



LEGEND

	SITE BOUNDARY
	FINISHED SURFACE CONTOURS
	EXISTING SURFACE LEVEL
	FINISHED SURFACE LEVEL
	EXISTING NOMINAL KERB LINE
	EXISTING STORMWATER DRAINAGE (RECORDS)
	EXISTING SEWER
	EXISTING WATER (RECORDS)
	EXISTING UNDERGROUND ELECTRICITY (RECORDS)
	EXISTING TELECOMMUNICATIONS (RECORDS)
	PROPOSED STORMWATER DRAINAGE
	PROPOSED 'TYPE B2' KERB IN ACCORDANCE WITH IPWEA STD DRG RS-080
	EXISTING ROAD
	PROPOSED FOOTPATH IN ACCORDANCE WITH IPWEA STD DRG. RS-065
	PROPOSED DRIVEWAY HARDSTAND
	PROPOSED TYPE 'GENERAL WIDE FLAIED' & 'GENERAL WIDE' DRIVEWAY CROSSOVER IN ACCORDANCE WITH IPWEA STD DRG. RS-051

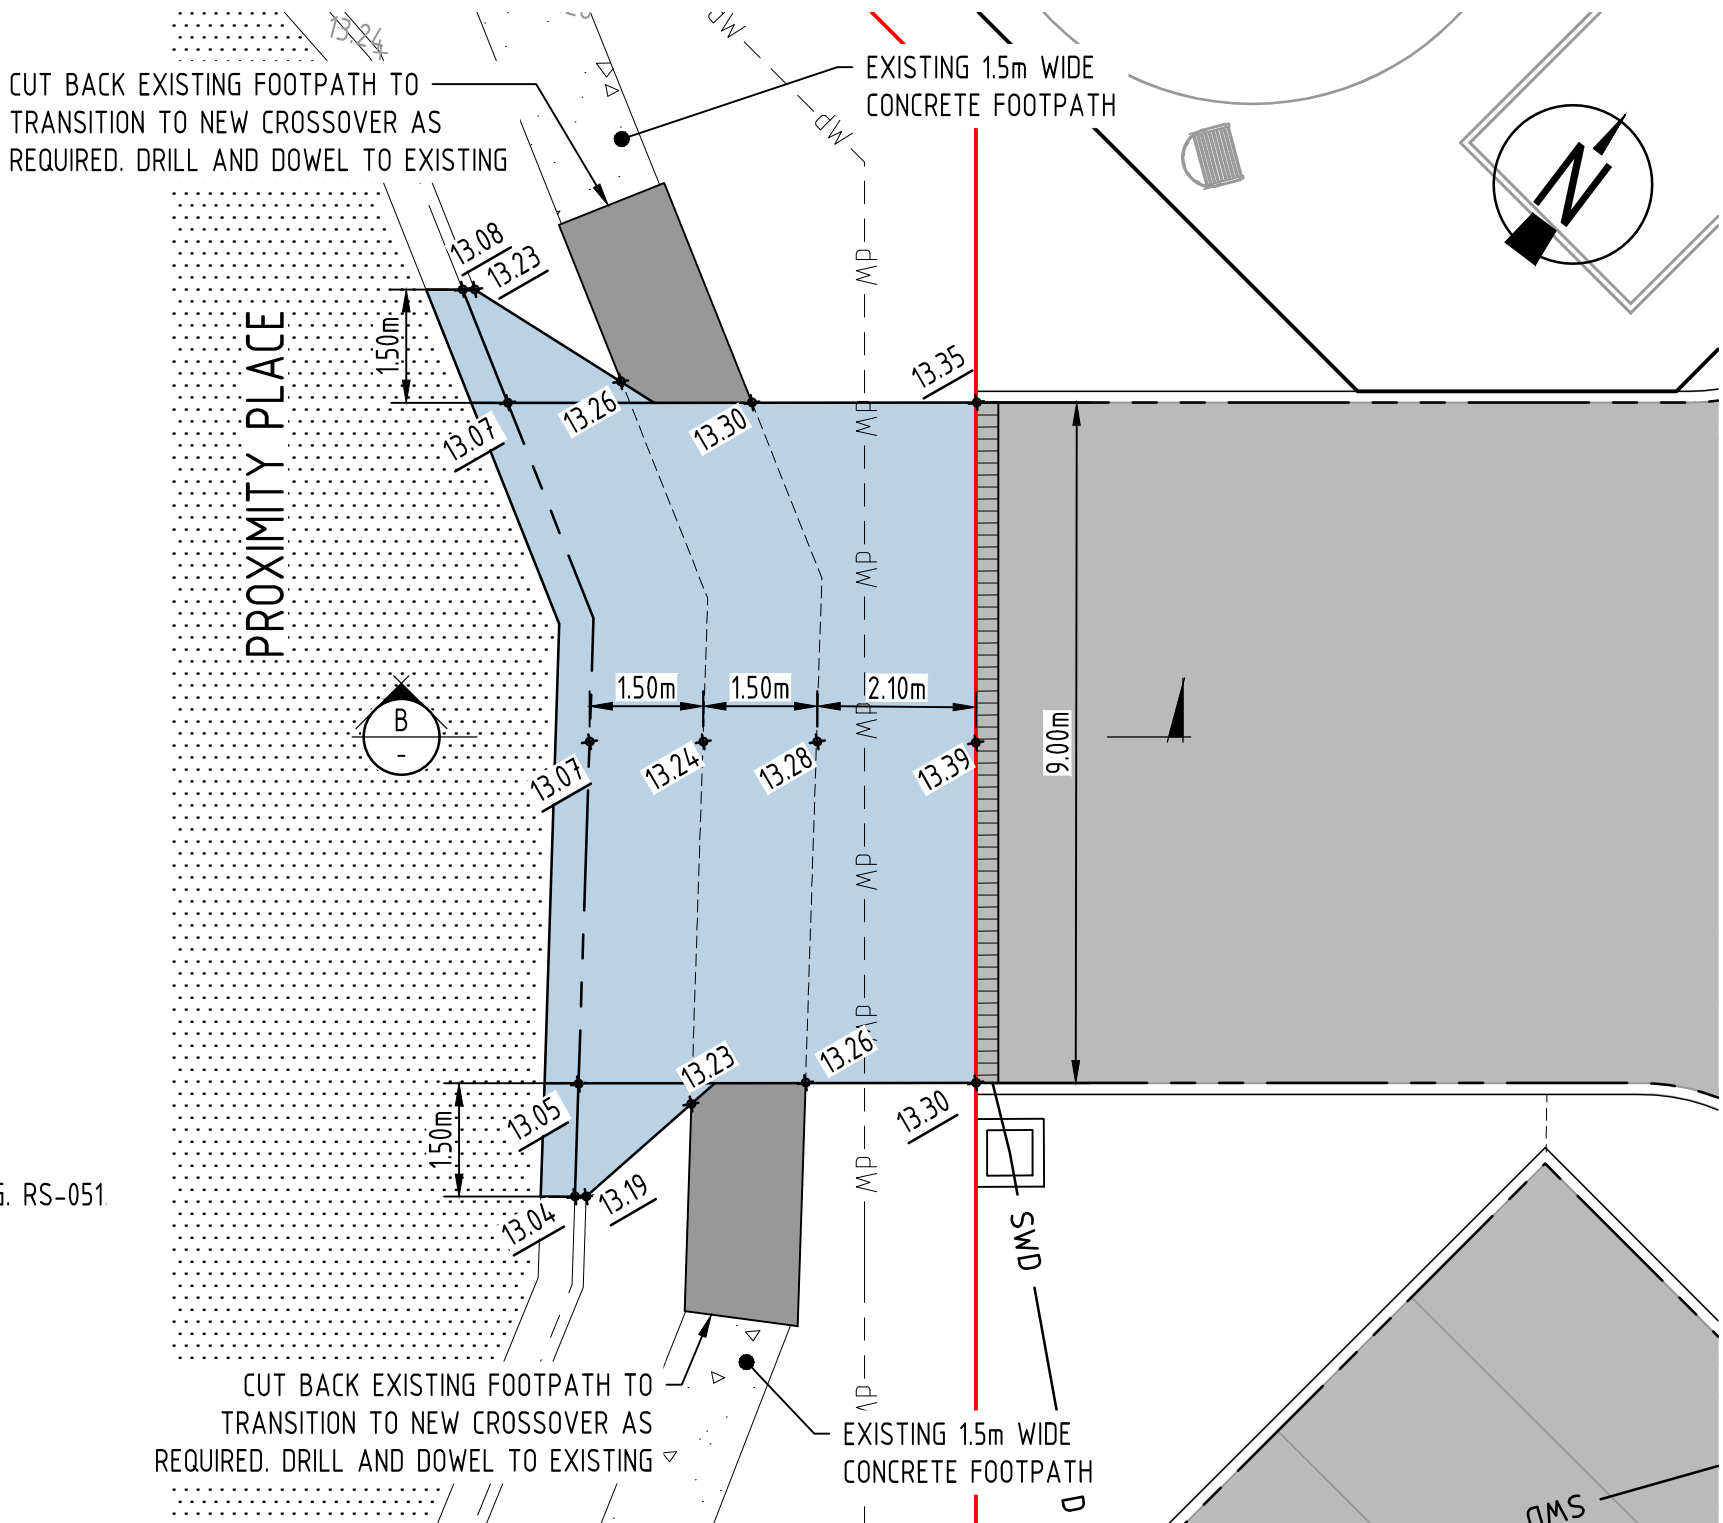



GENERAL WIDE DRIVEWAY LAYOUT PLAN
SCALE 1:100

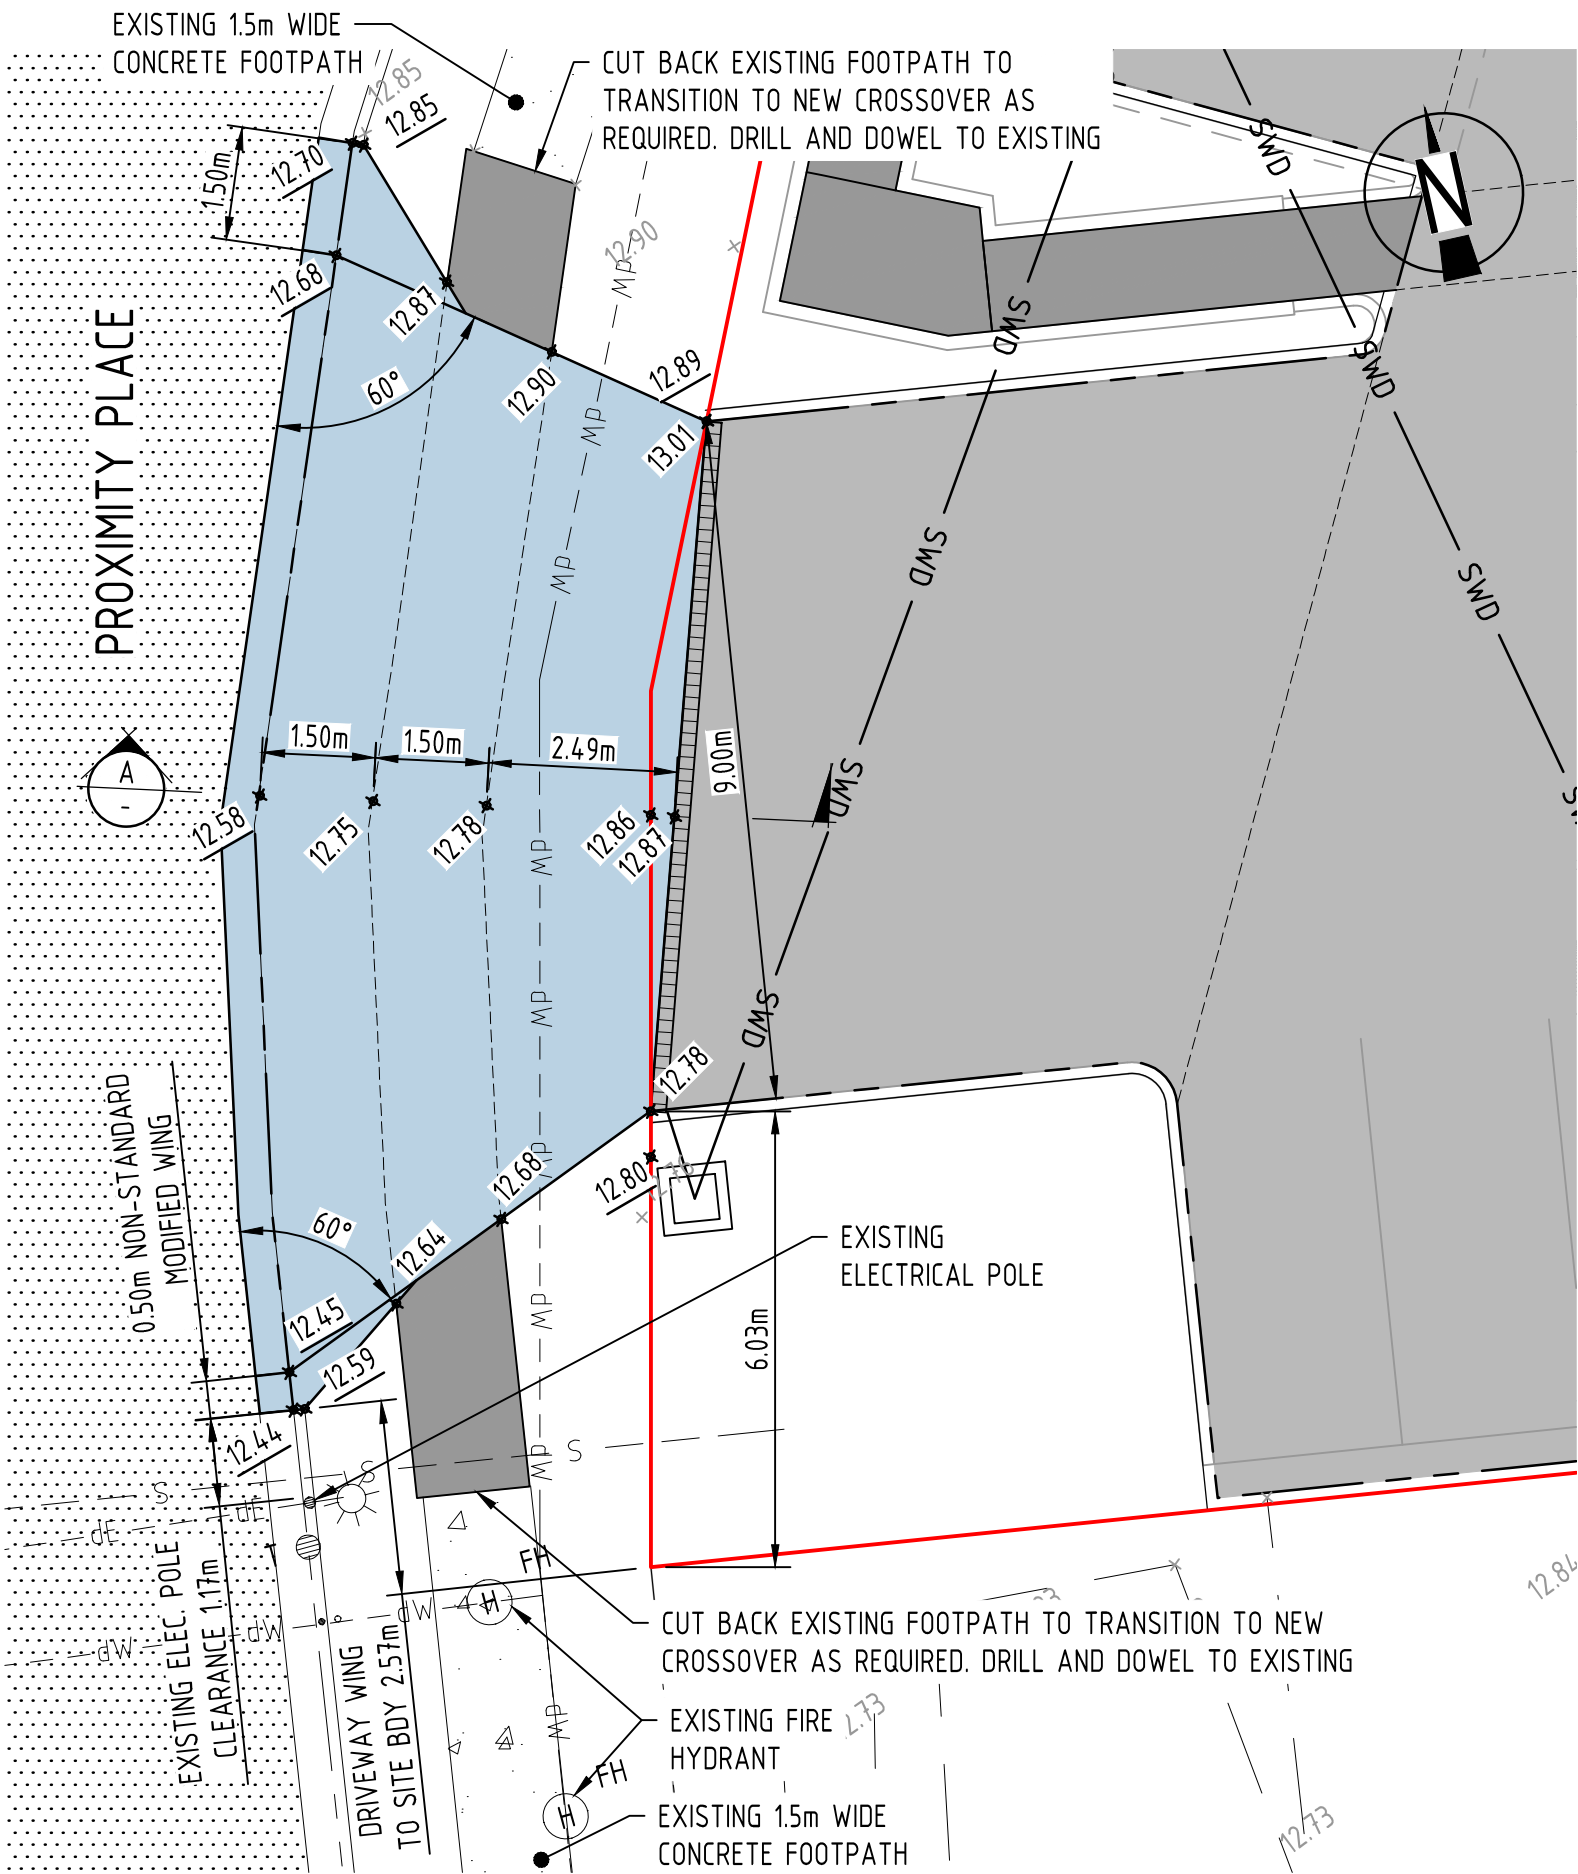


GENERAL WIDE FLAIED DRIVEWAY LAYOUT PLAN
SCALE 1:100

NOTES

- FOR GENERAL NOTES REFER DRG No. C01, WHICH IS TO BE REQUESTED AND VIEWED PRIOR TO COMMENCEMENT OF CONSTRUCTION IF NOT SUPPLIED.
- FOR ROADWORKS NOTES AND DETAILS REFER DRG No. C30
- ALL ROADWORKS AND DRAINAGE CONSTRUCTION AND TESTING TO BE IN ACCORDANCE WITH CITY OF GOLD COAST DEVELOPMENT GUIDELINES, DRAWINGS AND SPECIFICATIONS.
- TRENCH BACKFILL UNDER PAVEMENT TO BE COMPACTED TO 100% STANDARD DRY DENSITY (AS1289 5.1.1) IN LAYERS NOT EXCEEDING 150mm OF CBR 15 MATERIAL OR APPROVED EQUIVALENT.
- ALL FOOTPATHS TO BE CONSTRUCTED IN ACCORDANCE WITH ARCHITECTURAL/LANDSCAPING DRAWINGS IPWEA STD DRG RS-065
- CONTRACTOR TO ADEQUATELY PROTECT EXISTING DN150 DCL WATER MAIN AND HYDRANTS THROUGHOUT CONSTRUCTION, ANY DAMAGES TO BE RECTIFIED AT CONTRACTOR EXPENSE

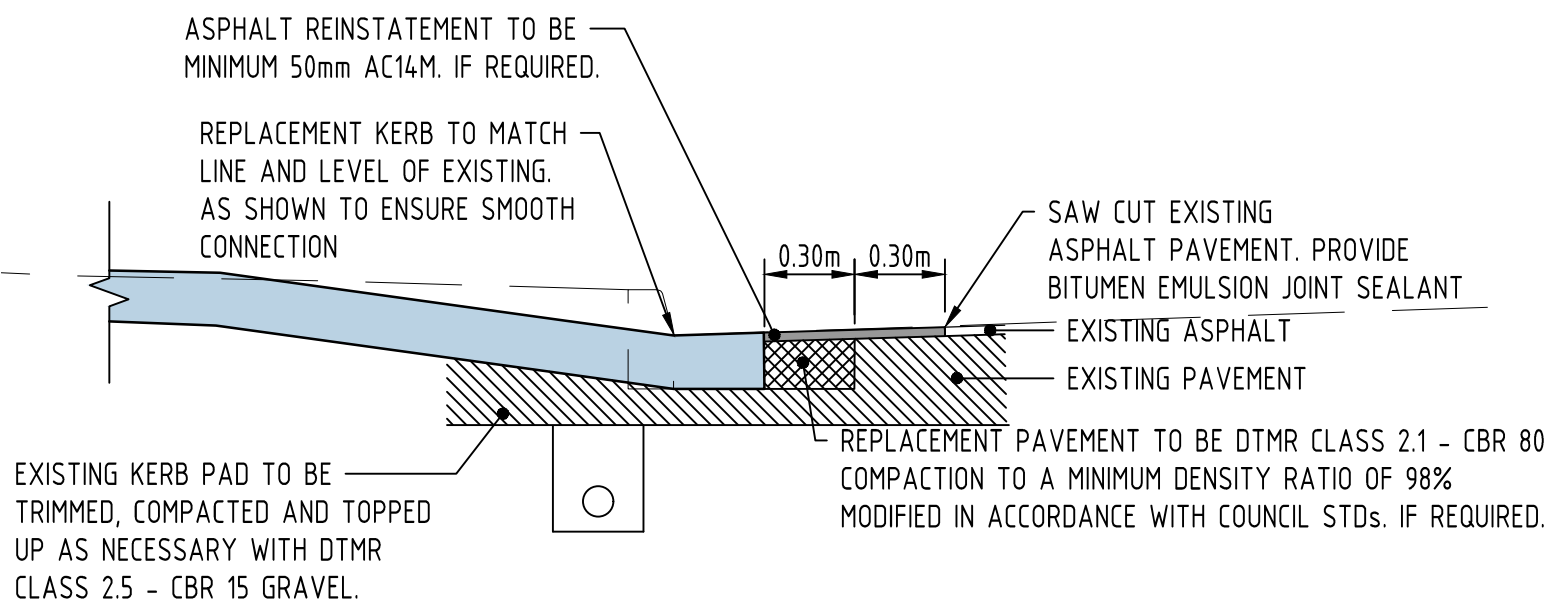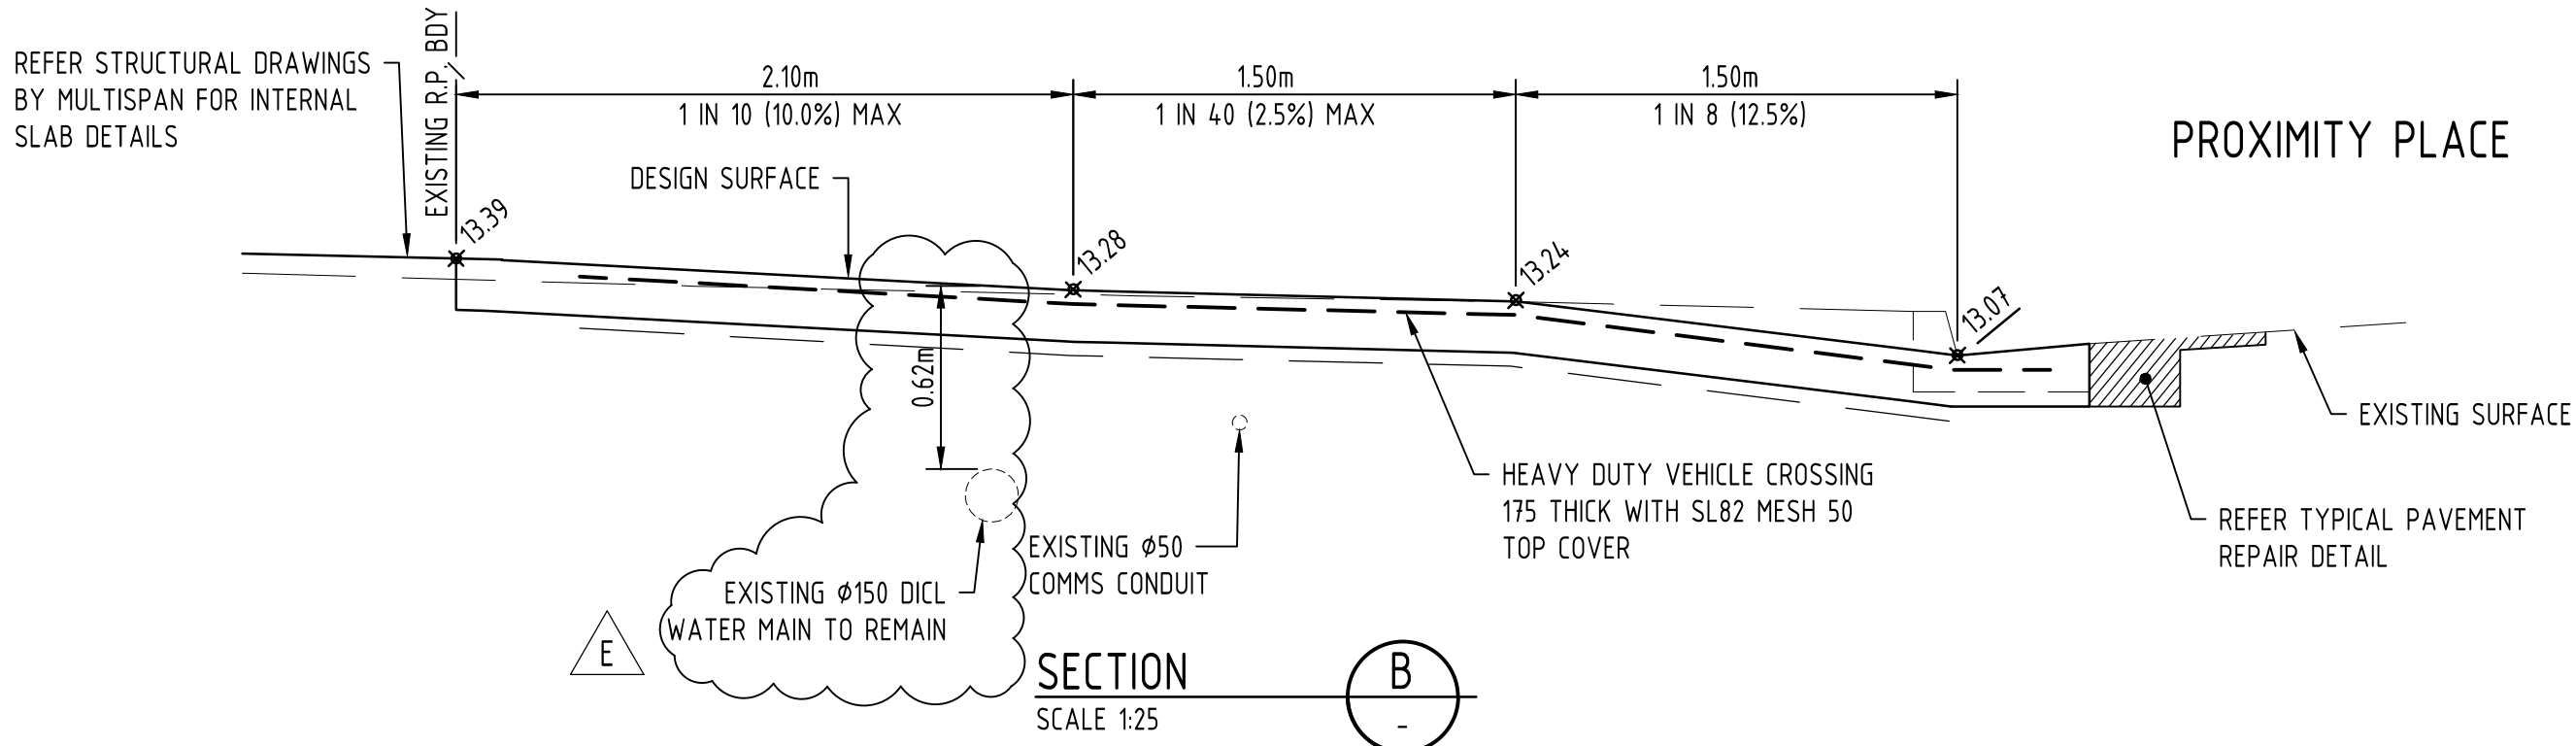

TYPICAL PAVEMENT REPLACEMENT DETAIL
SCALE 1:25

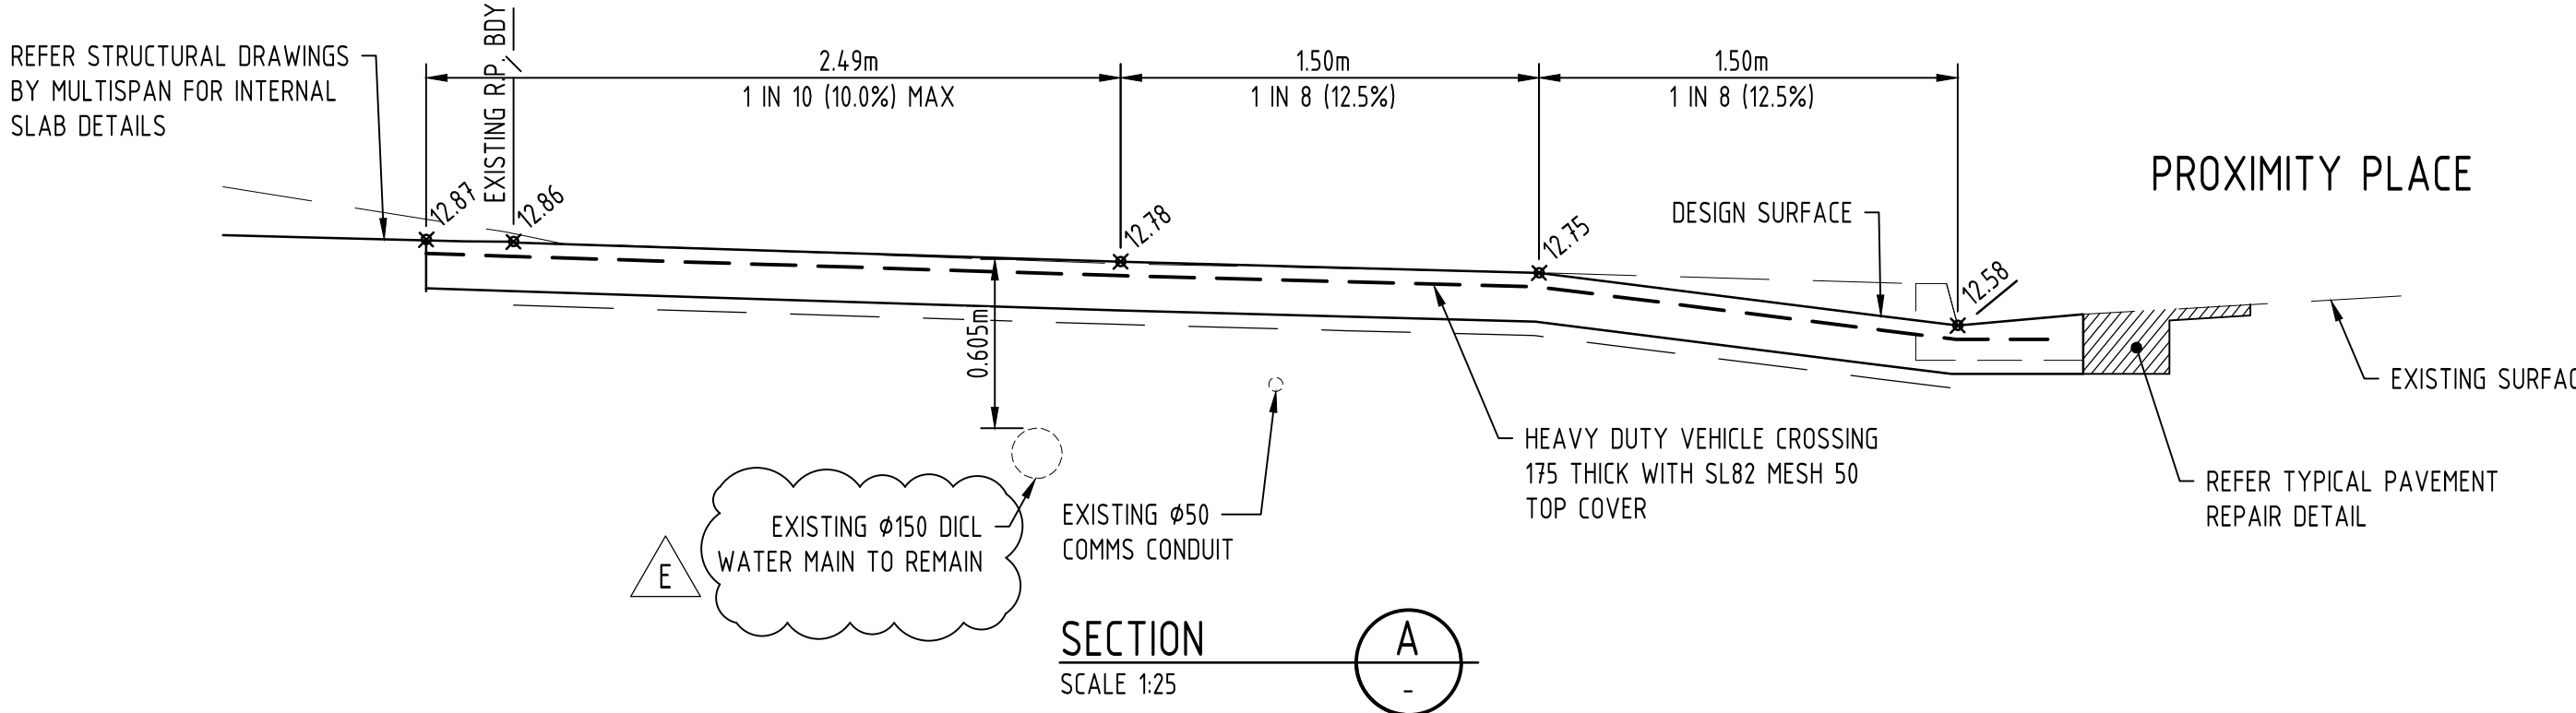


SECTION
SCALE 1:25

ISSUED FOR
APPROVAL

Rev	Date	Description	By	CHK
E	27.09.24	ISSUED FOR APPROVAL	DG	ML
D	22.08.24	ISSUED FOR CONSTRUCTION	DG	ML
C	05.07.24	ISSUED FOR APPROVAL	DG	ML
B	02.07.24	ISSUED FOR APPROVAL	DG	ML
A	24.05.24	ISSUED FOR APPROVAL	DG	ML

ADG RPEQ CERTIFICATION

PROJECT NUMBER: 27982
PROJECT NAME: LOT 16 ON SP 342459
DATE: 27.09.24
CERTIFIED BY: MICHAEL LEPELAAR
RPEQ NUMBER: 11171
SIGNATURE:



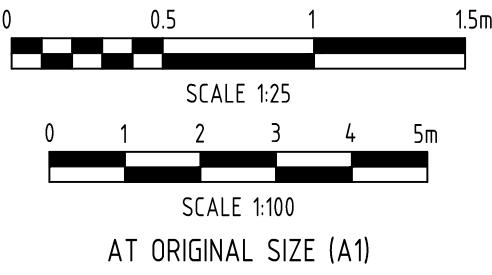


ADG

T:1300 857 402 E: info@adgco.com W: www.adgco.com
Quality Assurance ISO 9001:2015 | Work Health Safety ISO 45001:2018
Environmental Management ISO 14001:2015

Client MULTI SPAN AUSTRALIA GROUP PTY LTD		Discipline CIVIL		Status APPROVAL	Title DRIVEWAY CROSSOVER DETAILS
Project Name 15 PROXIMITY PLACE LOT 16 ON SP 342459 STAPYLTON, QLD 4207		Designed By TS	Checked By CH	Approved By ML	
		Project No. 27982	Drawn By DG	Scale at A1 AS SHOWN	
		The concepts and information contained in this document are the copyright of ADG Engineers (Aust) Pty Ltd. Use or copying of the document in whole or in part without the written permission of ADG Engineers (Aust) Pty Ltd constitutes an infringement of copyright. Do not scale drawings. If in doubt, ask!			
Drawing No. C32		Revision E			

  LEGEND



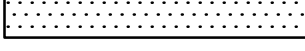
	FINISHED SURFACE CONTOURS
	SITE BOUNDARY
	EXISTING PROPERTY BOUNDARY
	EXISTING NOMINAL KERB LINE
	EXISTING STORMWATER DRAINAGE (RECORDS)
	EXISTING SEWER (RECORDS)
	EXISTING WATER (RECORDS)
	EXISTING UNDERGROUND ELECTRICITY (RECORDS)
	EXISTING TELECOMMUNICATIONS (RECORDS)
	PROPOSED STORMWATER DRAINAGE
	PROPOSED WATER MAIN
	PROPOSED NOMINAL KERB LINE
	EXISTING ROAD
	PROPOSED FOOTPATH
	PROPOSED DRIVEWAY HARDSTAND
	PROPOSED DRIVEWAY CROSSOVER
	PROPOSED EASEMENTS
	PROPOSED LANDSCAPE RETAINING WALL. REFER MULTISAN DRGS. FOR DETAILS

AS CONSTRUCTED / ADAC

CONTRACTOR TO ALLOW ALL COSTS FOR SURVEYOR TO GATHER
AS CONSTRUCTED SURVEY INFORMATION AND PREPARE ADAC
DATA IN ACCORDANCE WITH CURRENT GOLD COAST WATER
REQUIREMENTS, UNLESS OTHERWISE ADVISED BY ADG ENGINEERS

WATER CONNECTION NOTES

1. ALL WORKS AND MATERIALS SHALL BE IN ACCORDANCE WITH CURRENT SEQ DESIGN AND CONSTRUCTION CODE REQUIREMENTS.
2. EXISTING SERVICES HAVE BEEN PLOTTED FROM SUPPLIED DATA AND AS SUCH THEIR ACCURACY CANNOT BE GUARANTEED. IT IS THE RESPONSIBILITY OF THE CONTRACTOR TO ESTABLISH THE LOCATION AND LEVEL OF ALL EXISTING SERVICES PRIOR TO THE COMMENCEMENT OF ANY WORK. ANY DISCREPANCIES SHALL BE REPORTED TO THE SUPERINTENDENT.
3. CONTRACTOR SHALL OBTAIN THE LOCATION OF ALL SERVICES AND PROTECT THESE SERVICES PRIOR TO WORKING IN THE VICINITY. CONTRACTOR SHALL BE RESPONSIBLE FOR REPAIR OF ANY DAMAGE TO COUNCIL'S INFRASTRUCTURE. SUCH REPAIR OR REINSTATEMENT TO BE CARRIED OUT IMMEDIATELY TO THE SATISFACTION OF LOCAL COUNCIL AT CONTRACTORS EXPENSE.
4. ALL MATERIALS USED IN THE WORKS SHALL COMPLY WITH THE SEQ-SP'S ACCEPTED PRODUCTS AND MATERIALS LIST OR BE APPROPRIATELY SHOWN, LISTED AND DEFINED IN THE ENGINEERING SUBMISSION SO THAT THE ALTERNATIVE PRODUCT OR MATERIAL CAN BE ASSESSED AND IF APPROPRIATE, APPROVED BY THE SEQ-SP.
5. UNLESS SPECIFIED OTHERWISE ALL MATERIALS AND WORK SHALL COMPLY WITH THE RELEVANT AUSTRALIAN STANDARDS.
6. COVER ON MAINS FROM PERMANENT LEVEL TO BE AS FOLLOWS:
100 & 150 (DN63, 125 & 180 For PE100) - 600
200, 250 & 300 (DN250, 315 & 355 For PE100) - 1000mm
7. CONDUITS TO BE INSTALLED IN ACCORDANCE WITH SEQ SPECIFICATIONS.
8. A WATER METER SUPPLIED AT THE DEVELOPER'S COST, IS TO BE INSTALLED AT THE SERVICE POINT OF EACH LOT IN ACCORDANCE WITH THE STANDARD DRAWING FOR THE SEQ-SP.
9. mPVC PIPES SHALL BE SERIES 2 CLASS PN16 AND COMPLY WITH AS/NZS34765. FITTINGS SHALL BE CEMENT LINED GREY IRON IN ACCORDANCE WITH A.S. 2554, OR DUCTILE IRON CEMENT LINED (DICI) IN ACCORDANCE WITH A.S. 2280. DUCTILE IRON CEMENT LINED (DICI) PIPES AND FITTINGS SHALL BE CLASS PN35 AND COMPLY WITH A.S. 2280. PIPES AND FITTINGS SHALL BE POLYETHYLENE SLEEVED.
10. MILD STEEL (MSCL) PIPES SHALL COMPLY WITH A.S. 1579 AND BE CEMENT LINED IN ACCORDANCE WITH A.S. 1281. PIPE COATING SHALL COMPLY WITH A.S. 4321 (SINTAKOTE II).
11. POLYETHYLENE PIPES AND FITTING SHALL BE CLASS PN16 PE100 AND COMPLY WITH A.S. 4130 AND A.S. 4129.
12. ALL CONCRETE FOOTPATHS TO BE CLEAR OF WATER MAINS.
13. THE CONSTRUCTION OF THE WATER RETICULATION WORK SHOWN IN THIS DRAWING MUST BE SUPERVISED BY AN ENGINEER WHO HAS RPQ REGISTRATION. WORKS NOT COMPLYING WITH THIS REQUIREMENT WILL NOT BE PERMITTED TO CONNECT INTO COGC'S RETICULATION SYSTEM.
14. CONTRACTOR TO UNDERTAKE TESTING AND AS CONSTRUCTED DRAWINGS AS REQUIRED BY GOLD COAST WATER
15. EXISTING WATER MAIN COVER AND LOCATION CONFIRMED ONSITE BY SAFEDIG SERVICES VIA POTHOLING.

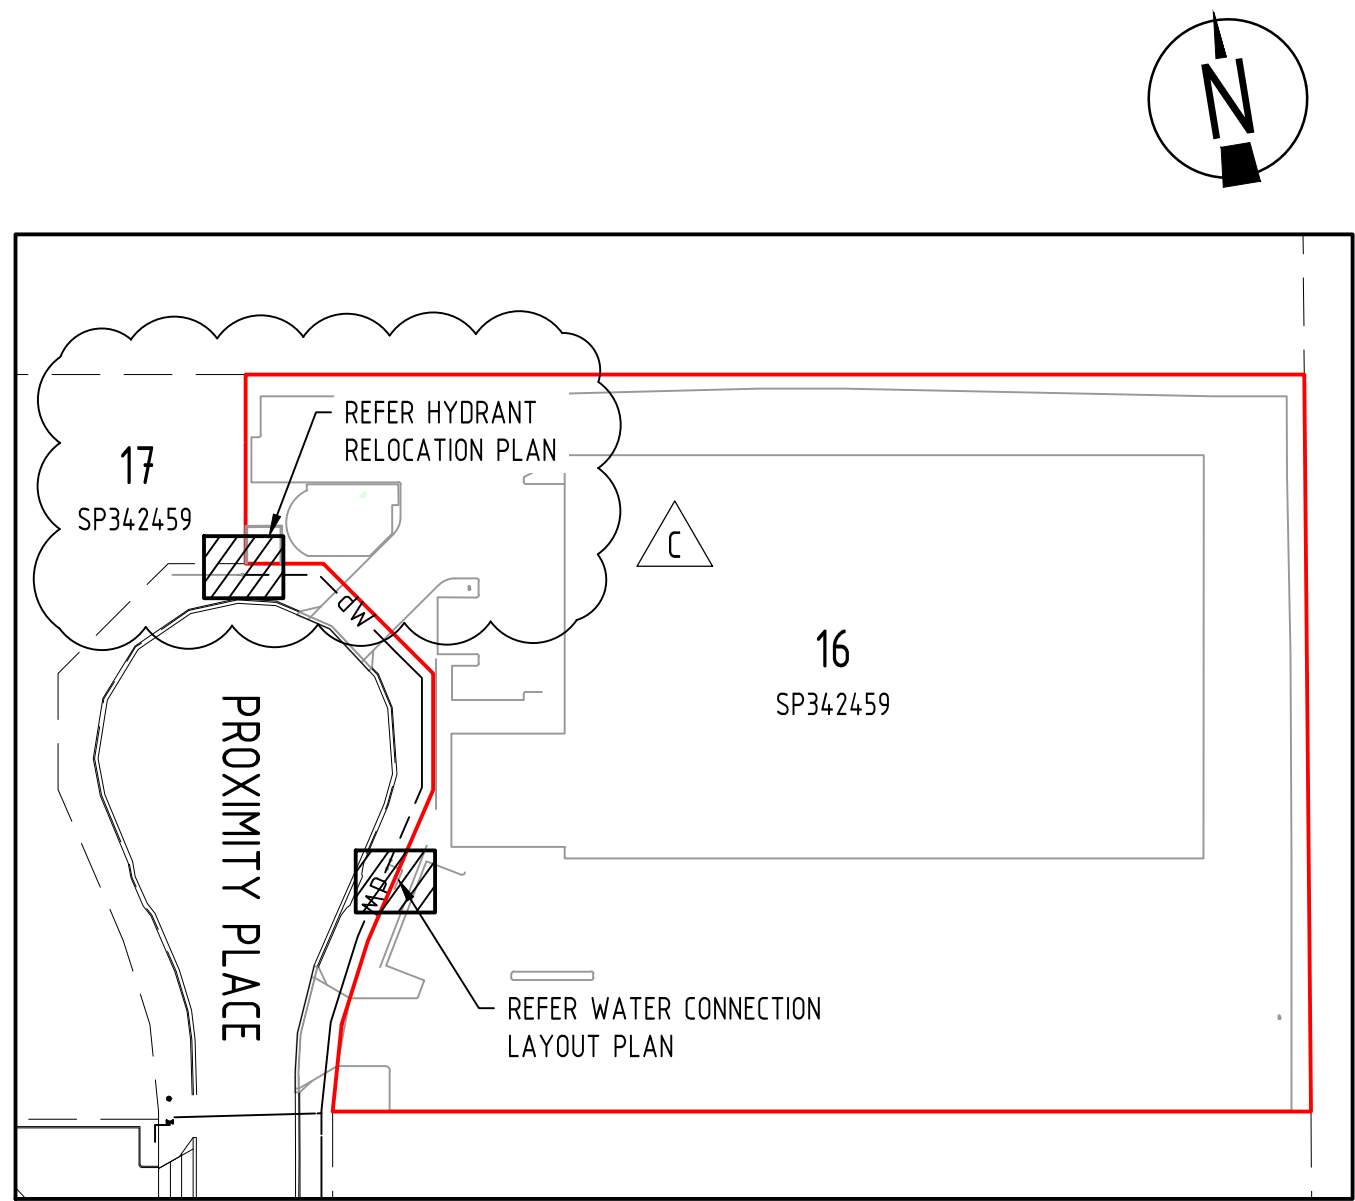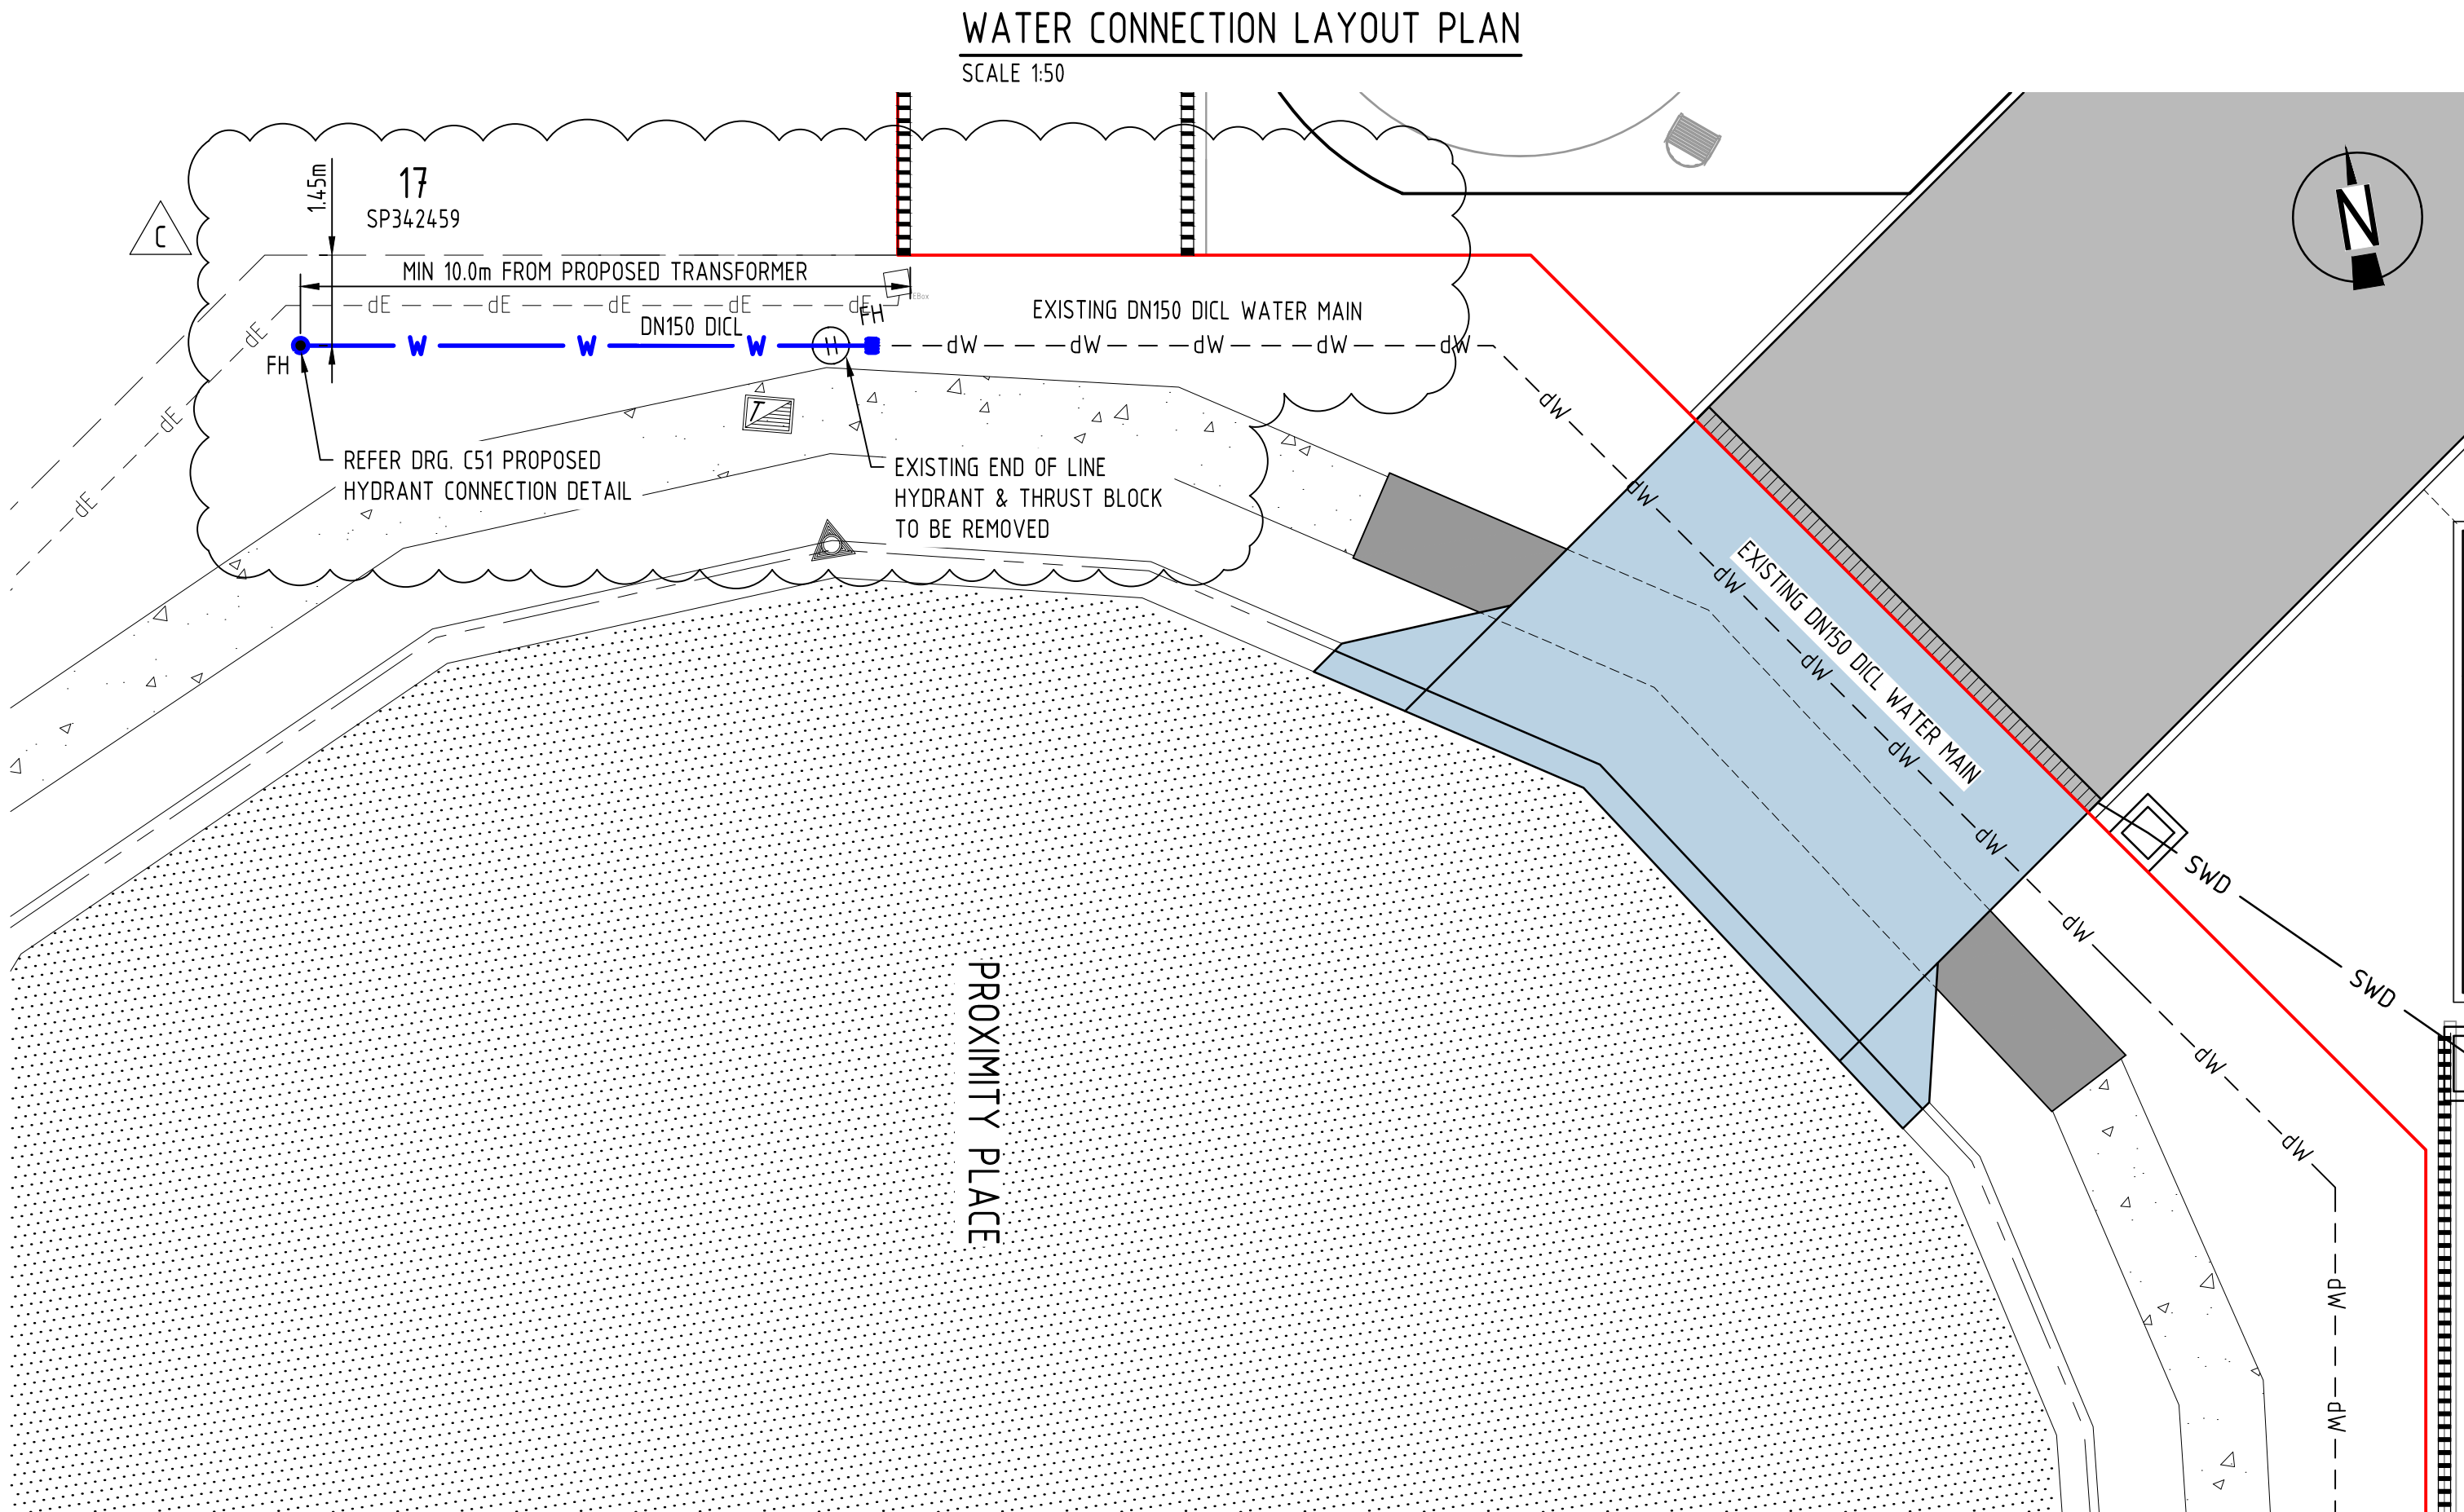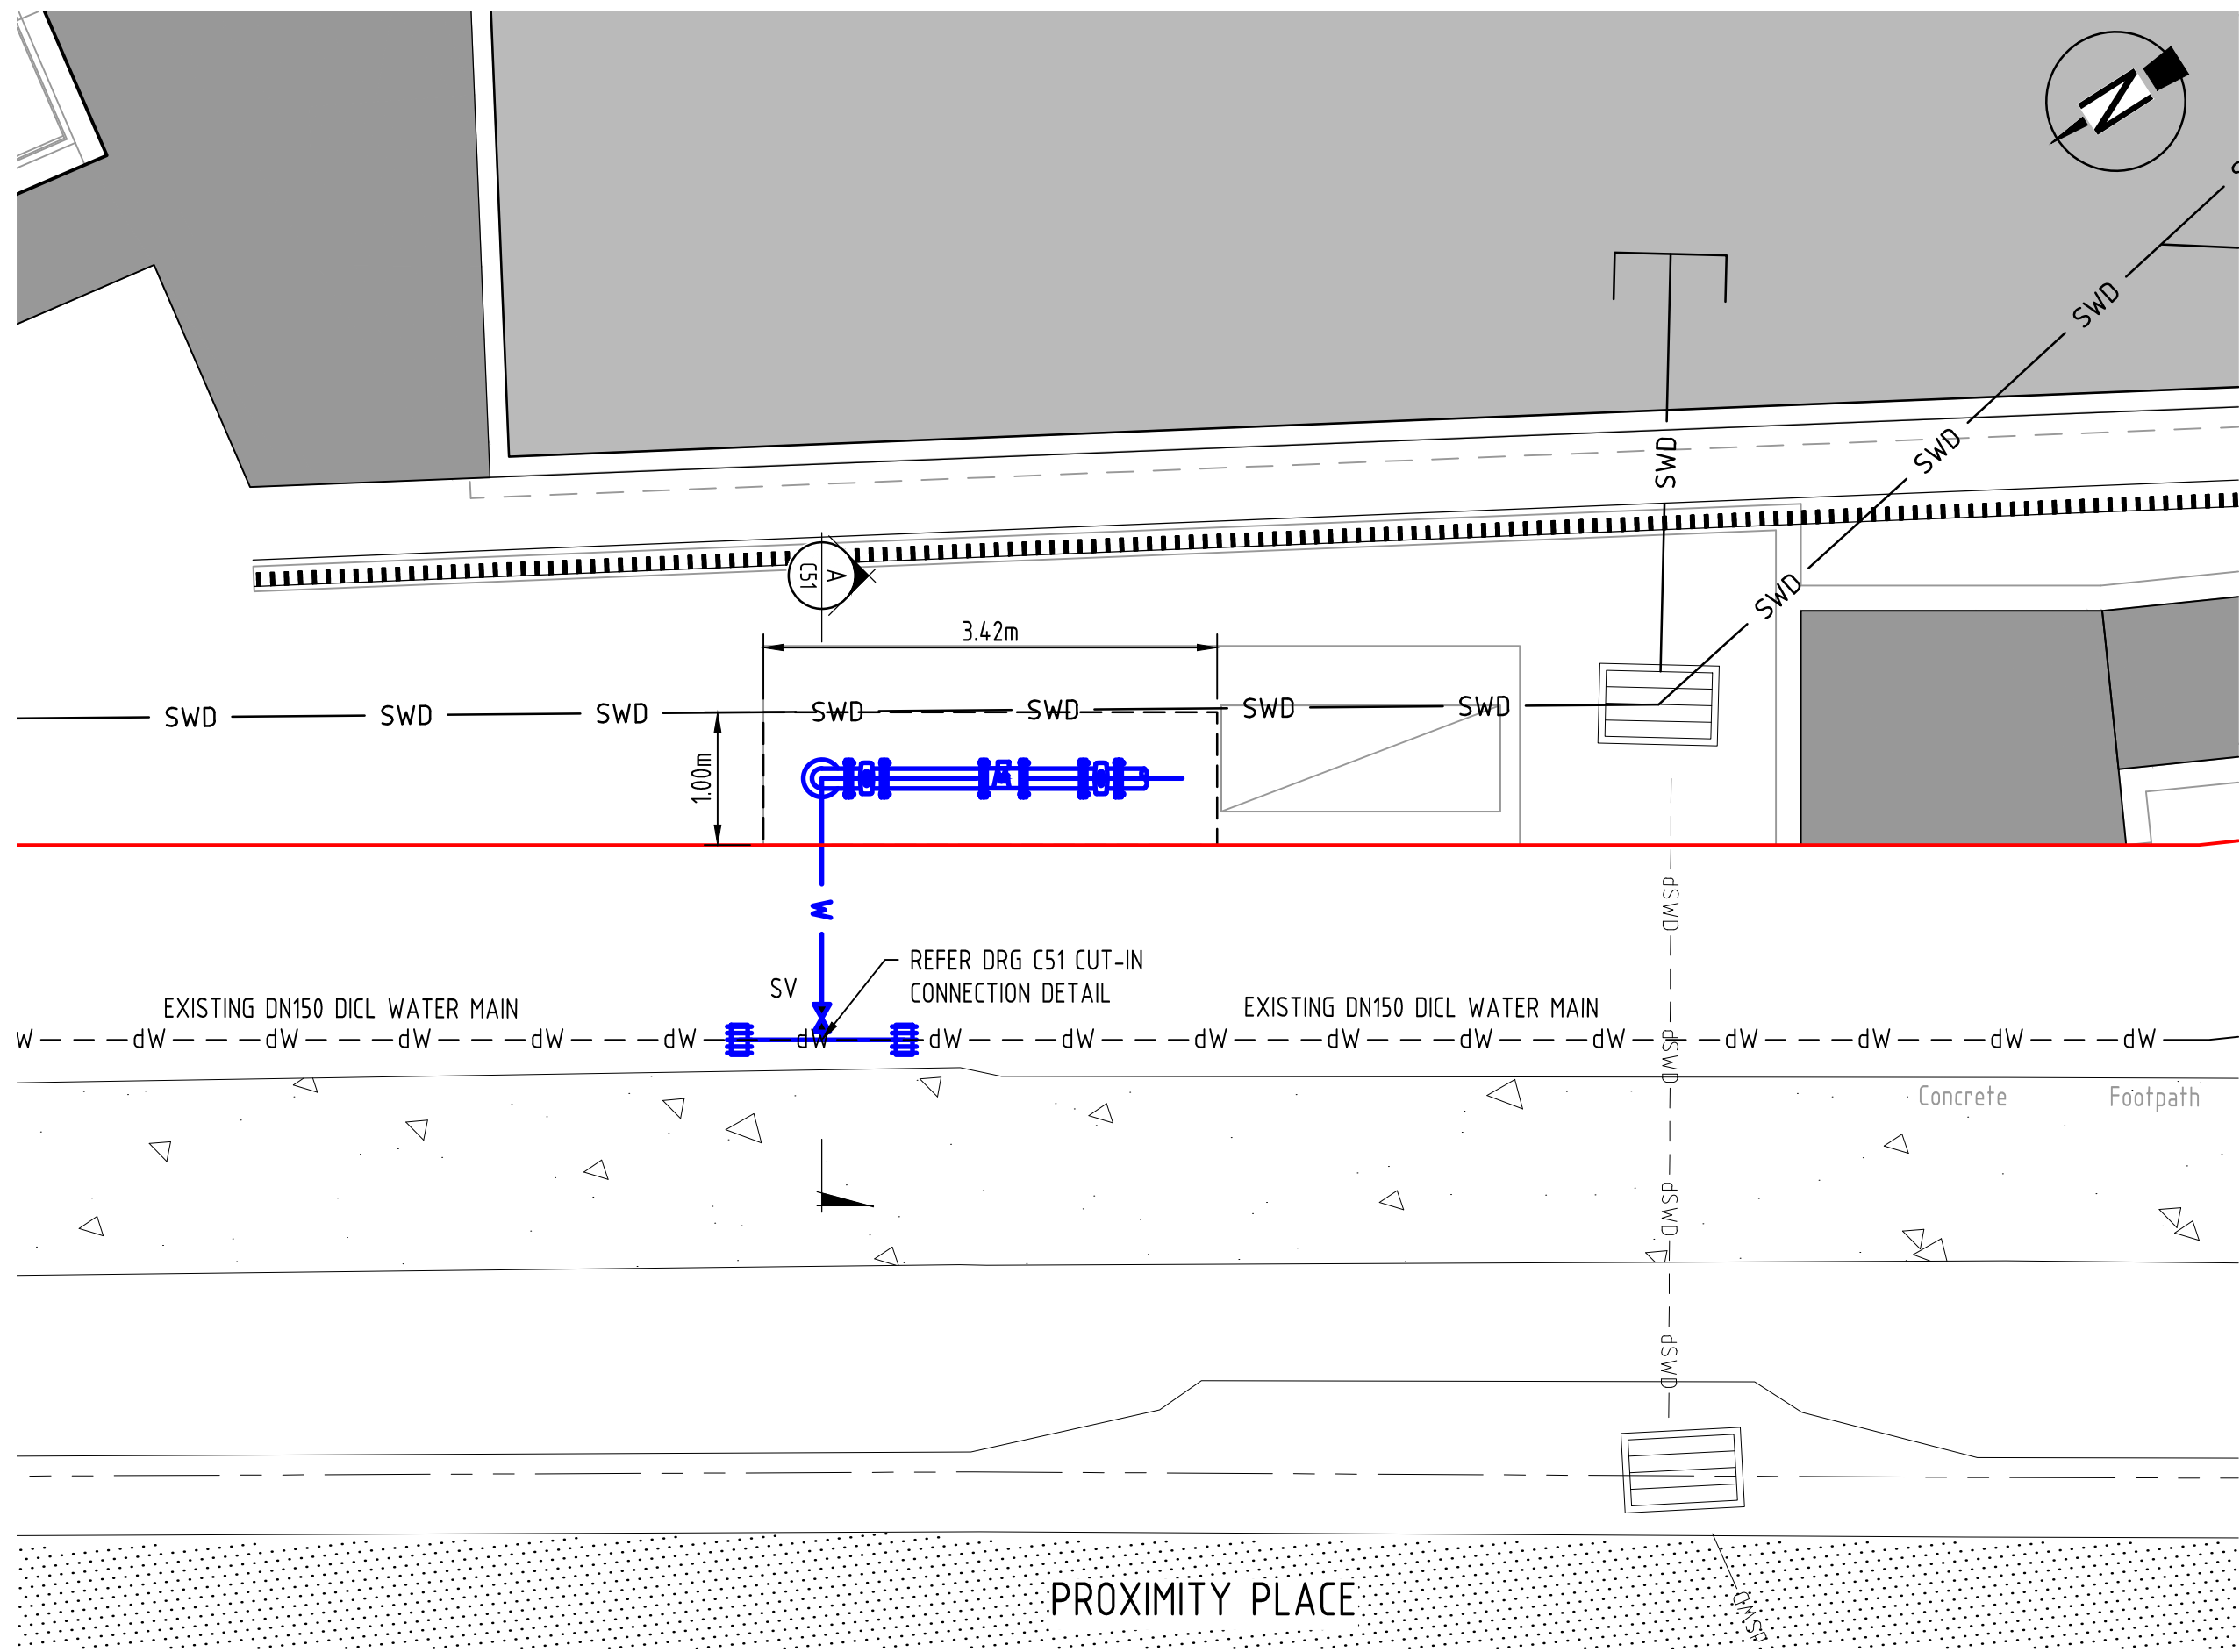

KEY PLAN
SCALE 1:1000

NOTE:

- CoGC OPERATIONAL WORKS APPROVAL REQUIRED FOR THESE WORKS
- 'APPLICATION TO WORK ON THE CITY'S INFRASTRUCTURE' APPROVAL REQUIRED FOR THESE WORKS.
- ALL LIVE WORKS TO BE COMPLETED UNDER SUPERVISION OF CoGC.

NOTE:

EXISTING SHOWN ARE BASED ON DETAILED SURVEY AND COUNCIL RECORDS. EXISTING SERVICES TO BE ACCURATELY LOCATED MINIMUM 10 DAYS PRIOR TO THE COMMENCEMENT OF WORKS AND INFORMATION SUPPLIED TO ADG ENGINEERS TO ENSURE THAT THE PROPOSED METER ARRANGEMENT CAN BE ACCOMMODATED AS SHOWN.

ISSUED FOR
APPROVAL

C	27.09.24	ISSUED FOR APPROVAL		DG	ML
B	22.08.24	ISSUED FOR CONSTRUCTION		DG	ML
A	24.05.24	ISSUED FOR APPROVAL		DG	ML
Rev	Date	Description		By	CHK

ADG RPEQ CERTIFICATION

 
PROJECT NUMBER: 27982


PROJECT NAME: LOT 16 ON SP 342459

DATE: 27.09.24


CERTIFIED BY: MICHAEL LEPELAAR

RPEQ NUMBER: 11171

SIGNATURE: 

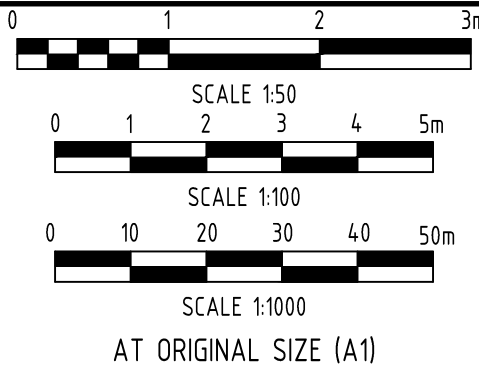

Client	Discipline	Status	Title
MULTI SPAN AUSTRALIA GROUP PTY LTD	CIVIL	APPROVAL	WATER PROPERTY CONNECTION LAYOUT PLAN
Project Name	Designed By	Checked By	Approved By
15 PROXIMITY PLACE	TS	CH	ML
LOT 16 ON SP 342459	Project No.	Drawn By	Scale at A1
STAPYLTON, QLD	27982	DG	AS SHOWN
4207	The concepts and information contained in this document are the copyright of ADG Engineers (Aust) Pty Ltd. Use or copying of the document in whole or in part without the written permission of ADG Engineers (Aust) Pty Ltd constitutes an infringement of copyright. Do not scale drawings. If in doubt, ask!		Drawing No.
			C50
			Revision
			C

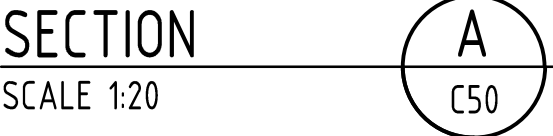

ISSUED FOR
APPROVAL

ADG RPEQ CERTIFICATION

PROJECT NUMBER: 27982


PROJECT NAME: LOT 16 ON SP 342459

DATE: 27.09.24

CERTIFIED BY: MICHAEL LEPELAAR

RPEQ NUMBER: 11171

SIGNATURE: 

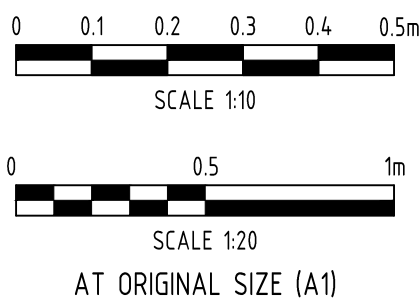

Client MULTI SPAN AUSTRALIA GROUP PTY LTD		Discipline CIVIL		Status APPROVAL	Title WATER PROPERTY CONNECTION DETAILS
Project Name 15 PROXIMITY PLACE LOT 16 ON SP 342459 STAPYLTON, QLD 4207		Designed By TS	Checked By CH	Approved By ML	
		Project No. 27982	Drawn By DG	Scale at A1 AS SHOWN	
		The concepts and information contained in this document are the copyright of ADG Engineers (Aust) Pty Ltd. Use or copying of the document in whole or in part without the written permission of ADG Engineers (Aust) Pty Ltd constitutes an infringement of copyright. Do not scale drawings. If in doubt, ask!			
		Drawing No. C51			Revision C

PLOT DATE: 9/27/2024 10:52 AM FILENAME: J:\GLC\27000\27982\CVL\DWG\CPW\27982_C51_WATER PROPERTY CONNECTION DETAILS.DWG

FULL SIZE ON ORIGINAL 0 10 20 30 40 50 60 70 80 90 100mm