


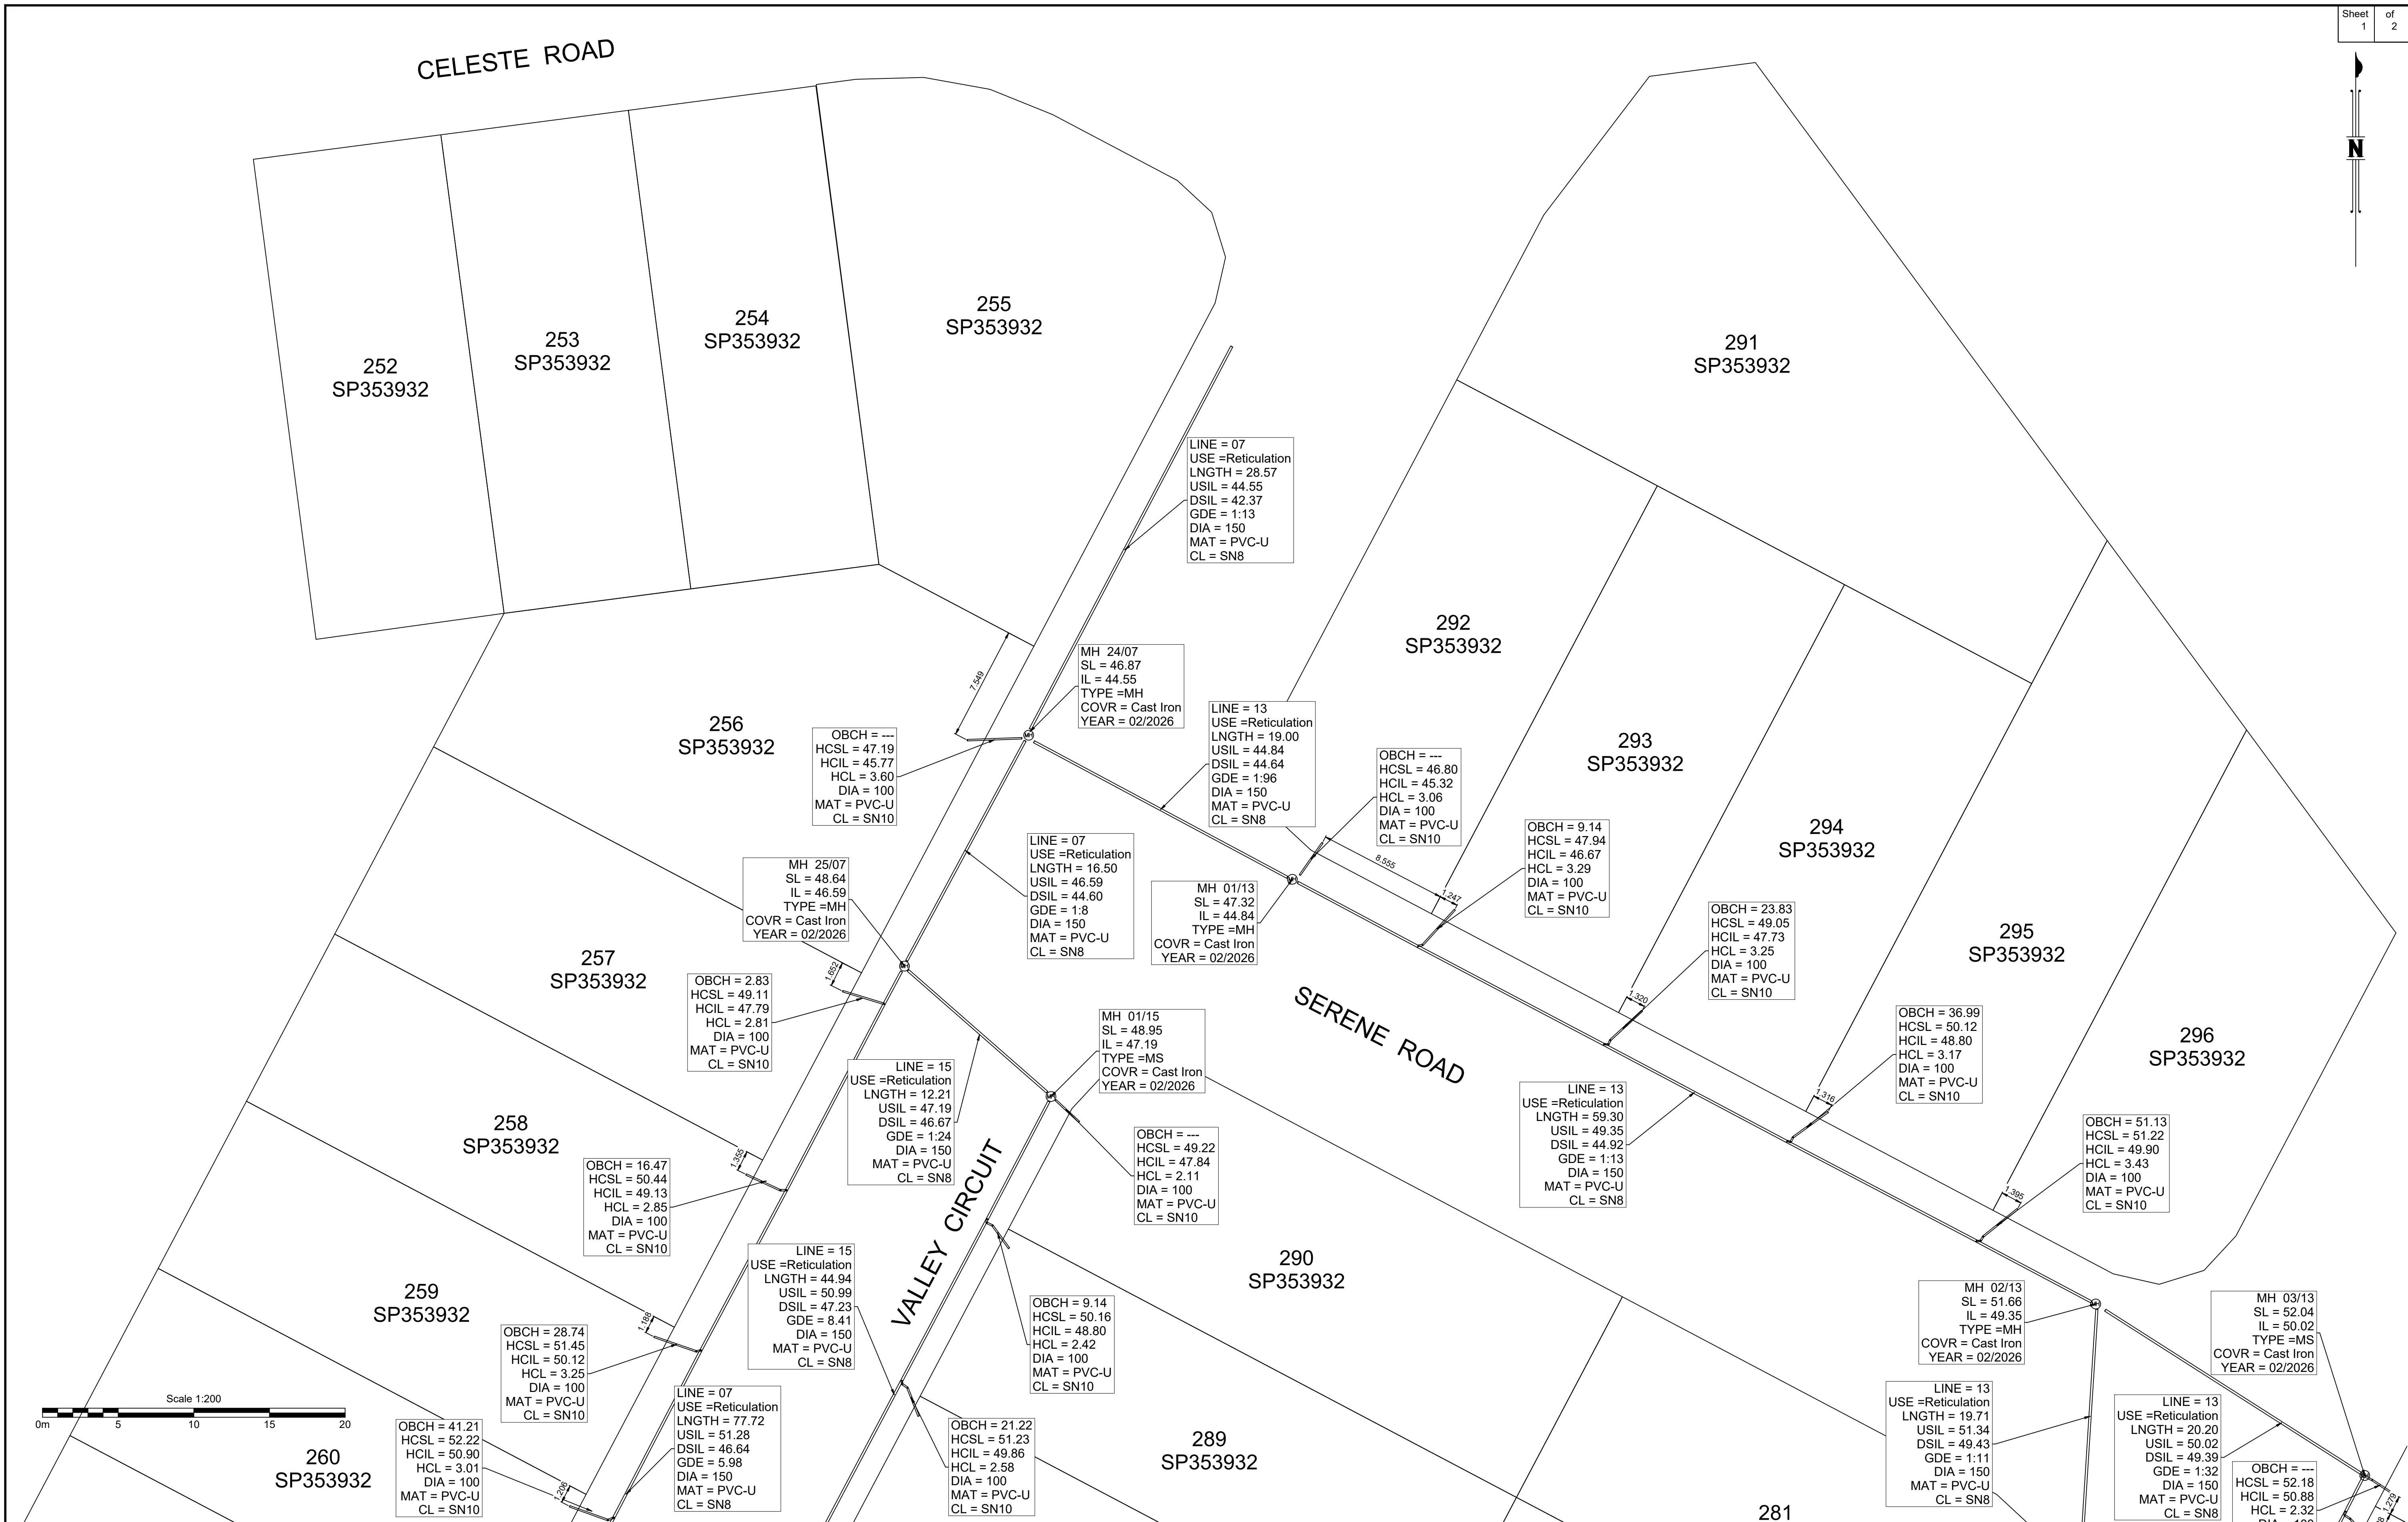

B.B.H PTY. LTD ACN 010 427 531
(trading as Bennett and Bennett Group) hereby certify
that the vertical and horizontal locations, and
dimensions shown on this plan are a true and
correct record of the As-Constructed information.

Agent
Date

I, ...
hereby certify that the As Constructed
information shown on this plan is a true and
correct record of sizes, types, materials,
classes etc, and it corresponds with the
relevant approved Engineering Drawings

Signed
RPEQ No. Date

Revisions

Rev	Description	Date	Initial
A	ORIGINAL	25/05/2026	BDH

SEWER - AS CONSTRUCTED
COURTNEY DRIVE STAGE 5
UPPER COOMERA
OPW/2024/349

Client:	HB Australia Pty Ltd
Job No:	171101
Authority:	Council of the City of Gold Coast
Plan No:	171101_062_ASC.pdf
DWG File:	171101_062_ASC.dwg
Level Origin & Datum:	PSM170053 41.380 AHD
1:200 @ A1	Drawn: DK
Date:	29/05/26

BENNETT + BENNETT
PO Box 5021, GCMC QLD 9726
Ph: (07) 5631 8000
mail@bennettandbennett.com.au
www.bennettandbennett.com.au

