

O2LA STANDARD DRAWINGS

© COPYRIGHT: THE INFORMATION CONTAINED IN THIS DOCUMENT IS THE PROPERTY OF O2 LANDSCAPE ARCHITECTURE. COPYING OF THIS DOCUMENT WITHOUT THE CONSENT OF O2 LANDSCAPE ARCHITECTURE CONSTITUTES AN INFRINGEMENT OF COPYRIGHT. DISCLAIMER: DO NOT SCALE OFF DRAWINGS. THE CONTRACTOR IS REQUIRED TO VERIFY DIMENSIONS AND SETOUT INFORMATION AND ADVISE THE LANDSCAPE ARCHITECT IF THERE ARE ANY ERRORS OR OMISSIONS. DRAWINGS SHALL NOT BE USED FOR CONSTRUCTION PURPOSES UNTIL ISSUED FOR CONSTRUCTION.

O2 LANDSCAPE ARCHITECTURE PTY LTD
SHOP 3, 42 CORDELIA STREET
SOUTH BRISBANE QLD 4101
T: +61 7 3831 0681
mail@o2la.com.au
www.o2la.com.au

LANDSCAPE PLANS APPROVED

- To be constructed in accordance with the approved plan.
- Approval is subject to the observance of any amendments noted in red thereon.
- Landscape to be inspected and approved by Council Officers, prior to the use commencing on the land.
- No canopy trees to be planted within 3 metres of building foundations or rooflines (including neighbouring properties)
- All landscape materials, plants, vegetation and watering systems shown on the approved landscaping plan must be an acceptable quality and be installed and maintained to the satisfaction of the Chief Executive Officer.

Application No.: OPW/2022/1191

Dated: 24 November 2022

NOTES

LANDSCAPE PACKAGE TO BE READ IN CONJUNCTION WITH THE FOLLOWING DOCUMENTS:

- SPECIFIC LANDSCAPE DETAILS
- LANDSCAPE SPECIFICATIONS
- ARCHITECTURAL DRAWINGS
- CIVIL DRAWINGS
- HYDRAULIC DRAWINGS
- ELECTRICAL DRAWINGS

WHERE THERE ARE MAJOR DISCREPANCIES IN THE DRAWING AND SITE CONDITIONS, PLEASE CONTACT THE LANDSCAPE ARCHITECT FOR CLARIFICATION.


- LAWN AREAS MAXIMUM GRADE 1:4
- PLANTING AREAS TYPICALLY MAXIMUM GRADE 1:3. IF STEEPER, CONSULT WITH LANDSCAPE ARCHITECT TO CONFIRM GRADE
- MAKE GOOD AREAS DISTURBED BY WORKS
- WHERE NEW WORKS ADJOIN EXISTING, ALLOW FOR SMOOTH TRANSITION

	Issue	Comments	Date	Scale AS SHOWN Designed Approved Drawn Date of First Issue NI NI JS 26/03/2015				Drawing name STANDARD DRAWINGS COVER PAGE	O2LA STANDARD DRAWING	
	A	ORIGINAL ISSUE	26/03/2015						Drawing Number OSD-001	Issue B
	B	REVISED TITLEBLOCK	26/04/2017							

LANDSCAPE PLANS APPROVED

- To be constructed in accordance with the approved plan.
- Approval is subject to the observance of any amendments noted in red thereon.
- Landscape to be inspected and approved by Council Officers, prior to the use commencing on the land.
- No canopy trees to be planted within 3 metres of building foundations or rooflines (including neighbouring properties)
- All landscape materials, plants, vegetation and watering systems shown on the approved landscaping plan must be an acceptable quality and be installed and maintained to the satisfaction of the Chief Executive Officer.

Application No.: OPW/2022/1191
Dated: 24 November 2022

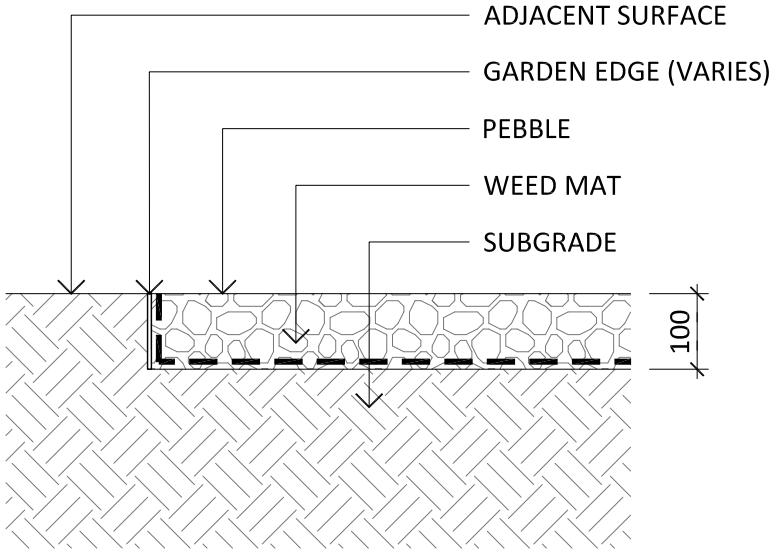

SECTION
SCALE 1:10



Issue	Comments	Date
A	ORIGINAL ISSUE	26/03/2015
B	ORIGINAL ISSUE	26/04/2017

LENGTH IN MILLIMETRES			
50	0	100	200
Scale 1:10 @ A3			
Designed	Approved	Drawn	Date of First Issue
NI	NI	JS	26/03/2015

Drawing name

GRAVEL - DECORATIVE

PEBBLE

O2LA STANDARD DRAWING

Drawing Number

OSD-500-1


Issue

B

LANDSCAPE PLANS APPROVED

- To be constructed in accordance with the approved plan.
- Approval is subject to the observance of any amendments noted in red thereon.
- Landscape to be inspected and approved by Council Officers, prior to the use commencing on the land.
- No canopy trees to be planted within 3 metres of building foundations or rooflines (including neighbouring properties)
- All landscape materials, plants, vegetation and watering systems shown on the approved landscaping plan must be an acceptable quality and be installed and maintained to the satisfaction of the Chief Executive Officer.

Application No. OPW/2022/1191
Dated: 24 November 2022

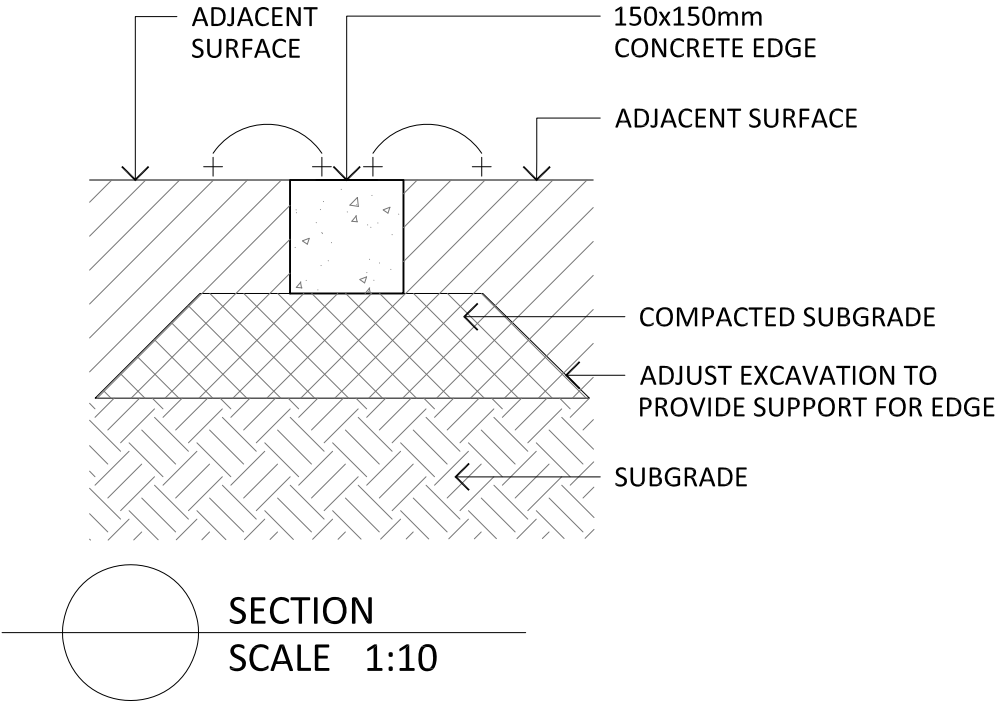

Issue	Comments	Date
A	ORIGINAL ISSUE	26/03/2015
B	REVISED TITLEBLOCK	26/04/2017
C	GENERAL UPDATE	13/03/2020

50	0	100	200	500
LENGTH IN MILLIMETRES				
Scale 1:10 @ A3				
Designed	Approved	Drawn	Date of First Issue	
NI	NI	JS	26/03/2015	

Drawing name

EDGE - CONCRETE


(150 x 150mm)

O2LA STANDARD DRAWING	
Drawing Number	Issue
OSD-551-1	C

LANDSCAPE PLANS APPROVED

- To be constructed in accordance with the approved plan.
- Approval is subject to the observance of any amendments noted in red thereon.
- Landscape to be inspected and approved by Council Officers, prior to the use commencing on the land.
- No canopy trees to be planted within 3 metres of building foundations or rooflines (including neighbouring properties)
- All landscape materials, plants, vegetation and watering systems shown on the approved landscaping plan must be an acceptable quality and be installed and maintained to the satisfaction of the Chief Executive Officer.

Application No.: OPW/2022/1191
Dated: 24 November 2022

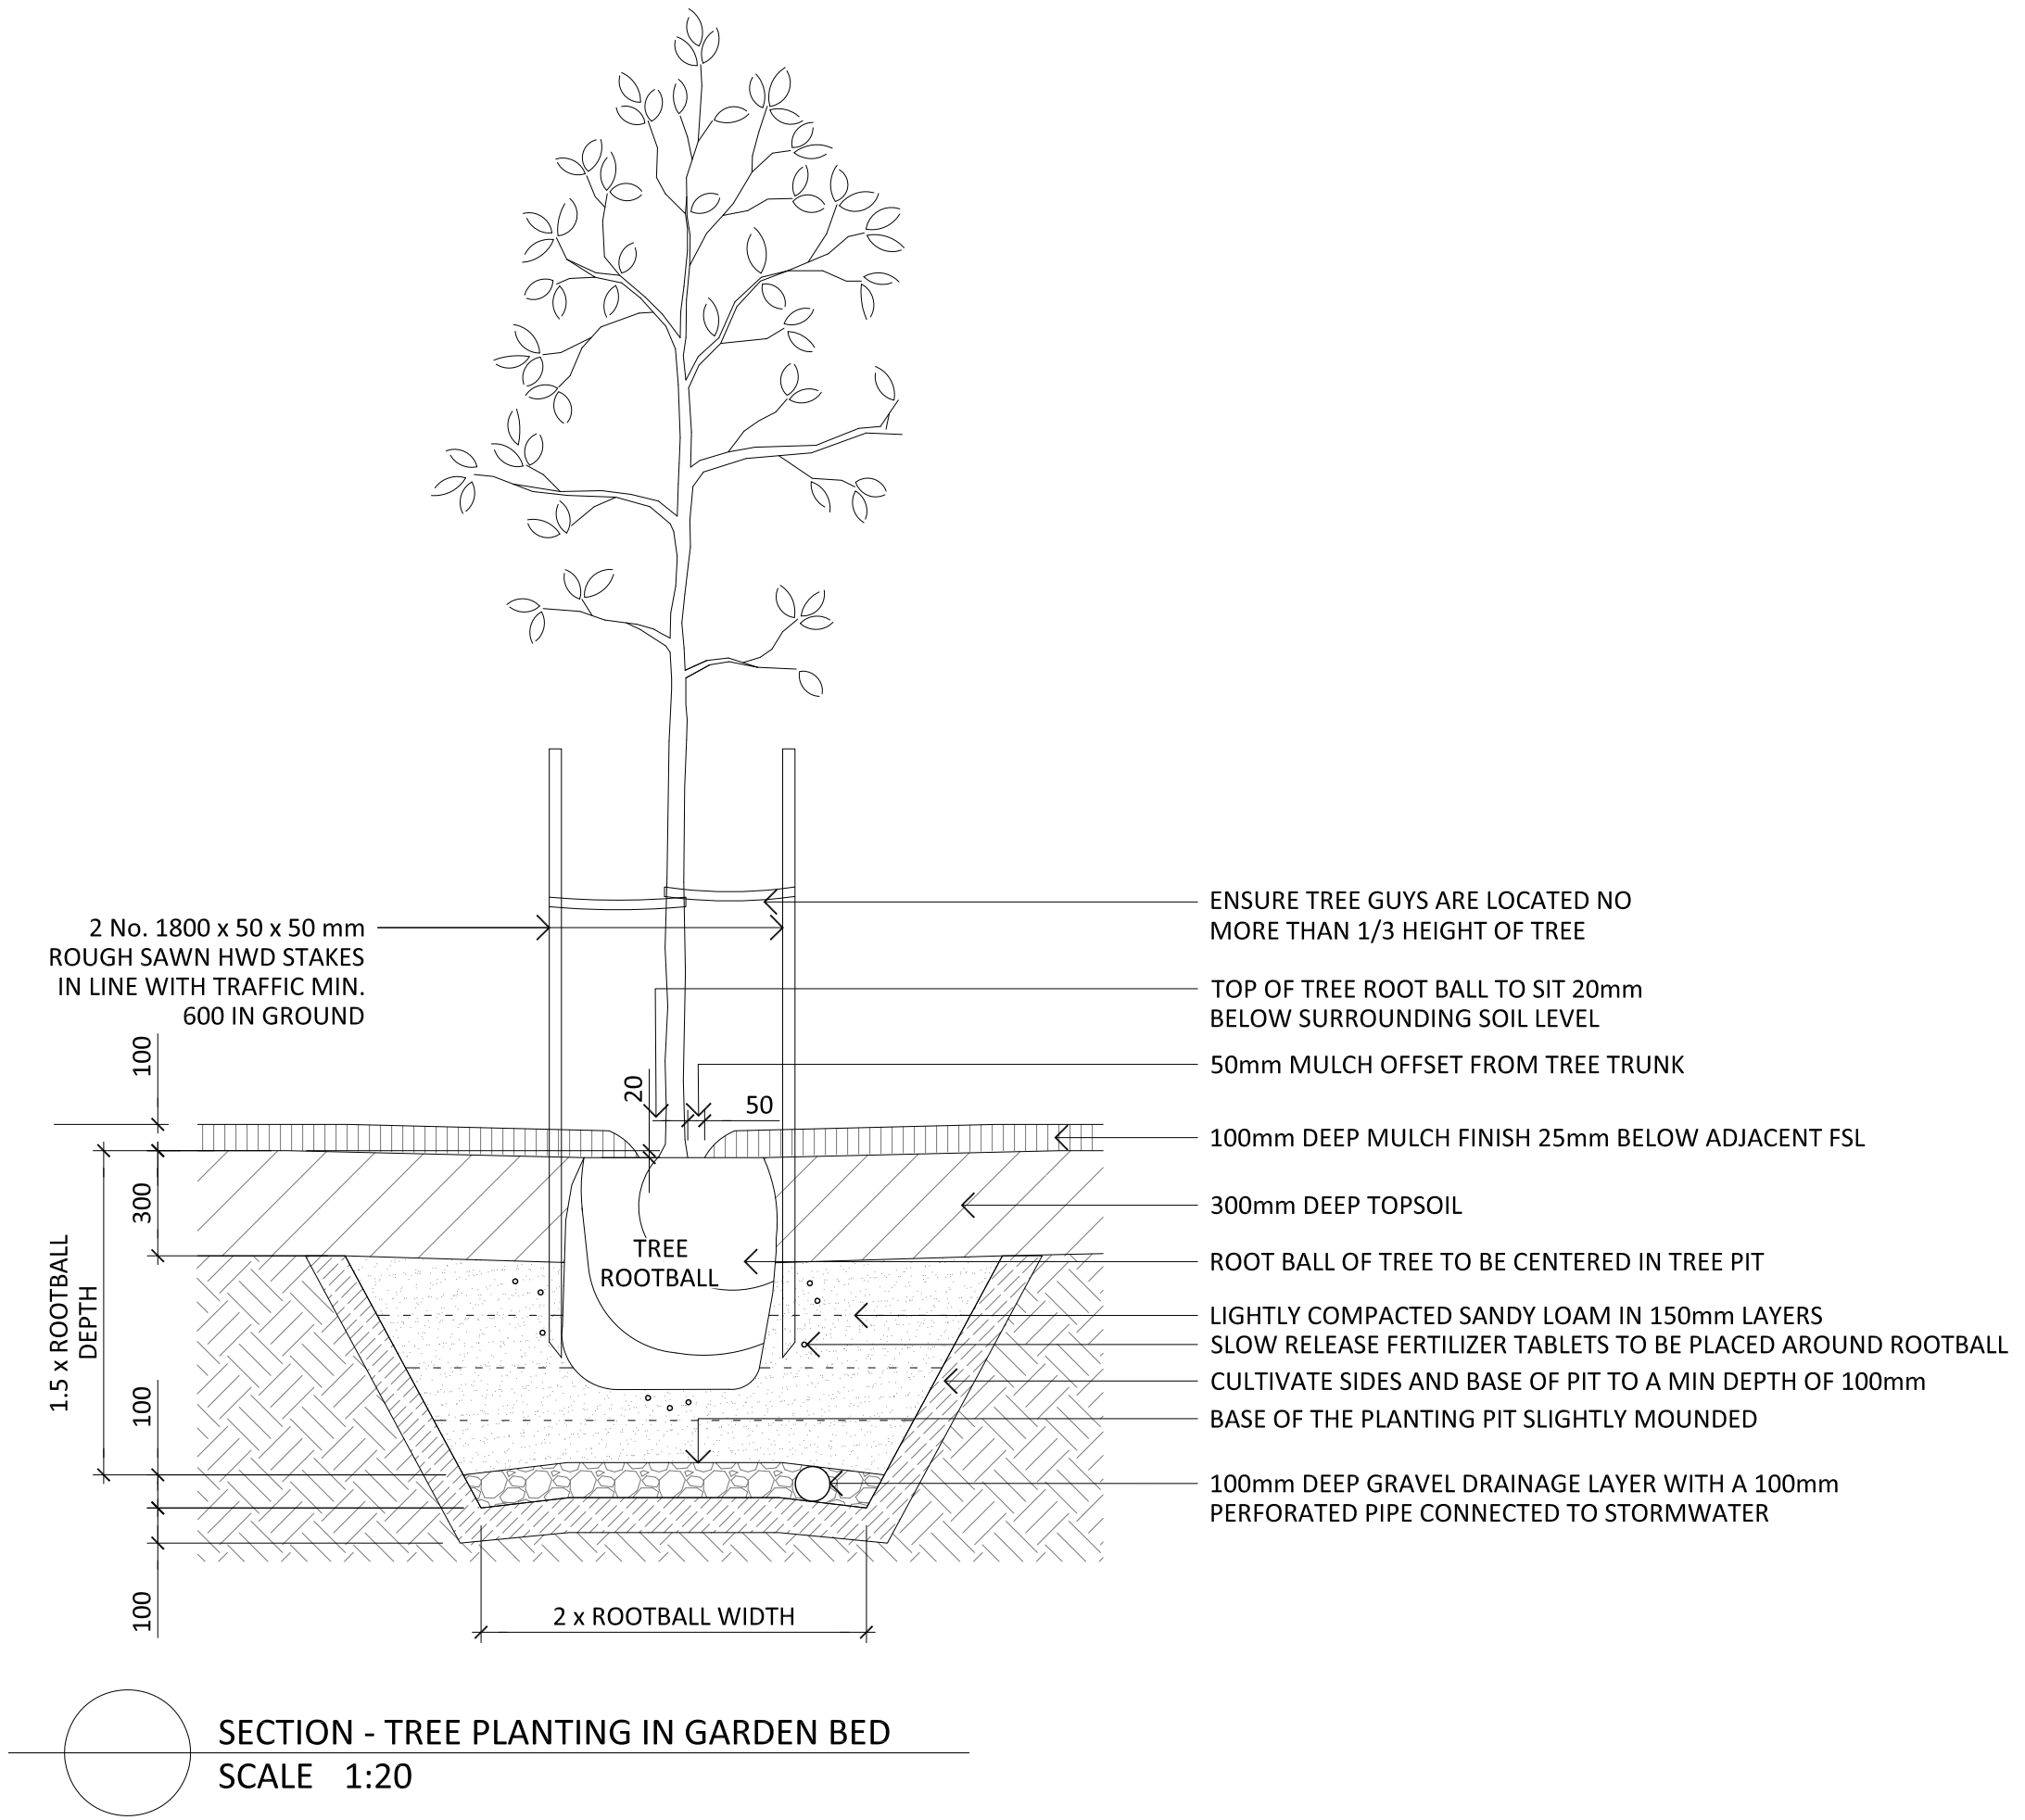

Issue	Comments	Date
A	ORIGINAL ISSUE	26/03/2015
B	REVISED TITLEBLOCK	26/04/2017

100	0	200	500	1000
LENGTH IN MILLIMETRES				
Scale 1:20 @ A3				
Designed	Approved	Drawn	Date of First Issue	
NI	NI	JS	26/03/2015	


Drawing name
TREE PLANTING (IN PLANTING BED)

O2LA STANDARD DRAWING	
Drawing Number	Issue
OSD-600-1	B


LANDSCAPE PLANS APPROVED

- To be constructed in accordance with the approved plan.
- Approval is subject to the observance of any amendments noted in red thereon.
- Landscape to be inspected and approved by Council Officers, prior to the use commencing on the land.
- No canopy trees to be planted within 3 metres of building foundations or rooflines (including neighbouring properties)
- All landscape materials, plants, vegetation and watering systems shown on the approved landscaping plan must be an acceptable quality and be installed and maintained to the satisfaction of the Chief Executive Officer.

Application No.: OPW/2022/1191
Dated: 24 November 2022

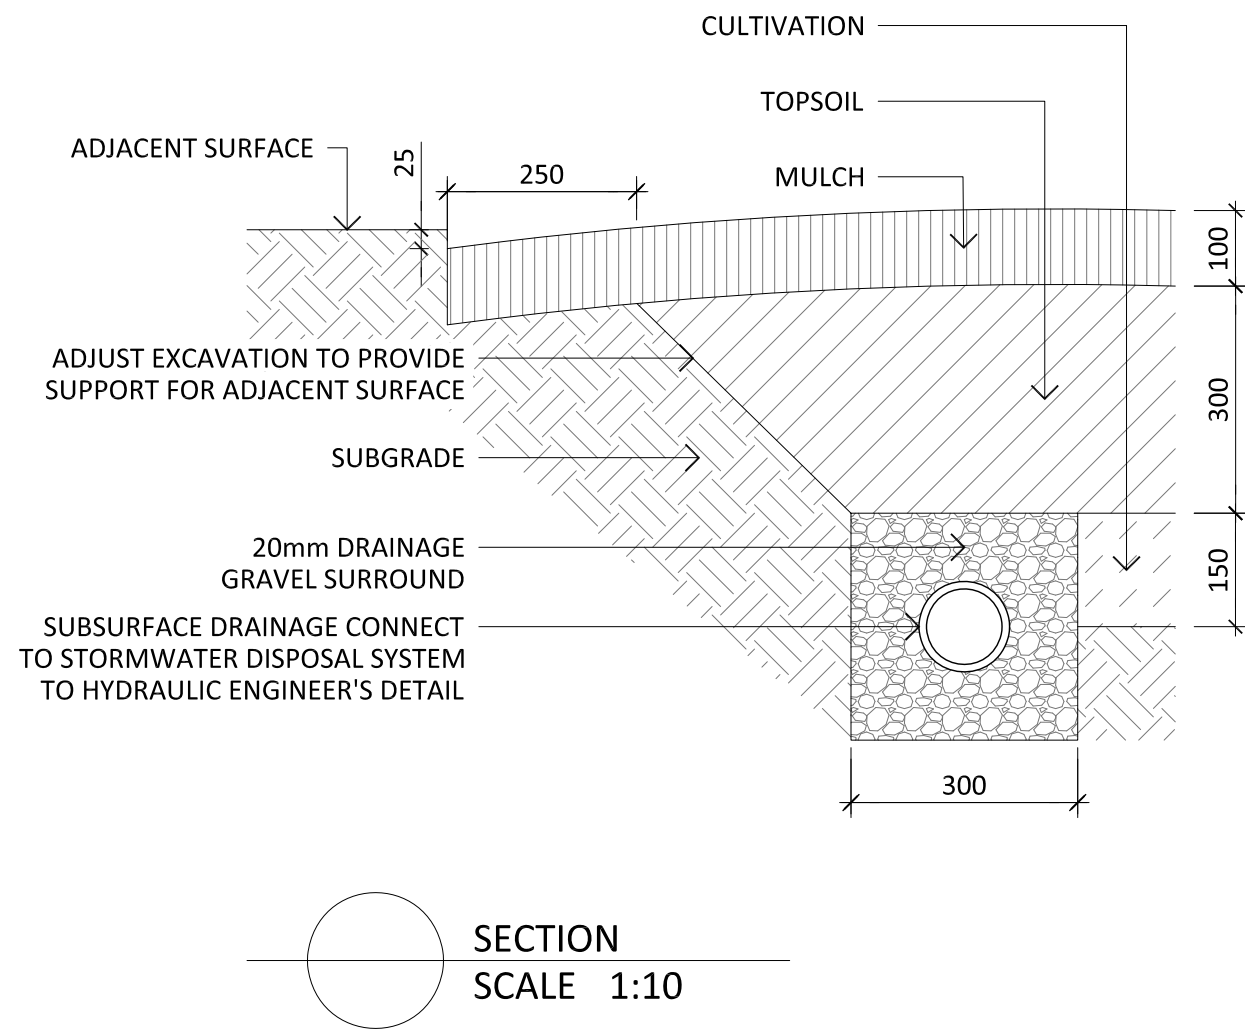

Issue	Comments	Date	LENGTH IN MILLIMETRES				Drawing name		O2LA STANDARD DRAWING	
A	ORIGINAL ISSUE	26/03/2015	50	0	100	200	PLANTING BED		Drawing Number	
B	REVISED TITLEBLOCK	26/04/2017	Scale 1:10 @ A3				(WITH SUBSOIL DRAINAGE)		OSD-650-1	
C	GENERAL UPDATE	13/03/2020	Designed	Approved	Drawn	Date of First Issue			Issue	
			NI	NI	JS	26/03/2015			C	

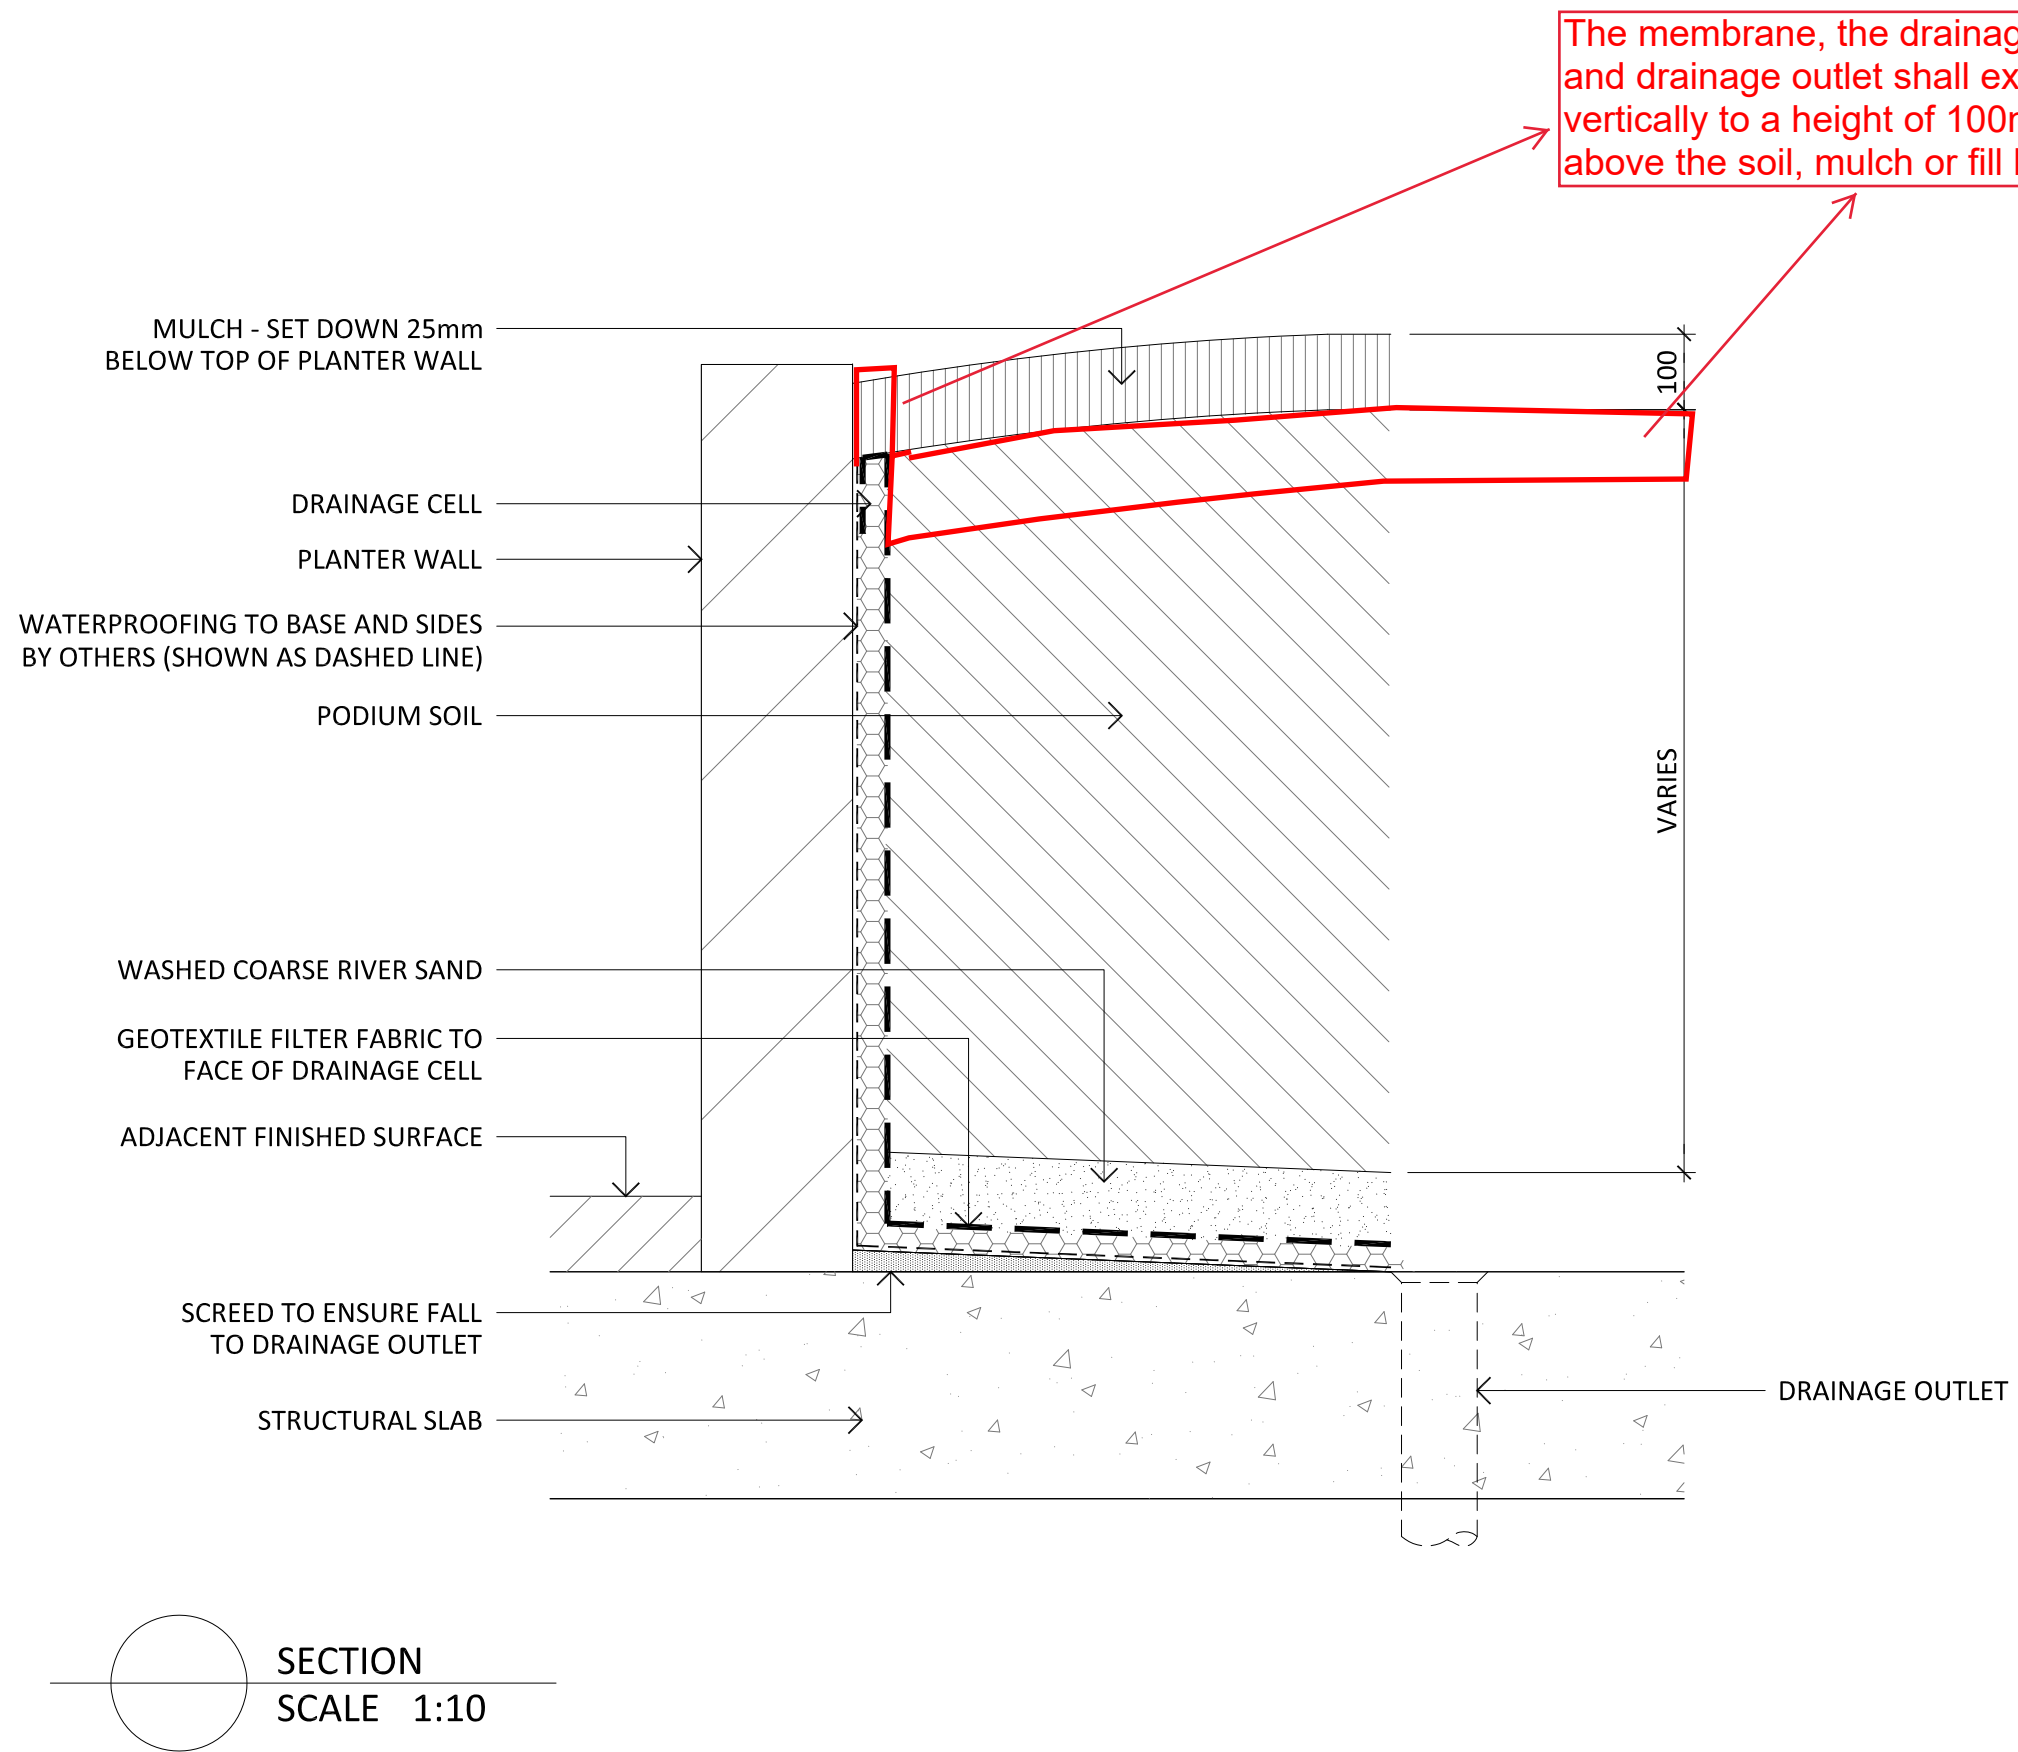

LANDSCAPE PLANS APPROVED

- To be constructed in accordance with the approved plan.
- Approval is subject to the observance of any amendments noted in red thereon.
- Landscape to be inspected and approved by Council Officers, prior to the use commencing on the land.
- No canopy trees to be planted within 3 metres of building foundations or rooflines (including neighbouring properties)
- All landscape materials, plants, vegetation and watering systems shown on the approved landscaping plan must be an acceptable quality and be installed and maintained to the satisfaction of the Chief Executive Officer.

Application No.: OPW/2022/1191

Dated: 24 November 2022



Issue	Comments	Date
E	UPDATED	22/05/2017
F	HYDROCELL RG30	22/05/2017
G	HYDROCELL DELETED, HORIZONS ADDED	20/08/2021
H	HORIZONS DELETED	08/03/2022

LENGTH IN MILLIMETRES				
50	0	100	200	500
Scale 1:10 @ A3				
Designed	Approved	Drawn	Date of First Issue	
NI	NI	JM	26/03/2015	

Drawing name

PODIUM PLANTER

O2LA STANDARD DRAWING	
Drawing Number	Issue
OSD-660-1	H