PLANS AND DOCUMENTS referred to in the DEVELOPMENT APPROVAL

Application No: MIN/2024/337

Dated: 16 July 2024

Development shall comply with the conditions of approval as detailed in the Decision Notice and Council's Planning Scheme, Local Laws and Planning Policies

COURTNEY DRIVE
UPPER COOMERA

OPERATIONAL WORKS
STAGE 02
No. 41901-02

CONSTRUCTION ISSUE

SCHEDULE OF DRAWINGS

NUMBER	REV. NO.	TITLE
GENERAL		
41901-02-000	E	COVER SHEET
41901-02-003	A	SAFETY IN DESIGN
41901-02-004	A	RISK MATRIX & NOTES
41901-02-005	C	ROAD HIERARCHY & STAGING PLAN SHEET 01
41901-02-006	A	ROAD HIERARCHY & STAGING PLAN SHEET 02
EARTHWORKS: EXISTING FEATURES & DEMOLITION		
41901-02-020	C	PLAN SHEET 01
41901-02-021	A	PLAN SHEET 02
EARTHWORKS: BULK EARTHWORKS CUT FILL		
41901-02-040	C	PLAN SHEET 01
41901-02-041	A	PLAN SHEET 02
41901-02-042	A	PLAN SHEET 03
41901-02-045	B	GEOTECHNICAL REQUIREMENTS PLAN
41901-02-050	C	EARTHWORKS SECTION KEY PLAN
41901-02-051	B	SECTIONS-SHEET 01
41901-02-052	C	SECTIONS-SHEET 02
EARTHWORKS: RETAINING WALL & DETAIL GRADING		
41901-02-060	C	PLAN SHEET 01
41901-02-060A	B	PLAN SHEET 01 A
41901-02-061	C	PLAN SHEET 02
41901-02-062	B	PLAN SHEET 03
41901-02-063	B	PLAN SHEET 04
41901-02-070	B	DETAILS
41901-02-071	A	FINAL TRIM DETAILS
EARTHWORKS: PADMOUNT SECTIONS		
41901-02-076	C	PADMOUNT 6 SHEET 01
EARTHWORKS: FINAL SURFACE & SEDIMENT AND EROSION CONTROL		
41901-02-080	C	PLAN SHEET 01
41901-02-081	B	PLAN SHEET 02
41901-02-082	B	PLAN SHEET 03
41901-02-083	A	PLAN SHEET 04
ROADS: COMBINED SERVICES		
41901-02-090	C	PLAN SHEET 01
41901-02-091	B	PLAN SHEET 02
41901-02-092	B	PLAN SHEET 03
ROADS: ROADWORKS		
41901-02-100	D	PLAN SHEET 01
41901-02-101	B	PLAN SHEET 02
41901-02-102	A	PLAN SHEET 03
41901-02-120	A	DETAILS
ROADS: LONGITUDINAL SECTIONS		
41901-02-200	B	COURTNEY DRIVE-ROAD 01 SHEET 01
41901-02-201	B	COURTNEY DRIVE-ROAD 01 (Cont.) SHEET 02
41901-02-202	A	ROAD 03
41901-02-203	B	ROAD 04 & ROAD 07
41901-02-204	A	ROAD 10 & ACCESS BASIN 01
ROADS: CROSS SECTIONS		
41901-02-300	A	COURTNEY DRIVE-ROAD 01 SHEET 01
41901-02-301	B	COURTNEY DRIVE-ROAD 01 (Cont.) SHEET 02
41901-02-302	C	COURTNEY DRIVE-ROAD 01 (Cont.) SHEET 03
41901-02-303	A	ROAD 03 SHEET 01
41901-02-304	A	ROAD 03 (Cont.) SHEET 02
41901-02-305	A	ROAD 04
41901-02-306	B	ROAD 07 & ROAD 10
41901-02-307	A	ACCESS BASIN 01
ROADS: INTERSECTION GRADING		
41901-02-400	B	DETAILS
ROADS: JOINTING DETAILS		
41901-02-410	B	DETAILS SHEET 01
41901-02-411	C	DETAILS SHEET 02
ROADS: LINEMARKING AND SIGNAGE		
41901-02-420	B	PLAN SHEET 01
41901-02-421	B	PLAN SHEET 02
SEWER: SEWER RETICULATION		
41901-02-500	C	PLAN SHEET 01
41901-02-501	B	PLAN SHEET 02
41901-02-502	A	PLAN SHEET 03
41901-02-510	A	DETAILS
SEWER: PROFILES		
41901-02-530	B	SHEET 01
41901-02-531	B	SHEET 02
41901-02-532	B	SHEET 03
41901-02-533	B	SHEET 04
41901-02-534	B	SHEET 05
41901-02-535	B	SHEET 06
SEWER: HOUSE CONNECTION PROFILES		
41901-02-550	B	SHEET 01
41901-02-551	B	SHEET 02
DRAINAGE: STORMWATER		
41901-02-600	C	PLAN SHEET 01
41901-02-601	B	PLAN SHEET 02
41901-02-602	A	PLAN SHEET 03
DRAINAGE: PROFILES		
41901-02-620	D	SHEET 01
41901-02-621	B	SHEET 02
41901-02-622	B	SHEET 03
41901-02-623	B	SHEET 04
41901-02-624	A	SHEET 05
41901-02-625	A	SHEET 06
41901-02-626	C	SHEET 07
DRAINAGE: PIT OUTLETS & TYPICAL DETAILS		
41901-02-640	C	OUTLETS & TYPICAL DETAILS SHEET 01
41901-02-641	B	RCBC OUTLET
41901-02-642	C	STABILISATION PLAN
DRAINAGE: PIT DETAILS		
41901-02-650	B	PIT DETAILS SHEET 01
41901-02-651	B	PIT DETAILS SHEET 02
41901-02-652	B	PIT DETAILS SHEET 03
DRAINAGE: BASINS & CULVERTS		
41901-02-660	B	PLAN SHEET 01
41901-02-661	B	PLAN SHEET 02
41901-02-662	A	SECTIONS SHEET 01
41901-02-663	A	SECTIONS SHEET 02
41901-02-664	B	DETAILS SHEET 01
41901-02-665	B	DETAILS SHEET 02
DRAINAGE: CATCHMENT		
41901-02-670	C	PLAN SHEET 01
41901-02-671	A	PLAN SHEET 02
DRAINAGE: CALCULATION TABLES		
41901-02-680	C	MINOR CALC TABLE SHET 01
41901-02-680A	B	MINOR CALC TABLE SHEET 02
41901-02-681	C	MAJOR CALC TABLE SHEET 01
WATER: WATER RETICULATION		
41901-02-700	B	PLAN SHEET 01
41901-02-701	B	PLAN SHEET 02
41901-02-702	B	PLAN SHEET 03
41901-02-710	A	DETAILS

MORTONS urbansolutions
Urban & Regional Planning
Civil Engineering
Project Coordination

COMPASS ASSURANCE ISO 9001 QUALITY

CLIENT

HB Land


SUB-CONSULTANTS

BIOME WATER AND ENVIRONMENTAL CONSULTING

Robin Russell & ASSOCIATES PTY. LTD.

BENNETT + BENNETT

LOCALITY PLAN

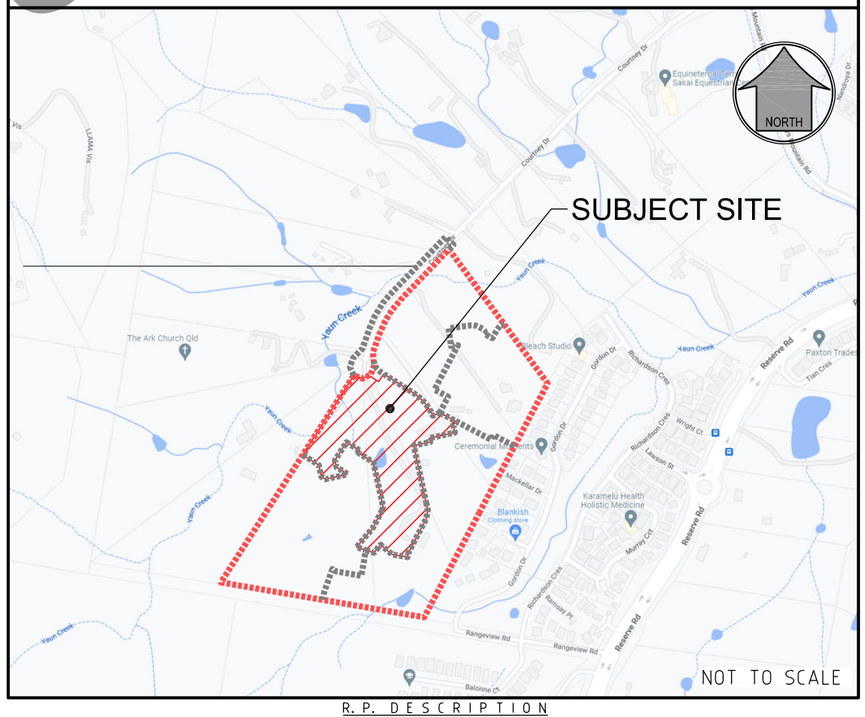

R. P. DESCRIPTION
LOT 188, 189, 190, 191 & 192 ON RP173728
COURTNEY DRIVE
LOCALITY OF UPPER COOMERA
LOCAL AUTHORITY - GOLD COAST CITY COUNCIL

DRAWING NUMBER	AMEND.
41901-02-000	E

F:\Autocad Client\419 - HB Land\01 - Courtney Drive\Precinct-Stage 02\Engineering Drawings\Current\41901-02-000.dwg, COVER SHEET, 15/07/2024 2:24:21 PM, 1:2

PLANS AND DOCUMENTS referred to in the DEVELOPMENT APPROVAL

Application No: MIN/2024/337

Dated: 16 July 2024

Development shall comply with the conditions of approval as detailed in the Decision Notice and Council's Planning Scheme, Local Laws and Planning Policies

DESIGN ITEM	POTENTIAL HAZARD	PHASE	THOSE AT RISK	PRE-TREATMENT RISK ASSESSMENT				TREATMENT OPTIONS	- ADOPTED TREATMENT - REASON - BY WHOM	RESIDUAL RISK ASSESSMENT				ONGOING RESPONSIBILITY
				SEVERITY	LIKELIHOOD (RISK)	Risk Product	RISK RATING			SEVERITY	LIKELIHOOD (RISK)	Risk Product	RISK RATING	
Road Design	Traffic Speed	Operational	Public	Death	Possible	15	Significant	- Design compliance with Local Council requirements, Queensland Streets and appropriate sections of Austroads. - Lot layout to consider natural slow points in road layout. - Consideration of slow points within Local street network.	Town Planners and Council to ensure original layout reduces risk (i.e. minimise long straight roads). Designer to consider inclusion of slow points in consultation with Council and prepare design in accordance with applicable standards.	Permanent Disability	Rare	4	Low	Closed
Road Design	Unclear priorities at intersections or slow points	Operational	Public	Death	Unlikely	10	High	- Design compliance with Local Council requirements, Queensland Streets and appropriate sections of Austroads. - Linemarking to be provided in accordance with MUTCD and Council's approval.	Designer to incorporate linemarking in accordance with MUTCD and Council's requirements to assist in minimising confusion at intersections and slow points.	Permanent Disability	Rare	4	Low	Closed
Traffic Management	Accidents at the interface between public and work site	Construction	Contractor & Public	Permanent Disability	Unlikely	8	Moderate	- Traffic Management Plan to be prepared by suitable qualified consultant. - TMP to consider temporary lighting, signals, barriers/separation and other traffic management measures.	Contractor to prepare site specific TMP incorporating appropriate measures to minimise risk at interface of work site and public roads.	Permanent Disability	Rare	4	Low	On Going: Contractor to monitor until end of Construction Phase
Public Access	Public wandering onto work site	Construction	Contractor & Public	Death	Unlikely	10	High	- Appropriate signage to be installed at public interface - Fencing to discourage accidental access to site	Contractor to prepare site specific Construction Management Plan to minimise risk of public access to the site.	Death	Rare	5	Moderate	On Going: Contractor to monitor until end of Construction Phase
Existing Services	Working on or near existing services - Electrocution, disrupt critical services, explosion	Construction	Contractor, Public & Asset Owner	Permanent Disability	Possible	12	High	- Design to consider existing services and include appropriate clearances or protection measures. - Dial Before You Dig to be performed prior to design commencing. - Developer provide survey of any critical existing infrastructure prior to design. - Design drawings to show known services. - Connection point to be detailed in accordance with the relevant standard.	Contractor to physically locate and confirm service location information. Dial Before You Dig logo to be added to drawings. Connection details design and annotated on drawings in accordance with Water Authority requirements.	Death	Rare	5	Moderate	On Going: Contractor to monitor until end of Construction Phase
Retaining Walls	Failing	Construction, operational, maintenance and demolition	Contractor, Public & Asset Owner	Medical Treatment	Possible	9	High	- Minimise the height if retaining walls. - Minimise the number of locations.	Batters designed in all locations practical. Heights of wall minimised by civil designer. Safety fencing requirements included on drawings.	Medical Treatment	Unlikely	6	Moderate	On Going: Contractor to monitor until end of Construction Phase
Earthworks Surface	Working on steep Batters	Construction and maintenance	Contractor & Asset Owner	Medical Treatment	Possible	9	High	- Minimise the height of batters. - Minimise the number of locations. - Extend services up batters where possible to reduce future works on batter slopes.	Batters designed to minimum practical height in all locations practical. Services to be constructed up the batters to ensure future batter stability.	Medical Treatment	Rare	3	Low	On Going: Contractor to monitor until end of Construction Phase and Asset Owner to continue monitoring for future maintenance.
Deep excavation	Failing or collapse	Construction, Maintenance and demolition	Public, Client, Supervisors, Contractors	Permanent Disability	Possible	12	High	- Minimise depth of structure. - Bench deep trenches appropriately to minimise trench collapse risk. - Design in accordance with relevant standard. - Minimise the number of structures.	Structures designed in accordance with local authority requirements. Utilise RIGS sewer to reduce the number of access points. Graded pipelines as shallow as practical to reduce depth. Contractor to manage open excavations during construction in accordance with their Management Plans.	Permanent Disability	Rare	4	Low	On Going: Contractor to Monitor until end of Construction Phase
Stormwater and Sewer	Falling and Trench Collapse	Construction and Maintenance	Contractor & Asset Owner	Death	Unlikely	10	High	- Minimise depth of drainage lines. - Design in accordance with relevant standard.	Infrastructure designed in accordance with local authority requirements. Graded pipelines as shallow as practical to reduce depth.	Death	Rare	5	Moderate	On going: Contractor to Monitor until end of Pipe line construction completed.
Stormwater Inlets	Drowning	Operational	Public	Death	Possible	15	Significant	- Design to minimise stormwater inlets within public areas. - Install inlet grates on stormwater inlets where required.	Risk assessment of stormwater inlets undertaken in accordance with QUDM requirements and stormwater inlet grates have been specified where required.	Death	Rare	5	Moderate	Closed
Temporary Stormwater Construction Sediment Ponds	Drowning	Construction and Maintenance	Public, Contractors & Council	Death	Possible	15	Significant	- Site fencing and warning signs to be installed. - Minimise depth - Design access and egress in accordance with QUDM and Asset Owner requirements.	Notes annotated on civil drawings for contractor to provide fencing and signage. Designed in accordance Qudm for access and egress. Depth minimised.	Death	Rare	5	Moderate	Monitor until end of Construction of Sediment Basins
Permanent Stormwater Basin Infrastructure	Drowning	Maintenance and demolition	Public	Death	Possible	15	Significant	- Site fencing and warning signs to be installed. - Minimise depth - Design access and egress in accordance with QUDM and Asset Owner requirements.	Notes annotated on civil drawings for contractor to provide fencing and signage. Designed in accordance Qudm for access and egress. Depth minimised.	Death	Rare	5	Moderate	Monitor until end of Construction of Sediment Basins

PROJECT NAME

COURTNEY DR UPPER COOMERA

STAGE 02

RP DESCRIPTION

LOT 188, 189, 190, 191 & 192 ON RP173728
COURTNEY DRIVE
LOCALITY OF UPPER COOMERA
LOCAL AUTHORITY - GOLD COAST CITY COUNCIL

CLIENT

HB Land

REV	DATE	DESCRIPTION	INT
A	13-10-23	COUNCIL ISSUE	EP

COPYRIGHT IS VESTED IN MORTONS-URBAN SOLUTIONS AND WRITTEN CONSENT IS REQUIRED PRIOR TO REPRODUCTION. DO NOT SCALE FROM THIS DRAWING.

ASSOCIATED CONSULTANTS

BIOME WATER AND ENVIRONMENTAL CONSULTING

Robin Russell & ASSOCIATES PTY. LTD.

BENNETT+BENNETT

DRAWING TITLE

SAFETY IN DESIGN

MORTONS urbansolutions
Urban & Regional Planning
Civil Engineering
Project Coordination

MUS Pty Ltd T/As:
Mortons-Urban Solutions
ABN: 39 116 375 065
mortons@urbansolutions.net.au
www.urbansolutions.net.au
Tel 07 5571 1099

Postal Address
PO Box 2484
Southport QLD 4215

Gold Coast Office
Suite 9, 19 Short St
Southport QLD 4215

DESIGNED	RB	DRAWN	EP
APPROVED	RPEQ 4706	DATE	13-10-23

DRAWING NUMBER 41901-02-003

REV A

F:\Autocad Client\419 - HB Land\01 - Courtney Drive\Precinct-Stage 02\Engineering Drawings\Current\41901-02-003.dwg, SAFETY IN DESIGN, 21/06/2024 1:15:06 PM, 1:2

PLANS AND DOCUMENTS referred to in the DEVELOPMENT APPROVAL

Application No: MIN/2024/337

Dated: 16 July 2024

Development shall comply with the conditions of approval as detailed in the Decision Notice and Council's Planning Scheme, Local Laws and Planning Policies

Likelihood ↑	Consequence → Minor / Insignificant (1)	First Aid Treatment (2)	Medical Treatment (3)	Permanent Disability (4)	Death (5)
Almost Certain (5)	Moderate	High	Significant	Significant	Significant
Likely (4)	Low	Moderate	High	Significant	Significant
Possible (3)	Low	Moderate	High	High	Significant
Unlikely (2)	Low	Low	Moderate	Moderate	High
Rare (1)	Low	Low	Low	Low	Moderate

LEVEL OF RISK
SIGNIFICANT 15 to 25
HIGH 9 to 14
MODERATE 5 to 8
LOW 1 to 4

NOTES:

1. THIS SID REGISTER IN NO WAY RELIEVES THE PRINCIPAL, CONTRACTOR, ASSET OWNER OR ANY OTHER PARTY OF THEIR OWN OBLIGATIONS UNDER THE WORKPLACE HEALTH AND SAFETY ACT AND THEIR DUTY OF CARE. THIS IS PROVIDED AS INFORMATION FOR PARTIES TO ASSIST IN MEETING THEIR OWN OBLIGATIONS AND IS BY NO MEANS A COMPLETE LIST. THIS SID REGISTER OR THE NOTES AND DETAILS INCLUDED WITHIN THE DESIGN DRAWINGS DO NOT RELIEVE THE PRINCIPAL CONTRACTOR OF ANY OBLIGATION UNDER ALL RELEVANT LEGISLATION OR GUIDELINE.
2. ALL CONTRACTORS AND ASSET OWNERS REMAIN RESPONSIBLE IN THE PREPARATION OF THEIR OWN SAFETY MANAGEMENT PLANS AND SUITABLE SAFE WORK METHOD STATEMENTS.
3. THIS SID REGISTER IDENTIFIES ATYPICAL FEATURES OF THE DESIGN. COMMON/TYPICAL FEATURES OF THIS DESIGN ARE NOT INCLUDED IN THIS SID REGISTER.

PROJECT NAME

COURTNEY DR UPPER COOMERA

STAGE 02

RP DESCRIPTION

LOT 188, 189, 190, 191 & 192 ON RP173728
COURTNEY DRIVE
LOCALITY OF UPPER COOMERA
LOCAL AUTHORITY - GOLD COAST CITY COUNCIL

CLIENT

HB Land

REV	DATE	DESCRIPTION	INT
A	13-10-23	COUNCIL ISSUE	EP

COPYRIGHT IS VESTED IN MORTONS-URBAN SOLUTIONS AND WRITTEN CONSENT IS REQUIRED PRIOR TO REPRODUCTION. DO NOT SCALE FROM THIS DRAWING.

ASSOCIATED CONSULTANTS

BIOME WATER AND ENVIRONMENTAL CONSULTING

Robin Russell & ASSOCIATES PTY. LTD.

BENNETT+BENNETT

DRAWING TITLE

RISK MATRIX & NOTES

MORTONS urbansolutions
Urban & Regional Planning
Civil Engineering
Project Coordination

MUS Pty Ltd T/As:
Mortons-Urban Solutions
ABN: 39 116 375 065

Postal Address
PO Box 2484
Southport QLD 4215

mortons@urbansolutions.net.au
www.urbansolutions.net.au
Tel 07 5571 1099

Gold Coast Office
Suite 9, 19 Short St
Southport QLD 4215

DESIGNED	RB	DRAWN	EP
APPROVED		RPEQ 4706	DATE 13-10-23

DRAWING NUMBER 41901-02-004

REV A

F:\Autocad Client\419 - HB Land\01 - Courtney Drive\Precinct-Stage 02\Engineering Drawings\Current\41901-02-003.dwg, RISK MATRIX & NOTES, 21/06/2024 1:15:39 PM, 1:2

PLANS AND DOCUMENTS referred to in the DEVELOPMENT APPROVAL

Application No: MIN/2024/337

Dated: 16 July 2024

Development shall comply with the conditions of approval as detailed in the Decision Notice and Council's Planning Scheme, Local Laws and Planning Policies

GENERAL

1. CONTRACT SPECIFICATIONS
   ALL DRAWINGS ARE TO BE READ IN CONJUNCTION WITH THE CONTRACT SPECIFICATION.
2. SETOUT
   SURVEY SETOUT INFORMATION HAS BEEN ESTABLISHED ON SITE BY THE PRINCIPAL'S SURVEYOR TO ENABLE THE CONTRACTOR TO ACCURATELY SETOUT THE WORKS TO THE CO-ORDINATES SHOWN. SETOUT INFORMATION SHALL NOT BE OBTAINED BY SCALING FROM THESE DRAWINGS.
3. DATUM
   LEVELS SHOWN ARE TO A.H.D.
4. TRENCH SPOIL
   ALL MATERIALS ARISING FROM ROADS & SERVICES ARE TO BE COMPACTED TO FUTURE STAGES. TO LEVEL 1 IF NO SPOIL AREA IS AVAILABLE THESE MATERIALS SHALL BE TRUCKED TO A LICENSED TIP. THESE WORKS FORM PART OF THE CONTRACTED WORKS.
5. CHECK ELECTRONIC SETOUT
   CONTRACTOR IS RESPONSIBLE TO ENSURE ANY ELECTRONIC DATA FILES MATCH THE DRAWINGS.
6. PRE START
   a. ERECT SITE SIGNAGE. CONSTRUCT ENTRY & EXIT POINT AS INDICATED.
   b. CONSTRUCT VEHICLE WASHDOWN AREA & ASSOCIATED SILT MANAGEMENT DEVICES.
   c. CONSTRUCT SITE OFFICE & STORAGE COMPOUND AREA.
   d. INSTALL EROSION & SEDIMENT CONTROL DEVICES AS PER THE CONTRACTOR'S EROSION & SEDIMENT CONTROL PLAN.
   e. ERECT TEMPORARY TREE PROTECTION FENCING IN ACCORDANCE WITH THE APPROVED VEGETATION MANAGEMENT PLAN & AUTHORITIES APPROVAL CONDITIONS (IF REQUIRED).
7. HEALTH & SAFETY
   ALL WORKS UNDERTAKEN BY THE CONTRACTOR SHALL COMPLY WITH ALL APPLICABLE WORKPLACE HEALTH & SAFETY LEGISLATION.
8. STOCKPILING
   STOCKPILING OF ANY SURPLUS MATERIAL IS NOT PERMITTED

PROJECT SPECIFIC REPORTS

THE CONTRACTOR MUST FOLLOW THE RECOMMENDATIONS & PROCEDURES OUTLINED IN THE FOLLOWING REPORTS AT ALL TIMES.


a) GEOTECHNICAL INVESTIGATION REPORTS (INCLUDING ANY ACID SULPHATE OR DISPERSIVE SOIL REPORTING)
b) VEGETATION & FAUNA MANAGEMENT PLANS
c) OTHER MANAGEMENT PLANS NOMINATED IN THE CONTRACT, AUTHORITIES APPROVAL CONDITIONS OR BY THE SUPERINTENDENT.

LEGEND

- RESIDENTIAL ACCESS STREET (7.5m CARRIAGEWAY)
- RESIDENTIAL COLLECTOR STREET (7.5m CARRIAGEWAY)

REFER 120 DRAWING SERIES FOR TYPICAL SECTIONS

- EXISTING PROPERTY LINE
- EXISTING KERB (INVERT)
- FUTURE PROPERTY LINE
- FUTURE KERB (INVERT)
- PROPOSED PROPERTY LINE
- PROPOSED KERB (INVERT)
- SITE BOUNDARY
- STAGE BOUNDARY
- LIMIT OF WORKS BOUNDARY

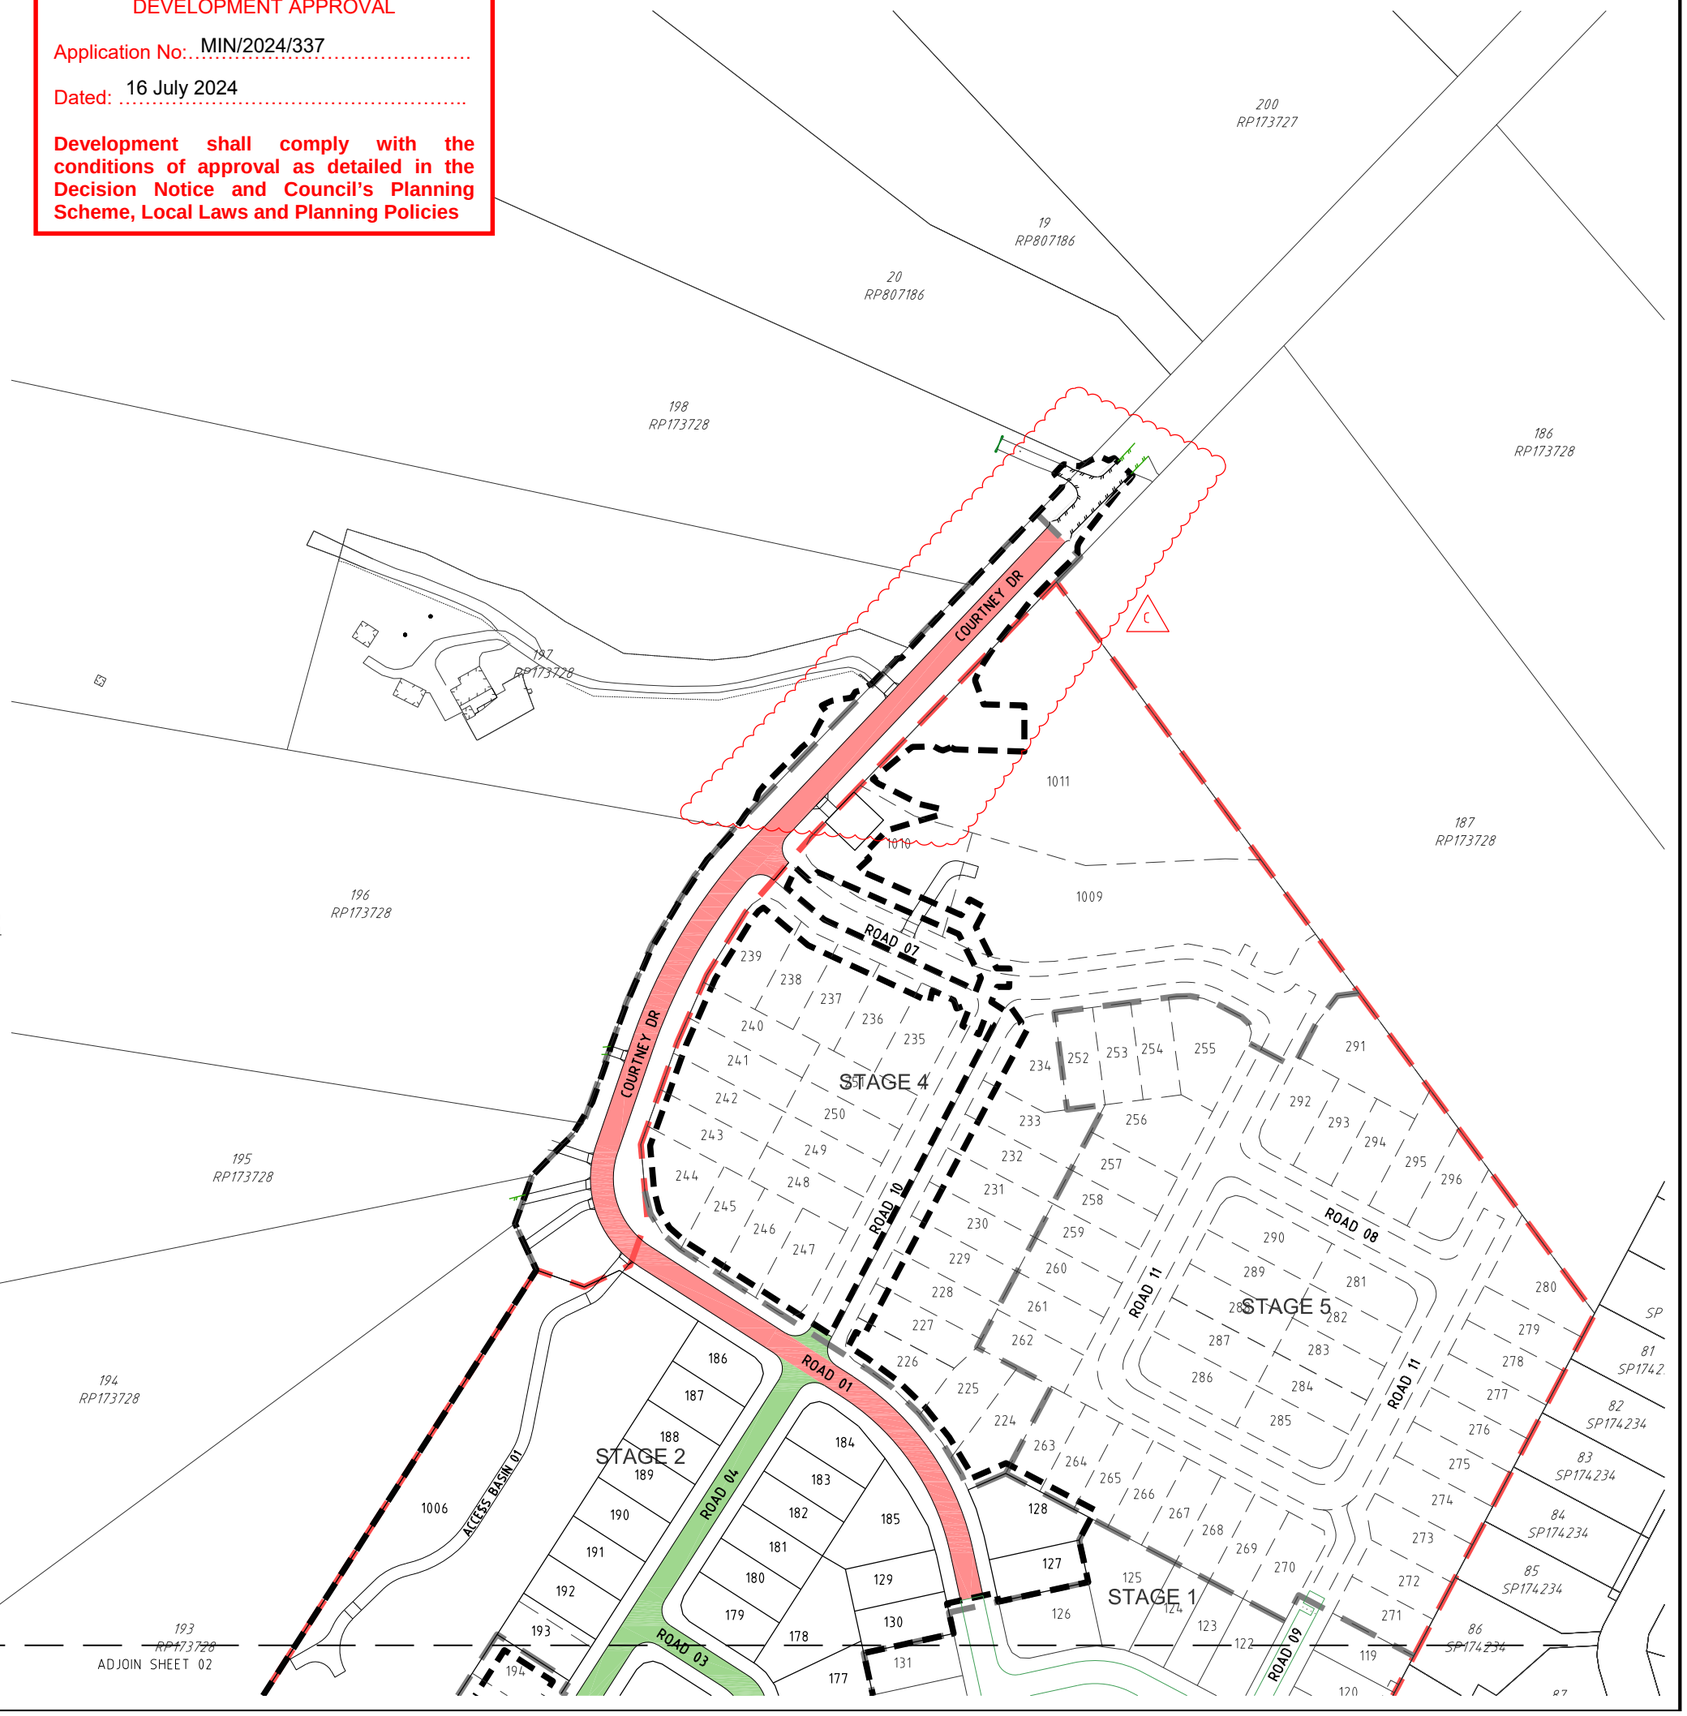

DIAL BEFORE YOU DIG www.1100.com.au

PROJECT NAME

COURTNEY DR UPPER COOMERA

STAGE 02

RP DESCRIPTION

LOT 188, 189, 190, 191 & 192 ON RP173728
COURTNEY DRIVE
LOCALITY OF UPPER COOMERA
LOCAL AUTHORITY - GOLD COAST CITY COUNCIL

CLIENT

HB Land

REV	DATE	DESCRIPTION	INT
C	13-06-24	LIMIT OF WORKS AMENDED	RK
B	17-01-24	COURTNEY DR & LIMIT OF WORKS AMENDED	EP
A	13-10-23	COUNCIL ISSUE	EP

COPYRIGHT IS VESTED IN MORTONS-URBAN SOLUTIONS AND WRITTEN CONSENT IS REQUIRED PRIOR TO REPRODUCTION. DO NOT SCALE FROM THIS DRAWING.

ASSOCIATED CONSULTANTS

BIOME WATER AND ENVIRONMENTAL CONSULTING
Robin Russell & ASSOCIATES PTY. LTD.
BENNETT + BENNETT

DRAWING TITLE

ROAD HIERARCHY,
STAGING PLAN
&
GENERAL NOTES
SHEET 01

MORTONS urbansolutions
Urban & Regional Planning
Civil Engineering
Project Coordination
MUS Pty Ltd T/As:
Mortons-Urban Solutions
ABN: 39 116 375 065
mortons@urbansolutions.net.au
www.urbansolutions.net.au
Tel 07 5571 1099
Postal Address
PO Box 2484
Southport QLD 4215
Gold Coast Office
Suite 9, 19 Short St
Southport QLD 4215

DESIGNED RB | DRAWN EP
APPROVED RPEQ 4706 | DATE 13-10-23

DRAWING NUMBER 41901-02-005 | REV C

F:\Autocad Client\419 - HB Land\01 - Courtney Drive\Precinct-Stage 02\Engineering Drawings\Current\41901-02-005.dwg, ROAD HIERARCHY & STAGING PLAN SHEET 01, 21/06/2024 1:15:59 PM, 1:2

LEGEND

- RESIDENTIAL ACCESS STREET (7.5m CARRIAGEWAY)
- RESIDENTIAL COLLECTOR STREET (7.5m CARRIAGEWAY)

REFER 120 DRAWING SERIES FOR TYPICAL SECTIONS

- EXISTING PROPERTY LINE
- EXISTING KERB (INVERT)
- FUTURE PROPERTY LINE
- FUTURE KERB (INVERT)
- PROPOSED PROPERTY LINE
- PROPOSED KERB (INVERT)
- SITE BOUNDARY
- STAGE BOUNDARY
- LIMIT OF WORKS BOUNDARY

DIAL BEFORE YOU DIG www.1100.com.au

PLANS AND DOCUMENTS referred to in the DEVELOPMENT APPROVAL

Application No: MIN/2024/337

Dated: 16 July 2024

Development shall comply with the conditions of approval as detailed in the Decision Notice and Council's Planning Scheme, Local Laws and Planning Policies

ADJOIN SHEET 01

STAGE 1
STAGE 2
STAGE 3

ROAD 01
ROAD 02
ROAD 03
ROAD 04
ROAD 06
ROAD 09
MACKELLAR DR
PATTERSON CT
GORDON DR
RANGEVIEW ROAD

PROJECT NAME

COURTNEY DR UPPER COOMERA

STAGE 02

RP DESCRIPTION

LOT 188, 189, 190, 191 & 192 ON RP173728
COURTNEY DRIVE
LOCALITY OF UPPER COOMERA
LOCAL AUTHORITY - GOLD COAST CITY COUNCIL

CLIENT

HB Land

NORTH

0 10 20 30 40 50m
Scale 1:1000 - A1 (1:2000 - A3)

REV	DATE	DESCRIPTION	INT
A	13-10-23	COUNCIL ISSUE	EP

COPYRIGHT IS VESTED IN MORTONS-URBAN SOLUTIONS AND WRITTEN CONSENT IS REQUIRED PRIOR TO REPRODUCTION.
DO NOT SCALE FROM THIS DRAWING.

ASSOCIATED CONSULTANTS

BIOME WATER AND ENVIRONMENTAL CONSULTING
Robin Russell & ASSOCIATES PTY. LTD.
BENNETT+BENNETT

DRAWING TITLE

ROAD HIERARCHY,
STAGING PLAN
&
GENERAL NOTES
SHEET 02

MORTONS urbansolutions
Urban & Regional Planning
Civil Engineering
Project Coordination

MUS Pty Ltd T/As:
Mortons-Urban Solutions
ABN: 39 116 375 065
mortons@urbansolutions.net.au
www.urbansolutions.net.au
Tel 07 5571 1099

Postal Address
PO Box 2484
Southport QLD 4215

Gold Coast Office
Suite 9, 19 Short St
Southport QLD 4215

DESIGNED	RB	DRAWN	EP
APPROVED	RPEQ 4706	DATE	13-10-23

DRAWING NUMBER	REV
41901-02-006	A

F:\Autocad Client\419 - HB Land\01 - Courtney Drive\Precinct-Stage 02\Engineering Drawings\Current\41901-02-005.dwg, ROAD HIERARCHY & STAGING PLAN SHEET 02, 21/06/2024 1:16:01 PM, 1:2

PLANS AND DOCUMENTS referred to in the DEVELOPMENT APPROVAL

Application No: MIN/2024/337

Dated: 16 July 2024

Development shall comply with the conditions of approval as detailed in the Decision Notice and Council's Planning Scheme, Local Laws and Planning Policies

GENERAL


1. EXISTING SERVICES - EXTERNAL WORKS
   THE LOCATIONS OF ALL EXISTING SERVICES WITHIN THE WORK AREA SHALL BE CONFIRMED BY THE CONTRACTOR PRIOR TO CONSTRUCTION COMMENCING. IT IS THE CONTRACTOR'S RESPONSIBILITY TO CONTACT THE RELEVANT AUTHORITIES & TO ENSURE THAT THE EXISTING SERVICES ARE NOT DAMAGED OR DISTURBED IN ANY WAY BY THE CONTRACT WORKS.
2. EXISTING STRUCTURES
   ALL EXISTING STRUCTURES & ASSOCIATED INFRASTRUCTURE TO BE REMOVED & DISPOSED OF OFF SITE.
3. EXISTING DAMS
   EXISTING DAMS TO BE DEWATERED. ALL SILT & DEBRIS ARE TO BE REMOVED & LAWFULLY DISPOSED OF TO A TIP OFF SITE, OR INCORPORATED INTO THE SITE EARTHWORKS AT THE DIRECTION OF THE GEOTECHNICAL ENGINEER. REPLACEMENT FILL IS TO BE LOCATED & COMPACTED IN ACCORDANCE WITH LOCAL COUNCIL'S SPECIFICATIONS.

NOTE:
CONTRACTOR TO MAKE ALL NECESSARY ALLOWANCES FOR LOCATION AND PROTECTION OF EXISTING SERVICES DURING WORKS.

LEGEND

- EXISTING PROPERTY LINE
- EXISTING FENCE
- EXISTING KERB
- EXISTING EDGE OF BITUMEN
- CONTROL LINE / CENTER OF ROAD
- EXISTING FOOTPATH
- EXISTING EDGE OF VEGETATION
- EXISTING RISING MAIN
- EXISTING SEWER
- EXISTING STORMWATER
- EXISTING WATER
- EXISTING GAS
- EXISTING UNDERGROUND ELECTRICITY
- EXISTING OVERHEAD ELECTRICITY
- EXISTING TELSTRA
- EXISTING COMMUNICATIONS
- EXISTING CONTOURS MAJOR
- EXISTING CONTOURS MINOR
- DEMOLISH RISING MAIN
- DEMOLISH SEWER
- DEMOLISH STORMWATER
- DEMOLISH WATER
- DEMOLISH GAS
- DEMOLISH UNDERGROUND ELECTRICITY
- DEMOLISH OVERHEAD ELECTRICITY
- DEMOLISH TELSTRA
- DEMOLISH COMMUNICATIONS
- SITE BOUNDARY
- STAGE BOUNDARY
- LIMIT OF WORKS BOUNDARY
- TREE PROTECTION FENCE
- TREES TO BE RETAINED
- TREES TO BE REMOVED

DIAL BEFORE YOU DIG www.1100.com.au

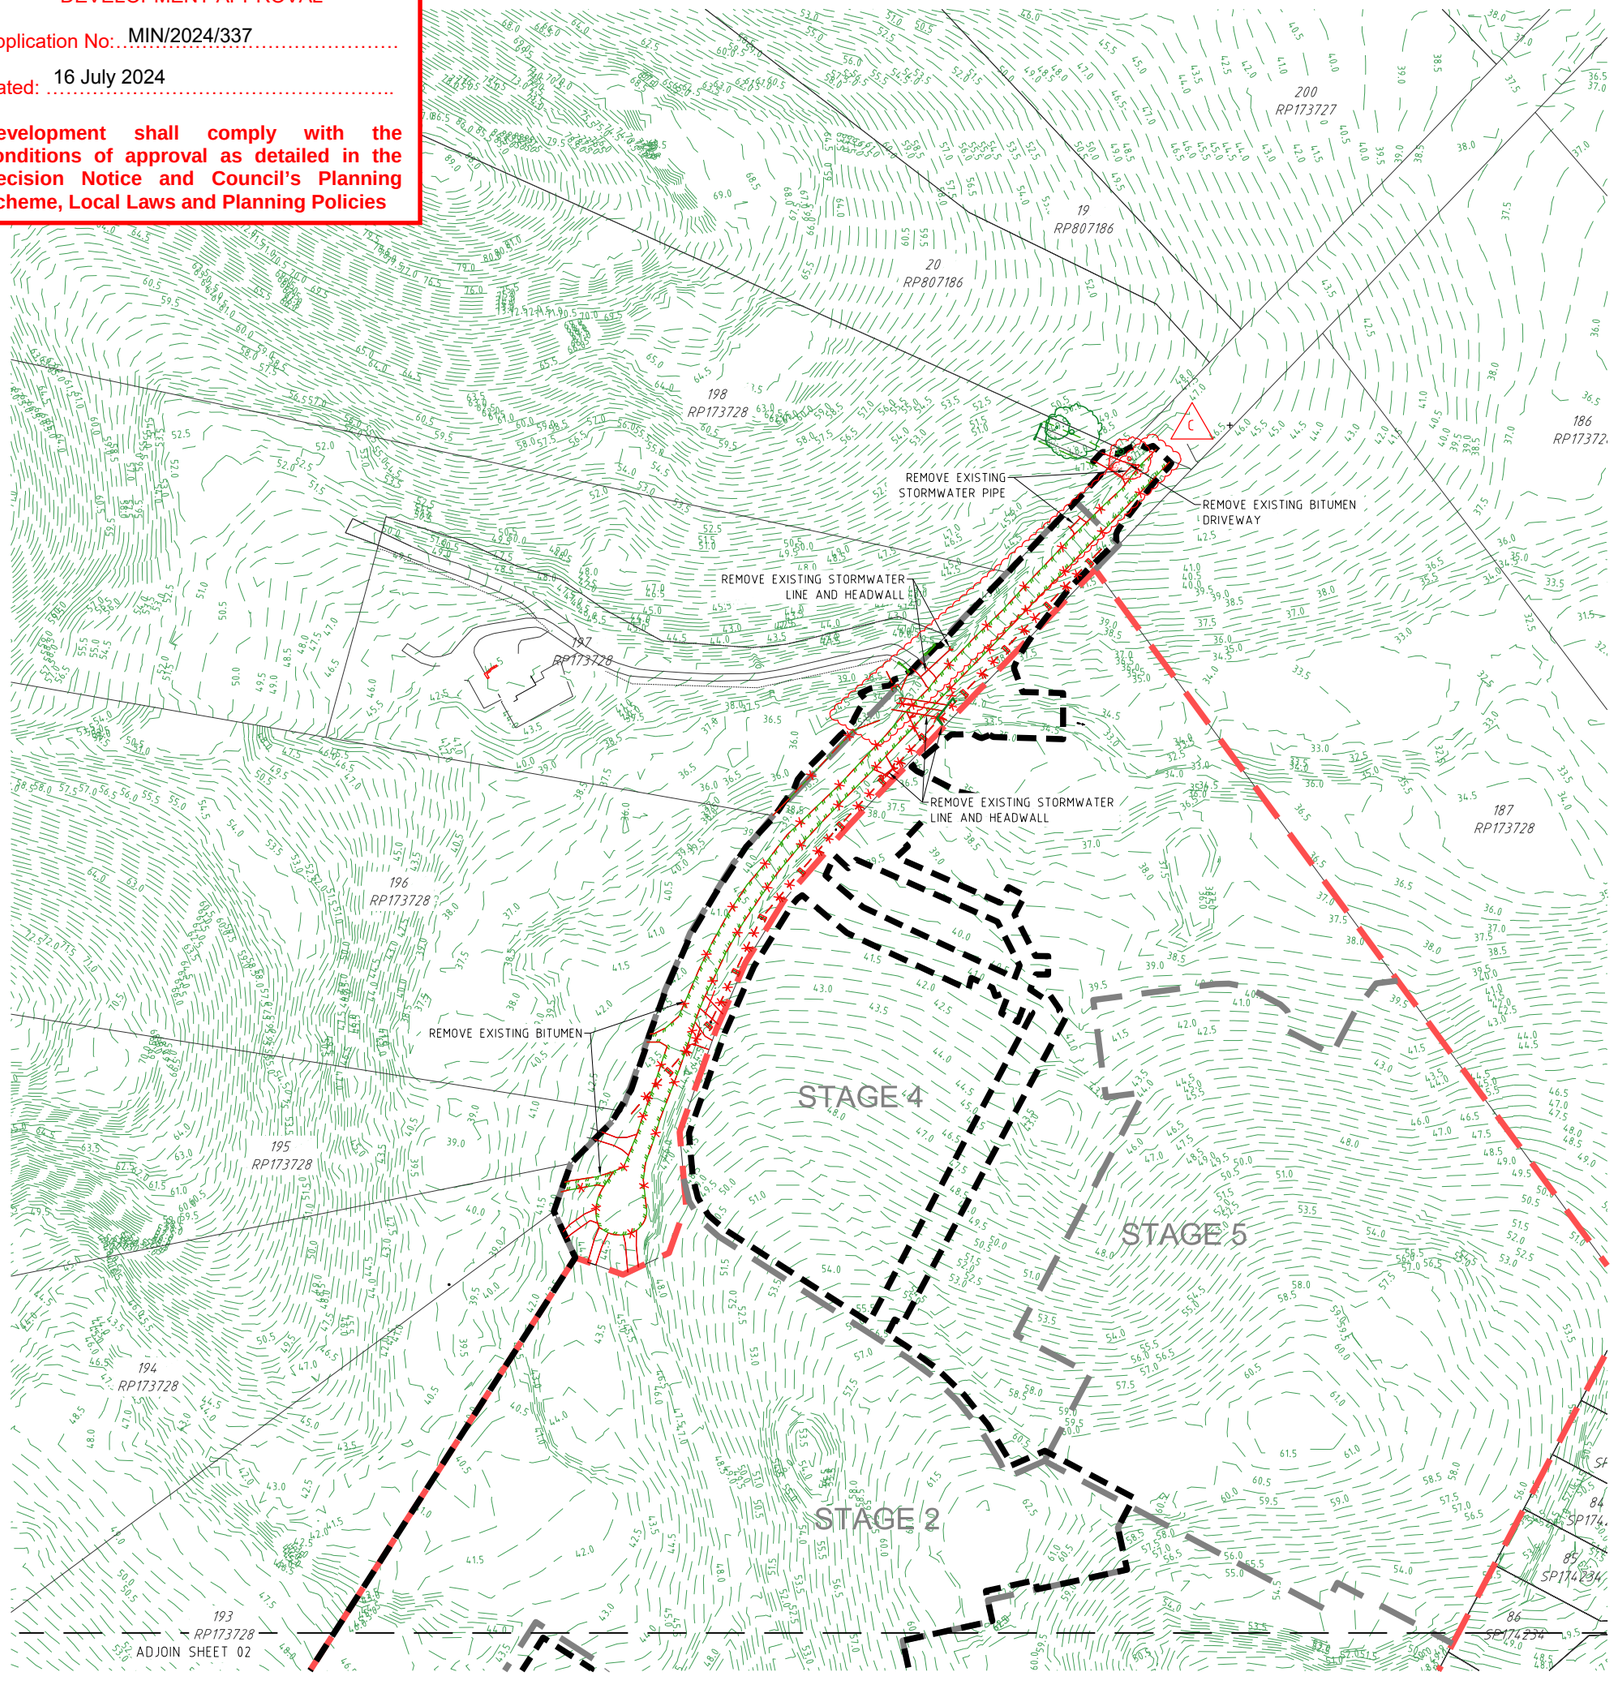

PROJECT NAME

COURTNEY DR UPPER COOMERA

STAGE 02

RP DESCRIPTION

LOT 188, 189, 190, 191 & 192 ON RP173728
COURTNEY DRIVE
LOCALITY OF UPPER COOMERA
LOCAL AUTHORITY - GOLD COAST CITY COUNCIL

CLIENT

HB Land

NORTH

0 10 20 30 40 50m
Scale 1:1000 - A1 (1:2000 - A3)

REV	DATE	DESCRIPTION	INT
C	13-06-24	LIMIT OF WORKS AMENDED	RK
B	17-01-24	LIMIT OF WORKS BDY AMENDED	EP
A	13-10-23	COUNCIL ISSUE	EP

COPYRIGHT IS VESTED IN MORTONS-URBAN SOLUTIONS AND WRITTEN CONSENT IS REQUIRED PRIOR TO REPRODUCTION. DO NOT SCALE FROM THIS DRAWING.

ASSOCIATED CONSULTANTS

BIOME WATER AND ENVIRONMENTAL CONSULTING
Robin Russell & ASSOCIATES PTY. LTD.
BENNETT+BENNETT

DRAWING TITLE

EXISTING FEATURES AND DEMOLITION PLAN SHEET 01

MORTONS urbansolutions
Urban & Regional Planning
Civil Engineering
Project Coordination
MUS Pty Ltd T/As:
Mortons-Urban Solutions
ABN: 39 116 375 065
mortons@urbansolutions.net.au
www.urbansolutions.net.au
Tel 07 5571 1099
Postal Address
PO Box 2484
Southport QLD 4215
Gold Coast Office
Suite 9, 19 Short St
Southport QLD 4215

DESIGNED	RB	DRAWN	EP
APPROVED		RPEQ 4706	DATE 13-10-23

DRAWING NUMBER 41901-02-020 REV C

F:\Autocad Client\419 - HB Land\01 - Courtney Drive\Precinct-Stage 02\Engineering Drawings\Current\41901-02-020.dwg, PLAN SHEET 01, 21/06/2024 1:16:04 PM, 1:2

PLANS AND DOCUMENTS referred to in the DEVELOPMENT APPROVAL

Application No: MIN/2024/337

Dated: 16 July 2024

Development shall comply with the conditions of approval as detailed in the Decision Notice and Council's Planning Scheme, Local Laws and Planning Policies

GENERAL


1. EXISTING SERVICES - EXTERNAL WORKS
   THE LOCATIONS OF ALL EXISTING SERVICES WITHIN THE WORK AREA SHALL BE CONFIRMED BY THE CONTRACTOR PRIOR TO CONSTRUCTION COMMENCING. IT IS THE CONTRACTOR'S RESPONSIBILITY TO CONTACT THE RELEVANT AUTHORITIES & TO ENSURE THAT THE EXISTING SERVICES ARE NOT DAMAGED OR DISTURBED IN ANY WAY BY THE CONTRACT WORKS.
2. EXISTING STRUCTURES
   ALL EXISTING STRUCTURES & ASSOCIATED INFRASTRUCTURE TO BE REMOVED & DISPOSED OF OFF SITE.
3. EXISTING DAMS
   EXISTING DAMS TO BE DEWATERED. ALL SILT & DEBRIS ARE TO BE REMOVED & LAWFULLY DISPOSED OF TO A TIP OFF SITE, OR INCORPORATED INTO THE SITE EARTHWORKS AT THE DIRECTION OF THE GEOTECHNICAL ENGINEER. REPLACEMENT FILL IS TO BE LOCATED & COMPACTED IN ACCORDANCE WITH LOCAL COUNCIL'S SPECIFICATIONS.

NOTE:
CONTRACTOR TO MAKE ALL NECESSARY ALLOWANCES FOR LOCATION AND PROTECTION OF EXISTING SERVICES DURING WORKS.

LEGEND

- EXISTING PROPERTY LINE
- EXISTING FENCE
- EXISTING KERB
- EXISTING EDGE OF BITUMEN
- CONTROL LINE / CENTER OF ROAD
- EXISTING FOOTPATH
- EXISTING EDGE OF VEGETATION
- RM EXISTING RISING MAIN
- S EXISTING SEWER
- SW EXISTING STORMWATER
- W EXISTING WATER
- G EXISTING GAS
- E EXISTING UNDERGROUND ELECTRICITY
- E EXISTING OVERHEAD ELECTRICITY
- T EXISTING TELSTRA
- C EXISTING COMMUNICATIONS
- 1.0 EXISTING CONTOURS MAJOR
- 1.5 EXISTING CONTOURS MINOR
- RM DEMOLISH RISING MAIN
- S DEMOLISH SEWER
- SW DEMOLISH STORMWATER
- W DEMOLISH WATER
- G DEMOLISH GAS
- E DEMOLISH UNDERGROUND ELECTRICITY
- E DEMOLISH OVERHEAD ELECTRICITY
- T DEMOLISH TELSTRA
- C DEMOLISH COMMUNICATIONS
- SITE BOUNDARY
- STAGE BOUNDARY
- LIMIT OF WORKS BOUNDARY
- TREE PROTECTION FENCE
- TREES TO BE RETAINED
- TREES TO BE REMOVED

DIAL BEFORE YOU DIG www.1100.com.au

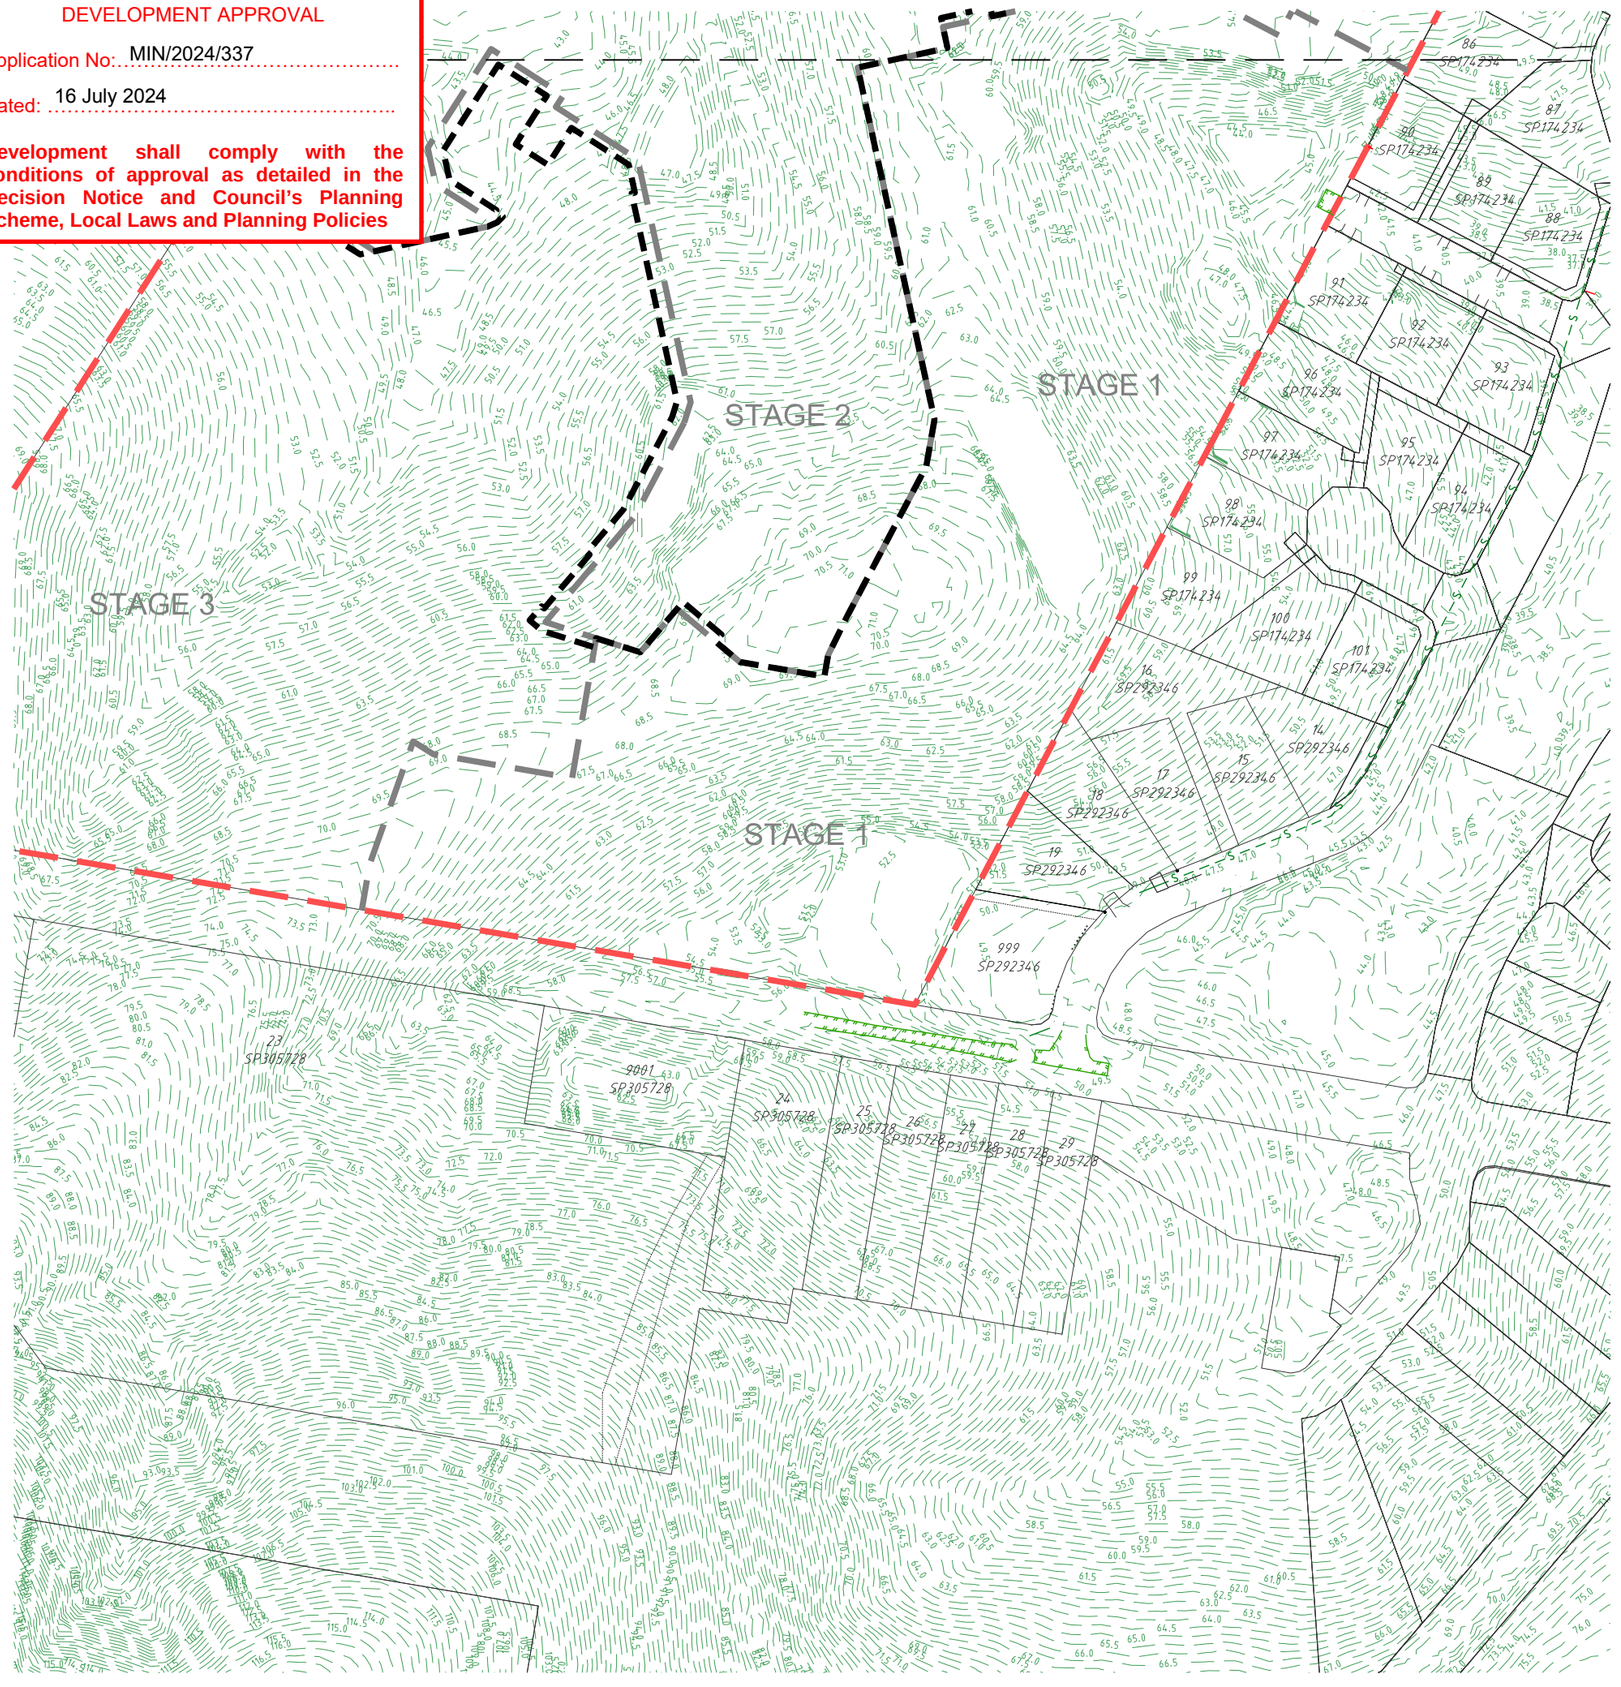

PROJECT NAME

COURTNEY DR UPPER COOMERA

STAGE 02

RP DESCRIPTION

LOT 188, 189, 190, 191 & 192 ON RP173728
COURTNEY DRIVE
LOCALITY OF UPPER COOMERA
LOCAL AUTHORITY - GOLD COAST CITY COUNCIL

CLIENT

HB Land

NORTH

0 10 20 30 40 50m
Scale 1:1000 - A1 (1:2000 - A3)

REV	DATE	DESCRIPTION	INT
A	13-10-23	COUNCIL ISSUE	EP

COPYRIGHT IS VESTED IN MORTONS-URBAN SOLUTIONS AND WRITTEN CONSENT IS REQUIRED PRIOR TO REPRODUCTION. DO NOT SCALE FROM THIS DRAWING.

ASSOCIATED CONSULTANTS

BIOME WATER AND ENVIRONMENTAL CONSULTING
Robin Russell & ASSOCIATES PTY. LTD.
BENNETT+BENNETT

DRAWING TITLE

EXISTING FEATURES AND DEMOLITION PLAN SHEET 02

MORTONS urbansolutions
Urban & Regional Planning
Civil Engineering
Project Coordination
MUS Pty Ltd T/As:
Mortons-Urban Solutions
ABN: 39 116 375 065
mortons@urbansolutions.net.au
www.urbansolutions.net.au
Tel 07 5571 1099
Postal Address
PO Box 2484
Southport QLD 4215
Gold Coast Office
Suite 9, 19 Short St
Southport QLD 4215

DESIGNED	RB	DRAWN	EP
APPROVED	RPEQ 4706	DATE	13-10-23

DRAWING NUMBER 41901-02-021 REV A

F:\Autocad Client\419 - HB Land\01 - Courtney Drive\Precinct-Stage 02\Engineering Drawings\Current\41901-02-020.dwg, PLAN SHEET 02, 21/06/2024 1:15:07 PM, 1:2

PLANS AND DOCUMENTS referred to in the DEVELOPMENT APPROVAL


Application No: MIN/2024/337

Dated: 16 July 2024

Development shall comply with the conditions of approval as detailed in the Decision Notice and Council's Planning Scheme, Local Laws and Planning Policies


EARTHWORKS

1. TOPSOIL STRIPPING
   TOPSOIL SHALL BE STRIPPED ACROSS THE ENTIRE LIMIT OF THE EARTHWORKS CUT & FILL AREAS & SHALL BE STOCKPILED IN A LOCATION APPROVED BY THE SUPERINTENDENT. THE EXISTING STRATA IS TO BE TREATED IN ACCORDANCE WITH THE SPECIFICATION PRIOR TO PLACING ANY FILL.
2. EARTHWORKS LEVELS
   EARTHWORKS LEVELS SHOWN ON DRAWINGS ARE TO FINISHED SURFACE LEVELS & INCLUDE 100mm OF TOPSOIL.
3. COMPACTION STANDARD
   SITE FILLING & TRENCH BACKFILL SHALL BE COMPACTED TO THE STANDARDS OUTLINED IN THE LOCAL AUTHORITY'S SPECIFICATIONS. FILL BATTER FACES ARE TO BE OVERFILLED, COMPACTED & CUT BACK TO DESIGN LEVELS. ALL CUT BATTERS ARE TO BE CUT BACK & TRIMMED TO DESIGN LEVELS.
4. PAVEMENT DEPTHS
   THE DESIGN PAVEMENT DEPTHS ALLOWED IN EARTHWORKS CALCULATIONS ARE BASED ON THE DEPTHS SHOWN IN THE SCHEDULE OF PAVEMENT DEPTHS. THE PAVEMENT DEPTHS GIVEN ARE DESIGN DEPTHS ONLY & MAY BE VARIED AFTER SUB GRADE TESTS ARE TAKEN & AUTHORITY APPROVAL.
5. TESTING & CERTIFICATION
   ALL COMPACTION TESTING SHALL BE CARRIED OUT BY AN APPROVED N.A.T.A. TESTING AUTHORITY. ALL SITE FILLING SHALL BE TESTED AT LEVEL 1 REQUIREMENTS. THE CONTRACTOR IS TO PROVIDE ALL REQUIRED EARTHWORKS CERTIFICATIONS IN ACCORDANCE WITH THE APPROVAL CONDITIONS. THE CONTRACTOR IS TO PROVIDE A CONSTRUCTED EARTHWORKS SLOPE STABILITY CERTIFICATION CONFIRMING REQUIRED F.O.S. CERTIFIED BY A RPEQ.
6. TOPSOIL REPLACEMENT
   ALL FOOTPATHS, BATTERS & ALLOTMENT CUT & FILL AREAS SHALL BE TOPSOILED WITH TOPSOIL FROM ONSITE STOCKPILES, & AMELIORATE SOIL AS NECESSARY TO ENSURE GRASS STRIKE.
7. GRASSING
   ALL CUT/FILL AREAS, DISTURBED AREAS & TRENCHED AREAS SHALL BE GRASSED TO THE SATISFACTION OF THE SUPERINTENDENT & LOCAL AUTHORITY.
8. ROCK
   THE CONTRACTOR IS TO INCLUDE ROCK EXCAVATION AS PART OF THEIR EARTHWORKS RATE.
9. EARTHWORKS ZONE
   THE FOLLOWING ACTIVITIES ARE PROHIBITED OUTSIDE THE EARTHWORKS ZONE - STORAGE & MIXING OF MATERIALS, VEHICLE PARKING, LIQUID DISPOSAL, MACHINERY REPAIRS/REFUELING, PLACEMENT OF SITE OFFICES OR SHEDS, COMBUSTION OF ANY MATERIAL, STOCKPILING OF SOIL, RUBBLE OR DEBRIS, ANY FILLING OR EXCAVATION INCLUDING TRENCHES, TOPSOIL, SKIMMING AND/OR SURFACE EXCAVATION UNLESS OTHERWISE APPROVED BY THE RELEVANT AUTHORITY.
10. CONSTRUCTION - STOCKPILING
    TEMPORARY SILT FENCE TO BE ERECTED 5m FROM TOE OF BATTER ON LOW SIDE OF STOCKPILING. STOCKPILE SITE TO BE CLEAR OF ADJACENT PROPERTY BOUNDARIES SO AS NOT TO CAUSE A NUISANCE TO ADJOINING PROPERTIES. NO STOCKPILES ARE TO BE LOCATED WITHIN THE TREE PROTECTION ZONE, REFER VEGETATION MANAGEMENT PLAN FOR MORE DETAILS. THE CONTRACTOR SHALL NOT CREATE STOCKPILES OF SURPLUS MATERIALS UNLESS DIRECTED BY THE SUPERINTENDENT. ALL MATERIALS ARISING FROM THE WORKS SHALL BE COMPACTED TO FUTURE FILL AREAS AS NOMINATED OR REMOVED FROM THE SITE.
11. TOPSOIL SCREENING
    TOPSOIL SHALL BE SCREENED BY THE CONTRACTOR WHEN DIRECTED BY THE SUPERINTENDENT. ALL UNSUITABLE MATERIAL SCREENED FROM THE TOPSOIL WILL BE TAKEN TO AN OFFSITE TIP BY THE CONTRACTOR AT THE CONTRACTORS EXPENSE.
12. EARTHWORKS MATERIAL SIZE
    ALL EARTHWORKS MATERIAL IS TO BE BROKEN DOWN TO AN ACCEPTABLE SIZE TO BE COMPACTED UNDER LEVEL 1 FILL. WHERE THE RELEVANT GUIDELINES DON'T SPECIFY AN ACCEPTABLE SIZE, EARTHWORKS MATERIAL IS TO BE BROKEN DOWN TO A SIZE NO LARGER THAN 75mm.
13. MOISTURE CONTENT
    EARTHWORKS MOISTURE VARIATION TO NOT EXCEED ±2% OF THE OPTIMUM MOISTURE CONTENT.
14. SURFACE FINISH
    THE FINISHED SURFACE LEVEL IS TO BE CAPPED WITH FINER MATERIAL & SMOOTH DRUM ROLLED & GRADED TO PROMOTE SURFACE WATER RUNOFF IN A CONTROLLED MANNER.
15. EARTHWORKS LIMITS
    THE CONTRACTOR IS TO TIE IN TO THE NATURAL SURFACE AT THE LIMIT OF THE EARTHWORKS. THE TIE IN IS TO BE COMPLETED IN A MANNER TO ENSURE THERE IS NO PONDING OF SURFACE WATER.
16. IMPORTED MATERIAL
    LOTS - ALL IMPORTED MATERIAL FOR PLACEMENT ON LOTS TO BE A MINIMUM CBR 10 MATERIAL & HAVE A SWELL % <1.5.
    ROADS - ALL IMPORTED MATERIAL FOR PLACEMENT ON ROADS TO BE A MINIMUM CBR10 MATERIAL WITH A SWELL % <1.5, LIQUID LIMIT <70 & PLASTICITY IDEX <45.
    SOIL PARAMETERS TO BE REVIEWED BY THE SITE GEOTECHNICAL ENGINEER PRIOR TO PLACEMENT ON SITE.
17. REACTIVE SOILS
    a) ALL REACTIVE TOPSOIL TO BE IDENTIFIED BY THE GEOTECHNICAL ENGINEER & BE SEPARATED FROM THE NON REACTIVE TOPSOIL.
    b) ALL REACTIVE TOPSOIL TO BE RESPREAD IN THE OPEN SPACE AREA. WHERE REACTIVE TOPSOIL IS REQUIRED TO BE RESPREAD ON DEVELOPABLE AREAS THE CONTRACTOR SHALL LIME TREAT THE TOPSOIL TO THE SATISFACTION OF THE GEOTECHNICAL ENGINEER.
    c) WHEN UNDERTAKING THE EARTHWORKS CUT ALL MATERIALS SHOULD BE SELECTIVELY SORTED SO THAT THE REACTIVE SOILS ARE SEPARATED FROM THE LOW REACTIVE RESIDUAL SOILS & XW BEDROCK
    d) ALL REACTIVE SOILS ARE TO BE PLACED IN THE LOWER SECTIONS OF FILL WITH THE LESS REACTIVE RESIDUAL SOILS & XW BEDROCK TO BE PLACE IN THE UPPER FILLS. ALTERNATIVELY, THE REACTIVE SOILS CAN BE BLENDED WITH THE LESS REACTIVE SOILS & XW ROCK TO THE SATISFACTION OF THE GEOTECHNICAL ENGINEER.
    e) NO REACTIVE CLAY SOILS SHOULD BE PLACED WITHIN THE UPPER 0.75M APPROX. FILL PROFILE WHERE POSSIBLE.
    f) WHEN PLACING FILL OVER HIGHLY REACTIVE SOILS, TREATMENT MAY BE REQUIRED IF THE FILLS ARE ONLY MINOR, 0.3m APPROX. & THE REACTIVE SOIL PROFILE IS GREATER THAN 0.7m APPROX. IN THESE AREAS SUBGRADE REPLACEMENT OF AT LEAST 0.75m OF NON REACTIVE / LOW REACTIVE MATERIAL OVERLYING THE REACTIVE SOILS SHALL BE UNDERTAKEN.
    g) ALL WORKS ASSOCIATED WITH THE IDENTIFICATION, PLACEMENT & TREATMENT OF REACTIVE SOILS SHALL BE UNDERTAKEN TO THE SATISFACTION OF THE GEOTECHNICAL ENGINEER.

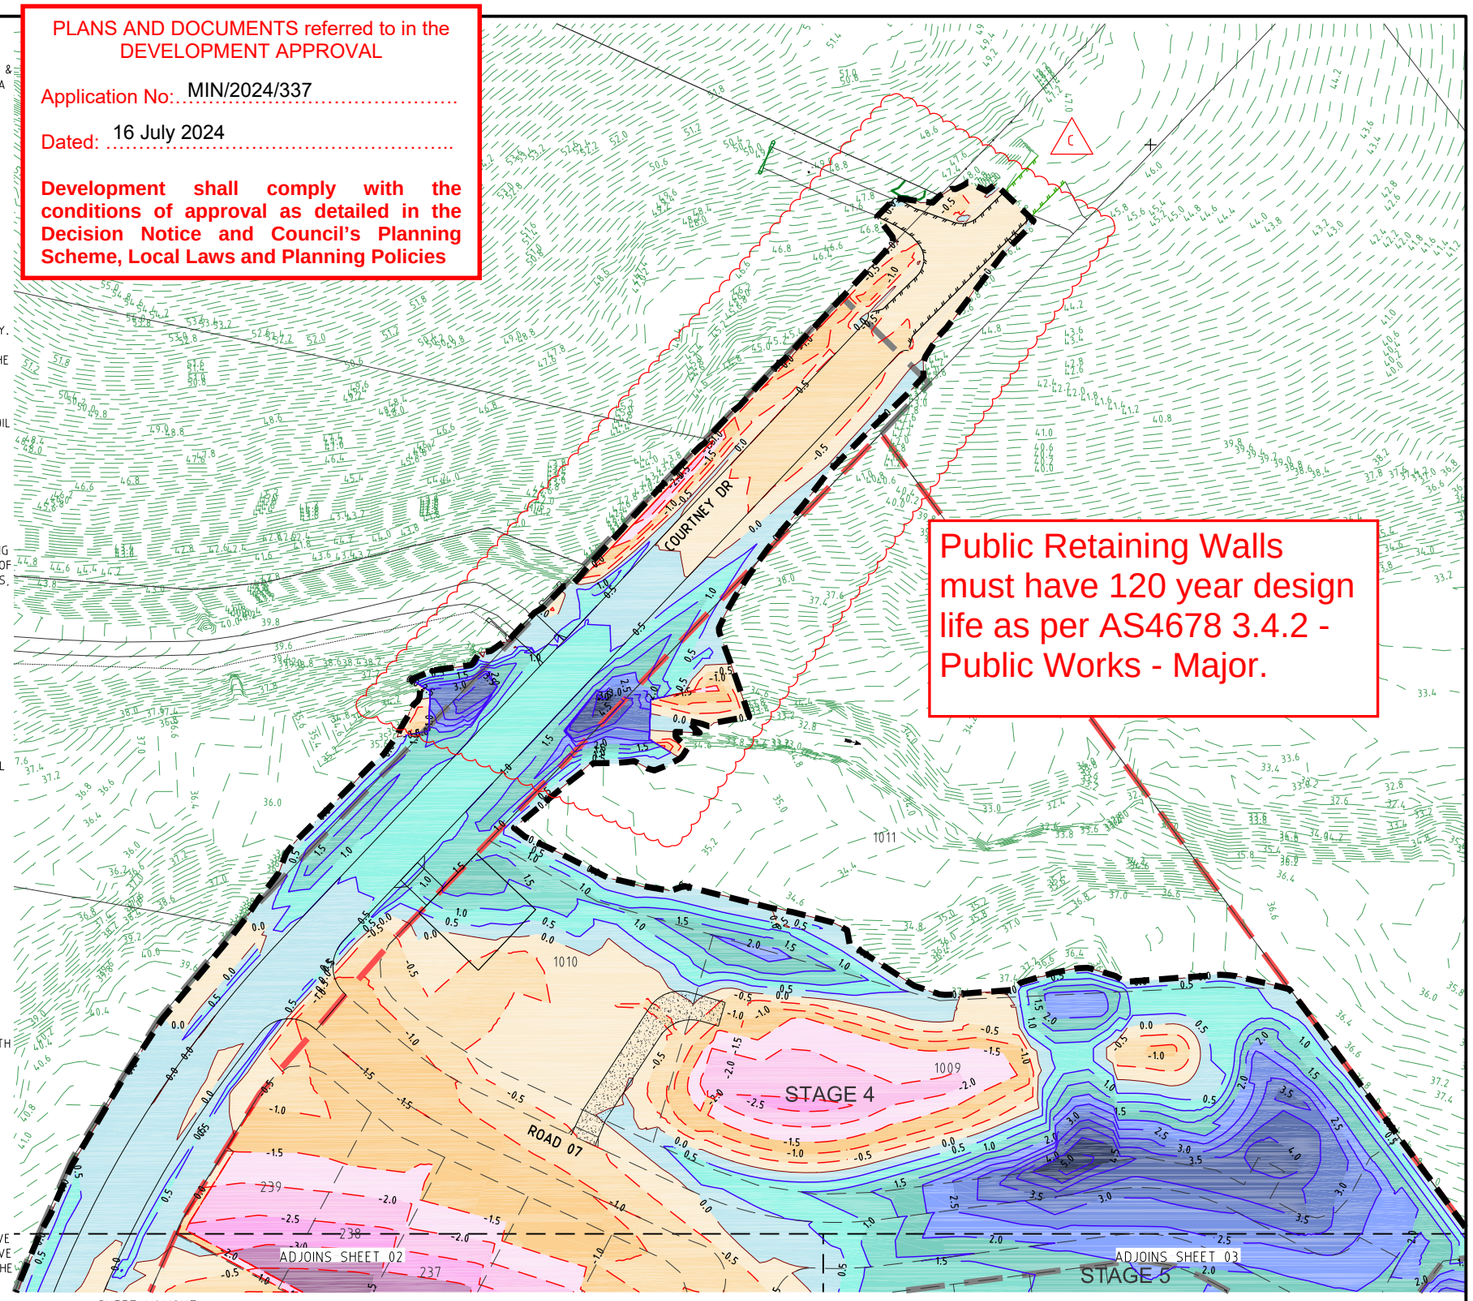

Public Retaining Walls must have 120 year design life as per AS4678 3.4.2 - Public Works - Major.

SHEET LAYOUT

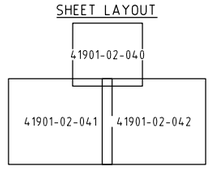

DIAL BEFORE YOU DIG www.1100.com.au

NOTE:
CONTRACTOR TO MAKE ALL NECESSARY ALLOWANCES FOR EXISTING SERVICES DURING ALL WORKS.

NOTES:
1. EARTHWORKS VOLUMES ARE APPROXIMATE ONLY, CONTRACTOR TO VERIFY & ALLOW FOR ANY DISCREPANCY IN THE CONTRACT VALUE.
2. VOLUMES INDICATE THE STRUCTURAL QUANTITY OF EARTHWORKS, IE BETWEEN THE EXISTING SURFACE & THE UNDERSIDE OF THE MINIMUM BOX & OF THE FSL, AS PROSCRIBED IN THE CONTRACT DOCUMENTATION.
3. NO ALLOWANCE FOR COMPACTION OR BULKING FACTOR IS INCLUDED IN THE EARTHWORKS VOLUMES. THE CONTRACTOR IS TO MAKE ALLOWANCES FOR BULKING/COMPACTION AS PART OF THEIR CONTRACT WORKS.
4. THE CONTRACTOR IS TO VERIFY EXISTING SURFACE & TOPSOIL DISTRIBUTION PRIOR TO SIGNING THE CONTRACT. THE CONTRACTORS PRICE FOR THESE WORKS IS DEEMED TO BE ACCEPTING OF THE NATURAL SURFACE & TOPSOIL DISTRIBUTION.
5. THE CONTRACTOR IS REQUIRED TO EXPORT / IMPORT AS NEEDED TO ACHIEVE THE FINAL SURFACE LEVELS. THE EXPORT/IMPORT AS REQUIRED TO COMPLETE EARTHWORKS FORMS PART OF THE CONTRACT WORKS.
6. WHERE NO SPOIL AREA IS AVAILABLE WITHIN THE PROJECT FOOTPRINT, THE CIVIL CONTRACTOR SHALL EXPORT EXCESS MATERIALS TO A LICENCED TIP OFF SITE. THESE WORKS FORM PART OF THE CONTRACT WORKS.


LEGEND

- EXISTING PROPERTY LINE
- EXISTING KERB (INVERT)
- FUTURE KERB (INVERT)
- FUTURE PROPERTY LINE
- SITE BOUNDARY
- STAGE BOUNDARY
- LIMIT OF EARTHWORKS BOUNDARY
- PROPOSED PROPERTY LINE
- PROPOSED KERB (INVERT)
- -0.5 CUT CONTOUR
- 0.0 INTERFACE CONTOUR
- 0.5 FILL CONTOUR


CUT#
- 4.5m +
- 4.0 - 4.5m
- 3.5 - 4.0m
- 3.0 - 3.5m
- 2.5 - 3.0m
- 2.0 - 2.5m
- 1.5 - 2.0m
- 1.0 - 1.5m
- 0.5 - 1.0m
- 0.0 - 0.5m

FILL#
- 0.0 - 0.5m
- 0.5 - 1.0m
- 1.0 - 1.5m
- 1.5 - 2.0m
- 2.0 - 2.5m
- 2.5 - 3.0m
- 3.0 - 3.5m
- 3.5 - 4.0m
- 4.0 - 4.5m
- 4.5m +

BULK EARTHWORKS (EXISTING TO FINISHED SURFACE)

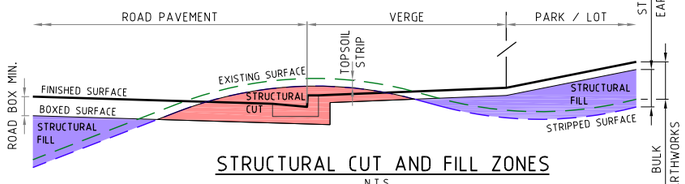

STRUCTURAL CUT AND FILL ZONES
N.T.S.

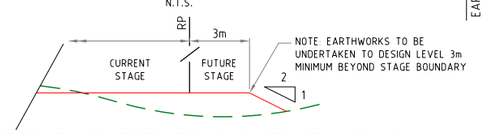

TEMPORARY BATTER BEYOND STAGE WORKS
N.T.S.

PROJECT NAME

COURTNEY DR
UPPER COOMERA

STAGE 02

RP DESCRIPTION

LOT 188, 189, 190, 191 & 192 ON RP173728
COURTNEY DRIVE
LOCALITY OF UPPER COOMERA
LOCAL AUTHORITY - GOLD COAST CITY COUNCIL

CLIENT

HB Land

NORTH

0 5 10 15 20 25m
Scale 1:500 - A1 (1:1000 - A3)

REV	DATE	DESCRIPTION	INT
C	12-06-24	CONTOURS & LIMIT OF WORKS AMENDED	EP
B	17-01-24	CONTOURS AMENDED	xx
A	13-10-23	COUNCIL ISSUE	EP

COPYRIGHT IS VESTED IN MORTONS-URBAN SOLUTIONS AND WRITTEN CONSENT IS REQUIRED PRIOR TO REPRODUCTION.
DO NOT SCALE FROM THIS DRAWING.

ASSOCIATED CONSULTANTS

BIOME WATER AND ENVIRONMENTAL CONSULTING
Robin Russell & ASSOCIATES PTY. LTD.
BENNETT + BENNETT

DRAWING TITLE

EARTHWORKS
CUT TO FILL
PLAN
SHEET 01

MORTONS urbansolutions
Urban & Regional Planning
Civil Engineering
Project Coordination

MUS Pty Ltd T/As:
Mortons-Urban Solutions
ABN: 39 116 375 065
mortons@urbansolutions.net.au
www.urbansolutions.net.au
Tel 07 5571 1099

Postal Address
PO Box 2484
Southport QLD 4215

Gold Coast Office
Suite 9, 19 Short St
Southport QLD 4215

DESIGNED	RB	DRAWN	EP
APPROVED	RPEQ 4706	DATE	13-10-23

DRAWING NUMBER 41901-02-040 | REV C


F:\Autocad Client\419 - HB Land\01 - Courtney Drive\Precinct-Stage 02\Engineering Drawings\Current\41901-02-040.dwg, PLAN SHEET 01, 21/06/2024 1:16:20 PM, 1:2

PLANS AND DOCUMENTS referred to in the DEVELOPMENT APPROVAL

Application No: MIN/2024/337

Dated: 16 July 2024

Development shall comply with the conditions of approval as detailed in the Decision Notice and Council's Planning Scheme, Local Laws and Planning Policies

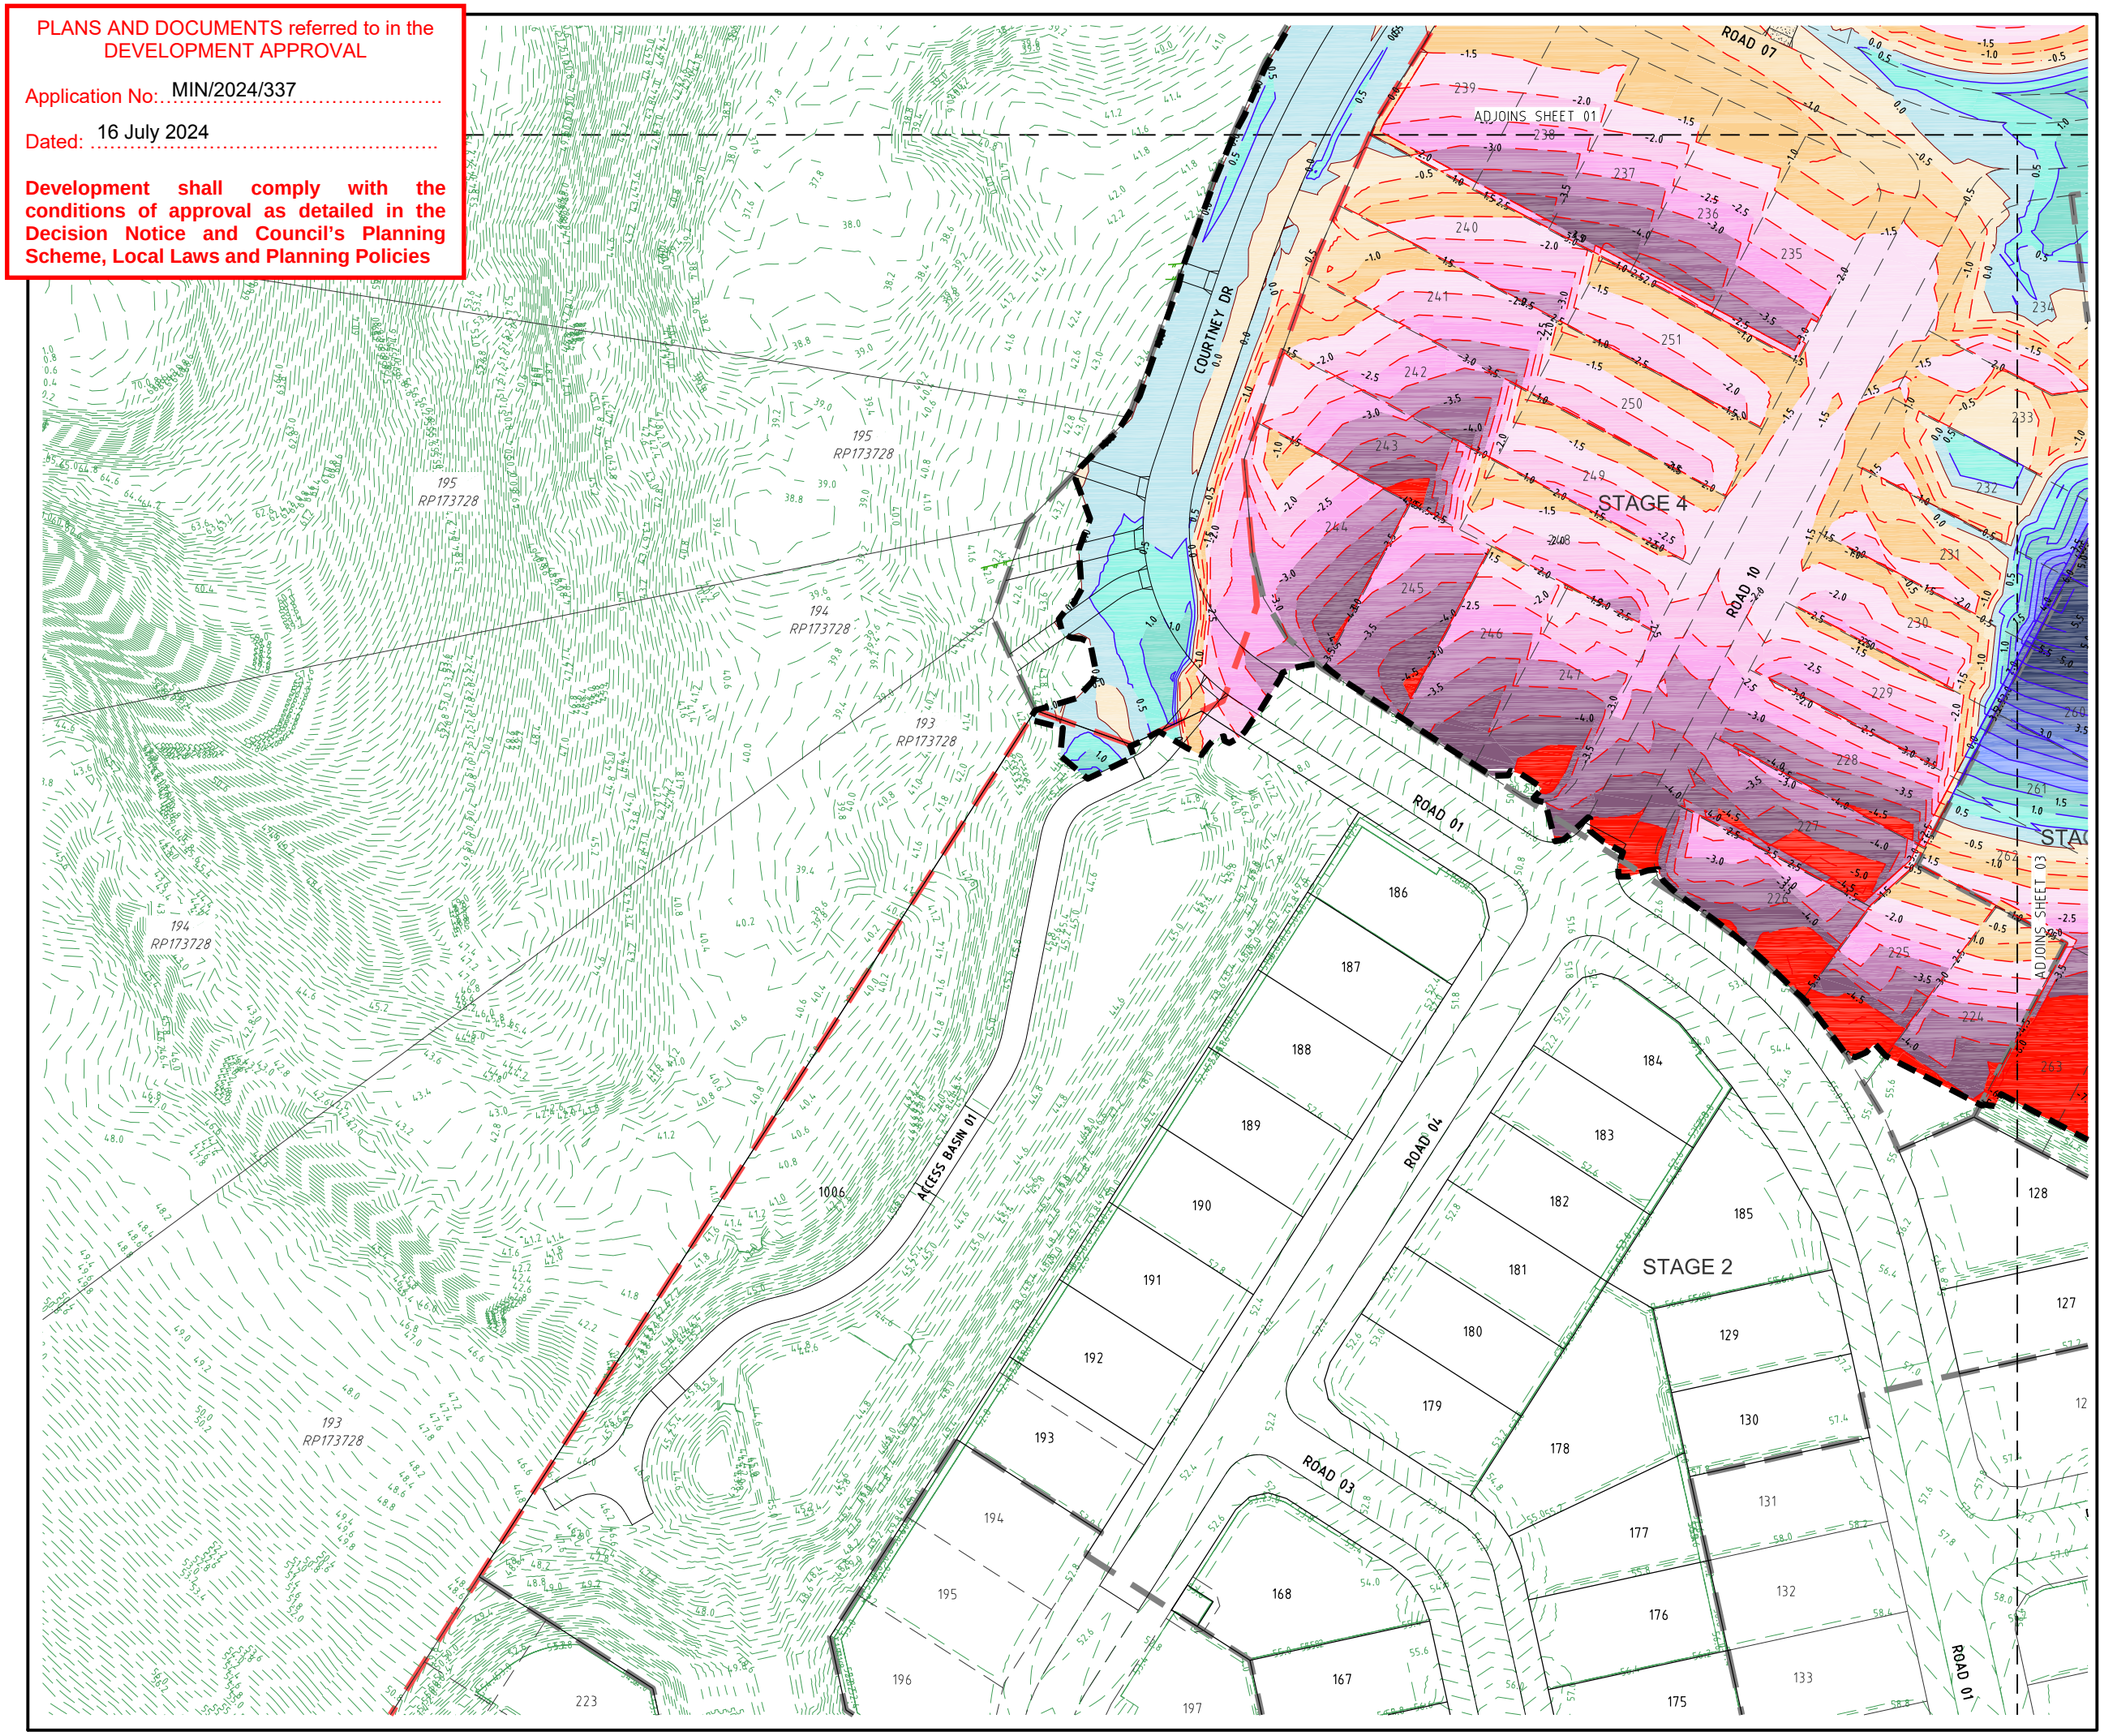

PROJECT NAME

COURTNEY DR UPPER COOMERA

STAGE 02

RP DESCRIPTION

LOT 188, 189, 190, 191 & 192 ON RP173728
COURTNEY DRIVE
LOCALITY OF UPPER COOMERA
LOCAL AUTHORITY - GOLD COAST CITY COUNCIL

CLIENT

HB Land

NORTH

0 5 10 15 20 25m
Scale 1:500 - A1 (1:1000 - A3)

REV	DATE	DESCRIPTION	INT
A	13-10-23	COUNCIL ISSUE	EP

COPYRIGHT IS VESTED IN MORTONS-URBAN SOLUTIONS AND WRITTEN CONSENT IS REQUIRED PRIOR TO REPRODUCTION. DO NOT SCALE FROM THIS DRAWING.

ASSOCIATED CONSULTANTS

BIOME WATER AND ENVIRONMENTAL CONSULTING
Robin Russell & ASSOCIATES PTY. LTD.
BENNETT+BENNETT

DRAWING TITLE

EARTHWORKS
CUT TO FILL
PLAN
SHEET 02

MORTONS urbansolutions
Urban & Regional Planning
Civil Engineering
Project Coordination

MUS Pty Ltd T/As:
Mortons-Urban Solutions
ABN: 39 116 375 065
mortons@urbansolutions.net.au
www.urbansolutions.net.au
Tel 07 5571 1099

Postal Address
PO Box 2484
Southport QLD 4215

Gold Coast Office
Suite 9, 19 Short St
Southport QLD 4215

DESIGNED RB	DRAWN EP
APPROVED	RPEQ 4706 DATE 13-10-23

DRAWING NUMBER 41901-02-041 REV A

F:\Autocad Client\419 - HB Land\01 - Courtney Drive\Precinct-Stage 02\Engineering Drawings\Current\41901-02-040.dwg, PLAN SHEET 02, 21/06/2024 1:17:31 PM, 1:2

PLANS AND DOCUMENTS referred to in the DEVELOPMENT APPROVAL

Application No: MIN/2024/337

Dated: 16 July 2024

Development shall comply with the conditions of approval as detailed in the Decision Notice and Council's Planning Scheme, Local Laws and Planning Policies

ADJOINS SHEET 01

ADJOINS SHEET 02

STAGE 5

STAGE 5

ROAD 11

ROAD 08

ROAD 09

ROAD 06

ROAD 01

RICHARDSON

GORDON DR

PROJECT NAME

COURTNEY DR UPPER COOMERA

STAGE 02

RP DESCRIPTION

LOT 188, 189, 190, 191 & 192 ON RP173728
COURTNEY DRIVE
LOCALITY OF UPPER COOMERA
LOCAL AUTHORITY - GOLD COAST CITY COUNCIL

CLIENT

HB Land

NORTH

0 5 10 15 20 25m

Scale 1:500 - A1 (1:1000 - A3)

REV	DATE	DESCRIPTION	INT
A	13-10-23	COUNCIL ISSUE	EP

COPYRIGHT IS VESTED IN MORTONS-URBAN SOLUTIONS AND WRITTEN CONSENT IS REQUIRED PRIOR TO REPRODUCTION.
DO NOT SCALE FROM THIS DRAWING.

ASSOCIATED CONSULTANTS

BIOME WATER AND ENVIRONMENTAL CONSULTING

Robin Russell & ASSOCIATES PTY. LTD.

BENNETT+BENNETT

DRAWING TITLE

EARTHWORKS
CUT TO FILL
PLAN
SHEET 03

MORTONS urbansolutions
Urban & Regional Planning
Civil Engineering
Project Coordination

MUS Pty Ltd T/As
Mortons-Urban Solutions
ABN: 39 116 375 065

mortons@urbansolutions.net.au
www.urbansolutions.net.au
Tel 07 5571 1099

Postal Address
PO Box 2484
Southport QLD 4215

Gold Coast Office
Suite 9, 19 Short St
Southport QLD 4215

DESIGNED	RB	DRAWN	EP
APPROVED	RPEQ 4706	DATE	13-10-23

DRAWING NUMBER	REV
41901-02-042	A


F:\Autocad Client\419 - HB Land\01 - Courtney Drive\Precinct-Stage 02\Engineering Drawings\Current\41901-02-040.dwg, PLAN SHEET 03, 21/06/2024 1:17:41 PM, 1:2

PLANS AND DOCUMENTS referred to in the DEVELOPMENT APPROVAL

Application No: MIN/2024/337

Dated: 16 July 2024

Development shall comply with the conditions of approval as detailed in the Decision Notice and Council's Planning Scheme, Local Laws and Planning Policies

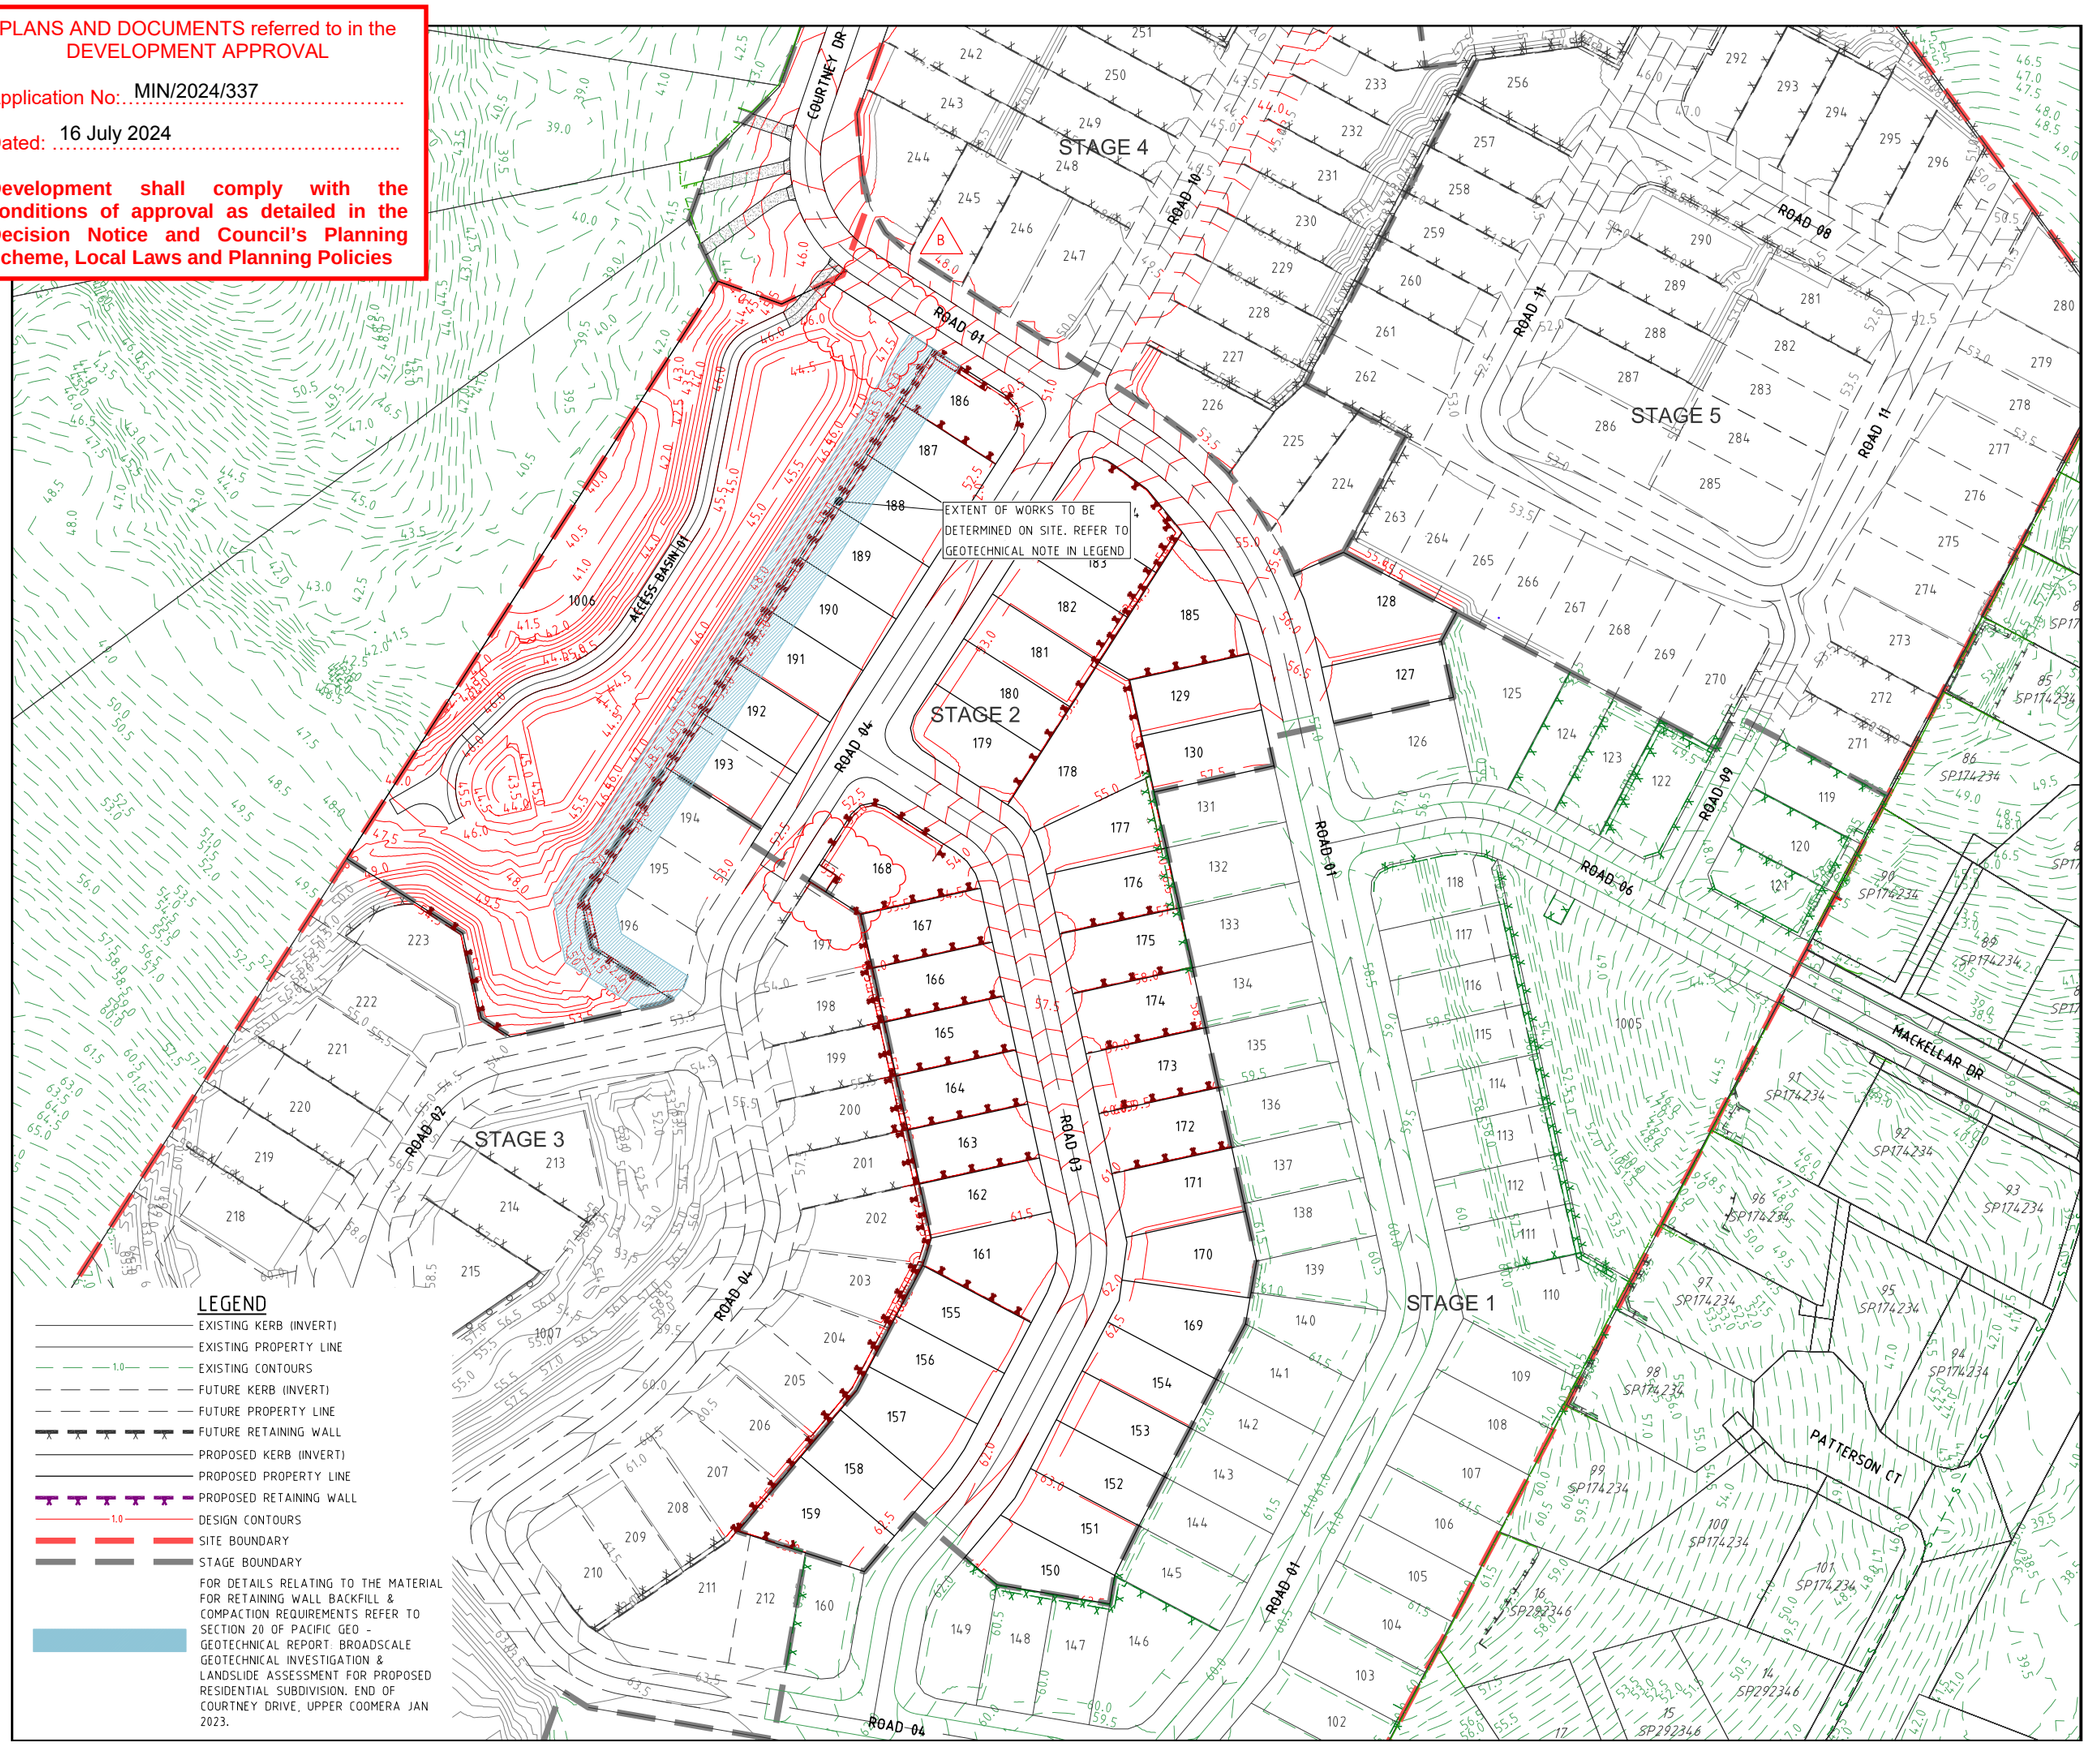

LEGEND

- EXISTING KERB (INVERT)
- EXISTING PROPERTY LINE
- EXISTING CONTOURS (1.0)
- FUTURE KERB (INVERT)
- FUTURE PROPERTY LINE
- FUTURE RETAINING WALL
- PROPOSED KERB (INVERT)
- PROPOSED PROPERTY LINE
- PROPOSED RETAINING WALL
- DESIGN CONTOURS (1.0)
- SITE BOUNDARY
- STAGE BOUNDARY

FOR DETAILS RELATING TO THE MATERIAL FOR RETAINING WALL BACKFILL & COMPACTION REQUIREMENTS REFER TO SECTION 20 OF PACIFIC GEO - GEOTECHNICAL REPORT: BROADSCALE GEOTECHNICAL INVESTIGATION & LANDSLIDE ASSESSMENT FOR PROPOSED RESIDENTIAL SUBDIVISION. END OF COURTNEY DRIVE, UPPER COOMERA JAN 2023.

PROJECT NAME

COURTNEY DR UPPER COOMERA

STAGE 02

RP DESCRIPTION

LOT 188, 189, 190, 191 & 192 ON RP173728
COURTNEY DRIVE
LOCALITY OF UPPER COOMERA
LOCAL AUTHORITY - GOLD COAST CITY COUNCIL

CLIENT

HB Land

NORTH

0 7.5 15 22.5 30 37.5m
Scale 1:750 - A1 (1:1500 - A3)

REV	DATE	DESCRIPTION	INT
B	19-06-24	PMT'S UPDATED	RK
A	13-10-23	COUNCIL ISSUE	EP

COPYRIGHT IS VESTED IN MORTONS-URBAN SOLUTIONS AND WRITTEN CONSENT IS REQUIRED PRIOR TO REPRODUCTION. DO NOT SCALE FROM THIS DRAWING.

ASSOCIATED CONSULTANTS

BIOME WATER AND ENVIRONMENTAL CONSULTING
Robin Russell & ASSOCIATES PTY. LTD.
BENNETT+BENNETT

DRAWING TITLE

GEOTECHNICAL REQUIREMENTS PLAN

MORTONS urbansolutions
Urban & Regional Planning
Civil Engineering
Project Coordination

MUS Pty Ltd T/As:
Mortons-Urban Solutions
ABN: 39 116 375 065

Postal Address
PO Box 2484
Southport QLD 4215

mortons@urbansolutions.net.au
www.urbansolutions.net.au
Tel 07 5571 1099

Gold Coast Office
Suite 9, 19 Short St
Southport QLD 4215

DESIGNED	RB	DRAWN	EP
APPROVED	RPEQ 4706	DATE	13-10-23

DRAWING NUMBER	REV
41901-02-045	B


F:\Autocad Client\419 - HB Land\01 - Courtney Drive\Precinct-Stage 02\Engineering Drawings\Current\41901-02-045.dwg, GEOTECHNICAL REQUIREMENTS PLAN, 21/06/2024 1:18:10 PM, 1:2

PLANS AND DOCUMENTS referred to in the DEVELOPMENT APPROVAL

Application No: MIN/2024/337

Dated: 16 July 2024

Development shall comply with the conditions of approval as detailed in the Decision Notice and Council's Planning Scheme, Local Laws and Planning Policies

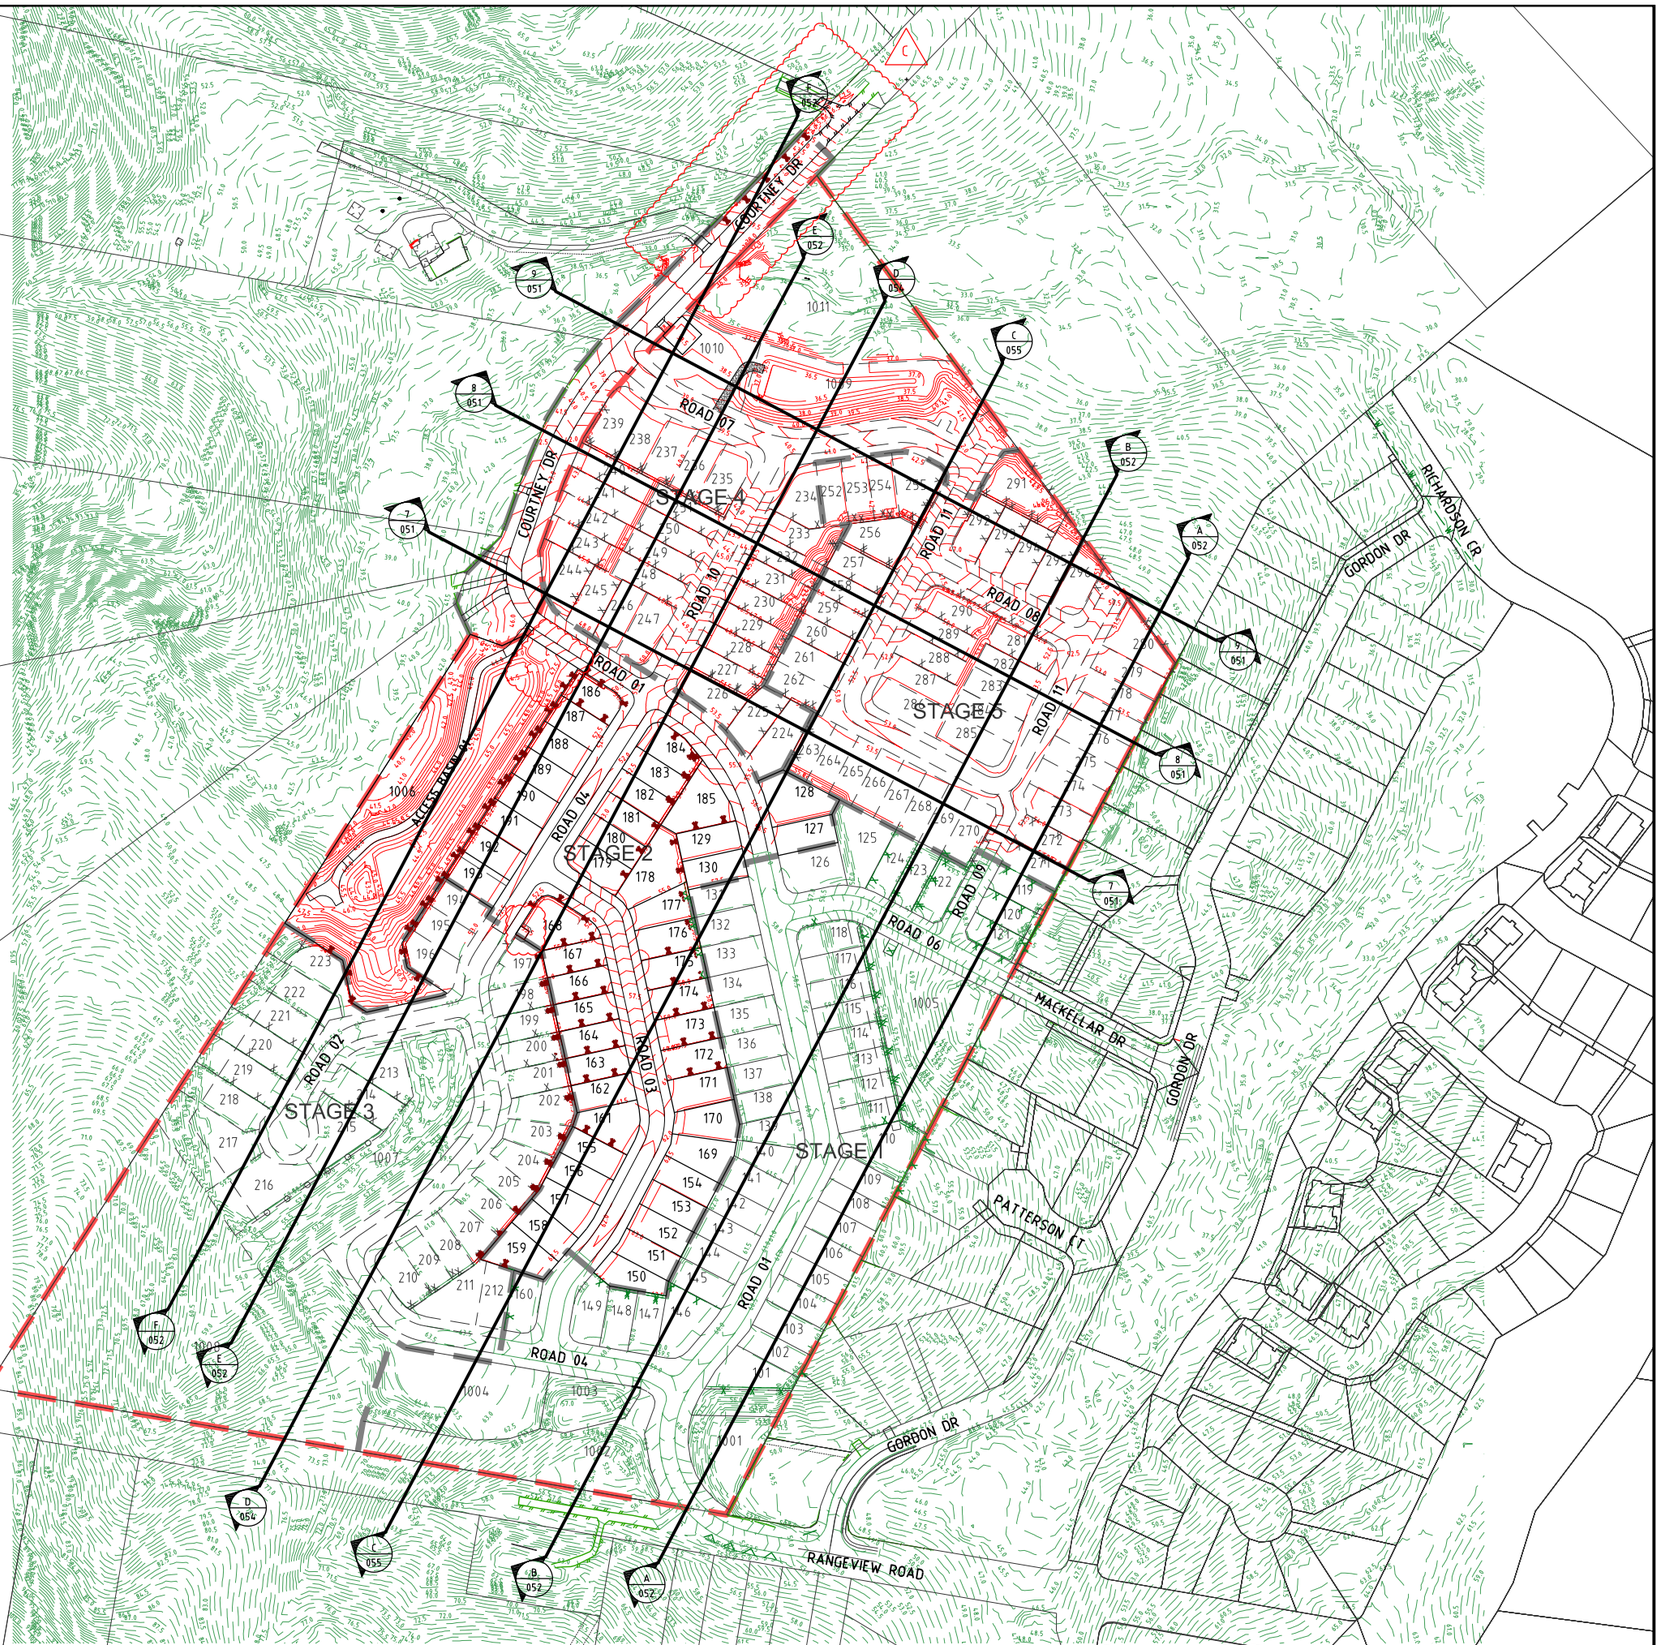

LEGEND

- EXISTING KERB (INVERT)
- EXISTING PROPERTY LINE
- 1.0 EXISTING CONTOURS
- FUTURE KERB (INVERT)
- FUTURE PROPERTY LINE
- PROPOSED KERB (INVERT)
- PROPOSED PROPERTY LINE
- PROPOSED RETAINING WALL
- 1.0 DESIGN CONTOURS
- SITE BOUNDARY
- STAGE BOUNDARY

PROJECT NAME

COURTNEY DR UPPER COOMERA

STAGE 02

RP DESCRIPTION

LOT 188, 189, 190, 191 & 192 ON RP173728
COURTNEY DRIVE
LOCALITY OF UPPER COOMERA
LOCAL AUTHORITY - GOLD COAST CITY COUNCIL

CLIENT

HB Land

NORTH

0 15 30 45 60 75m

Scale 1:1500 - A1 (1:3000 - A3)

REV	DATE	DESCRIPTION	INT
C	13-06-24	CONTOURS & PMT'S UPDATED	RK
B	17-01-24	CONTOURS AMENDED	EP
A	13-10-23	COUNCIL ISSUE	EP

COPYRIGHT IS VESTED IN MORTONS-URBAN SOLUTIONS AND WRITTEN CONSENT IS REQUIRED PRIOR TO REPRODUCTION.
DO NOT SCALE FROM THIS DRAWING.

ASSOCIATED CONSULTANTS

BIOME WATER AND ENVIRONMENTAL CONSULTING

Robin Russell & ASSOCIATES PTY. LTD.

BENNETT+BENNETT

DRAWING TITLE

BULK EARTHWORKS
SECTION KEY PLAN

MORTONS urbansolutions
Urban & Regional Planning
Civil Engineering
Project Coordination

MUS Pty Ltd T/As
Mortons-Urban Solutions
ABN 39 116 375 065

mortons@urbansolutions.net.au
www.urbansolutions.net.au
Tel 07 5571 1099


Postal Address
PO Box 2484
Southport QLD 4215

Gold Coast Office
Suite 9, 19 Short St
Southport QLD 4215

DESIGNED	RB	DRAWN	EP
APPROVED	RPEQ 4706	DATE	13-10-23

DRAWING NUMBER	REV
41901-02-050	C

F:\Autocad Client\419 - HB Land\01 - Courtney Drive\Precinct-Stage 02\Engineering Drawings\Current\41901-02-050.dwg, EARTHWORKS SECTION KEY PLAN, 21/06/2024 11:16:19 PM, 1:2

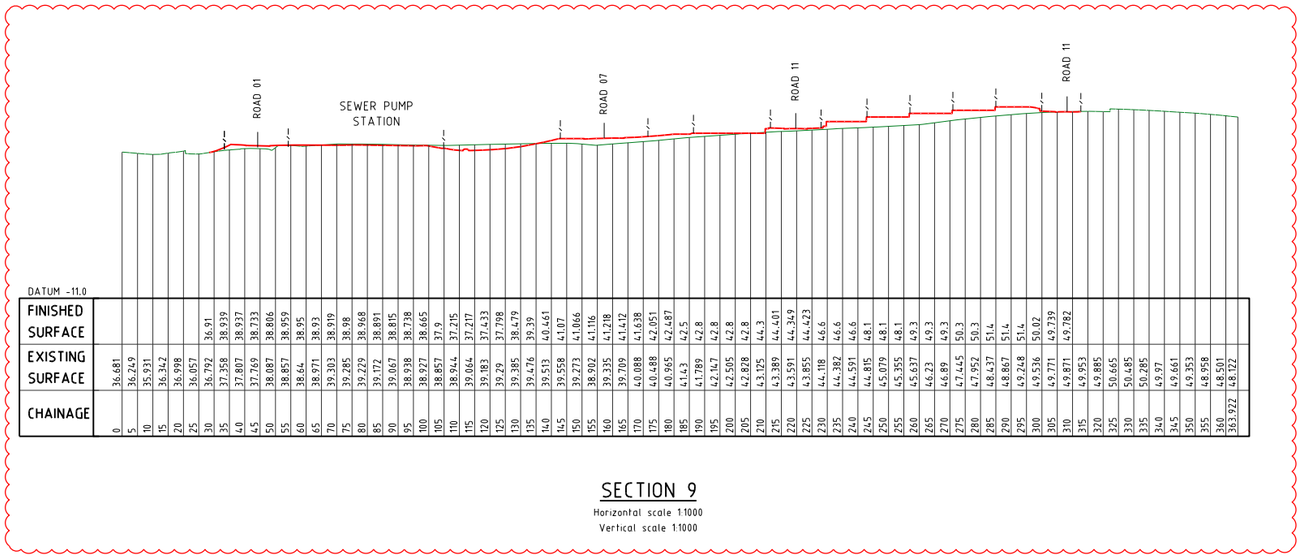


DATUM -11.0

CHAINAGE	FINISHED SURFACE	EXISTING SURFACE
0		36.681
5		36.249
10		35.931
15		36.342
20		36.998
25		36.057
30	36.91	36.792
35	38.939	37.358
40	38.937	37.807
45	38.733	37.769
50	38.806	38.087
55	38.959	38.857
60	38.955	38.64
65	38.93	38.971
70	38.919	39.303
75	38.98	39.285
80	38.968	39.229
85	38.891	39.172
90	38.815	39.067
95	38.738	38.938
100	38.665	38.927
105	37.9	38.857
110	37.215	38.944
115	37.217	39.064
120	37.433	39.183
125	37.798	39.29
130	38.479	39.385
135	39.39	39.476
140	40.461	39.513
145	41.07	39.558
150	41.066	39.273
155	41.116	38.902
160	41.218	39.335
165	41.412	39.709
170	41.638	40.088
175	42.051	40.488
180	42.487	40.965
185	42.5	41.43
190	42.8	41.789
195	42.8	42.147
200	42.8	42.505
205	42.8	42.828
210	42.8	43.125
215	44.3	43.389
220	44.401	43.591
225	44.349	43.855
230	44.423	44.118
235	46.6	44.382
240	46.6	44.591
245	46.6	44.815
250	48.1	45.079
255	48.1	45.355
260	48.3	45.637
265	49.3	46.23
270	49.3	46.89
275	49.3	47.445
280	50.3	47.952
285	51.4	48.437
290	51.4	48.867
295	51.4	49.248
300	50.02	49.536
305	49.739	49.771
310	49.782	49.871
315		49.953
320		49.885
325		50.665
330		50.485
335		50.285
340		49.97
345		49.661
350		49.353
355		48.958
360		48.501
363.922		48.122

SECTION 9

Horizontal scale 1:1000
Vertical scale 1:1000

B

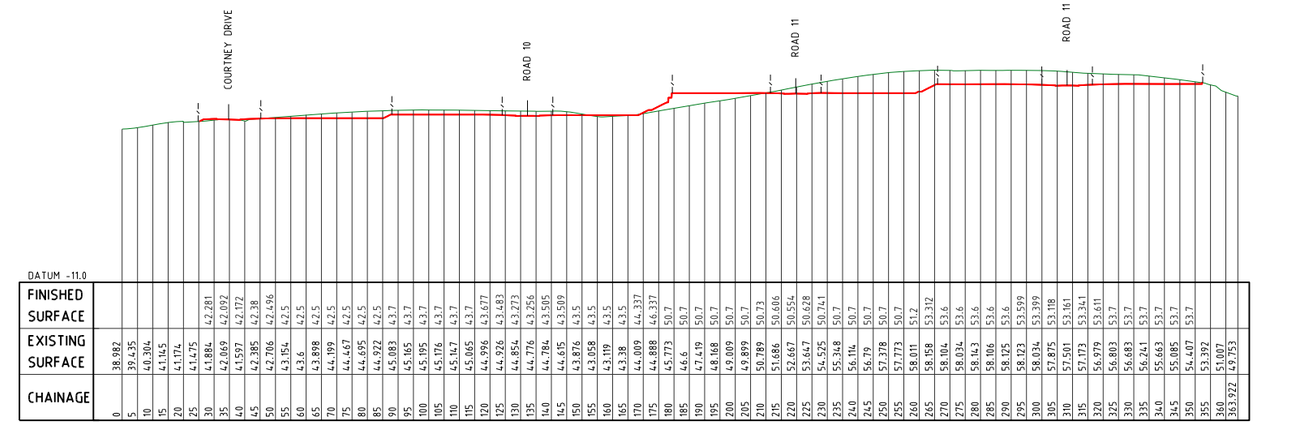


DATUM -11.0

CHAINAGE	FINISHED SURFACE	EXISTING SURFACE
0		38.982
5		39.435
10		40.304
15		41.145
20		41.174
25		41.475
30	42.281	41.884
35	42.092	42.069
40	42.172	41.597
45	42.38	42.385
50	42.496	42.706
55	42.5	43.154
60	42.5	43.6
65	42.5	43.898
70	42.5	44.199
75	42.5	44.467
80	42.5	44.695
85	43.7	44.922
90	43.7	45.083
95	43.7	45.165
100	43.7	45.195
105	43.7	45.176
110	43.7	45.147
115	43.7	45.065
120	43.677	44.996
125	43.483	44.926
130	43.273	44.856
135	43.256	44.776
140	43.505	44.784
145	43.509	44.615
150	43.5	43.876
155	43.5	43.058
160	43.5	43.119
165	43.5	43.38
170	44.337	44.009
175	46.337	44.888
180	50.7	45.773
185	50.7	46.6
190	50.7	47.419
195	50.7	48.168
200	50.7	49.009
205	50.7	49.899
210	50.73	50.789
215	50.606	51.686
220	50.554	52.667
225	50.628	53.647
230	50.741	54.525
235	50.7	55.348
240	50.7	56.114
245	50.7	56.79
250	50.7	57.378
255	50.7	57.773
260	51.2	58.011
265	53.312	58.158
270	53.6	58.104
275	53.6	58.034
280	53.6	58.143
285	53.6	58.106
290	53.6	58.125
295	53.599	58.123
300	53.399	58.034
305	53.118	57.875
310	53.161	57.501
315	53.341	57.173
320	53.611	56.979
325	53.7	56.803
330	53.7	56.683
335	53.7	56.241
340	53.7	55.663
345	53.7	55.085
350	53.7	54.407
355		53.392
360		51.007
363.922		49.753

SECTION 8

Horizontal scale 1:1000
Vertical scale 1:1000

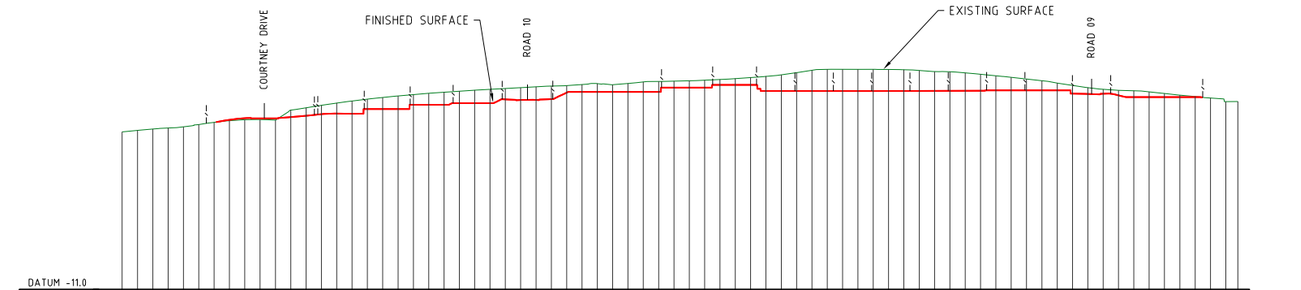

DATUM -11.0

CHAINAGE	FINISHED SURFACE	EXISTING SURFACE
0		40.35
5		40.857
10		41.302
15		41.628
20		42.027
25		42.729
30	43.475	43.475
35	44.27	44.069
40	44.808	44.312
45	44.766	44.354
50	44.767	44.282
55	45.184	47.453
60	45.617	48.216
65	46.142	49.01
70	46.354	49.796
75	46.3	50.429
80	47.8	51.013
85	47.8	51.589
90	47.8	52.092
95	49.2	52.49
100	49.2	52.914
105	49.2	53.334
110	49.7	53.673
115	49.7	54.004
120	49.7	54.258
125	50.965	54.503
130	50.754	54.772
135	50.786	55.068
140	51.043	55.288
145	53.165	55.462
150	53.4	55.8
155	53.4	56.111
160	53.4	55.749
165	53.4	56.165
170	53.4	56.647
175	53.4	56.769
180	54.8	56.928
185	54.8	57.088
190	54.8	57.27
195	55.7	57.451
200	55.7	57.773
205	55.7	58.138
210	53.7	58.504
215	53.7	58.965
220	53.7	59.667
225	53.7	60.441
230	53.7	60.76
235	53.7	60.75
240	53.7	60.75
245	53.7	60.75
250	53.7	60.734
255	53.7	60.628
260	53.7	60.382
265	53.7	60.02
270	53.8	59.964
275	53.8	59.618
280	53.8	59.161
285	53.9	58.671
290	53.9	58.151
295	53.9	57.599
300	53.9	57.047
305	53.9	56.272
310	52.85	55.507
315	52.725	54.778
320	52.782	54.258
325	52.299	53.906
330	51.7	53.177
335	51.7	53.416
340	51.7	52.875
345	51.7	52.356
350	51.7	51.904
355		51.402
360		50.242
363.922		50.277

SECTION 7

Horizontal scale 1:1000
Vertical scale 1:1000

PLANS AND DOCUMENTS referred to in the DEVELOPMENT APPROVAL

Application No: MIN/2024/337

Dated: 16 July 2024

Development shall comply with the conditions of approval as detailed in the Decision Notice and Council's Planning Scheme, Local Laws and Planning Policies

PROJECT NAME

COURTNEY DR UPPER COOMERA

STAGE 02

RP DESCRIPTION

LOT 188, 189, 190, 191 & 192 ON RP173728
COURTNEY DRIVE
LOCALITY OF UPPER COOMERA
LOCAL AUTHORITY - GOLD COAST CITY COUNCIL

CLIENT

HB Land

0 10 20 30 40 50m
Vert. Scale 1:1000 - A1 (1:2000 - A3)

0 10 20 30 40 50m
Horiz. Scale 1:1000 - A1 (1:2000 - A3)

REV	DATE	DESCRIPTION	INT
B	17-01-24	SECTION 9 AMENDED	EP
A	13-10-23	COUNCIL ISSUE	EP

COPYRIGHT IS VESTED IN MORTONS-URBAN SOLUTIONS AND WRITTEN CONSENT IS REQUIRED PRIOR TO REPRODUCTION.
DO NOT SCALE FROM THIS DRAWING.

ASSOCIATED CONSULTANTS

BIOME WATER AND ENVIRONMENTAL CONSULTING
Robin Russell & ASSOCIATES PTY. LTD.
BENNETT + BENNETT

DRAWING TITLE

BULK EARTHWORKS
SECTIONS
SHEET 01

MORTONS urbansolutions
Urban & Regional Planning
Civil Engineering
Project Coordination

MUS Pty Ltd T/As:
Mortons-Urban Solutions
ABN: 39 116 375 065

mortons@urbansolutions.net.au
www.urbansolutions.net.au
Tel 07 5571 1099


Postal Address
PO Box 2484
Southport QLD 4215

Gold Coast Office
Suite 9, 19 Short St
Southport QLD 4215

DESIGNED	RB	DRAWN	EP
APPROVED	RPEQ 4706	DATE	13-10-23

DRAWING NUMBER: 41901-02-051
REV: B


F:\Autocad Client\419 - HB Land\01 - Courtney Drive\Precinct-Stage 02\Engineering Drawings\Current\41901-02-050.dwg, SECTIONS-SHEET 01, 21/06/2024 1:18:25 PM, 1:2

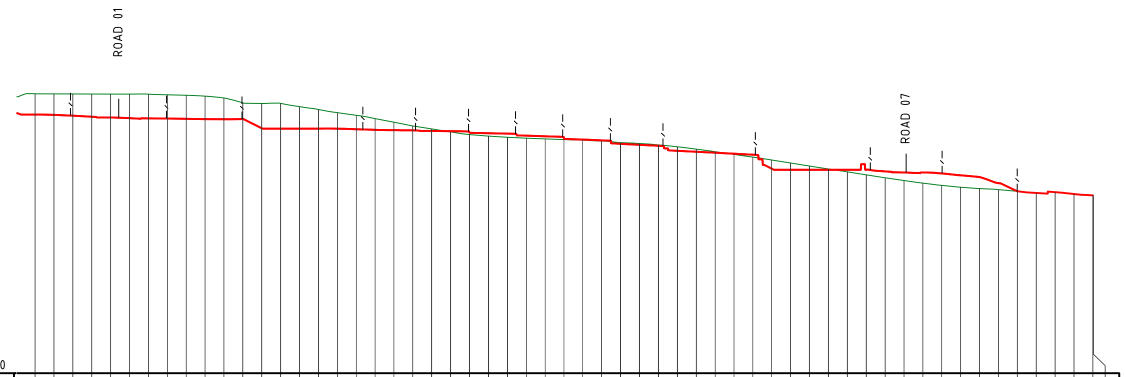

DATUM -11.0

CHAINAGE	FINISHED SURFACE	EXISTING SURFACE
365	57.4	62.905
370	57.34	62.908
375	57.113	62.856
380	56.848	62.85
385	56.623	62.837
390	56.461	62.838
395	56.421	62.781
400	56.411	62.67
405	56.217	62.485
410	56.2	62.217
415	56.2	61.824
420	56.2	60.527
425	53.789	60.378
430	53.7	60.363
435	53.7	59.513
440	53.7	58.755
445	53.7	57.924
450	53.548	57.236
455	53.4	56.353
460	53.29	55.384
465	53.241	54.397
470	53.09	53.621
475	53.021	52.844
480	52.6	52.204
485	52.485	51.794
490	52.361	51.401
495	51.826	51.178
500	51.666	50.954
505	51.015	50.822
510	50.799	50.664
515	50.583	50.414
520	49.672	50.011
525	49.412	49.733
530	49.171	49.368
535	47.824	48.894
540	47.569	48.289
545	47.314	47.544
550	47.059	46.849
555	46.8	46.154
560	43.088	45.412
565	42.8	44.612
570	42.8	43.813
575	42.8	43.026
580	42.8	42.251
585	42.8	41.477
590	42.378	40.663
595	42.078	39.964
600	42.064	39.276
605	41.858	38.654
610	41.35	38.293
615	40.906	37.932
620	39.297	37.554
625		37.12
630		36.689
635		36.893
640		36.407
645		36.024
645.166		36.014

C

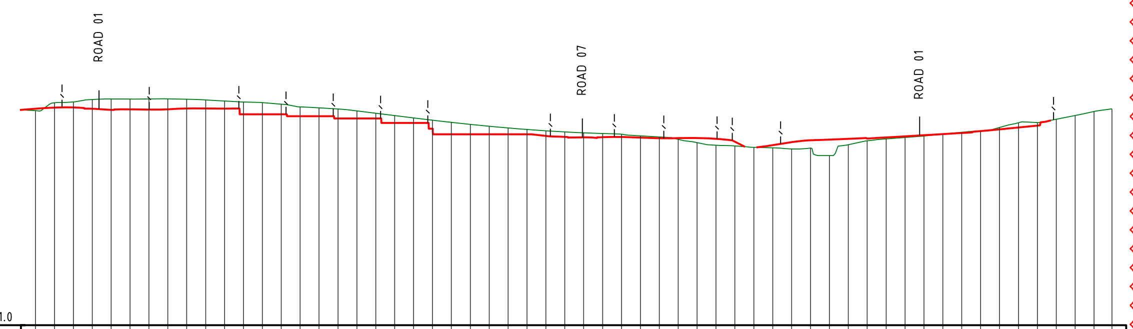


DATUM -11.0

CHAINAGE	FINISHED SURFACE	EXISTING SURFACE
365	46.291	45.766
370	46.533	47.829
375	46.584	48.05
380	46.236	48.694
385	45.981	48.844
390	46.09	48.81
395	46.047	48.834
400	46.099	48.861
405	46.3	48.76
410	46.3	48.593
415	46.3	48.317
420	44.8	48.048
425	44.8	47.877
430	44.8	47.474
435	44.3	46.748
440	44.3	46.478
445	43.7	46.177
450	43.7	45.682
455	43.7	45.068
460	42.5	44.454
465	42.5	43.857
470	41	43.279
475	39.5	42.692
480	39.5	42.114
485	39.5	41.643
490	39.5	41.155
495	39.5	40.765
500	39.085	40.4
505	38.804	40.146
510	38.675	39.934
515	38.728	39.743
520	38.784	39.533
525	38.621	39.077
530	38.469	38.8
535	38.475	38.17
540	38.51	37.28
545	38.274	36.591
550	37.547	36.406
555		36.038
560	36.637	35.906
565	37.384	35.683
570	37.925	35.875
575	38.095	33.884
580	38.294	36.744
585	38.372	37.78
590	38.663	38.271
595	38.96	38.652
600	39.268	39.046
605	39.544	39.553
610	39.85	40.028
615	40.345	40.353
620	40.805	41.301
625	41.296	42.552
630	41.812	42.607
635		43.49
640		44.472
645		45.527
649.736		46.224

SECTION F

Horizontal scale 1:1000
Vertical scale 1:1000

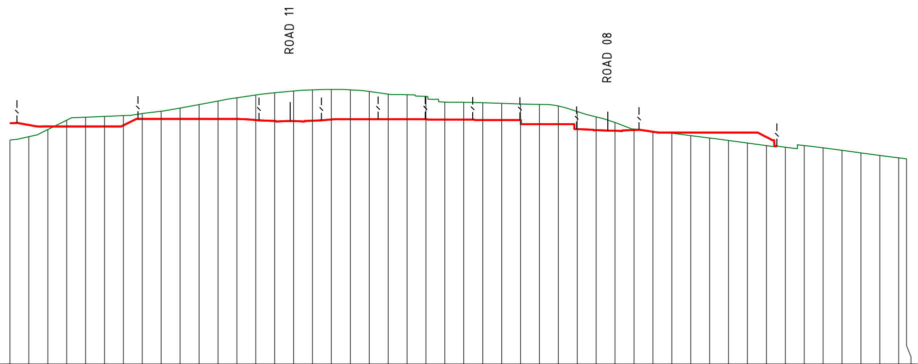


DATUM -11.0

CHAINAGE	FINISHED SURFACE	EXISTING SURFACE
365	52.27	49.182
370	51.9	51.069
375	51.9	53.545
380	51.9	54.343
385	51.9	54.551
390	52.18	54.759
395	53.9	55.285
400	53.9	55.932
405	53.9	56.741
410	53.9	57.676
415	53.9	58.619
420	53.9	59.469
425	53.567	60.208
430	53.341	60.783
435	53.296	61.239
440	53.414	61.543
445	53.728	61.668
450	53.8	61.568
455	53.8	61.12
460	53.8	60.438
465	53.8	60.276
470	53.8	59.809
475	53.7	58.336
480	53.7	58.264
485	53.6	58.132
490	53.6	58.002
495	53.6	57.829
500	52.5	57.695
505	52.5	57.32
510	51.179	55.826
515	50.895	54.431
520	50.745	52.951
525	50.934	51.196
530	50.501	50.546
535	50.3	50.106
540	50.3	49.48
545	50.3	48.853
550	50.3	48.182
555	50.3	47.511
560	49.1	46.84
565		46.416
570		46.841
575		46.246
580		45.581
585		44.913
590		44.218
595		43.602
597.051		43.325

SECTION B

Horizontal scale 1:1000
Vertical scale 1:1000

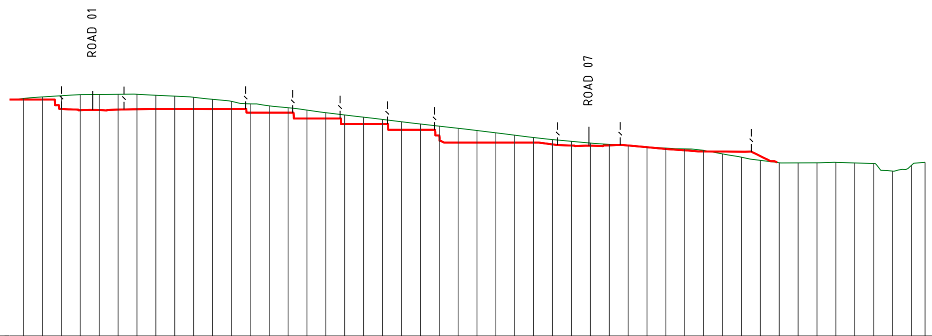

DATUM -11.0

CHAINAGE	FINISHED SURFACE	EXISTING SURFACE
360	51.7	51.967
365	51.7	52.385
370	49.203	52.705
375	48.887	52.992
380	48.899	53.018
385	49.038	53.067
390	49.16	53.077
395	49.2	52.832
400	49.2	52.582
405	49.2	52.273
410	49.2	51.752
415	49.2	51.196
420	48.2	50.557
425	48.2	50.025
430	48.2	49.519
435	46.7	48.896
440	46.7	48.203
445	45.2	47.616
450	45.2	47.02
455	45.2	46.418
460	43.7	45.82
465	43.7	45.226
470	42.2	44.658
475	40.3	44.08
480	40.3	43.482
485	40.3	42.878
490	40.3	42.263
495	40.3	41.649
500	39.831	41.09
505	39.531	40.63
510	39.486	40.171
515	39.573	39.822
520	39.545	39.503
525	39.082	39.039
530	38.618	38.839
535	38.243	38.647
540	37.95	38.255
545	37.913	37.323
550	37.889	36.441
555	36.734	35.609
560		34.984
565		34.929
570		34.957
575		35.063
580		34.922
585		34.774
590		32.755
595		34.296
598.595		35.092

SECTION E


Horizontal scale 1:1000
Vertical scale 1:1000

PLANS AND DOCUMENTS referred to in the DEVELOPMENT APPROVAL

Application No: MIN/2024/337

Dated: 16 July 2024

Development shall comply with the conditions of approval as detailed in the Decision Notice and Council's Planning Scheme, Local Laws and Planning Policies

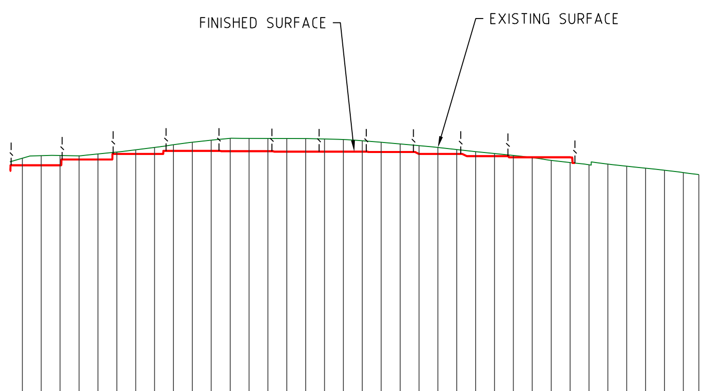


DATUM -11.0

CHAINAGE	FINISHED SURFACE	EXISTING SURFACE
375	50.2	52.057
380	50.2	52.73
385	50.2	52.777
390	51.7	52.7
395	51.7	53.193
400	53.2	53.678
405	53.2	54.284
410	53.2	54.92
415	54	55.628
420	54	56.3
425	54	56.836
430	53.9	57.334
435	53.9	57.298
440	53.9	57.281
445	53.8	57.263
450	53.8	57.245
455	53.8	57.143
460	53.8	57
465	53.8	56.649
470	53.7	56.249
475	53.7	55.851
480	53.2	55.39
485	53.2	54.906
490	53.2	54.347
495	52.6	53.787
500	52.6	53.302
505	52.3	52.798
510	52.3	52.165
515	52.3	51.498
520	52.3	50.92
525		50.338
530		50.52
535		49.931
540		49.432
545		48.878
550		48.251
554.081		47.756

SECTION A

Horizontal scale 1:1000
Vertical scale 1:1000

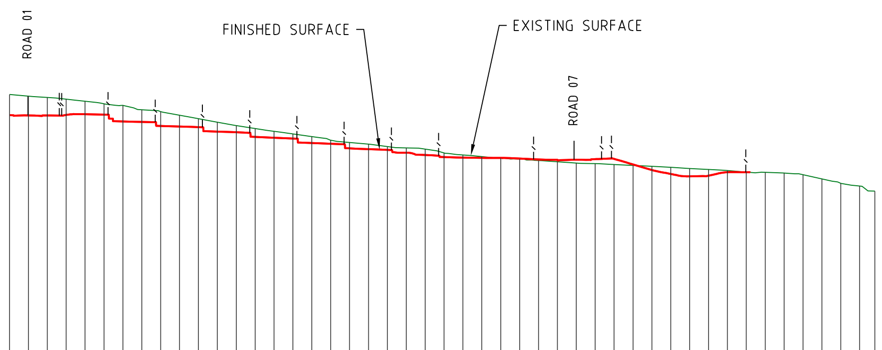

DATUM -11.0

CHAINAGE	FINISHED SURFACE	EXISTING SURFACE
430	52.46	57.54
435	52.448	57.196
440	52.577	56.746
445	52.758	56.198
450	52.655	55.518
455	50.858	55.099
460	50.738	53.951
465	49.678	53.46
470	49.522	52.482
475	49.363	51.572
480	48.177	50.66
485	47.988	49.772
490	46.793	48.991
495	46.57	48.25
500	46.366	47.552
505	45.15	46.841
510	44.948	45.911
515	43.75	45.297
520	43.544	44.853
525	43.322	44.228
530	42.583	43.884
535	41.975	43.562
540	41.468	42.553
545	41.3	42.006
550	41.232	41.575
555	41.222	41.164
560	41.067	40.934
565	40.82	40.526
570	40.716	40.194
575	40.756	39.85
580	40.893	39.71
585	40.982	39.471
590	39.505	39.24
595	38.006	38.999
600	36.988	38.761
605	36.4	38.425
610	36.532	38.168
615	37.45	37.906
620	37.45	37.472
625		37.409
630		37.218
635		36.797
640		35.693
645		34.512
650		33.811
653.995		32.46

SECTION D

Horizontal scale 1:1000
Vertical scale 1:1000

PROJECT NAME

COURTNEY DR UPPER COOMERA

STAGE 02

RP DESCRIPTION

LOT 188, 189, 190, 191 & 192 ON RP173728
COURTNEY DRIVE
LOCALITY OF UPPER COOMERA
LOCAL AUTHORITY - GOLD COAST CITY COUNCIL

CLIENT

HB Land

0 10 20 30 40 50m
Vert. Scale 1:1000 - A1 (1:2000 - A3)

0 10 20 30 40 50m
Horiz. Scale 1:1000 - A1 (1:2000 - A3)

REV	DATE	DESCRIPTION	INT
C	18-06-23	SECTION F AMENDED	RK
B	17-01-24	SECTION F AMENDED	EP
A	13-10-23	COUNCIL ISSUE	EP

COPYRIGHT IS VESTED IN MORTONS-URBAN SOLUTIONS AND WRITTEN CONSENT IS REQUIRED PRIOR TO REPRODUCTION. DO NOT SCALE FROM THIS DRAWING.

ASSOCIATED CONSULTANTS

BIOME WATER AND ENVIRONMENTAL CONSULTING
Robin Russell & ASSOCIATES PTY. LTD.
BENNETT + BENNETT

DRAWING TITLE

BULK EARTHWORKS
SECTIONS
SHEET 02

MORTONS urbansolutions
Urban & Regional Planning
Civil Engineering
Project Coordination
MUS Pty Ltd T/As:
Mortons-Urban Solutions
ABN: 39 116 375 065
mortons@urbansolutions.net.au
www.urbansolutions.net.au
Tel 07 5571 1099
Postal Address
PO Box 2484
Southport QLD 4215
Gold Coast Office
Suite 9, 19 Short St
Southport QLD 4215

DESIGNED	RB	DRAWN	EP
APPROVED	W.K. [signature]	RPEQ 4706	DATE 13-10-23

DRAWING NUMBER	REV
41901-02-052	C

PLANS AND DOCUMENTS referred to in the DEVELOPMENT APPROVAL

Application No: MIN/2024/337

Dated: 16 July 2024


Development shall comply with the conditions of approval as detailed in the Decision Notice and Council's Planning Scheme, Local Laws and Planning Policies

GENERAL

1. CONTRACT SPECIFICATIONS
   ALL DRAWINGS ARE TO BE READ IN CONJUNCTION WITH THE CONTRACT SPECIFICATION.
2. SETOUT
   SURVEY SETOUT INFORMATION HAS BEEN ESTABLISHED ON SITE BY THE PRINCIPAL'S SURVEYOR TO ENABLE THE CONTRACTOR TO ACCURATELY SETOUT THE WORKS TO THE CO-ORDINATES SHOWN. SETOUT INFORMATION SHALL NOT BE OBTAINED BY SCALING FROM THESE DRAWINGS.
3. DATUM
   LEVELS SHOWN ARE TO A.H.D.
4. EXISTING SERVICES - EXTERNAL WORKS
   THE LOCATIONS OF ALL EXISTING SERVICES WITHIN THE WORK AREA SHALL BE CONFIRMED BY THE CONTRACTOR PRIOR TO CONSTRUCTION COMMENCING. IT IS THE CONTRACTOR'S RESPONSIBILITY TO CONTACT THE RELEVANT AUTHORITIES & TO ENSURE THAT THE EXISTING SERVICES ARE NOT DAMAGED OR DISTURBED IN ANY WAY BY THE CONTRACT WORKS.
5. ALL MATERIALS ARISING FROM RETAINING WALL CONSTRUCTION ARE TO BE COMPACTED TO FUTURE STAGES, TO LEVEL 1 OR IF DIRECTED BY THE SUPERINTENDENT SHALL BE TRUCKED TO A LICENSED TIP.


LEGEND

- EXISTING KERB (INVERT)
- EXISTING PROPERTY LINE
- 1.0 EXISTING CONTOURS
- EXISTING RETAINING WALL
- FUTURE KERB (INVERT)
- FUTURE PROPERTY LINE
- 1.0 FUTURE CONTOURS
- FUTURE RETAINING WALL
- PROPOSED KERB (INVERT)
- PROPOSED PROPERTY LINE
- 1.0 DESIGN CONTOURS
- PROPOSED SINGLE TIER RETAINING WALL
- PROPOSED TWO TIER RETAINING WALL
- PL50.4 NOMINAL LOT PAD LEVEL
- RH1.0 INDICATIVE WALL HEIGHT
- DETAIL PAD FALL DIRECTION (CONTRACTOR TO ENSURE LOTS FALL TO ROAD AT 1:150 MIN. REFER DRG. 071)

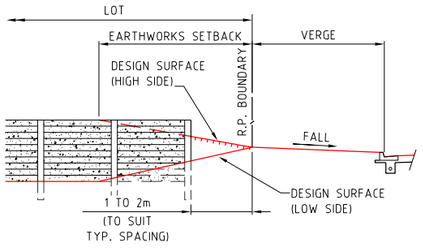

TYPICAL SIDE BOUNDARY CONSTRUCTION


SCALE 1:100 - A1 (1:200 - A3)

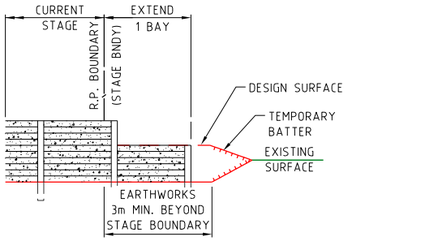


TYPICAL STAGE BOUNDARY CONSTRUCTION

SCALE 1:100 - A1 (1:200 - A3)

SHEET LAYOUT

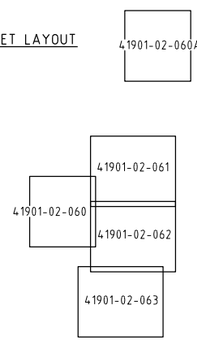

DIAL BEFORE YOU DIG www.1100.com.au

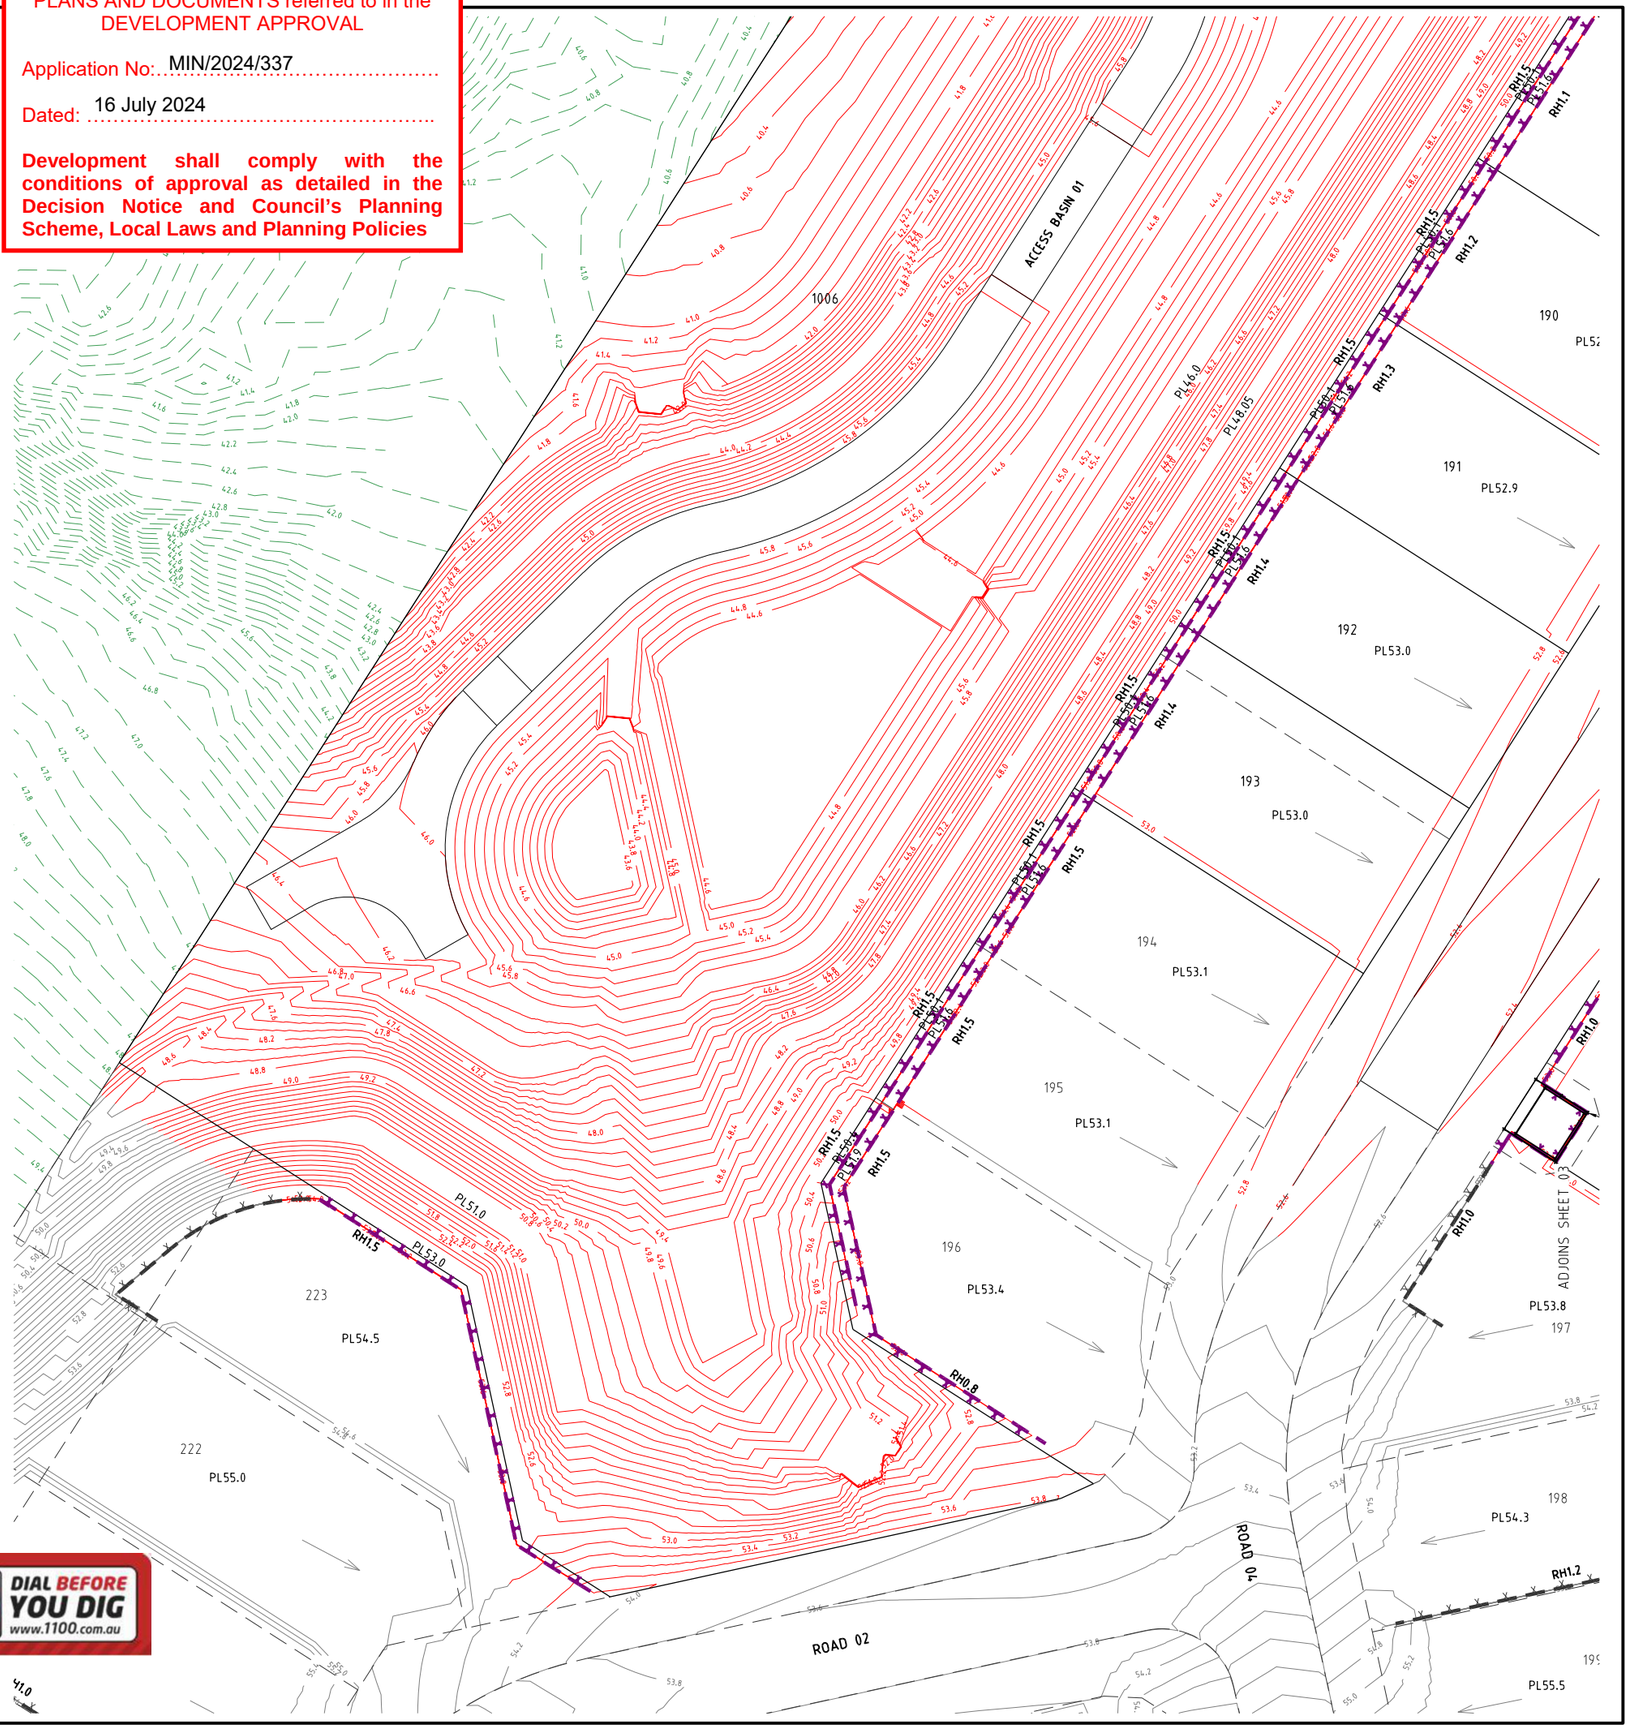

PROJECT NAME

COURTNEY DR UPPER COOMERA

STAGE 02

RP DESCRIPTION

LOT 188, 189, 190, 191 & 192 ON RP173728
COURTNEY DRIVE
LOCALITY OF UPPER COOMERA
LOCAL AUTHORITY - GOLD COAST CITY COUNCIL

CLIENT

HB Land

NORTH

0 2.5 5 7.5 10 12.5m

Scale 1:250 - A1 (1:500 - A3)

REV	DATE	DESCRIPTION	INT
C	14-06-24	SHEET LAYOUT AMENDED	RK
B	29/11/23	CONTOURS UPDATED	BL
A	13-10-23	COUNCIL ISSUE	EP

COPYRIGHT IS VESTED IN MORTONS-URBAN SOLUTIONS AND WRITTEN CONSENT IS REQUIRED PRIOR TO REPRODUCTION. DO NOT SCALE FROM THIS DRAWING.

ASSOCIATED CONSULTANTS

BIOME WATER AND ENVIRONMENTAL CONSULTING

Robin Russell & ASSOCIATES PTY. LTD.

BENNETT + BENNETT

DRAWING TITLE

RETAINING WALL AND DETAIL GRADING PLAN SHEET 01

MORTONS urbansolutions
Urban & Regional Planning
Civil Engineering
Project Coordination

MUS Pty Ltd T/As:
Mortons-Urban Solutions
ABN: 39 116 375 065
mortons@urbansolutions.net.au
www.urbansolutions.net.au
Tel 07 5571 1099

Postal Address
PO Box 2484
Southport QLD 4215

Gold Coast Office
Suite 9, 19 Short St
Southport QLD 4215


DESIGNED	RB	DRAWN	EP
APPROVED		RPEQ 4706	DATE 13-10-23

DRAWING NUMBER	REV
41901-02-060	C

F:\Autocad Client\419 - HB Land\01 - Courtney Drive\Precinct-Stage 02\Engineering Drawings\Current\41901-02-060.dwg, PLAN SHEET 01, 21/06/2024 1:19:01 PM, 1:2

WALL PROFILE

SCALE 1:250 - A1 (1:500 - A3)

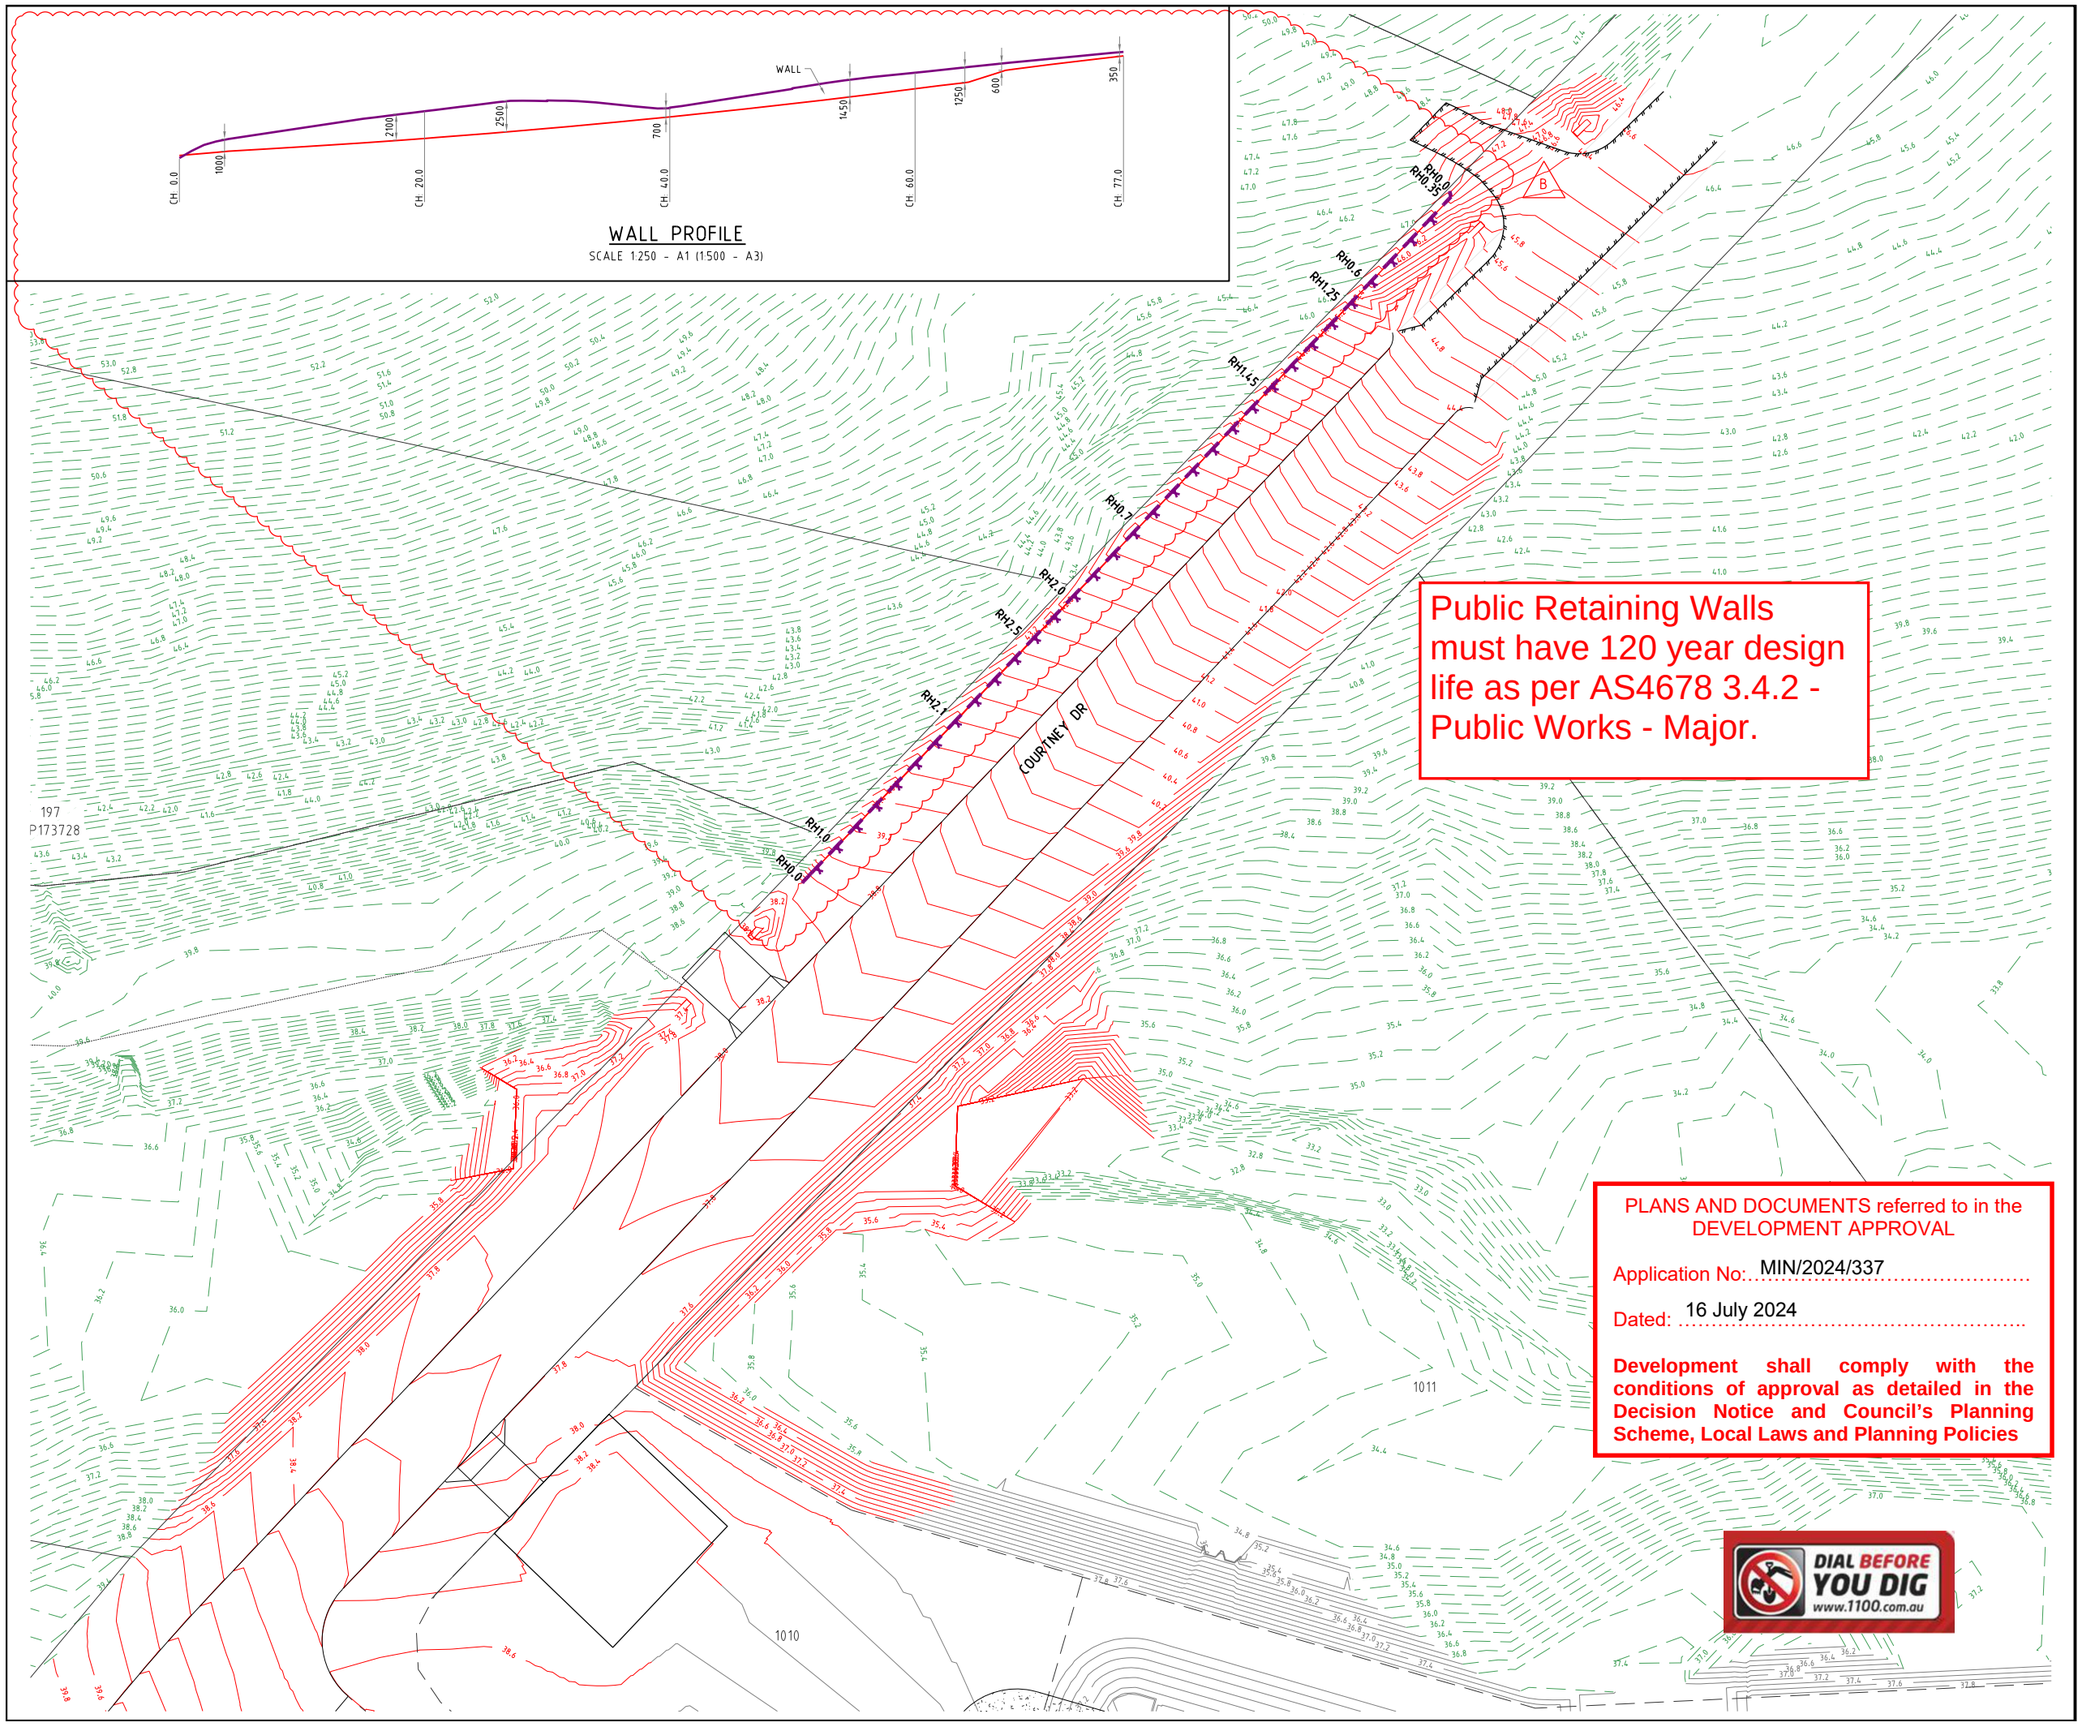

Public Retaining Walls must have 120 year design life as per AS4678 3.4.2 - Public Works - Major.

PLANS AND DOCUMENTS referred to in the DEVELOPMENT APPROVAL

Application No: MIN/2024/337

Dated: 16 July 2024

Development shall comply with the conditions of approval as detailed in the Decision Notice and Council's Planning Scheme, Local Laws and Planning Policies

DIAL BEFORE YOU DIG www.1100.com.au

PROJECT NAME

COURTNEY DR UPPER COOMERA

STAGE 02

RP DESCRIPTION

LOT 188, 189, 190, 191 & 192 ON RP173728
COURTNEY DRIVE
LOCALITY OF UPPER COOMERA
LOCAL AUTHORITY - GOLD COAST CITY COUNCIL

CLIENT

HB Land

NORTH

0 2.5 5 7.5 10 12.5m

Scale 1:250 - A1 (1:500 - A3)

REV	DATE	DESCRIPTION	INT
B	15-07-24	WALL HEIGHTS & PROFILE ADDED	EP
A	13-10-23	COUNCIL ISSUE	EP

COPYRIGHT IS VESTED IN MORTONS-URBAN SOLUTIONS AND WRITTEN CONSENT IS REQUIRED PRIOR TO REPRODUCTION. DO NOT SCALE FROM THIS DRAWING.

ASSOCIATED CONSULTANTS

BIOME WATER AND ENVIRONMENTAL CONSULTING

Robin Russell & ASSOCIATES PTY. LTD.

BENNETT+BENNETT

DRAWING TITLE

RETAINING WALL
AND DETAIL GRADING PLAN
SHEET 01A

MORTONS urbansolutions
Urban & Regional Planning
Civil Engineering
Project Coordination

MUS Pty Ltd T/As:
Mortons-Urban Solutions
ABN: 39 116 375 065
mortons@urbansolutions.net.au
www.urbansolutions.net.au
Tel 07 5571 1099

Postal Address
PO Box 2484
Southport QLD 4215

Gold Coast Office
Suite 9, 19 Short St
Southport QLD 4215

DESIGNED	RB	DRAWN	EP
APPROVED	RPEQ 4706	DATE	13-10-23

DRAWING NUMBER	REV
41901-02-060A	B

F:\Autocad Client\419 - HB Land\01 - Courtney Drive\Precinct-Stage 02\Engineering Drawings\Current\41901-02-060.dwg, PLAN SHEET 01 A, 15/07/2024 2:24:56 PM, 1:2

PLANS AND DOCUMENTS referred to in the DEVELOPMENT APPROVAL

Application No: MIN/2024/337

Dated: 16 July 2024

Development shall comply with the conditions of approval as detailed in the Decision Notice and Council's Planning Scheme, Local Laws and Planning Policies

PROJECT NAME

COURTNEY DR UPPER COOMERA

STAGE 02

RP DESCRIPTION

LOT 188, 189, 190, 191 & 192 ON RP173728
COURTNEY DRIVE
LOCALITY OF UPPER COOMERA
LOCAL AUTHORITY - GOLD COAST CITY COUNCIL

CLIENT

HB Land

NORTH

0 2.5 5 7.5 10 12.5m

Scale 1:250 - A1 (1:500 - A3)

REV	DATE	DESCRIPTION	INT
C	19-06-24	PMT LOCATION AMENDED	RK
B	29-11-23	CONTOURS UPDATED	BL
A	13-10-23	COUNCIL ISSUE	EP

COPYRIGHT IS VESTED IN MORTONS-URBAN SOLUTIONS AND WRITTEN CONSENT IS REQUIRED PRIOR TO REPRODUCTION. DO NOT SCALE FROM THIS DRAWING.

ASSOCIATED CONSULTANTS

BIOME WATER AND ENVIRONMENTAL CONSULTING

Robin Russell & ASSOCIATES PTY. LTD.

BENNETT+BENNETT

DRAWING TITLE

RETAINING WALL
AND DETAIL GRADING PLAN
SHEET 02

MORTONS urbansolutions
Urban & Regional Planning
Civil Engineering
Project Coordination

MUS Pty Ltd T/As:
Mortons-Urban Solutions
ABN: 39 116 375 065

Postal Address
PO Box 2484
Southport QLD 4215

mortons@urbansolutions.net.au
www.urbansolutions.net.au
Tel 07 5571 1099

Gold Coast Office
Suite 9, 19 Short St
Southport QLD 4215

DESIGNED	RB	DRAWN	EP
APPROVED	RPEQ 4706	DATE	13-10-23

DRAWING NUMBER: 41901-02-061

REV: C

F:\Autocad Client\419 - HB Land\01 - Courtney Drive\Precinct-Stage 02\Engineering Drawings\Current\41901-02-060.dwg, PLAN SHEET 02, 21/06/2024 1:19:44 PM, 1:2

PLANS AND DOCUMENTS referred to in the DEVELOPMENT APPROVAL

Application No: MIN/2024/337

Dated: 16 July 2024

Development shall comply with the conditions of approval as detailed in the Decision Notice and Council's Planning Scheme, Local Laws and Planning Policies

ROAD 04

ROAD 03

ROAD 06

ROAD 01

ADJOINS SHEET 01

REFER TO STRUCTURAL ARTS SK-01 FOR RETAINING WALL DETAILS

PROJECT NAME

COURTNEY DR UPPER COOMERA

STAGE 02

RP DESCRIPTION

LOT 188, 189, 190, 191 & 192 ON RP173728
COURTNEY DRIVE
LOCALITY OF UPPER COOMERA
LOCAL AUTHORITY - GOLD COAST CITY COUNCIL

CLIENT

HB Land

NORTH

0 2.5 5 7.5 10 12.5m

Scale 1:250 - A1 (1:500 - A3)

REV	DATE	DESCRIPTION	INT
B	29-11-23	CONTOURS UPDATED	BL
A	13-10-23	COUNCIL ISSUE	EP

COPYRIGHT IS VESTED IN MORTONS-URBAN SOLUTIONS AND WRITTEN CONSENT IS REQUIRED PRIOR TO REPRODUCTION.
DO NOT SCALE FROM THIS DRAWING.

ASSOCIATED CONSULTANTS

BIOME WATER AND ENVIRONMENTAL CONSULTING

Robin Russell & ASSOCIATES PTY. LTD.

BENNETT + BENNETT

DRAWING TITLE

RETAINING WALL
AND DETAIL GRADING PLAN
SHEET 03

MORTONS urbansolutions
Urban & Regional Planning
Civil Engineering
Project Coordination

MUS Pty Ltd T/As:
Mortons-Urban Solutions
ABN: 39 116 375 065
mortons@urbansolutions.net.au
www.urbansolutions.net.au
Tel 07 5571 1099

Postal Address
PO Box 2484
Southport QLD 4215

Gold Coast Office
Suite 9, 19 Short St
Southport QLD 4215

DESIGNED	RB	DRAWN	EP
APPROVED	RPEQ 4706	DATE	13-10-23

DRAWING NUMBER	REV
41901-02-062	B

F:\Autocad Client\419 - HB Land\01 - Courtney Drive\Precinct-Stage 02\Engineering Drawings\Current\41901-02-060.dwg, PLAN SHEET 03, 21/06/2024 12:20:05 PM, 1:2

PROJECT NAME

COURTNEY DR UPPER COOMERA

STAGE 02

RP DESCRIPTION

LOT 188, 189, 190, 191 & 192 ON RP173728
COURTNEY DRIVE
LOCALITY OF UPPER COOMERA
LOCAL AUTHORITY - GOLD COAST CITY COUNCIL

CLIENT

HB Land

NORTH

0 2.5 5 7.5 10 12.5m
Scale 1:250 - A1 (1:500 - A3)

PLANS AND DOCUMENTS referred to in the DEVELOPMENT APPROVAL

Application No: MIN/2024/337

Dated: 16 July 2024

Development shall comply with the conditions of approval as detailed in the Decision Notice and Council's Planning Scheme, Local Laws and Planning Policies

REV	DATE	DESCRIPTION	INIT
B	29-11-23	CONTOURS UPDATED	BL
A	13-10-23	COUNCIL ISSUE	EP

COPYRIGHT IS VESTED IN MORTONS-URBAN SOLUTIONS AND WRITTEN CONSENT IS REQUIRED PRIOR TO REPRODUCTION. DO NOT SCALE FROM THIS DRAWING.

ASSOCIATED CONSULTANTS

BIOME WATER AND ENVIRONMENTAL CONSULTING

Robin Russell & ASSOCIATES PTY. LTD.

BENNETT+BENNETT

DRAWING TITLE

RETAINING WALL
AND DETAIL GRADING PLAN
SHEET 04

MORTONS urbansolutions
Urban & Regional Planning
Civil Engineering
Project Coordination

MUS Pty Ltd T/As:
Mortons-Urban Solutions
ABN: 39 116 375 065
mortons@urbansolutions.net.au
www.urbansolutions.net.au
Tel 07 5571 1099

Postal Address
PO Box 2484
Southport QLD 4215

Gold Coast Office
Suite 9, 19 Short St
Southport QLD 4215

DESIGNED	RB	DRAWN	EP
APPROVED	RPEQ 4706	DATE	13-10-23


DRAWING NUMBER	REV
41901-02-063	B

F:\Autocad Client\419 - HB Land\01 - Courtney Drive\Precinct-Stage 02\Engineering Drawings\Current\41901-02-060.dwg, PLAN SHEET 04, 21/06/2024 1:20:28 PM, 1:2

NOTES:

1. RETAINING WALL DETAILS ARE INDICATIVE ONLY.
2. CONTRACTOR TO ARRANGE FOR DESIGN & CONSTRUCTION OF WALLS BY RPEQ STRUCTURAL ENGINEER. CONTRACTOR TO PROVIDE STRUCTURAL CERTIFICATION OF DESIGN & FINAL CONSTRUCTION.
3. ALLOW FOR 5KPa LOADING TO WALLS EXCEPT ADJACENT TO ROADS WHICH REQUIRE A 10kPa LOADING.
4. CONTRACTOR TO CONFIRM LOCATION OF LOT BOUNDARY PRIOR TO COMMENCING WALL CONSTRUCTION.
5. THE BUILDING ON THE HIGHER SIDE OF THE RETAINING WALL MUST MAINTAIN AN OFFSET OR APPROPRIATE FOUNDATION STRUCTURES (EG. PIERS) IN ORDER TO ENSURE THE ENTIRE DEPTH OF THE RETAINING WALL IS FREE FROM THE ZONE OF INFLUENCE OF THE BUILDING/OVERBURDEN LOAD UNLESS OTHERWISE SPECIFIED BY STRUCTURAL ENGINEER.
6. STRUCTURAL ENGINEER TO DESIGN SLAB & PIER.
7. AGRICULTURAL DRAIN TO DISCHARGE TO 300x300mm STORMWATER PIT. HOUSE BUILDER TO CONNECT 300x300mm STORMWATER PIT TO ROOFWATER SYSTEM.
8. RETAINING WALL DESIGN TO ALLOW FOR ALL SERVICES (ADJACENT OR BELOW) & HAVE NO IMPACT.
9. SANDSTONE & PROPRIETARY RETAINING WALLS TO BE DESIGNED & CONSTRUCTED TO HAVE VERTICAL FACE UNLESS OTHERWISE AGREED BY THE SUPERINTENDENT.
10. ANY WALL GREATER THAN 0.9M HIGH TO INSTALL A FALL BARRIER AT THE TOP OF WALL. THE FALL BARRIER IS TO BE MAINTAINED UNTIL THE END OF THE MAINTENANCE PERIOD OR THE ASSOCIATED LOT IS SOLD BY THE DEVELOPER.
11. REFER TO LANDSCAPE ARCHITECT FOR RETAINING WALL COLOUR & FINISH.
12. * SETBACK FROM BOUNDARY TO BE
    200mm SIDE BOUNDARY
    600mm ROAD RESERVE/OPEN SPACE
13. WHERE RETAINING WALLS ARE LOCATED WITHIN 2m OF A PMT SITE THE RETAINING WALL IS TO BE DESIGNED & CONSTRUCTED TO ALLOW EXCAVATION OF THE FULL PMT SITE TO A DEPTH OF 1.3m.
14. FENCE BRACKETS TO BE INSTALLEDON POSTS. NO BRACKETS 5m FROM FRONT BOUNDARY.
15. ALL FOOTINGS MUST BE A MINIMUM OF 200mm FROM PROPERTY BOUNDARY.

B

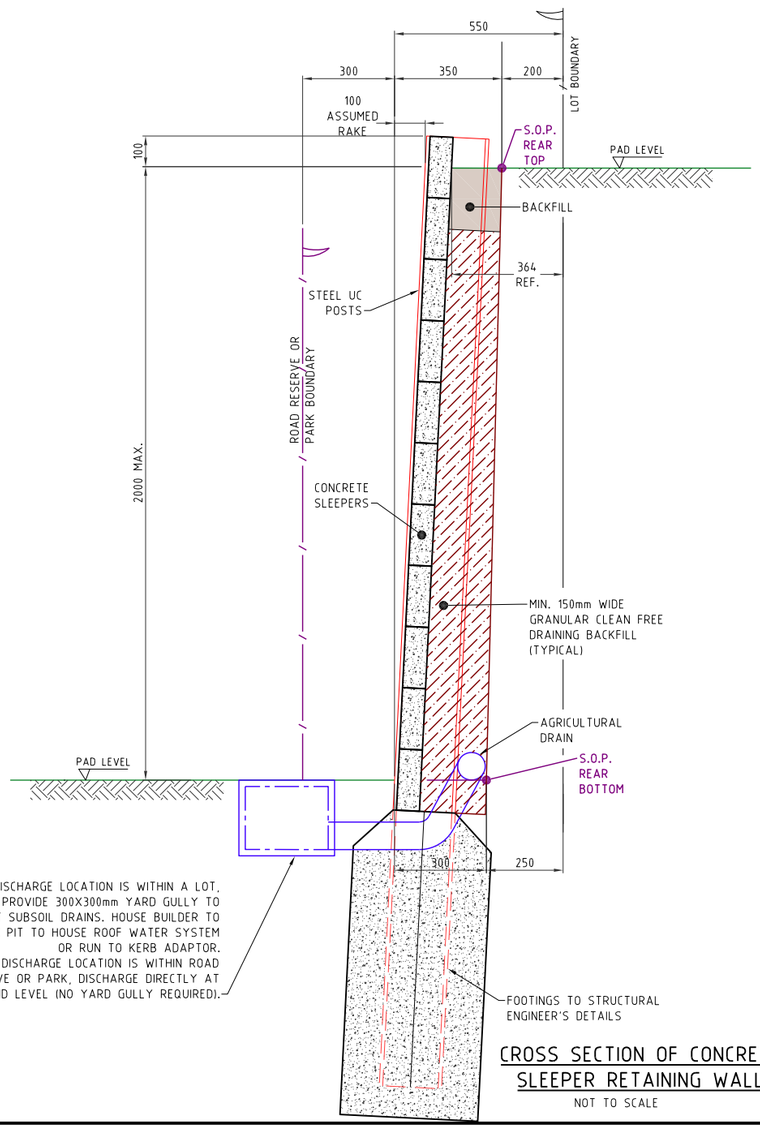

CROSS SECTION OF CONCRETE SLEEPER RETAINING WALL

NOT TO SCALE

RETAINING WALL COLOUR AND FACE FINISH NOTE:


1. RETAINING WALL COLOUR AND FINISH IS TO BE CHARCOAL COLOUR WITH SPLIT FACE, STONE PATTERN FINISH

PLANS AND DOCUMENTS referred to in the DEVELOPMENT APPROVAL

Application No: MIN/2024/337

Dated: 16 July 2024

Development shall comply with the conditions of approval as detailed in the Decision Notice and Council's Planning Scheme, Local Laws and Planning Policies

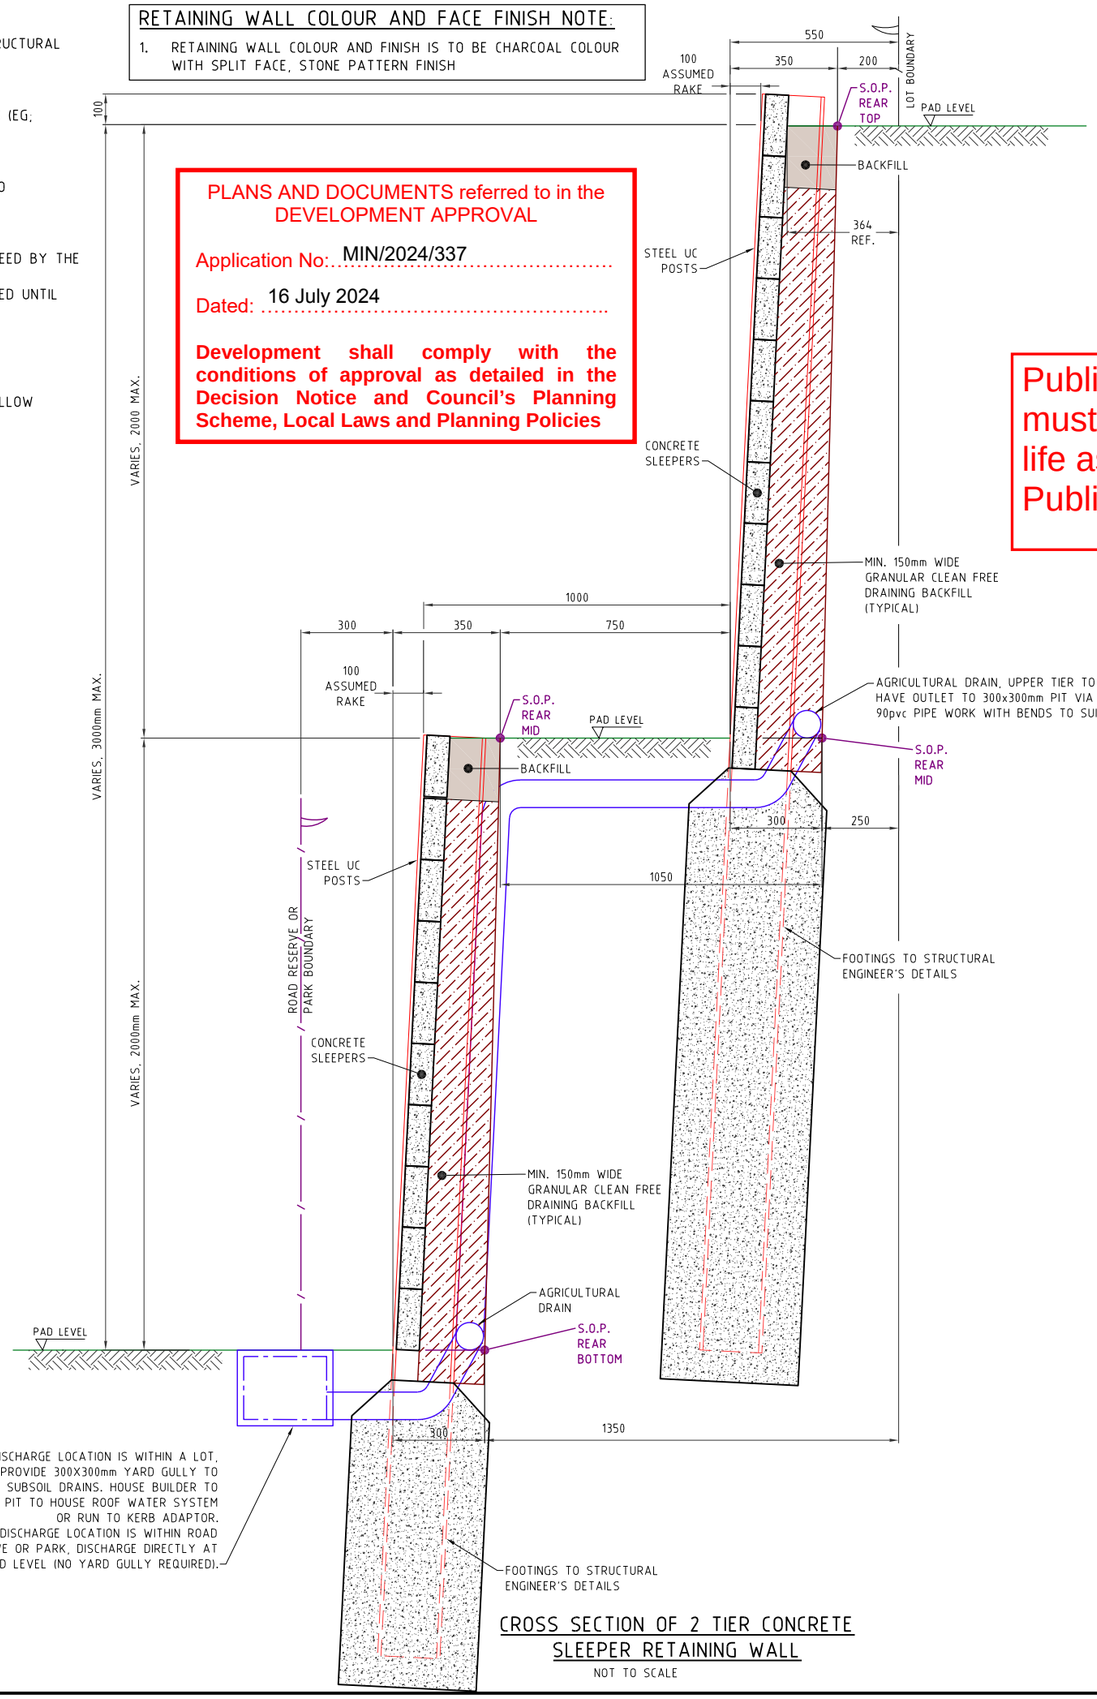

CROSS SECTION OF 2 TIER CONCRETE SLEEPER RETAINING WALL

NOT TO SCALE

Public Retaining Walls must have 120 year design life as per AS4678 3.4.2 - Public Works - Major.

PROJECT NAME

COURTNEY DR UPPER COOMERA

STAGE 02

RP DESCRIPTION

LOT 188, 189, 190, 191 & 192 ON RP173728
COURTNEY DRIVE
LOCALITY OF UPPER COOMERA
LOCAL AUTHORITY - GOLD COAST CITY COUNCIL

CLIENT

HB Land

REV	DATE	DESCRIPTION	INT
B	29-11-23	NOTES DELETED & AMENDED	BL
A	13-10-23	COUNCIL ISSUE	EP

COPYRIGHT IS VESTED IN MORTONS-URBAN SOLUTIONS AND WRITTEN CONSENT IS REQUIRED PRIOR TO REPRODUCTION.
DO NOT SCALE FROM THIS DRAWING.

ASSOCIATED CONSULTANTS

BIOME WATER AND ENVIRONMENTAL CONSULTING

Robin Russell & ASSOCIATES PTY. LTD.

BENNETT+BENNETT

DRAWING TITLE

RETAINING WALL DETAILS

MORTONS urbansolutions
Urban & Regional Planning
Civil Engineering
Project Coordination

MUS Pty Ltd T/As
Mortons-Urban Solutions
ABN 39 116 375 065
mortons@urbansolutions.net.au
www.urbansolutions.net.au
Tel 07 5571 1099

Postal Address
PO Box 2484
Southport QLD 4215

Gold Coast Office
Suite 9, 19 Short St
Southport QLD 4215

DESIGNED	RB	DRAWN	EP
APPROVED	RPEQ 4706	DATE	13-10-23

DRAWING NUMBER: 41901-02-070

REV: B


F:\Autocad Client\419 - HB Land\01 - Courtney Drive\Precinct-Stage 02\Engineering Drawings\Current\41901-02-070.dwg, DETAILS, 21/06/2024 1:20:34 PM, 1:2

PLANS AND DOCUMENTS referred to in the DEVELOPMENT APPROVAL

Application No: MIN/2024/337

Dated: 16 July 2024


Development shall comply with the conditions of approval as detailed in the Decision Notice and Council's Planning Scheme, Local Laws and Planning Policies

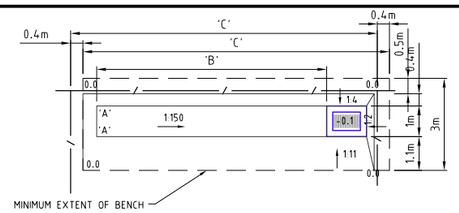

LOT WIDTH 'C'	HEIGHT 'A'	LENGTH 'B'
10	-0.050	7.500
12.5	-0.033	10.000
14	-0.023	11.500
16	-0.01	13.500
18	0.0	15.000
20	0.0	15.000


INTER-ALLOTMENT DRAINAGE SWALE

NOTE: GRADING OCCURS WITHIN MODEL, NO ADDITIONAL DEPRESSION OF PIT SURFACE LEVEL REQUIRED.

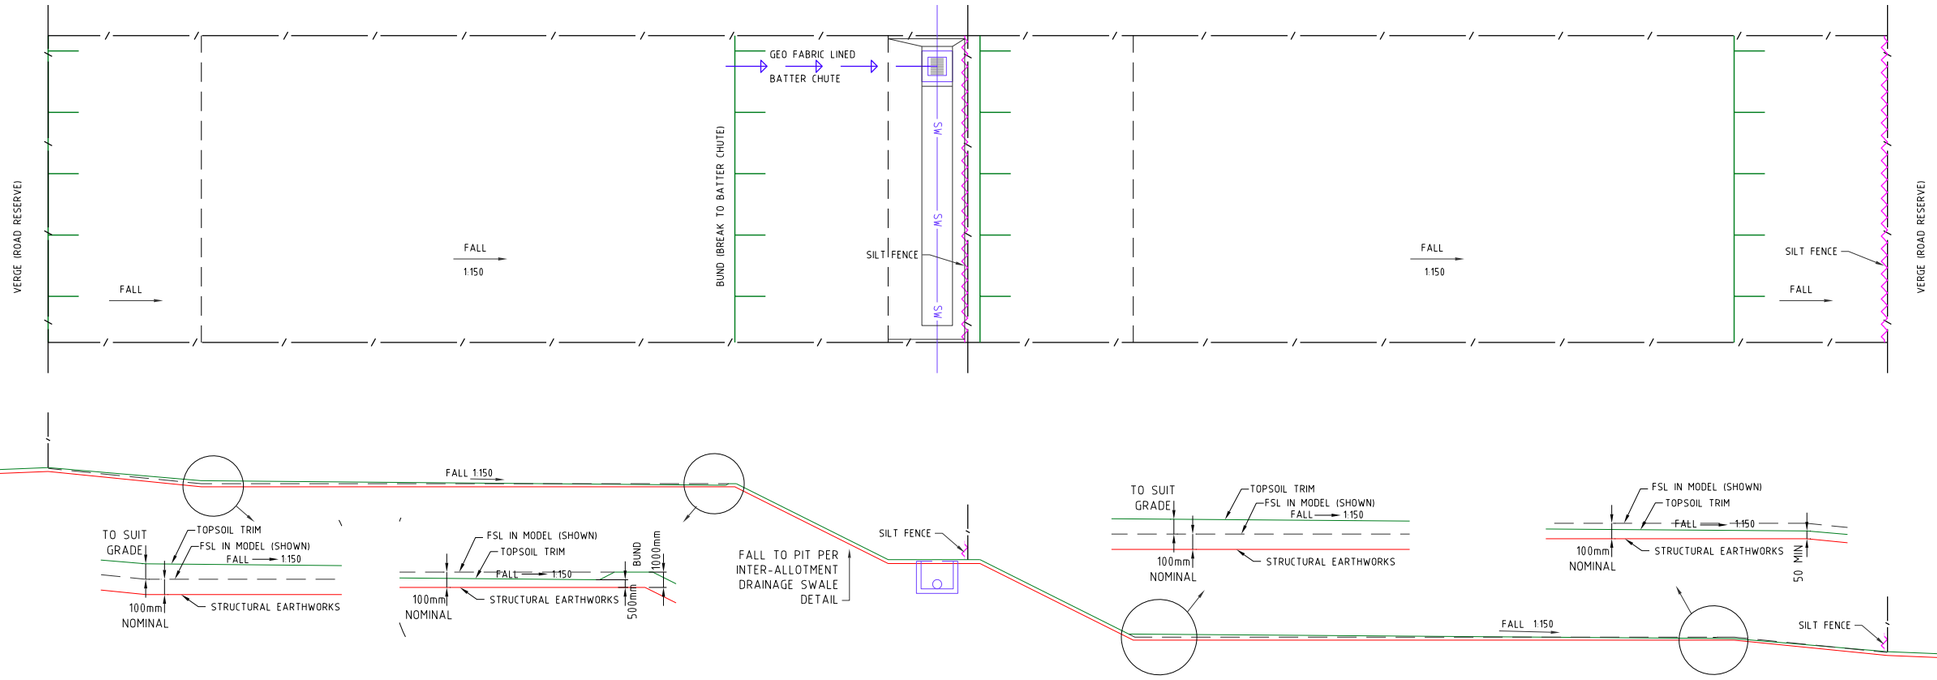

TYPICAL TOPSOIL TRIM (BENCHED LOTS)

NOT TO SCALE

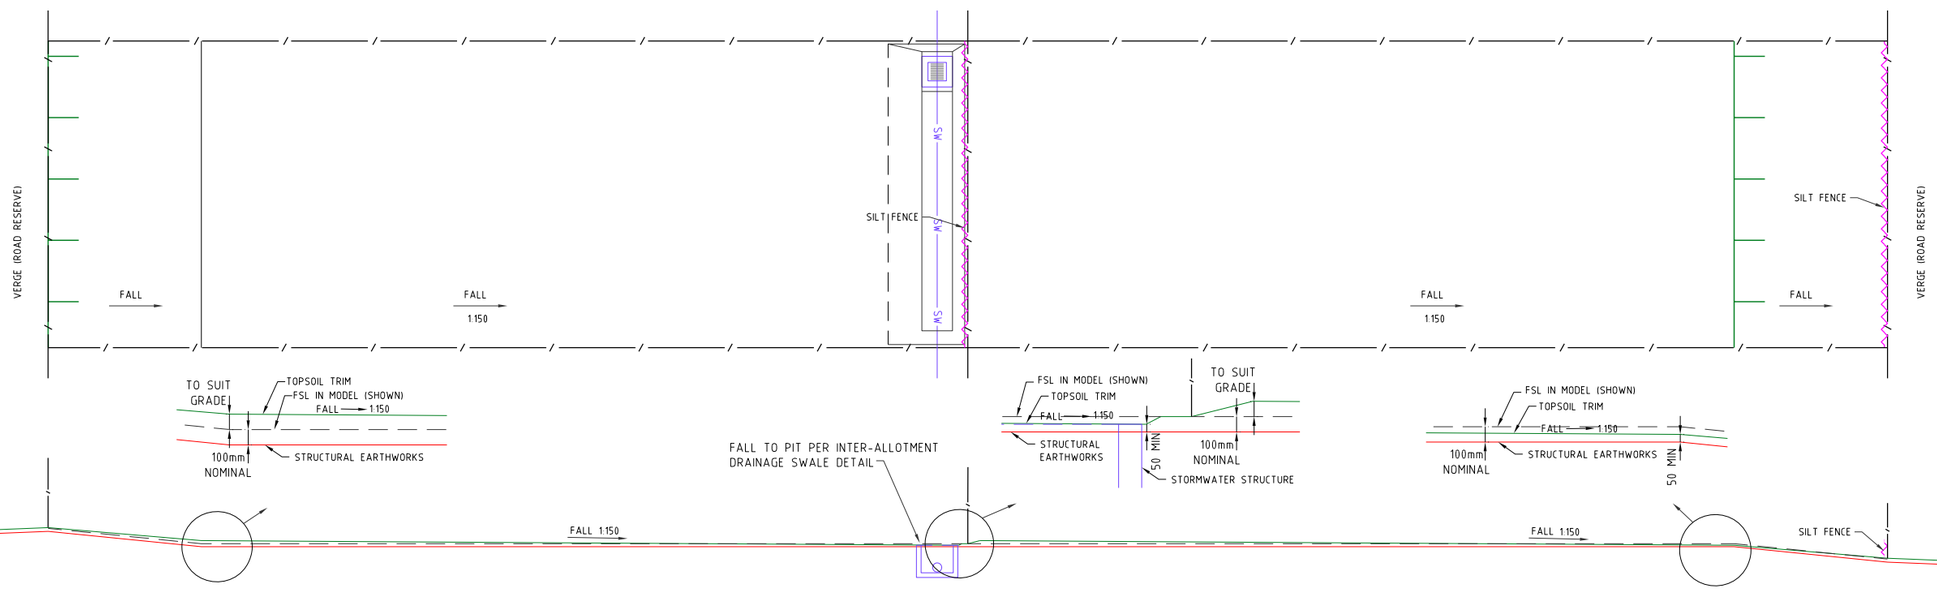

TYPICAL TOPSOIL TRIM (NON BENCHED LOTS)

NOT TO SCALE

PROJECT NAME

COURTNEY DR UPPER COOMERA

STAGE 02

RP DESCRIPTION

LOT 188, 189, 190, 191 & 192 ON RP173728
COURTNEY DRIVE
LOCALITY OF UPPER COOMERA
LOCAL AUTHORITY - GOLD COAST CITY COUNCIL

CLIENT

HB Land

REV	DATE	DESCRIPTION	INT
A	13-10-23	COUNCIL ISSUE	EP

COPYRIGHT IS VESTED IN MORTONS-URBAN SOLUTIONS AND WRITTEN CONSENT IS REQUIRED PRIOR TO REPRODUCTION. DO NOT SCALE FROM THIS DRAWING.

ASSOCIATED CONSULTANTS

BIOME WATER AND ENVIRONMENTAL CONSULTING

Robin Russell & ASSOCIATES PTY. LTD.

BENNETT + BENNETT

DRAWING TITLE

FINAL TRIM DETAILS

MORTONS urbansolutions
Urban & Regional Planning
Civil Engineering
Project Coordination

MUS Pty Ltd T/As:
Mortons-Urban Solutions
ABN: 39 116 375 065

mortons@urbansolutions.net.au
www.urbansolutions.net.au
Tel 07 5571 1099

Postal Address
PO Box 2484
Southport QLD 4215

Gold Coast Office
Suite 9, 19 Short St
Southport QLD 4215

DESIGNED	RB	DRAWN	EP
APPROVED		RPEQ 4706	DATE 13-10-23

DRAWING NUMBER	REV
41901-02-071	A


F:\Autocad Client\419 - HB Land\01 - Courtney Drive\Precinct-Stage 02\Engineering Drawings\Current\41901-02-071.dwg, FINAL TRIM DETAILS, 21/06/2024 1:20:36 PM, 1:2

PLANS AND DOCUMENTS referred to in the DEVELOPMENT APPROVAL

Application No: MIN/2024/337

Dated: 16 July 2024

Development shall comply with the conditions of approval as detailed in the Decision Notice and Council's Planning Scheme, Local Laws and Planning Policies

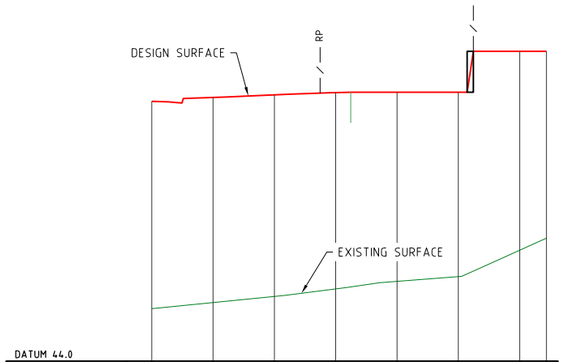


DATUM 44.0

FINISHED SURFACE	52.471		52.599	52.679	52.756	52.77	52.77		52.77	52.77 / 54.1	54.1	54.1
EXISTING SURFACE	45.712		45.911	46.11	46.354		46.602		46.757		47.616	48.009
CHAINAGE	0		2	4	6	6.49	8		10	10.29 / 10.69	12	12.873

LONGITUDINAL SECTION C

Horizontal scale 1:100
Vertical scale 1:100

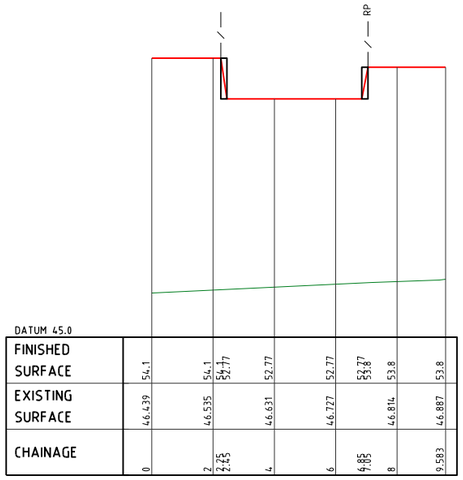


DATUM 45.0


LONGITUDINAL SECTION D

Horizontal scale 1:100
Vertical scale 1:100

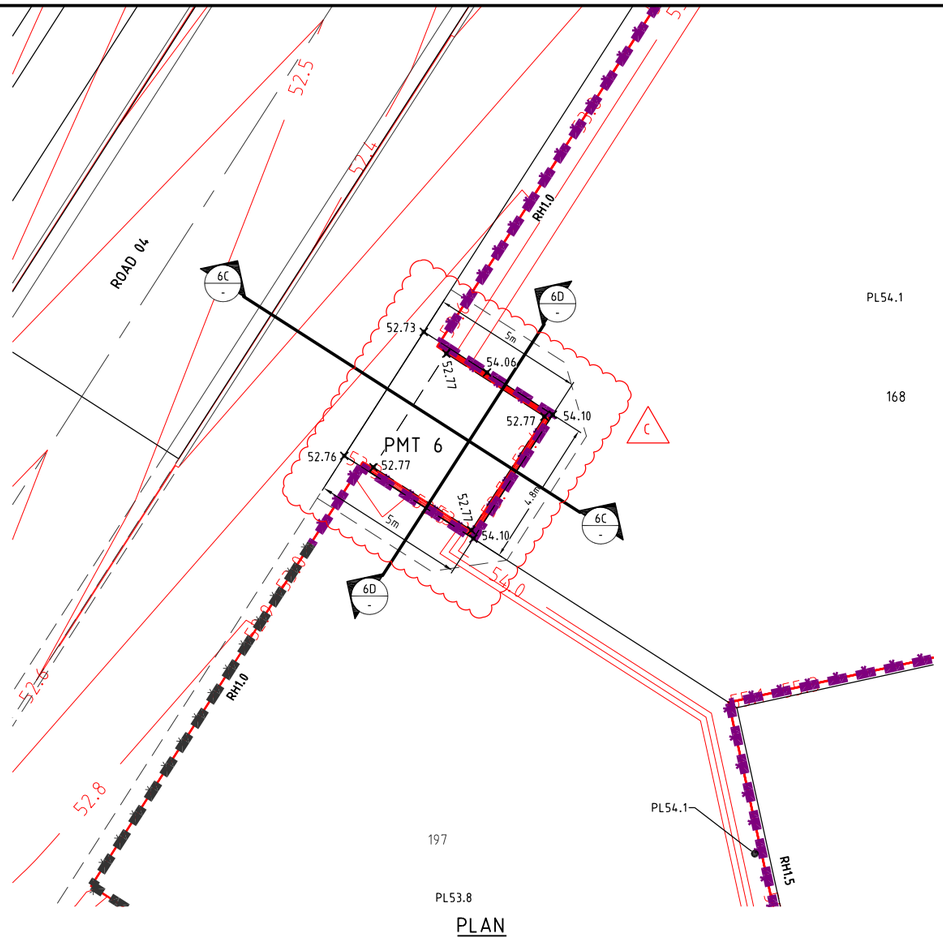

PLAN

SCALE 1:100 - A1 (1:200 - A3)

LEGEND

- CONTROL LINE / CENTER OF ROAD
- PROPOSED KERB (INVERT)
- PROPOSED KERB (LIP & BACK)
- PROPOSED FOOTPATH
- PROPOSED PROPERTY LINE
- PROPOSED RETAINING WALL
- 1.0 DESIGN CONTOURS

PROJECT NAME

COURTNEY DR
UPPER COOMERA

STAGE 02

RP DESCRIPTION

LOT 188, 189, 190, 191 & 192 ON RP173728
COURTNEY DRIVE
LOCALITY OF UPPER COOMERA
LOCAL AUTHORITY - GOLD COAST CITY COUNCIL

CLIENT

HB Land

NORTH

0 1 2 3 4 5m
Scale 1:100 - A1 (1:200 - A3)

REV	DATE	DESCRIPTION	INT
C	19-06-24	ENERGEX EASEMENT	RK
B	29-11-23	SPOT LEVELS ADDED	BL
A	13-10-23	COUNCIL ISSUE	EP

COPYRIGHT IS VESTED IN MORTONS-URBAN SOLUTIONS AND WRITTEN CONSENT IS REQUIRED PRIOR TO REPRODUCTION. DO NOT SCALE FROM THIS DRAWING.

ASSOCIATED CONSULTANTS

BIOME WATER AND ENVIRONMENTAL CONSULTING
Robin Russell & ASSOCIATES PTY. LTD.
BENNETT+BENNETT

DRAWING TITLE

PADMOUNT SECTIONS
PADMOUNT 6
SHEET 01

MORTONS urbansolutions
Urban & Regional Planning
Civil Engineering
Project Coordination
MUS Pty Ltd T/As:
Mortons-Urban Solutions
ABN: 39 116 375 065
mortons@urbansolutions.net.au
www.urbansolutions.net.au
Tel 07 5571 1099
Postal Address
PO Box 2484
Southport QLD 4215
Gold Coast Office
Suite 9, 19 Short St
Southport QLD 4215

DESIGNED	RB	DRAWN	EP
APPROVED	RPEQ 4706	DATE	13-10-23

DRAWING NUMBER 41901-02-076

REV C

F:\Autocad Client\419 - HB Land\01 - Courtney Drive\Precinct-Stage 02\Engineering Drawings\Current\41901-02-076.dwg, PADMOUNT 6 SHEET 01, 21/06/2024 12:20:41 PM, 1:2

PLANS AND DOCUMENTS referred to in the DEVELOPMENT APPROVAL

Application No: MIN/2024/337

Dated: 16 July 2024

Development shall comply with the conditions of approval as detailed in the Decision Notice and Council's Planning Scheme, Local Laws and Planning Policies


SEDIMENT AND EROSION

1. THE EROSION & SEDIMENT CONTROL DEVICES SHOWN ON THESE DRAWINGS ARE INDICATIVE & PROVIDED FOR SUBMISSION TO LOCAL AUTHORITY ONLY. NOTWITHSTANDING THE EROSION & CONTROL DEVICES SHOW ON THESE DRAWINGS, THE CONTRACTOR MUST PREPARE & FOLLOW A SITE SPECIFIC EROSION & SEDIMENT CONTROL PLAN TO MEET ALL LOCAL & STATE GOVERNMENT LEGISLATION INCLUDING BUT NOT LIMITED TO:
   a. ENVIRONMENTAL PROTECTION ACT WITH SPECIFIC REFERENCE TO PARTS S440G & S319
   b. STATE PLANNING POLICY

   PRESCRIBED WATER CONTAMINANTS (AS DEFINED IN THE ENVIRONMENTAL PROTECTION ACT 1994) MUST NOT BE RELEASED FROM THE SITE OR TO WATERS WITHIN THE SITE, OR BE LIKELY TO BE RELEASED SHOULD RAINFALL OCCUR, UNLESS ALL REASONABLE & PRACTICABLE MEASURES ARE TAKEN TO PREVENT OR MINIMISE THE RELEASE & CONCENTRATION OF CONTAMINATION. THE ESC PLAN MUST BE DESIGNED, IMPLEMENTED & MAINTAINED IN ACCORDANCE WITH "BEST PRACTICE EROSION & SEDIMENT CONTROL" PUBLISHED BY THE INTERNATIONAL EROSION CONTROL ASSOCIATION (AUSTRALASIAN CHAPTER) (IECA, 2008).
2. TO COMPLY WITH THE REQUIREMENTS OF THE EP ACT & BEST PRACTICE DESIGN, THE SEDIMENT BASINS ON THE SITE MUST BE DESIGNED & IMPLEMENTED TO ACHIEVE THE FOLLOWING:
   SEDIMENT BASINS ARE TO BE DESIGNED, IMPLEMENTED & MAINTAINED TO A STANDARD WHICH WOULD ACHIEVE AT LEAST 80% OF THE AVERAGE ANNUAL RUNOFF VOLUME OF THE CONTRIBUTING CATCHMENT TREATED (I.E. 80% HYDROLOGIC EFFECTIVENESS) TO 50MG/L TSS OR LESS & PH IN THE RANGE 6.5-8.5

   THIS WILL REQUIRE THE INSTALLATION & OPERATION OF A HIGH-EFFICIENCY SEDIMENT BASIN(S) DESIGNED IN ACCORDANCE WITH THE SPECIFICATIONS CONTAINED IN THE "BEST PRACTICE EROSION & SEDIMENT CONTROL - APPENDIX B SEDIMENT BASIN DESIGN & OPERATION" PUBLISHED BY THE INTERNATIONAL EROSION CONTROL ASSOCIATION (AUSTRALASIAN CHAPTER) (IECA, 2016, DRAFT)
3. THE EROSION & SEDIMENT CONTROL PLAN MUST BE PREPARED & CERTIFIED BY A CERTIFIED PROFESSIONAL IN EROSION & SEDIMENT CONTROL & FOLLOW THE REQUIREMENTS OUTLINED IN IECA'S BEST PRACTICE EROSION & SEDIMENT CONTROL DOCUMENT & THE QUEENSLAND URBAN DRAINAGE MANUAL.
4. PRIOR TO THE COMMENCEMENT OF WORKS ONSITE THE CONTRACTOR MUST MAKE THEMSELVES AWARE OF ALL PREVIOUS GEOTECHNICAL REPORTS & DETERMINE THE DISPERSIVE CHARACTERISTICS OF THE SOIL (INCLUDING PERFORMING ANY SOIL TESTS IF REQUIRED). THE RESULTS OF THIS REVIEW & ANY TESTS MUST BE INCLUDED IN THE CONTRACTOR'S EROSION & SEDIMENT CONTROL PLAN. A COPY OF ALL TEST RESULTS MUST BE PROVIDED TO THE SUPERINTENDENT.
5. THE CONTRACTOR SHALL TAKE ALL NECESSARY PRECAUTIONS TO CONTROL EROSION & DOWNSTREAM SEDIMENTATION DURING ALL STAGES OF CONSTRUCTION (INCLUDING THE MAINTENANCE PERIOD). NOTWITHSTANDING THE CONTROL MEASURES OR FINISHED EARTHWORKS DESIGN SHOWN ON THESE DRAWINGS, THE CONTRACTOR IS RESPONSIBLE FOR IMPLEMENTING ADDITIONAL OR ALTERNATIVE EROSION & SEDIMENT CONTROL MEASURES TO MINIMISE SEDIMENT ACROSS OR LEAVING THE SITE.
6. AT ALL TIMES THE CONTRACTOR SHALL MONITOR THE PREVAILING WEATHER CONDITIONS (INCLUDING WEEKENDS & PUBLIC HOLIDAYS) & AT ALL TIMES REMAINS RESPONSIBLE TO:
   a) CLEAN & REPAIR CONTROL DEVICES WHENEVER THE ACCUMULATED SEDIMENT REDUCES THEIR CAPACITY BY 50%.
   b) MAINTAIN POSITIVE GRADES OF ALL PERIMETER BANKS & SWALES TO AN OUTLET.
   c) PROTECT ANY DOWNSTREAM CONSTRUCTION.
   d) CONTROLLING DUST.
   e) MEASURES HAVE BEEN INSTALLED IN ACCORDANCE WITH DETAILS OUTLINED IN THEIR EROSION & SEDIMENT CONTROL PLAN & AS DIRECTED BY THE SUPERINTENDENT.
7. THE CONTRACTOR'S PLAN SHALL ALLOW FOR SUITABLE ACCESS TO ALLOW MAINTENANCE OF ALL SEDIMENT CONTROL DEVICES. NO ADDITIONAL VEGETATION CLEARING IS PERMITTED FOR GAINING ACCESS UNLESS APPROVED BY THE SUPERINTENDENT.
8. THE CONTRACTOR MAY REQUEST APPROVAL FROM THE SUPERINTENDENT TO REUSE THE STOCKPILED MULCH FOR STABILISING BATTERS ONLY IN LOCATIONS WHERE THE APPROVED LANDSCAPE OPW DESIGN REQUIRES MULCH ULTIMATELY.
9. CONSTRUCTION STOCKPILING
   a) TOPSOIL SHALL BE STRIPPED & STOCKPILED IN LOCATIONS NOMINATED ON THE CONSTRUCTION DRAWINGS OR IN LOCATIONS AGREED WITH THE SUPERINTENDENT.
   b) ADDITIONAL VEGETATION CLEARING IS NOT PERMITTED TO FACILITATE THE STOCKPILING OF MATERIALS UNLESS SHOWN ON THE APPROVED VEGETATION MANAGEMENT PLAN.
   c) ANY STOCKPILE SITE MUST BE CLEAR OF ADJACENT PROPERTY BOUNDARIES SO AS NOT TO CAUSE A NUISANCE TO ADJOINING PROPERTIES.
   d) NO STOCKPILES ARE TO BE LOCATED WITHIN THE TREE PROTECTION ZONE OF VEGETATION.
   e) A TEMPORARY SILT FENCE IS TO BE ERECTED APPROXIMATELY 5m FROM TOE OF BATTER ON LOW SIDE OF STOCKPILING.
10. NOTWITHSTANDING THE DETAILS SHOWN IN THE CONTRACTOR'S EROSION & SEDIMENT CONTROL PLAN, DURING CONSTRUCTION THE CONTRACTOR MUST:
   a) SIZE ALL TEMPORARY SEDIMENT BASINS APPROPRIATELY TO TREAT THE UPSTREAM CATCHMENT. NOTE THAT THE PERMANENT BIO BASINS SHOWN ON THESE DRAWINGS ARE SIZED FOR THE ULTIMATE CATCHMENT NOT FOR THE CONSTRUCTION PHASE.
   b) PLACE A ROCK BUND AROUND ALL HEADWALLS DURING CONSTRUCTION.
   c) PROVIDE KERB INLET PROTECTION TO ALL GULLIES.
   c) PLACE A MINIMUM 1.0m WIDE TURF STRIP BEHIND ALL KERBS & IN A HERRINGBONE LAYOUT WITHIN THE ROAD VERGE.
   d) MAINTENANCE (INCLUDING FLOCCULATION IF REQUIRED & PUMP OUT) OF ALL CONSTRUCTION SEDIMENT BASINS (WHETHER EXISTING OR NEW).
   e) CLEAN OUT OF ALL GROSS POLLUTANT TRAPS, SEDIMENT FOREBAYS & ALL OTHER PERMANENT SEDIMENT CONTROL DEVICES AT BOTH ON & OFF MAINTENANCE.
11. CONTRACTOR TO CONFIRM THE EXTENTS OF REQUIRED GRASSING TREATMENTS WITH THE SUPERINTENDENT AT LEAST 7 DAYS PRIOR TO FINAL TRIMMING.
12. THE CONTRACTOR IS RESPONSIBLE FOR ENSURING THAT GRASSING STRIKE RATES ARE ACHIEVED AT THE ON & OFF MAINTENANCE INSPECTIONS IN ACCORDANCE WITH COUNCIL REQUIREMENTS. THIS INCLUDES THE SUPPLY & INSTALLATION OF ANY REQUIRED CHEMICAL/FERTILISER AMELIORATION TO ACHIEVE THE SPECIFIED GRASS STRIKE RATES.
13. GEOFABRIC LINING OF CHANNELS & CHECK DAMS MAY BE REQUIRED SUBJECT TO THE SITE CONDITIONS.
14. BATTERS WITHIN PUBLIC OPEN SPACE TO BE VEGETATED IN ACCORDANCE WITH APPROVED OPEN SPACE MANAGEMENT PLAN & LANDSCAPING OPW. CONTRACT DOCUMENTATION WILL SPECIFY WHETHER THIS IS THE CIVIL CONTRACTOR OR THE LANDSCAPE CONTRACTOR'S RESPONSIBILITY TO SUPPLY & INSTALL. THE CIVIL CONTRACTOR IS RESPONSIBLE FOR PROVIDING SUITABLE ACCESS FOR THE LANDSCAPE CONTRACTOR TO PERFORM THEIR WORKS.
15. MAINTENANCE PERIOD (PRE TO POST CONSTRUCTION)
   a) ALL PROTECTION MEASURES ARE TO BE INSPECTED & MAINTAINED REGULARLY
   b) REPAIRS ARE TO BE EFFECTED IMMEDIATELY.
   c) SILT AFTER RAIN IS TO BE CLEANED FROM STREETS & ALLOTMENTS IMMEDIATELY & CORRECTIVE ACTION TAKEN TO AVOID A RE-OCCURRENCE.
   d) AT OFF-MAINTENANCE & ONLY WHEN DIRECTED BY COUNCIL, REMOVE & DISPOSE OFFSITE ALL TEMPORARY EROSION & SEDIMENT CONTROL DEVICES.

NOTE:
SEDIMENT AND EROSION CONTROL MEASURES SHOWN RELATE TO THE FINISHED SURFACE ONLY AND ARE CONCEPTUAL ONLY. THE CONTRACTOR IS TO PREPARE A SITE SPECIFIC CONSTRUCTION AND MAINTENANCE PHASE SEDIMENT AND EROSION CONTROL PLAN.

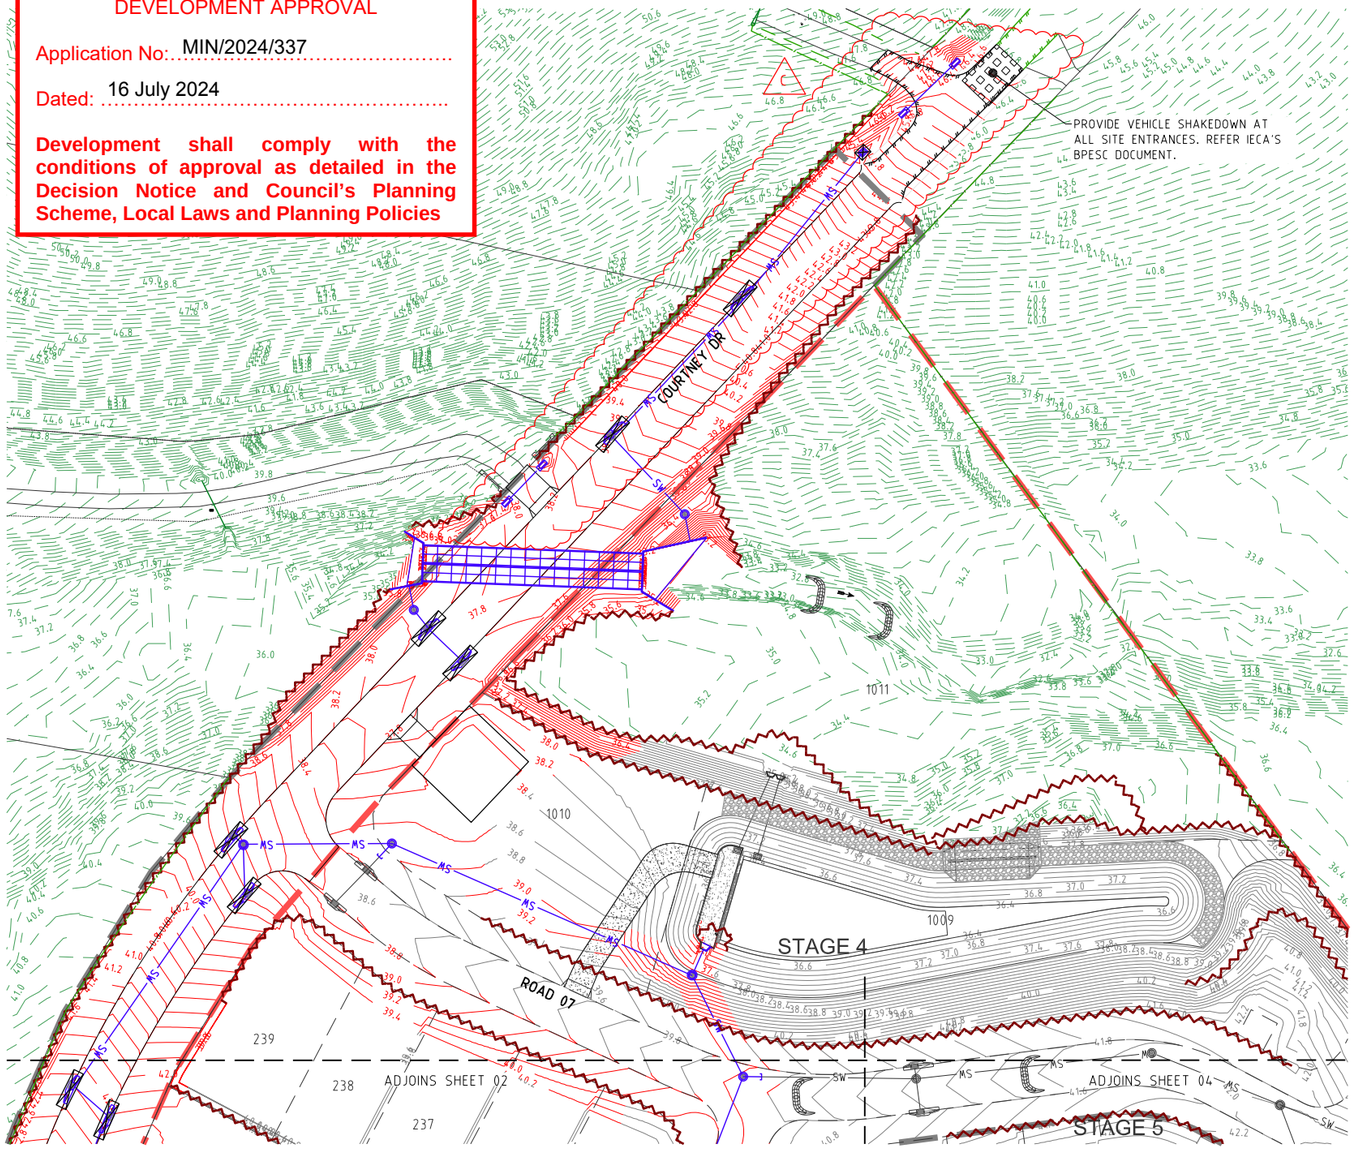


LEGEND

- EXISTING PROPERTY LINE
- EXISTING KERB (INVERT)
- EXISTING STORMWATER
- EXISTING CONTOURS
- FUTURE PROPERTY LINE
- FUTURE KERB (INVERT)
- FUTURE STORMWATER
- FUTURE CONTOURS
- SITE BOUNDARY
- STAGE BOUNDARY
- PROPOSED PROPERTY LINE
- PROPOSED KERB (INVERT)
- PROPOSED STORMWATER
- DESIGN CONTOURS
- MANHOLE
- KERB INLET (ON GRADE) PIT
- KERB INLET (SAG) PIT
- HEADWALL
- TREES
- SEDIMENT FENCE
- SCOUR PROTECTION
- TEMPORARY SEDIMENT BASIN
- STORMWATER INLET FILTER
- ROCK CHECK DAM
- VEHICLE SHAKEDOWN (AT ALL SITE ENTRANCES MIN.)

PROVIDE SEDIMENT AND EROSION CONTROL MEASURES IN ACCORDANCE WITH THE INTERNATIONAL EROSION CONTROL ASSOCIATION BPESC DOCUMENT.

SHEET LAYOUT

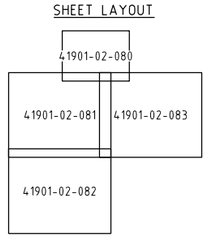

DIAL BEFORE YOU DIG www.1100.com.au

PROJECT NAME

COURTNEY DR UPPER COOMERA

STAGE 02

RP DESCRIPTION

LOT 188, 189, 190, 191 & 192 ON RP173728
COURTNEY DRIVE
LOCALITY OF UPPER COOMERA
LOCAL AUTHORITY - GOLD COAST CITY COUNCIL

CLIENT

HB Land

NORTH

0 5 10 15 20 25m

Scale 1:500 - A1 (1:1000 - A3)

REV	DATE	DESCRIPTION	INT
C	13-06-24	CONTOURS & STORMWATER AMENDED	RK
B	15-01-24	CONTOURS & SEDIMENT AND EROSION AMENDED	BL
A	13-10-23	COUNCIL ISSUE	EP

COPYRIGHT IS VESTED IN MORTONS-URBAN SOLUTIONS AND WRITTEN CONSENT IS REQUIRED PRIOR TO REPRODUCTION. DO NOT SCALE FROM THIS DRAWING.

ASSOCIATED CONSULTANTS

BIOME WATER AND ENVIRONMENTAL CONSULTING
Robin Russell & ASSOCIATES PTY. LTD.
BENNETT + BENNETT

DRAWING TITLE

FINAL SURFACE AND SEDIMENT AND EROSION PLAN
SHEET 01

MORTONS urbansolutions
Urban & Regional Planning
Civil Engineering
Project Coordination
MUS Pty Ltd T/As:
Mortons-Urban Solutions
ABN: 39 116 375 065
mortons@urbansolutions.net.au
www.urbansolutions.net.au
Tel 07 5571 1099
Postal Address
PO Box 2484
Southport QLD 4215
Gold Coast Office
Suite 9, 19 Short St
Southport QLD 4215

DESIGNED	RB	DRAWN	EP
APPROVED		RPEQ 4706	DATE 13-10-23

DRAWING NUMBER	REV
41901-02-080	C


F:\Autocad Client\419 - HB Land\01 - Courtney Drive\Precinct-Stage 02\Engineering Drawings\Current\41901-02-080.dwg, PLAN SHEET 01, 21/06/2024 1:20:58 PM, 1:2

PLANS AND DOCUMENTS referred to in the DEVELOPMENT APPROVAL

Application No: MIN/2024/337

Dated: 16 July 2024

Development shall comply with the conditions of approval as detailed in the Decision Notice and Council's Planning Scheme, Local Laws and Planning Policies

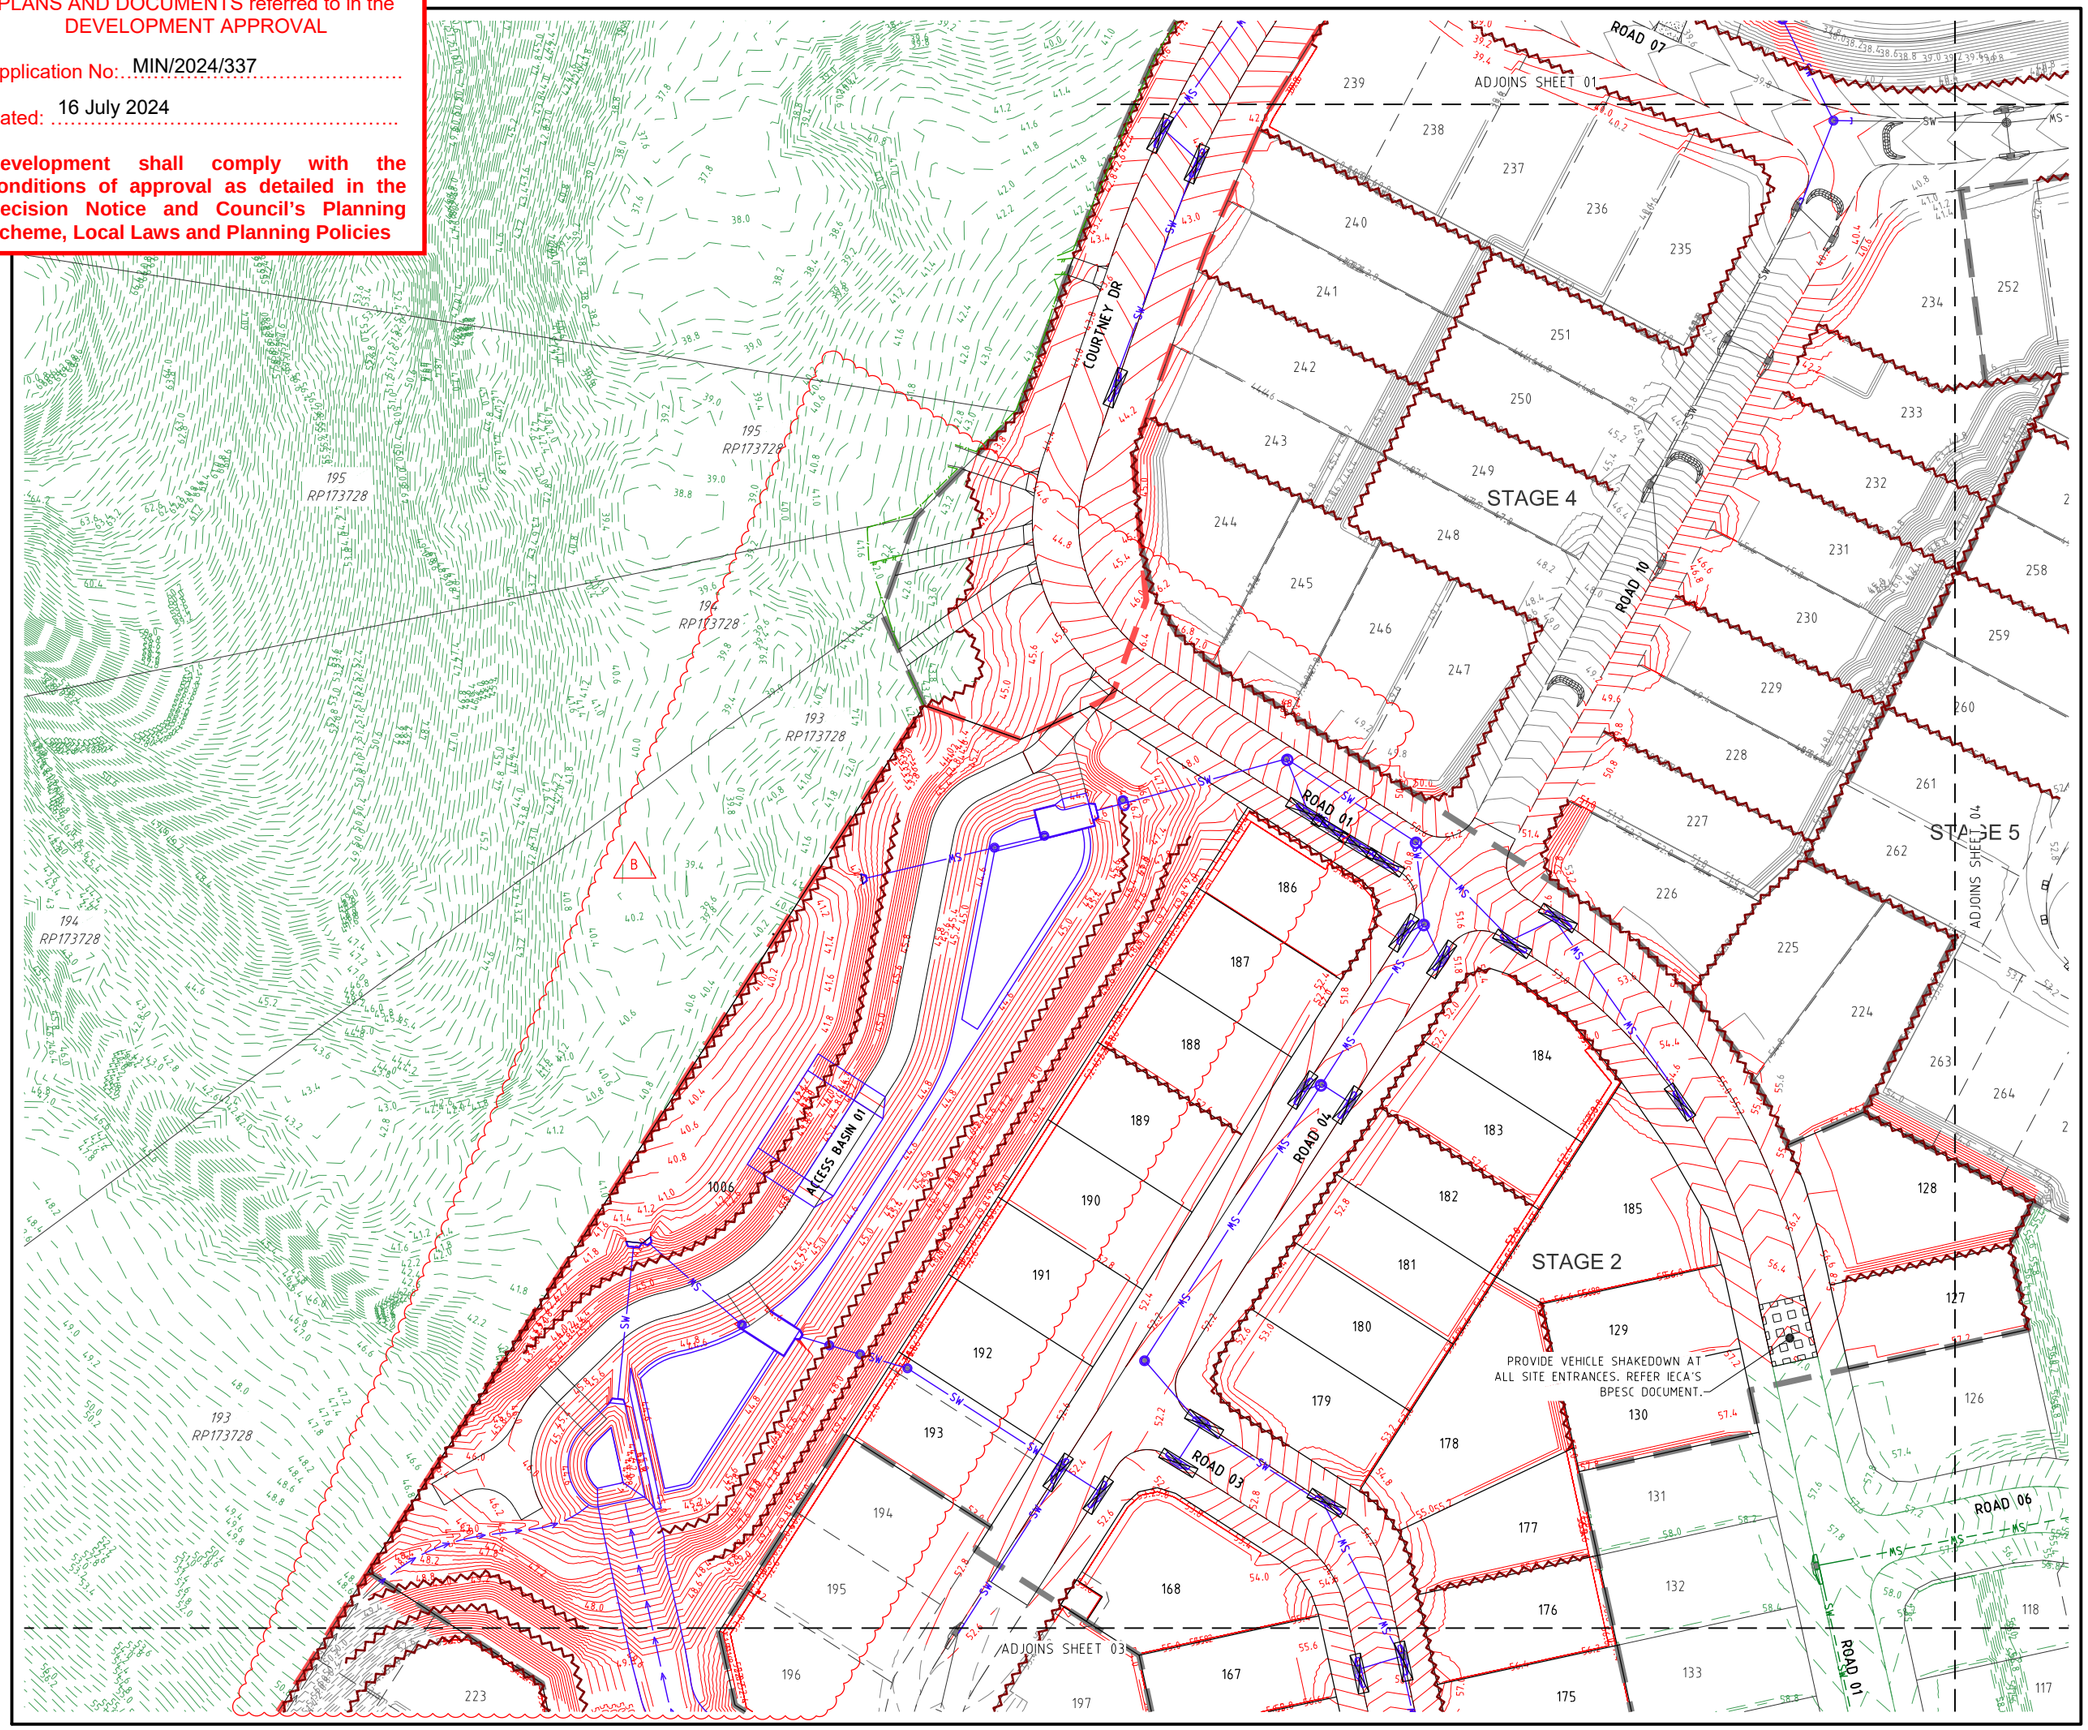

PROJECT NAME

COURTNEY DR UPPER COOMERA

STAGE 02

RP DESCRIPTION

LOT 188, 189, 190, 191 & 192 ON RP173728
COURTNEY DRIVE
LOCALITY OF UPPER COOMERA
LOCAL AUTHORITY - GOLD COAST CITY COUNCIL

CLIENT

HB Land

NORTH

0 5 10 15 20 25m
Scale 1:500 - A1 (1:1000 - A3)

REV	DATE	DESCRIPTION	INT
B	29-11-23	BASIN STORMWATER AMENDED	BL
A	13-10-23	COUNCIL ISSUE	EP

COPYRIGHT IS VESTED IN MORTONS-URBAN SOLUTIONS AND WRITTEN CONSENT IS REQUIRED PRIOR TO REPRODUCTION. DO NOT SCALE FROM THIS DRAWING.

ASSOCIATED CONSULTANTS

BIOME WATER AND ENVIRONMENTAL CONSULTING
Robin Russell & ASSOCIATES PTY. LTD.
BENNETT + BENNETT

DRAWING TITLE

FINAL SURFACE AND SEDIMENT AND EROSION PLAN SHEET 02

MORTONS urbansolutions
Urban & Regional Planning
Civil Engineering
Project Coordination

MUS Pty Ltd T/As
Mortons-Urban Solutions
ABN: 39 116 375 065
mortons@urbansolutions.net.au
www.urbansolutions.net.au
Tel 07 5571 1099

Postal Address
PO Box 2484
Southport QLD 4215

Gold Coast Office
Suite 9, 19 Short St
Southport QLD 4215

DESIGNED	RB	DRAWN	EP
APPROVED		RPEQ 4706	DATE 13-10-23

DRAWING NUMBER 41901-02-081 REV B

F:\Autocad Client\419 - HB Land\01 - Courtney Drive\Precinct-Stage 02\Engineering Drawings\Current\41901-02-080.dwg, PLAN SHEET 02, 21/06/2024 12:21:14 PM, 1:2

ADJOINS SHEET 02

STAGE 3

STAGE 2

STAGE 1

ROAD 01

ROAD 02

ROAD 03

ROAD 04

LOCALISED EARTHWORKS IN THIS AREA TO MAINTAIN CHANNEL PROFILE THROUGH ROAD 02. STORMWATER CULVERT TO BE INSTALLED AS PART OF STAGE 3 WORKS.

14 PROVIDE VEHICLE SHAKEDOWN AT ALL SITE ENTRANCES. REFER IECA'S BPESC DOCUMENT.

B

PLANS AND DOCUMENTS referred to in the DEVELOPMENT APPROVAL

Application No: MIN/2024/337

Dated: 16 July 2024

Development shall comply with the conditions of approval as detailed in the Decision Notice and Council's Planning Scheme, Local Laws and Planning Policies

F:\Engineering Drawings\Current\41901-02-080.dwg, PLAN SHEET 03, 21/06/2024 12:37 PM, 1:2

PROJECT NAME

COURTNEY DR UPPER COOMERA

STAGE 02

RP DESCRIPTION

LOT 188, 189, 190, 191 & 192 ON RP173728
COURTNEY DRIVE
LOCALITY OF UPPER COOMERA
LOCAL AUTHORITY - GOLD COAST CITY COUNCIL

CLIENT

HB Land

NORTH

0 5 10 15 20 25m

Scale 1:500 - A1 (1:1000 - A3)

REV	DATE	DESCRIPTION	INT
B	29-11-23	CHECK DAMS ADDED	BL
A	13-10-23	COUNCIL ISSUE	EP

COPYRIGHT IS VESTED IN MORTONS-URBAN SOLUTIONS AND WRITTEN CONSENT IS REQUIRED PRIOR TO REPRODUCTION. DO NOT SCALE FROM THIS DRAWING.

ASSOCIATED CONSULTANTS

BIOME WATER AND ENVIRONMENTAL CONSULTING

Robin Russell & ASSOCIATES PTY. LTD.

BENNETT+BENNETT

DRAWING TITLE

FINAL SURFACE AND SEDIMENT AND EROSION PLAN
SHEET 03

MORTONS urbansolutions
Urban & Regional Planning
Civil Engineering
Project Coordination

MUS Pty Ltd T/As:
Mortons-Urban Solutions
ABN: 39 116 375 065
mortons@urbansolutions.net.au
www.urbansolutions.net.au
Tel 07 5571 1099

Postal Address
PO Box 2484
Southport QLD 4215

Gold Coast Office
Suite 9, 19 Short St
Southport QLD 4215

DESIGNED	RB	DRAWN	EP
APPROVED		RPEQ	4706
		DATE	13-10-23

DRAWING NUMBER	REV
41901-02-082	B

PLANS AND DOCUMENTS referred to in the DEVELOPMENT APPROVAL

Application No: MIN/2024/337

Dated: 16 July 2024

Development shall comply with the conditions of approval as detailed in the Decision Notice and Council's Planning Scheme, Local Laws and Planning Policies

ADJOINS SHEET 01

ADJOINS SHEET 02

STAGE 5

STAGE 5

ROAD 11

ROAD 08

ROAD 11

ROAD 09

ROAD 06

ROAD 01

GORDON DR

RICHARDSON

PROJECT NAME

COURTNEY DR UPPER COOMERA

STAGE 02

RP DESCRIPTION

LOT 188, 189, 190, 191 & 192 ON RP173728
COURTNEY DRIVE
LOCALITY OF UPPER COOMERA
LOCAL AUTHORITY - GOLD COAST CITY COUNCIL

CLIENT

HB Land

NORTH

0 5 10 15 20 25m

Scale 1:500 - A1 (1:1000 - A3)

REV	DATE	DESCRIPTION	INT
A	13-10-23	COUNCIL ISSUE	EP

COPYRIGHT IS VESTED IN MORTONS-URBAN SOLUTIONS AND WRITTEN CONSENT IS REQUIRED PRIOR TO REPRODUCTION. DO NOT SCALE FROM THIS DRAWING.

ASSOCIATED CONSULTANTS

BIOME WATER AND ENVIRONMENTAL CONSULTING

Robin Russell & ASSOCIATES PTY. LTD.

BENNETT + BENNETT

DRAWING TITLE

FINAL SURFACE AND SEDIMENT AND EROSION PLAN
SHEET 04

MORTONS urbansolutions
Urban & Regional Planning
Civil Engineering
Project Coordination

MUS Pty Ltd T/As:
Mortons-Urban Solutions
ABN: 39 116 375 065

mortons@urbansolutions.net.au
www.urbansolutions.net.au
Tel 07 5571 1099

Postal Address
PO Box 2484
Southport QLD 4215

Gold Coast Office
Suite 9, 19 Short St
Southport QLD 4215

DESIGNED	RB	DRAWN	EP
APPROVED		RPEQ 4706	DATE 13-10-23

DRAWING NUMBER 41901-02-083

REV A

F:\Autocad Client\419 - HB Land\01 - Courtney Drive\Precinct-Stage 02\Engineering Drawings\Current\41901-02-080.dwg, PLAN SHEET 04, 21/06/2024 12:59 PM, 1:2

PLANS AND DOCUMENTS referred to in the DEVELOPMENT APPROVAL

Application No: MIN/2024/337

Dated: 16 July 2024


Development shall comply with the conditions of approval as detailed in the Decision Notice and Council's Planning Scheme, Local Laws and Planning Policies

CONSTRUCTION SERVICES


1. CONSTRUCTION OF SEWER/ROOFWATER/STORMWATER/SERVICES
   EXCAVATED MATERIAL TO BE PLACED ON HIGH SIDE OF TRENCH & TO PROTECT PIPE WORK & DIRECT SURFACE MATERIAL AWAY FROM EXCAVATIONS. TOPSOIL & GRASS SEED AREAS IN ALLOTMENTS IMMEDIATELY AFTER COMPLETING THE SEWER & ROOFWATER DRAINAGE CONSTRUCTION. DEPRESS GROUND AROUND TEMPORARY FIELD INLETS TO CREATE SILT POND.
2. TRIP HAZARD
   MANHOLES OR STRUCTURES INSTALLED IN THE ROAD, FOOTPATH OR VERGE MUST MATCH NEATLY WITH NO TRIP HAZARD.
3. EXISTING SERVICES - EXTERNAL WORKS
   THE LOCATIONS OF ALL EXISTING SERVICES WITHIN THE WORK AREA SHALL BE CONFIRMED BY THE CONTRACTOR PRIOR TO CONSTRUCTION COMMENCING. IT IS THE CONTRACTOR'S RESPONSIBILITY TO CONTACT THE RELEVANT AUTHORITIES & TO ENSURE THAT THE EXISTING SERVICES ARE NOT DAMAGED OR DISTURBED IN ANY WAY BY THE CONTRACT WORKS.

LEGEND

- EXISTING PROPERTY LINE
- EXISTING KERB (INVERT)
- EXISTING FOOTPATH
- EXISTING RISING MAIN
- EXISTING SEWER
- EXISTING STORMWATER
- EXISTING ROOFWATER
- EXISTING SUBSOIL
- EXISTING WATER
- EXISTING WATER
- EXISTING WATER
- EXISTING WATER
- EXISTING WATER
- EXISTING WATER
- EXISTING WATER CONDUIT
- PROPOSED PROPERTY LINE
- PROPOSED KERB (INVERT)
- PROPOSED FOOTPATH
- PROPOSED RISING MAIN
- PROPOSED SEWER
- PROPOSED STORMWATER
- PROPOSED ROOFWATER
- PROPOSED SUBSOIL
- PROPOSED WATER
- PROPOSED WATER
- PROPOSED WATER
- PROPOSED WATER
- PROPOSED WATER
- PROPOSED WATER
- PROPOSED WATER CONDUIT
- FUTURE PROPERTY LINE
- FUTURE KERB (INVERT)
- FUTURE FOOTPATH
- FUTURE RISING MAIN
- FUTURE SEWER
- FUTURE STORMWATER
- FUTURE ROOFWATER
- FUTURE SUBSOIL
- FUTURE WATER
- FUTURE WATER
- FUTURE WATER
- FUTURE WATER
- FUTURE WATER
- FUTURE WATER
- FUTURE WATER CONDUIT
- SITE BOUNDARY
- STAGE BOUNDARY

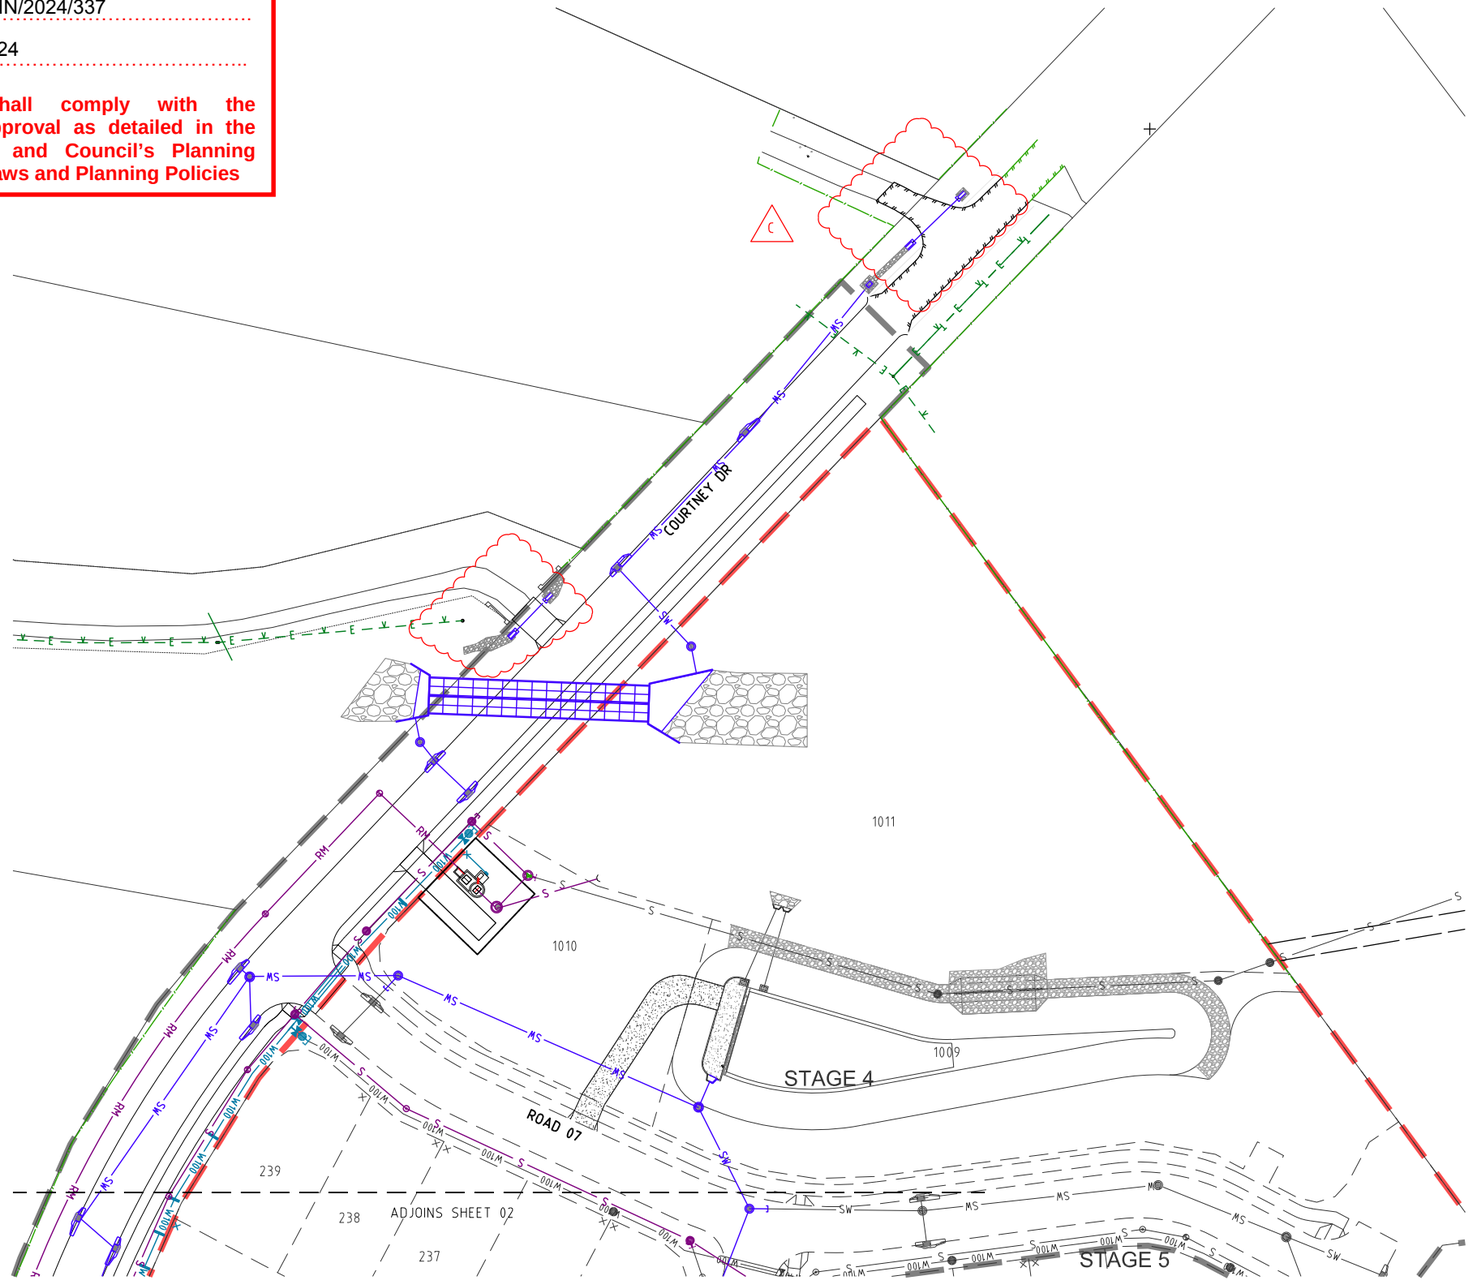

SHEET LAYOUT

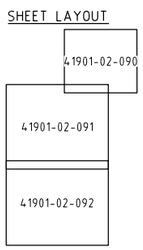

DIAL BEFORE YOU DIG www.1100.com.au

PROJECT NAME

COURTNEY DR UPPER COOMERA

STAGE 02

RP DESCRIPTION

LOT 188, 189, 190, 191 & 192 ON RP173728
COURTNEY DRIVE
LOCALITY OF UPPER COOMERA
LOCAL AUTHORITY - GOLD COAST CITY COUNCIL

CLIENT

HB Land

NORTH

0 5 10 15 20 25m

Scale 1:500 - A1 (1:1000 - A3)

REV	DATE	DESCRIPTION	INT
C	13-06-24	STORMWATER AMENDED	RK
B	29-11-23	WATERMAIN LINETYPE AMENDED	BL
A	13-10-23	COUNCIL ISSUE	EP

COPYRIGHT IS VESTED IN MORTONS-URBAN SOLUTIONS AND WRITTEN CONSENT IS REQUIRED PRIOR TO REPRODUCTION. DO NOT SCALE FROM THIS DRAWING.

ASSOCIATED CONSULTANTS

BIOME WATER AND ENVIRONMENTAL CONSULTING

Robin Russell & ASSOCIATES PTY. LTD.

BENNETT+BENNETT

DRAWING TITLE

COMBINED SERVICES PLAN SHEET 01

MORTONS urbansolutions
Urban & Regional Planning
Civil Engineering
Project Coordination

MUS Pty Ltd T/As:
Mortons-Urban Solutions
ABN: 39 116 375 065
mortons@urbansolutions.net.au
www.urbansolutions.net.au
Tel 07 5571 1099

Postal Address
PO Box 2484
Southport QLD 4215

Gold Coast Office
Suite 9, 19 Short St
Southport QLD 4215

DESIGNED	RB	DRAWN	EP
APPROVED	RPEQ 4706	DATE	13-10-23

DRAWING NUMBER 41901-02-090

REV C


F:\Autocad Client\419 - HB Land\01 - Courtney Drive\Precinct-Stage 02\Engineering Drawings\Current\41901-02-090.dwg, PLAN SHEET 01, 21/06/2024 1:22:11 PM, 1:2

PLANS AND DOCUMENTS referred to in the DEVELOPMENT APPROVAL

Application No: MIN/2024/337

Dated: 16 July 2024

Development shall comply with the conditions of approval as detailed in the Decision Notice and Council's Planning Scheme, Local Laws and Planning Policies

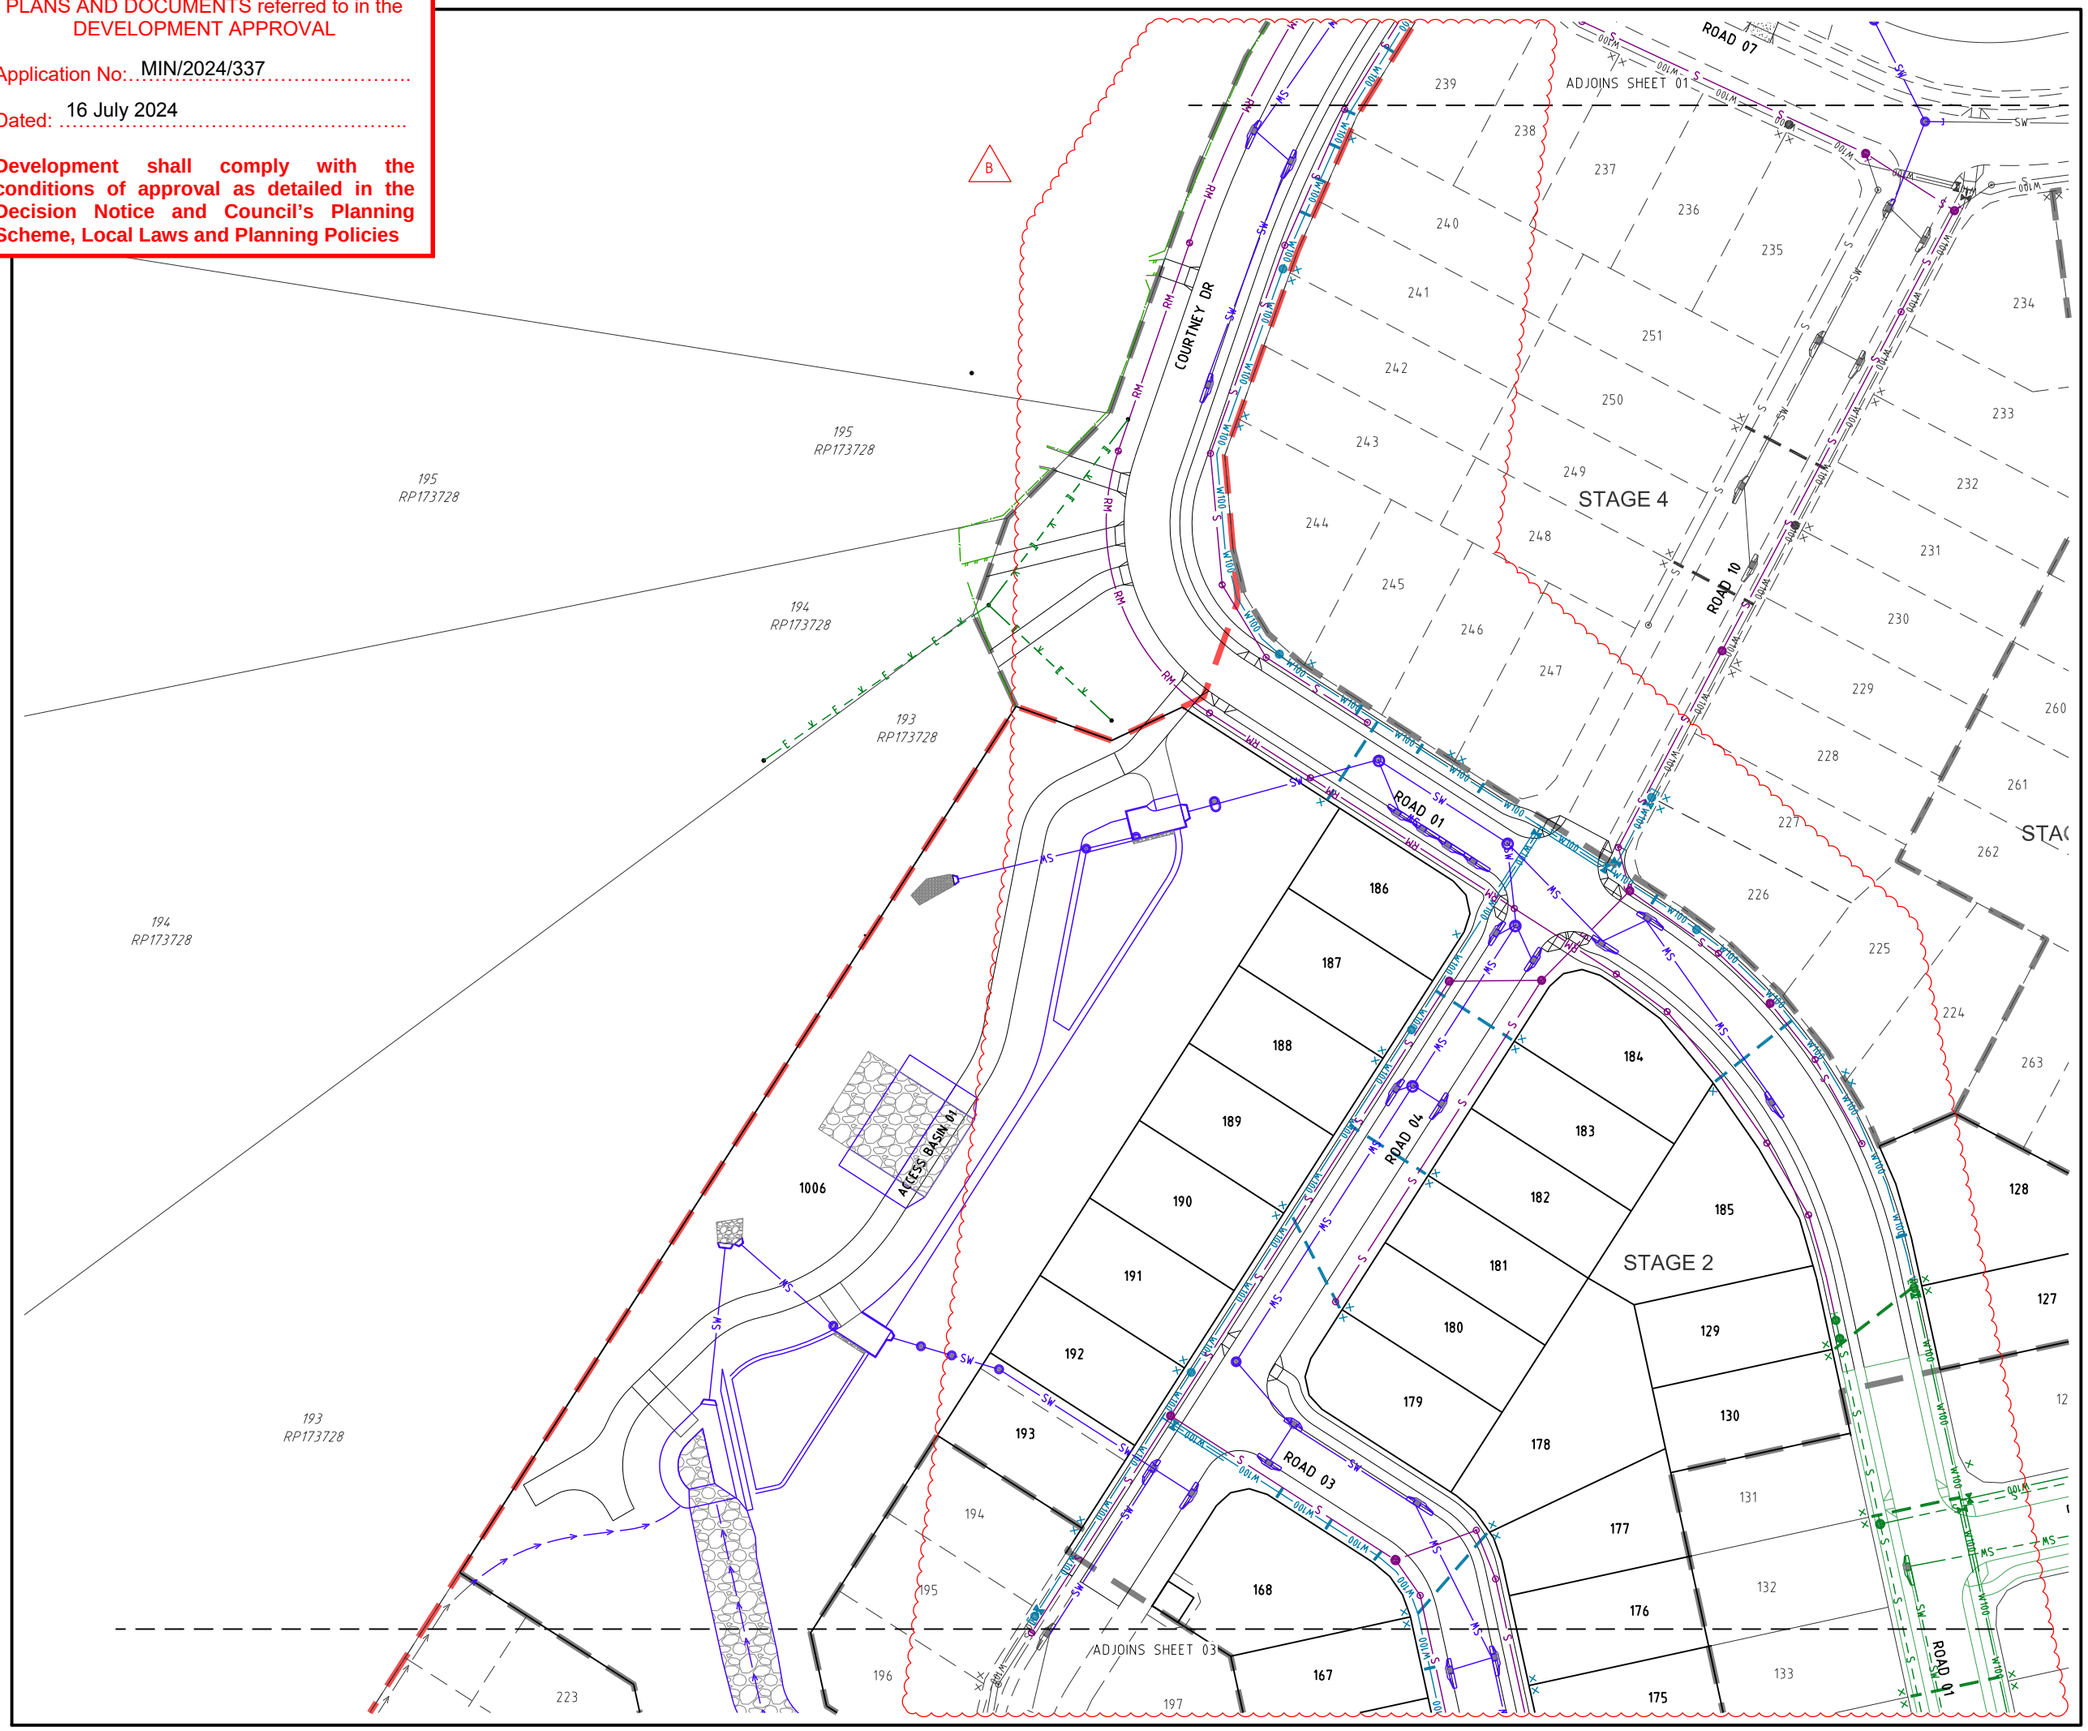

PROJECT NAME

COURTNEY DR UPPER COOMERA

STAGE 02

RP DESCRIPTION

LOT 188, 189, 190, 191 & 192 ON RP173728
COURTNEY DRIVE
LOCALITY OF UPPER COOMERA
LOCAL AUTHORITY - GOLD COAST CITY COUNCIL

CLIENT

HB Land

NORTH

0 5 10 15 20 25m
Scale 1:500 - A1 (1:1000 - A3)

REV	DATE	DESCRIPTION	INT
B	29-11-23	WATERMAIN LINETYPE AMENDED	BL
A	13-10-23	COUNCIL ISSUE	EP

COPYRIGHT IS VESTED IN MORTONS-URBAN SOLUTIONS AND WRITTEN CONSENT IS REQUIRED PRIOR TO REPRODUCTION.
DO NOT SCALE FROM THIS DRAWING.

ASSOCIATED CONSULTANTS

BIOME WATER AND ENVIRONMENTAL CONSULTING
Robin Russell & ASSOCIATES PTY. LTD.
BENNETT+BENNETT

DRAWING TITLE

COMBINED SERVICES PLAN
SHEET 02

MORTONS urbansolutions
Urban & Regional Planning
Civil Engineering
Project Coordination

MUS Pty Ltd T/As
Mortons-Urban Solutions
ABN 39 116 375 065

mortons@urbansolutions.net.au
www.urbansolutions.net.au
Tel 07 5571 1099


Postal Address
PO Box 2484
Southport QLD 4215

Gold Coast Office
Suite 9, 19 Short St
Southport QLD 4215

DESIGNED	RB	DRAWN	EP
APPROVED	RPEQ 4706	DATE	13-10-23

DRAWING NUMBER	REV
41901-02-091	B

F:\Autocad Client\419 - HB Land\01 - Courtney Drive\Precinct-Stage 02\Engineering Drawings\Current\41901-02-090.dwg, PLAN SHEET 02, 21/06/2024 1:22:15 PM, 1:2

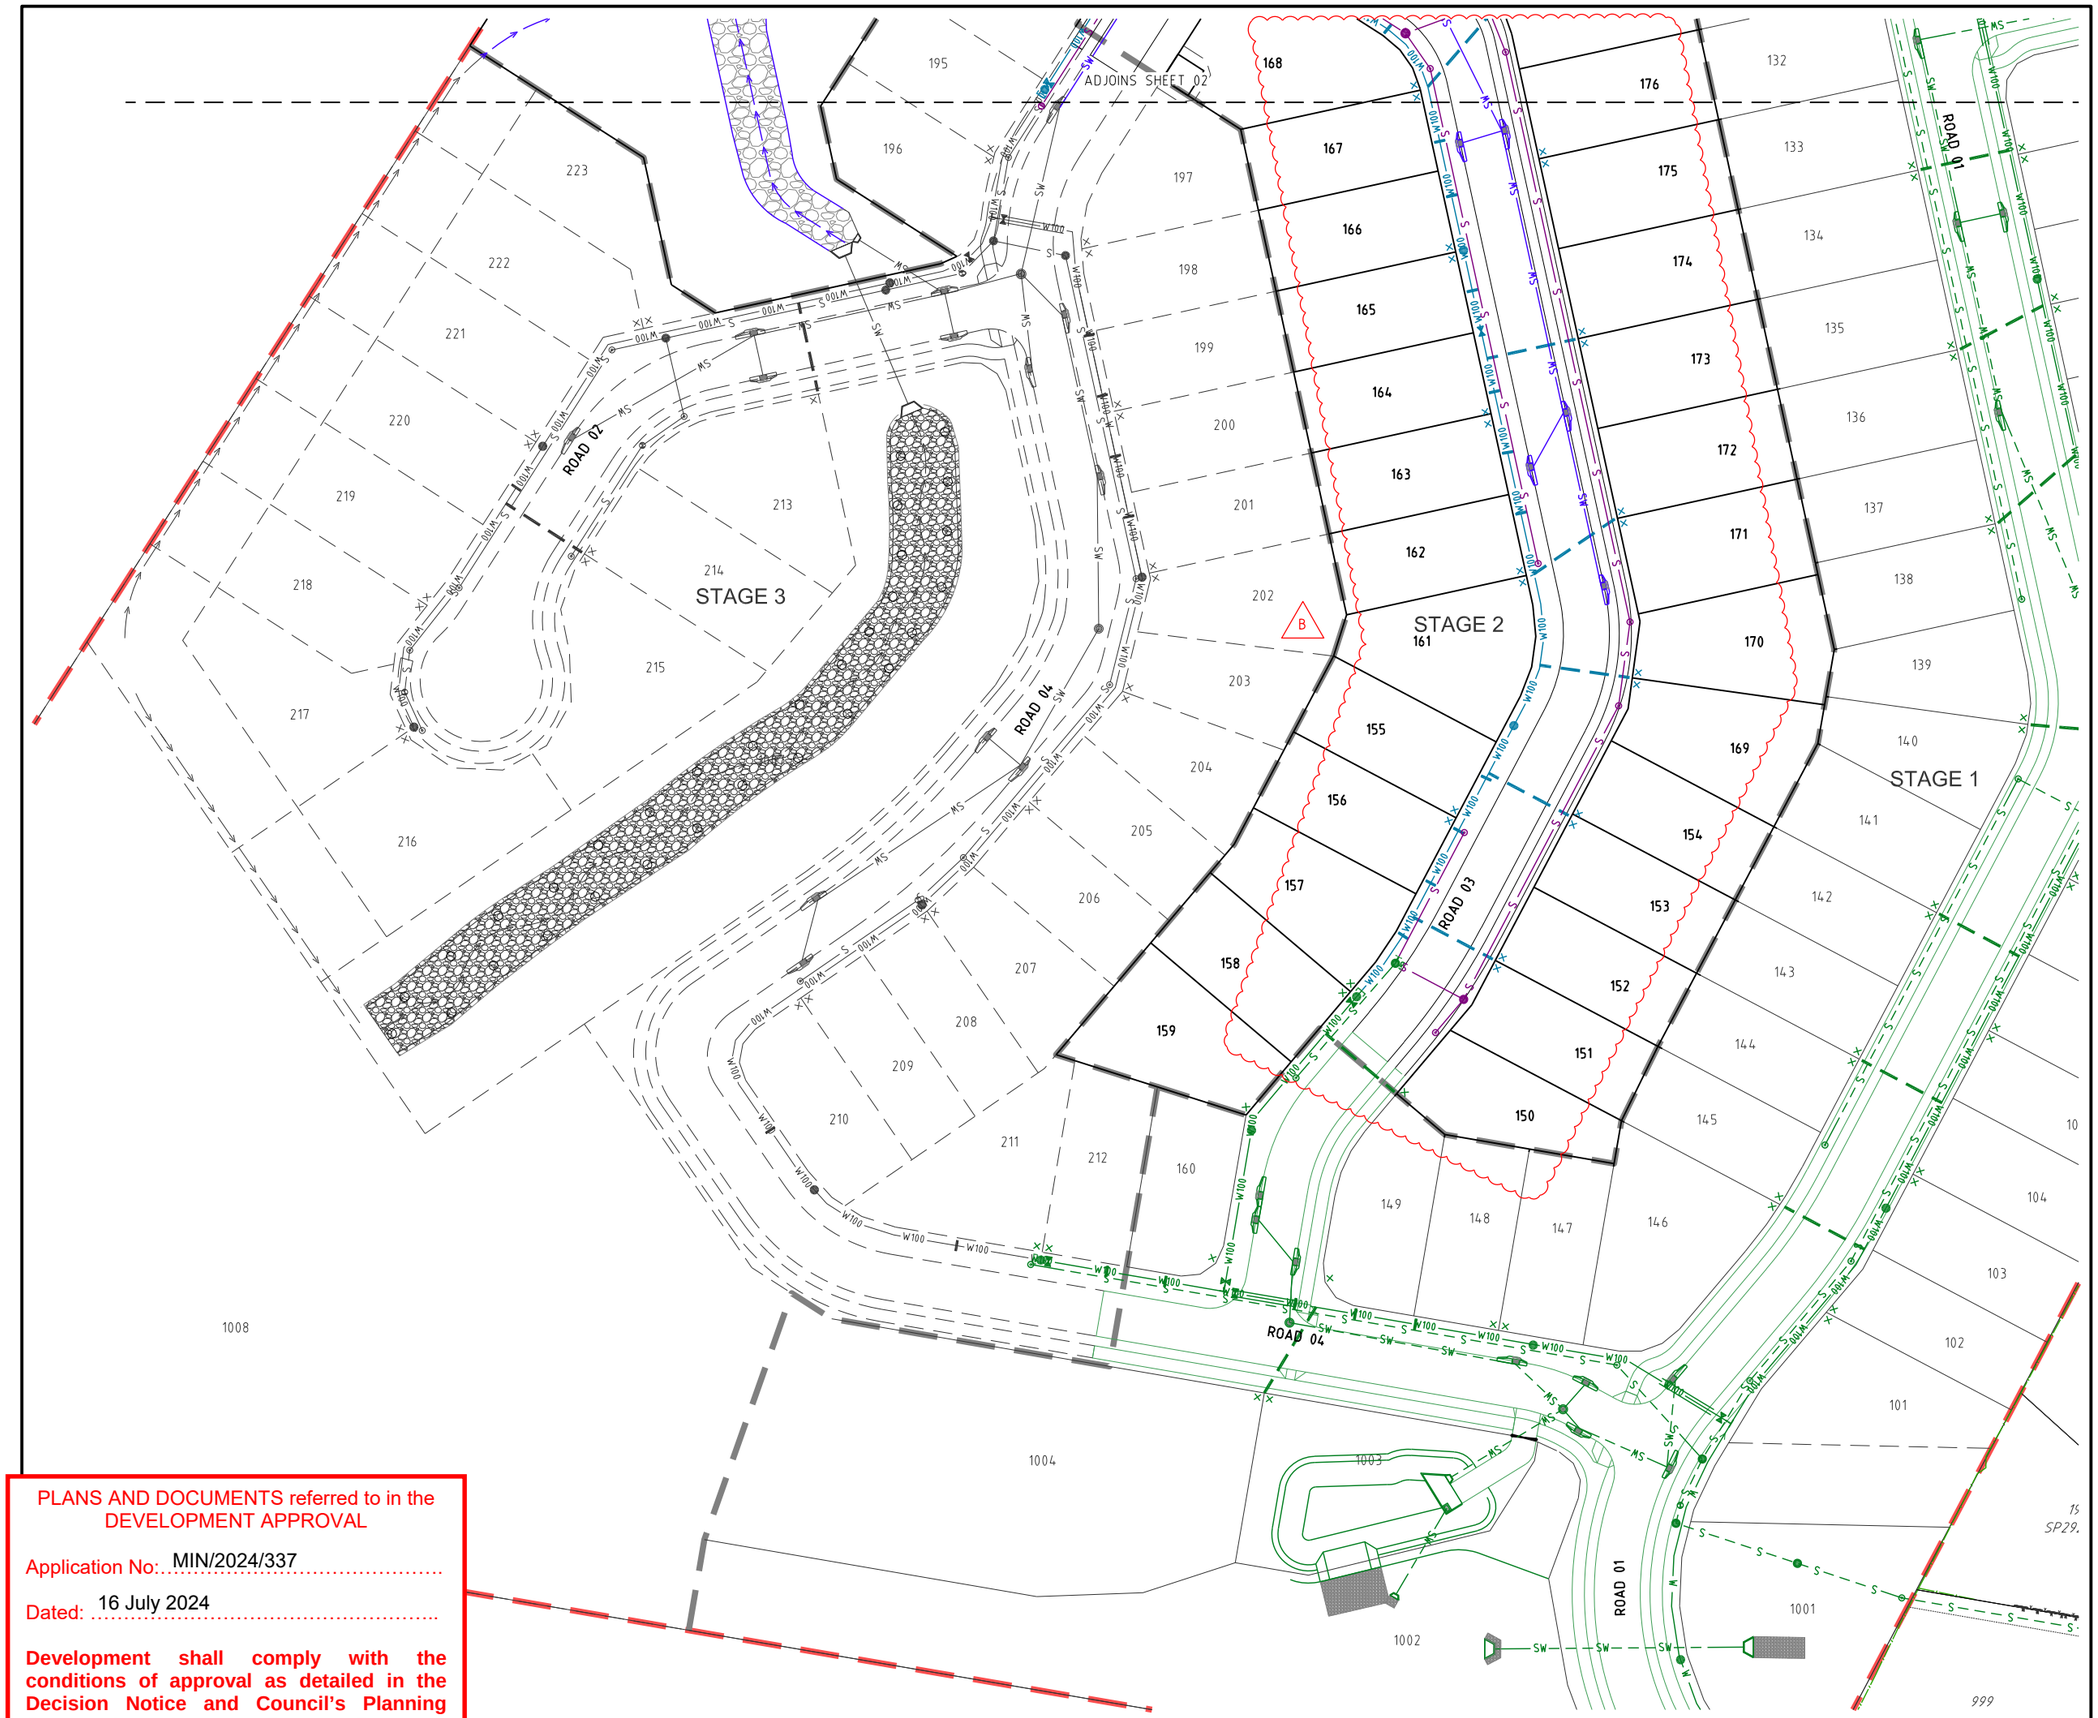

PLANS AND DOCUMENTS referred to in the DEVELOPMENT APPROVAL

Application No: MIN/2024/337

Dated: 16 July 2024

Development shall comply with the conditions of approval as detailed in the Decision Notice and Council's Planning Scheme, Local Laws and Planning Policies

F:\Autocad Client\419 - HB Land\01 - Courtney Drive\Precinct-Stage 02\Engineering Drawings\Current\41901-02-090.dwg, PLAN SHEET 03, 21/06/2024 1:22:18 PM, 1:2

PROJECT NAME

COURTNEY DR UPPER COOMERA

STAGE 02

RP DESCRIPTION

LOT 188, 189, 190, 191 & 192 ON RP173728
COURTNEY DRIVE
LOCALITY OF UPPER COOMERA
LOCAL AUTHORITY - GOLD COAST CITY COUNCIL

CLIENT

HB Land

NORTH

0 5 10 15 20 25m

Scale 1:500 - A1 (1:1000 - A3)

REV	DATE	DESCRIPTION	INT
B	29-11-23	WATERMAIN LINETYPE AMENDED	BL
A	13-10-23	COUNCIL ISSUE	EP

COPYRIGHT IS VESTED IN MORTONS-URBAN SOLUTIONS AND WRITTEN CONSENT IS REQUIRED PRIOR TO REPRODUCTION. DO NOT SCALE FROM THIS DRAWING.

ASSOCIATED CONSULTANTS

BIOME WATER AND ENVIRONMENTAL CONSULTING

Robin Russell & ASSOCIATES PTY. LTD.

BENNETT + BENNETT

DRAWING TITLE

COMBINED SERVICES PLAN
SHEET 03

MORTONS urbansolutions
Urban & Regional Planning
Civil Engineering
Project Coordination

MUS Pty Ltd T/As:
Mortons-Urban Solutions
ABN: 39 116 375 065
mortons@urbansolutions.net.au
www.urbansolutions.net.au
Tel 07 5571 1099

Postal Address
PO Box 2484
Southport QLD 4215

Gold Coast Office
Suite 9, 19 Short St
Southport QLD 4215

DESIGNED	RB	DRAWN	EP
APPROVED		RPEQ 4706	DATE 13-10-23

DRAWING NUMBER	REV
41901-02-092	B

PLANS AND DOCUMENTS referred to in the DEVELOPMENT APPROVAL

Application No: MIN/2024/337

Dated: 16 July 2024

Development shall comply with the conditions of approval as detailed in the Decision Notice and Council's Planning Scheme, Local Laws and Planning Policies

ROADWORKS


1. PAVEMENT DEPTHS
   a) THE DESIGN PAVEMENT DEPTHS ALLOWED IN EARTHWORKS CALCULATIONS ARE BASED ON THE DEPTHS SHOWN IN THE SCHEDULE OF PAVEMENT DEPTHS ON DRAWING 120.
   b) THE PAVEMENT DEPTHS GIVEN ARE DESIGN DEPTHS ONLY & MAY BE VARIED AFTER SUB-GRADE TESTS ARE TAKEN. THE CONTRACTOR IS TO PROVIDE THE SUPERINTENDENT A SUBGRADE C.B.R. REPORT PREPARED BY A SUITABLY QUALIFIED GEOTECHNICAL ENGINEER.
   THE SUPERINTENDENT WILL COORDINATE THE AUTHORITIES APPROVAL OF THE PAVEMENT DESIGN.
   c) REFER TO DWG. 120 FOR TYPICAL ROAD SECTIONS.
2. TESTING
   ALL COMPACTION TESTING SHALL BE CARRIED OUT BY AN APPROVED N.A.T.A. TESTING AUTHORITY. ALL SITE FILLING SHALL BE TESTED AT LEVEL 1 REQUIREMENTS.
3. SUBSOIL DRAINS
   SUBSOIL DRAINS ARE TO BE CONSTRUCTED IN ACCORDANCE WITH THE LOCAL AUTHORITY'S SPECIFICATIONS. SUBSOIL DRAINS SHALL BE PLACED UNDER ALL KERB STRUCTURES & ARE TO BE CONSTRUCTED TO A DEPTH GREATER THAN THAT OF THE INVERT OF THE DEEPEST SERVICE CROSSING.
4. MITRE DRAINS
   MITRE DRAINS ARE TO BE CONSTRUCTED ALONG THE CUT/FILL INTERFACE & SAG/LOW POINTS OF ALL ROADS. CONTRACTOR TO REQUEST DIRECTION FROM SUPERINTENDENT WHETHER TO INSTALL MITRE DRAIN AT ROCK ENCOUNTERED IN SUBGRADE. ALL MITRE DRAINS MUST BE FREE DRAINING & TIE INTO THE ADJACENT SUBSOIL DRAINS.
5. ROCK
   THE CONTRACTOR IS TO INCLUDE ROCK EXCAVATION AS PART OF THEIR RATES.
6. TURF
   1.0m TURF STRIP TO BE INSTALLED BEHIND THE BACK OF ALL KERBS. A PERPENDICULAR TURF STRIP AT MAXIMUM 10m INCREMENTS MUST BE INSTALLED TO FULL VERGE WIDTH FOR SEDIMENT & EROSION CONTROL PURPOSES.
7. KERBS
   ALL KERBS TO BE CONSTRUCTED IN ACCORDANCE WITH AUTHORITY STANDARDS
8. PAVEMENT TIE-IN
   PAVEMENT TIE-IN TO BE IN ACCORDANCE WITH DWG. 120

LEGEND


- EXISTING KERB (INVERT)
- EXISTING KERB (LIP & BACK)
- EXISTING FOOTPATH
- EXISTING PROPERTY LINE
- 1.0 EXISTING CONTOURS
- FUTURE KERB
- FUTURE FOOTPATH
- FUTURE PROPERTY LINE
- 1.0 FUTURE CONTOURS
- CONTROL LINE / CENTER OF ROAD
- PROPOSED KERB (INVERT)
- PROPOSED KERB (LIP & BACK)
- PROPOSED FOOTPATH
- PROPOSED PROPERTY LINE
- SITE BOUNDARY
- STAGE BOUNDARY
- 1.0 DESIGN CONTOURS
- PROPOSED CONCRETE
- 41.065 CENTRELINE CHAINAGE
- B1 BARRIER KERB & CHANNEL

REFER TO DRG. 120 FOR KERB TYPES

SHEET LAYOUT

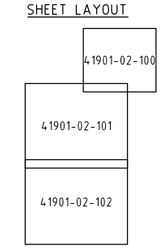

DIAL BEFORE YOU DIG www.1100.com.au

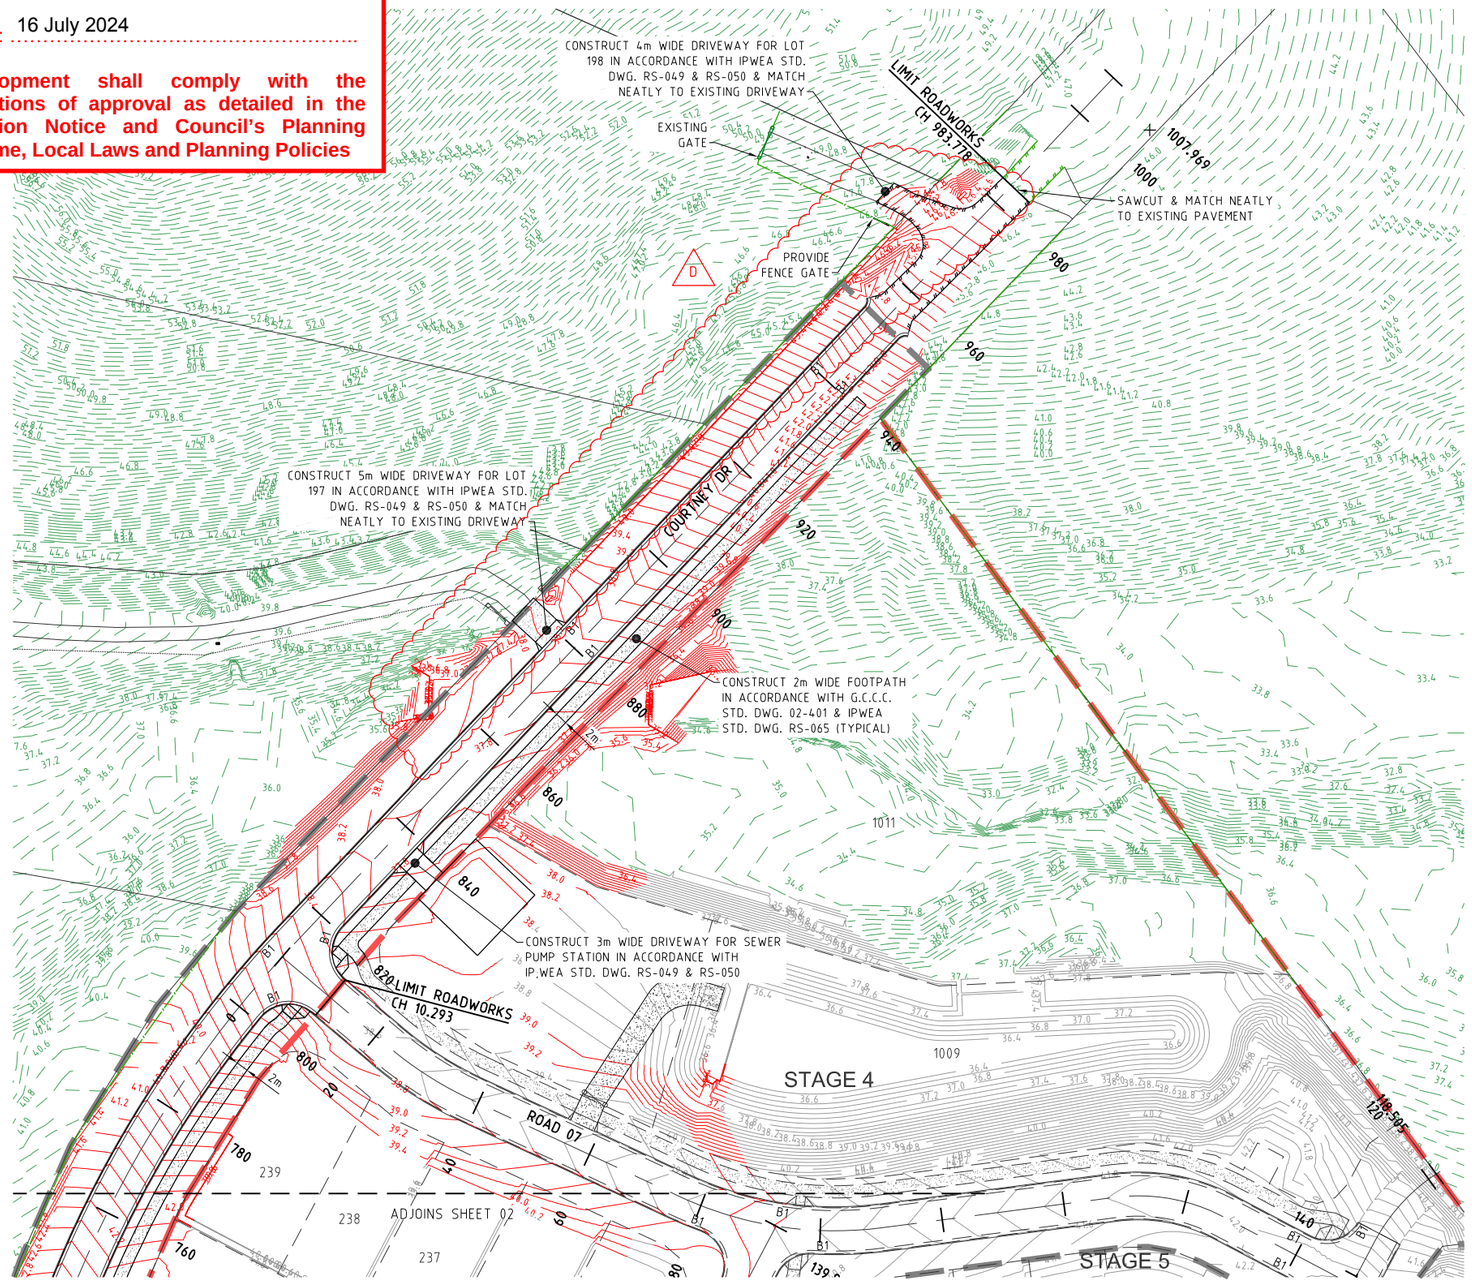

PROJECT NAME

COURTNEY DR UPPER COOMERA

STAGE 02

RP DESCRIPTION

LOT 188, 189, 190, 191 & 192 ON RP173728
COURTNEY DRIVE
LOCALITY OF UPPER COOMERA
LOCAL AUTHORITY - GOLD COAST CITY COUNCIL

CLIENT

HB Land

NORTH

0 5 10 15 20 25m

Scale 1:500 - A1 (1:1000 - A3)

REV	DATE	DESCRIPTION	INT
D	14-06-24	CONTOURS & DRIVEWAY AMENDED	RK
C	15-01-24	CONTOURS & LIMIT OF WORKS AMENDED	BL
B	29-11-23	FOOTPATH DIMENSIONS AMENDED	BL
A	13-10-23	COUNCIL ISSUE	EP

COPYRIGHT IS VESTED IN MORTONS-URBAN SOLUTIONS AND WRITTEN CONSENT IS REQUIRED PRIOR TO REPRODUCTION.
DO NOT SCALE FROM THIS DRAWING.

ASSOCIATED CONSULTANTS

BIOME WATER AND ENVIRONMENTAL CONSULTING

Robin Russell & ASSOCIATES PTY. LTD.

BENNETT + BENNETT

DRAWING TITLE

ROADWORKS
PLAN
SHEET 01

MORTONS urbansolutions
Urban & Regional Planning
Civil Engineering
Project Coordination

MUS Pty Ltd T/As
Mortons-Urban Solutions
ABN: 39 116 375 065
mortons@urbansolutions.net.au
www.urbansolutions.net.au
Tel 07 5571 1099

Postal Address
PO Box 2484
Southport QLD 4215

Gold Coast Office
Suite 9, 19 Short St
Southport QLD 4215

DESIGNED	RB	DRAWN	EP
APPROVED	RPEQ 4706	DATE	13-10-23

DRAWING NUMBER	REV
41901-02-100	D

F:\Autocad Client\419 - HB Land\01 - Courtney Drive\Precinct-Stage 02\Engineering Drawings\Current\41901-02-100.dwg, PLAN SHEET 01, 21/06/2024 12:22:40 PM, 1:2

PLANS AND DOCUMENTS referred to in the DEVELOPMENT APPROVAL

Application No: MIN/2024/337

Dated: 16 July 2024

Development shall comply with the conditions of approval as detailed in the Decision Notice and Council's Planning Scheme, Local Laws and Planning Policies

CONSTRUCT 3m WIDE DRIVEWAY FOR LOT 196 IN ACCORDANCE WITH IPWEA STD. DWG. RS-049 & RS-050 & MATCH NEATLY TO EXISTING DRIVEWAY

CONSTRUCT 3m WIDE DRIVEWAY FOR LOT 195 IN ACCORDANCE WITH IPWEA STD. DWG. RS-049 & RS-050 & MATCH NEATLY TO EXISTING DRIVEWAY

CONSTRUCT 3m WIDE DRIVEWAY FOR LOT 193 & 194 IN ACCORDANCE WITH IPWEA STD. DWG. RS-049 & RS-050 & MATCH NEATLY TO EXISTING DRIVEWAY

CONSTRUCT 4m WIDE DRIVEWAY FOR ACCESS BASIN 01 IN ACCORDANCE WITH IPWEA STD. DWG. RS-049 & RS-050

ADJOINS SHEET 01

ADJOINS SHEET 03

COURTNEY DR

ROAD 07

ROAD 10

ROAD 08

ROAD 04

ROAD 03

ROAD 06

ROAD 01

ACCESS BASIN 01

STAGE 4

STAGE 5

STAGE 2

LIMIT ROADWORKS CH 12.339

LIMIT ROADWORKS CH 499.518

LIMIT ROADWORKS CH 137.722

CONSTRUCT 2m WIDE FOOTPATH IN ACCORDANCE WITH G.C.C.C. STD. DWG. 02-401 & IPWEA STD. DWG. RS-065 (TYPICAL)

JOIN NEATLY TO EXISTING FOOTPATH

SAWCUT & MATCH NEATLY TO EXISTING PAVEMENT

195 RP173728

194 RP173728

193 RP173728

PROJECT NAME

COURTNEY DR UPPER COOMERA

STAGE 02

RP DESCRIPTION

LOT 188, 189, 190, 191 & 192 ON RP173728
COURTNEY DRIVE
LOCALITY OF UPPER COOMERA
LOCAL AUTHORITY - GOLD COAST CITY COUNCIL

CLIENT

HB Land

NORTH

0 5 10 15 20 25m

Scale 1:500 - A1 (1:1000 - A3)

REV	DATE	DESCRIPTION	INT
B	29-11-23	BASIN HATCH AMENDED & DRIVEWAY HATCH ADDED	BL
A	13-10-23	COUNCIL ISSUE	EP

COPYRIGHT IS VESTED IN MORTONS-URBAN SOLUTIONS AND WRITTEN CONSENT IS REQUIRED PRIOR TO REPRODUCTION. DO NOT SCALE FROM THIS DRAWING.

ASSOCIATED CONSULTANTS

BIOME WATER AND ENVIRONMENTAL CONSULTING

Robin Russell & ASSOCIATES PTY. LTD.

BENNETT+BENNETT

DRAWING TITLE

ROADWORKS
PLAN
SHEET 02

MORTONS urbansolutions
Urban & Regional Planning
Civil Engineering
Project Coordination

MUS Pty Ltd T/As:
Mortons-Urban Solutions
ABN: 39 116 375 065
mortons@urbansolutions.net.au
www.urbansolutions.net.au
Tel 07 5571 1099

Postal Address
PO Box 2484
Southport QLD 4215

Gold Coast Office
Suite 9, 19 Short St
Southport QLD 4215

DESIGNED	RB	DRAWN	EP
APPROVED	RPEQ 4706	DATE	13-10-23

DRAWING NUMBER 41901-02-101

REV B

F:\Autocad Client\419 - HB Land\01 - Courtney Drive\Precinct-Stage 02\Engineering Drawings\Current\41901-02-100.dwg, PLAN SHEET 02, 21/06/2024 1:22:54 PM, 1:2

ADJOINS SHEET 02

STAGE 3

STAGE 2

STAGE 1

ROAD 01

ROAD 02

ROAD 03

ROAD 04

LOCALISED EARTHWORKS IN THIS AREA TO MAINTAIN CHANNEL PROFILE THROUGH ROAD 02. STORMWATER CULVERT TO BE INSTALLED AS PART OF STAGE 3 WORKS.

CONSTRUCT 2m WIDE FOOTPATH IN ACCORDANCE WITH G.C.C.C. STD. DWG. 02-401 & IPWEA STD. DWG. RS-065 (TYPICAL)

LIMIT ROADWORKS CH 222.133

JOIN NEATLY TO EXISTING FOOTPATH

SAWCUT & MATCH NEATLY TO EXISTING PAVEMENT

274.677

512.814

130.388

PLANS AND DOCUMENTS referred to in the DEVELOPMENT APPROVAL

Application No: MIN/2024/337

Dated: 16 July 2024

Development shall comply with the conditions of approval as detailed in the Decision Notice and Council's Planning Scheme, Local Laws and Planning Policies

F:\Autocad Client\419 - HB Land\01 - Courtney Drive\Precinct-Stage 02\Engineering Drawings\Current\41901-02-100.dwg, PLAN SHEET 03, 21/06/2024 12:31:14 PM, 1:2

PROJECT NAME

COURTNEY DR UPPER COOMERA

STAGE 02

RP DESCRIPTION

LOT 188, 189, 190, 191 & 192 ON RP173728
COURTNEY DRIVE
LOCALITY OF UPPER COOMERA
LOCAL AUTHORITY - GOLD COAST CITY COUNCIL

CLIENT

HB Land

NORTH

0 5 10 15 20 25m

Scale 1:500 - A1 (1:1000 - A3)

REV	DATE	DESCRIPTION	INT
A	13-10-23	COUNCIL ISSUE	EP

COPYRIGHT IS VESTED IN MORTONS-URBAN SOLUTIONS AND WRITTEN CONSENT IS REQUIRED PRIOR TO REPRODUCTION. DO NOT SCALE FROM THIS DRAWING.

ASSOCIATED CONSULTANTS

BIOME WATER AND ENVIRONMENTAL CONSULTING

Robin Russell & ASSOCIATES PTY. LTD.

BENNETT + BENNETT

DRAWING TITLE

ROADWORKS
PLAN
SHEET 03

MORTONS urbansolutions
Urban & Regional Planning
Civil Engineering
Project Coordination

MUS Pty Ltd T/As
Mortons-Urban Solutions
ABN: 39 116 375 065
mortons@urbansolutions.net.au
www.urbansolutions.net.au
Tel 07 5571 1099

Postal Address
PO Box 2484
Southport QLD 4215

Gold Coast Office
Suite 9, 19 Short St
Southport QLD 4215

DESIGNED	RB	DRAWN	EP
APPROVED	RPEQ 4706	DATE	13-10-23

DRAWING NUMBER	REV
41901-02-102	A


SCHEDULE OF PAVEMENT DEPTHS

ROAD NAME	SURFACING	BASE	SUB-BASE	LOWER SUB-BASE	CLASSIFICATION	DESA OR VPD	DESIGN GUIDE
ROAD 03, ROAD 04 & ROAD 10	25mm ASPHALT	100mm TYPE 2.1 (CBR 60)	100mm TYPE 2.3 (CBR 45)	100mm TYPE 2.5 (CBR 15)	RESIDENTIAL ACCESS ST	401-750	GCCC TABLE 2.11
COURTNEY DRIVE & ROAD 01 & ROAD 07	25mm ASPHALT	100mm TYPE 2.1 (CBR 60)	100mm TYPE 2.3 (CBR 45)	100mm TYPE 2.5 (CBR 15)	RESIDENTIAL COLLECTOR ST	751-3000	GCCC TABLE 2.11

NOTE: THE PAVEMENT DEPTHS ARE GIVEN AS A GUIDE ONLY AND FINAL PAVEMENT DESIGN WILL BE DETERMINED AFTER CBR TESTING IS UNDERTAKEN, AND COUNCIL HAVE APPROVED THE DESIGN. PLEASE NOTE CBR10 IS MAXIMUM INSITU CBR VALUE.


SCHEDULE OF KERB TYPES

KERB TYPE	IMAGE	REFERENCE
B1		IPWEA DWG. RS-080 NOTE: SUBSOIL DRAINS TO BE PLACED UNDER ALL KERBS.

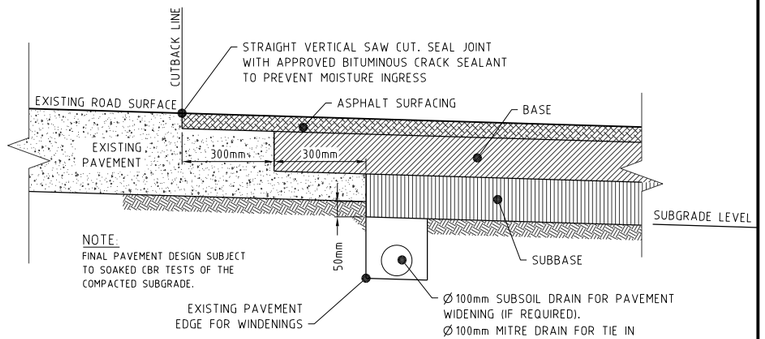

PAVEMENT WIDENING AND TIE-IN DETAIL

NOT TO SCALE

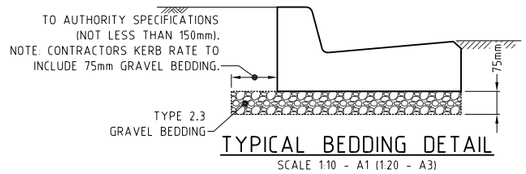

TYPICAL BEDDING DETAIL


SCALE 1:10 - A1 (1:20 - A3)

PLANS AND DOCUMENTS referred to in the DEVELOPMENT APPROVAL

Application No: MIN/2024/337


Dated: 16 July 2024

Development shall comply with the conditions of approval as detailed in the Decision Notice and Council's Planning Scheme, Local Laws and Planning Policies

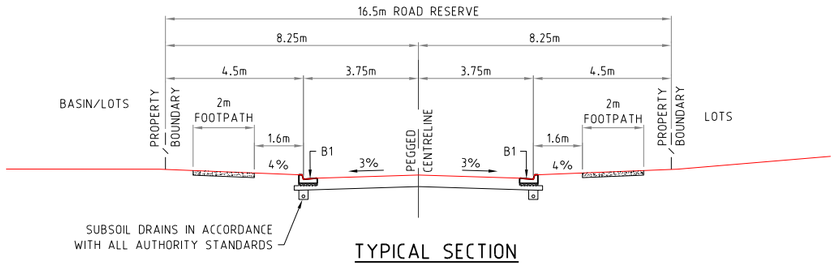


TYPICAL SECTION
7.5m ROAD-16.5m ROAD RESERVE
ROAD 01

SCALE 1:100 - A1 (1:200 - A3)

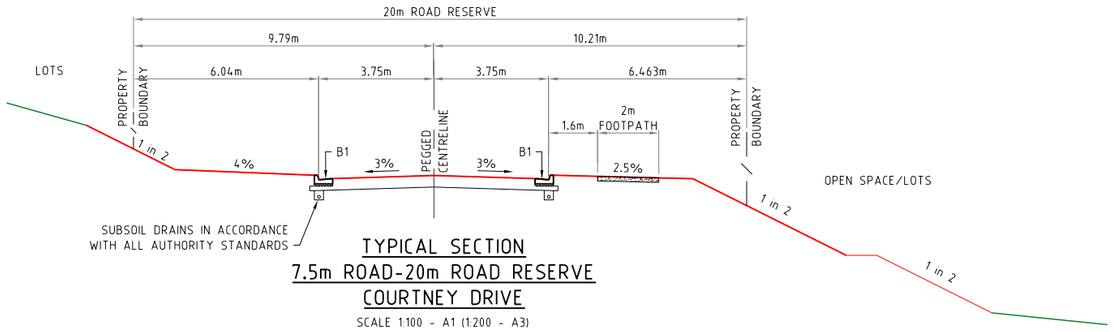


TYPICAL SECTION
7.5m ROAD-20m ROAD RESERVE
COURTNEY DRIVE

SCALE 1:100 - A1 (1:200 - A3)

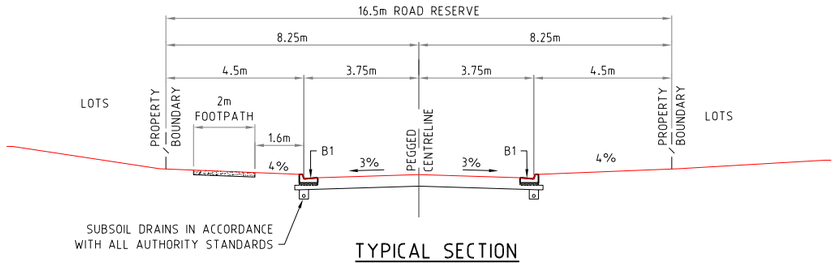

TYPICAL SECTION
7.5m ROAD-16.5m ROAD RESERVE
ROAD 03 & ROAD 07

SCALE 1:100 - A1 (1:200 - A3)

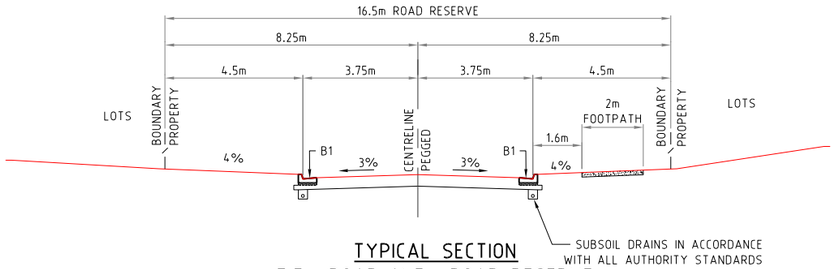

TYPICAL SECTION
7.5m ROAD-16.5m ROAD RESERVE
ROAD 04 & ROAD 10

SCALE 1:100 - A1 (1:200 - A3)

PROJECT NAME

COURTNEY DR UPPER COOMERA

STAGE 02

RP DESCRIPTION

LOT 188, 189, 190, 191 & 192 ON RP173728
COURTNEY DRIVE
LOCALITY OF UPPER COOMERA
LOCAL AUTHORITY - GOLD COAST CITY COUNCIL

CLIENT

HB Land

0 0.1 0.2 0.3 0.4 0.5m
Scale 1:10 - A1 (1:20 - A3)
0 1 2 3 4 5m
Scale 1:100 - A1 (1:200 - A3)

REV	DATE	DESCRIPTION	INT
A	13-10-23	COUNCIL ISSUE	EP

COPYRIGHT IS VESTED IN MORTONS-URBAN SOLUTIONS AND WRITTEN CONSENT IS REQUIRED PRIOR TO REPRODUCTION. DO NOT SCALE FROM THIS DRAWING.

ASSOCIATED CONSULTANTS

BIOME WATER AND ENVIRONMENTAL CONSULTING
Robin Russell & ASSOCIATES PTY. LTD.
BENNETT + BENNETT

DRAWING TITLE

ROADWORKS DETAILS

MORTONS urbansolutions
Urban & Regional Planning
Civil Engineering
Project Coordination
MUS Pty Ltd T/As:
Mortons-Urban Solutions
ABN: 39 116 375 065
mortons@urbansolutions.net.au
www.urbansolutions.net.au
Tel 07 5571 1099
Postal Address
PO Box 2484
Southport QLD 4215
Gold Coast Office
Suite 9, 19 Short St
Southport QLD 4215

DESIGNED RB	DRAWN EP
APPROVED RPEQ 4706	DATE 13-10-23

DRAWING NUMBER 41901-02-120

REV A

F:\Autocad Client\419 - HB Land\01 - Courtney Drive\Precinct-Stage 02\Engineering Drawings\Current\41901-02-120.dwg, DETAILS, 21/06/2024 12:52:21 PM, 1:2

EXISTING | STAGE 2

CH. 499.518

RD 06 CH 468.082

VIP R.L. 56.305

RD 04 CH 598.511

VIP R.L. 44.748

VIP R.L. 43.215

DRAIN #42 | SEWER #03 | DRAIN #41 | DRAIN #41 | SEWER #16 | DRAIN #41 | DRAIN #26 | DRAIN #24 | DRAIN #26 | DRAIN #20

PLANS AND DOCUMENTS referred to in the DEVELOPMENT APPROVAL

Application No: MIN/2024/337

Dated: 16 July 2024

Development shall comply with the conditions of approval as detailed in the Decision Notice and Council's Planning Scheme, Local Laws and Planning Policies

B

DESIGN GRADELINE: -8.000% | -2.490%

VERTICAL GEOMETRY: 139.20m R2400m | 38.30m R695m | 58.78m R1315m

HORIZONTAL GEOMETRY: -85 | 30

DATUM 27.0

CHAINAGE	470.107	480	500	515.44	520	539.707	540	560	580	582.199	600	609.307	620	640	660	660.985	665.014	680	684.162	700	700.893	703.31	716.366	720	736.752	740	745.757	760
CONTROL LINE LEVELS	57.836	57.598	56.992	56.41	56.22	55.296	55.281	54.175	52.902	52.752	51.463	50.737	49.881	48.281	46.681	46.602	46.28	45.243	45.012	44.362	44.336	44.272	43.946	43.851	43.281	43.146	42.886	42.136
EXISTING SURFACE	60.25	60.279	62.621	62.838	62.864	61.933	61.904	59.915	58.028	57.933	56.439	55.577	54.353	52.176	49.643	49.527	49.05	44.474	44.441	44.252	44.239	44.203	43.931	43.835	43.272	43.159	42.891	42.113
DEPTH	2.414	2.682	5.628	6.427	6.644	6.637	6.623	5.74	5.125	5.181	4.976	4.84	4.472	3.895	2.962	2.925	2.77	-0.769	-0.571	-0.11	-0.097	-0.069	-0.016	-0.016	-0.009	0.013	0.005	-0.024

COURTNEY DRIVE/ROAD 01

PROJECT NAME

COURTNEY DR UPPER COOMERA

STAGE 02

RP DESCRIPTION

LOT 188, 189, 190, 191 & 192 ON RP173728
COURTNEY DRIVE
LOCALITY OF UPPER COOMERA
LOCAL AUTHORITY - GOLD COAST CITY COUNCIL

CLIENT

HB Land

0 5 10 15 20 25m
Horiz. Scale 1:500 - A1 (1:1000 - A3)

0 1 2 3 4 5m
Vert. Scale 1:100 - A1 (1:200 - A3)

REV	DATE	DESCRIPTION	INT
B	15-01-24	LONG SECTION AMENDED	BL
A	13-10-23	COUNCIL ISSUE	EP

COPYRIGHT IS VESTED IN MORTONS-URBAN SOLUTIONS AND WRITTEN CONSENT IS REQUIRED PRIOR TO REPRODUCTION. DO NOT SCALE FROM THIS DRAWING.

ASSOCIATED CONSULTANTS

BIOME WATER AND ENVIRONMENTAL CONSULTING

Robin Russell & ASSOCIATES PTY. LTD.

BENNETT + BENNETT

DRAWING TITLE

LONGITUDINAL SECTIONS
COURTNEY DRIVE/ROAD 01
SHEET 01

MORTONS urbansolutions
Urban & Regional Planning
Civil Engineering
Project Coordination

MUS Pty Ltd T/As:
Mortons-Urban Solutions
ABN: 39 116 375 065
mortons@urbansolutions.net.au
www.urbansolutions.net.au
Tel 07 5571 1099

Postal Address
PO Box 2484
Southport QLD 4215


Gold Coast Office
Suite 9, 19 Short St
Southport QLD 4215

DESIGNED	RB	DRAWN	EP
APPROVED	RPEQ 4706	DATE	13-10-23

DRAWING NUMBER: 41901-02-200

REV: B

F:\Autocad Client\419 - HB Land\01 - Courtney Drive\Precinct-Stage 02\Engineering Drawings\Current\41901-02-200.dwg, COURTNEY DRIVE-ROAD 01 SHEET 01, 21/06/2024 12:23:24 PM, 1:2

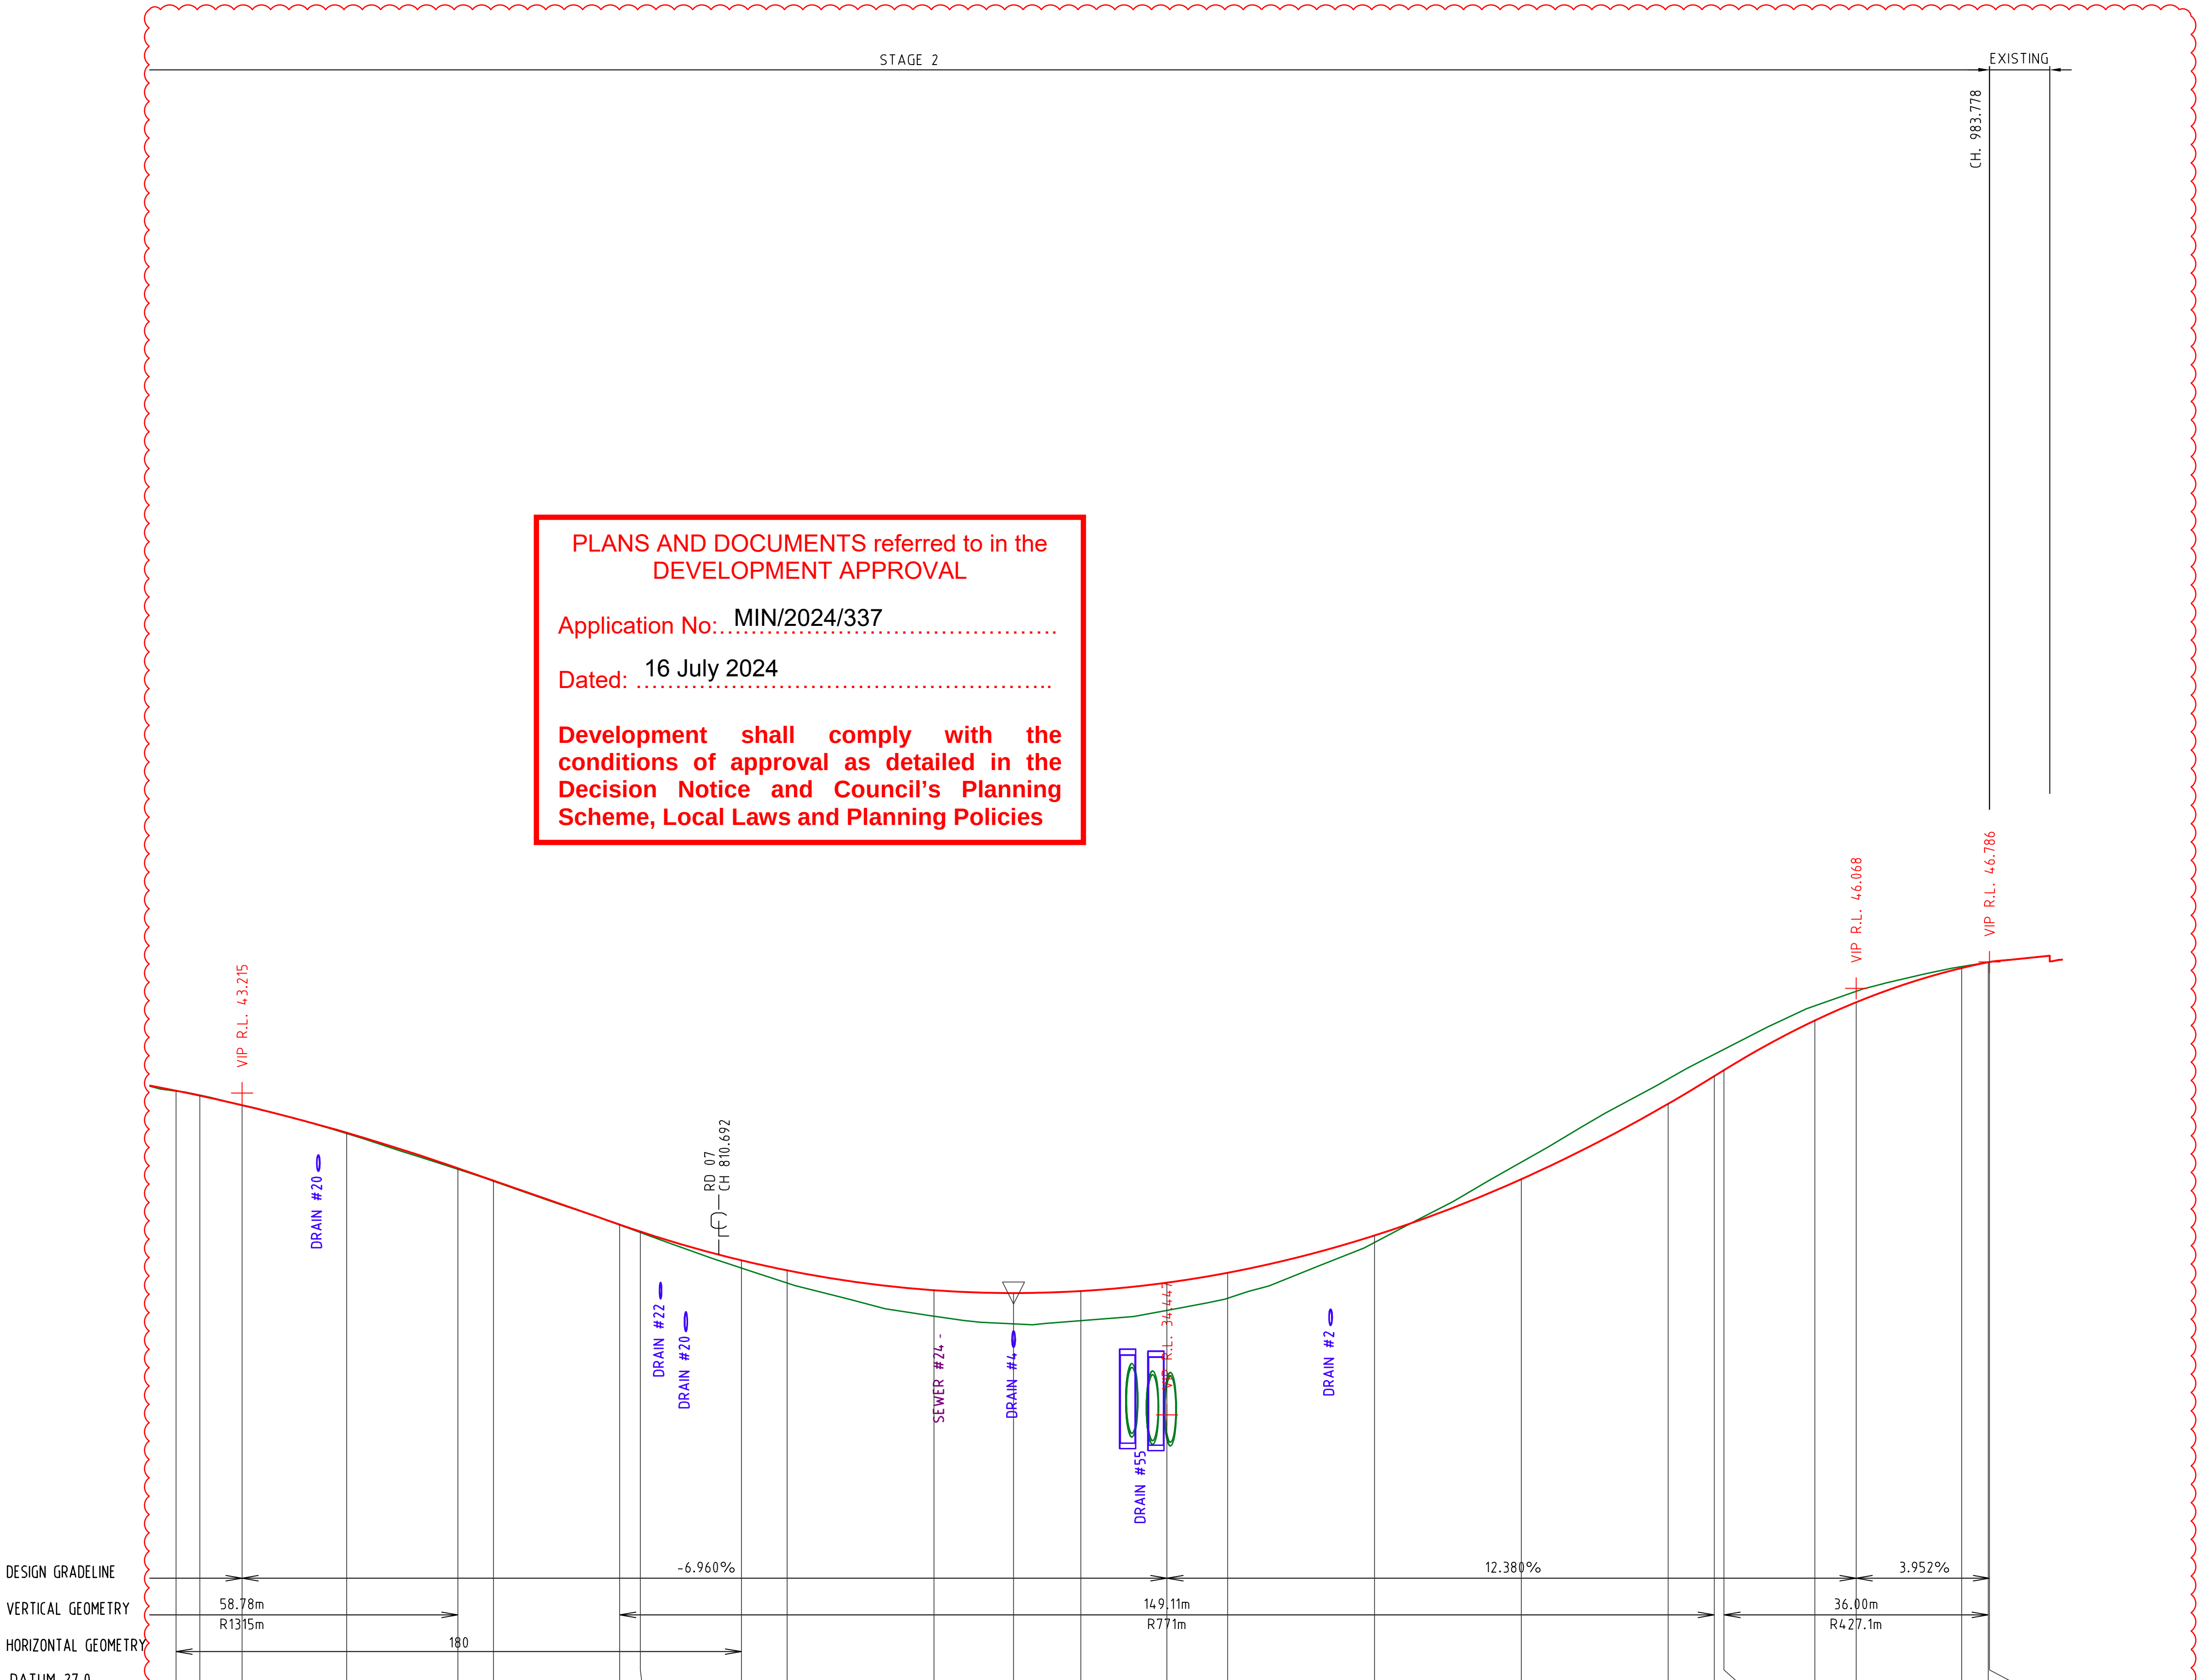

PLANS AND DOCUMENTS referred to in the DEVELOPMENT APPROVAL

Application No: MIN/2024/337

Dated: 16 July 2024

Development shall comply with the conditions of approval as detailed in the Decision Notice and Council's Planning Scheme, Local Laws and Planning Policies

B

CONTROL LINE LEVELS	43.281	43.146	42.886	42.136	41.169	40.831	39.635	39.445	38.659
EXISTING SURFACE	43.272	43.159	42.891	42.113	41.141	40.817	39.624	39.418	38.449
DEPTH	-0.009	0.013	0.005	-0.024	-0.028	-0.015	-0.011	-0.026	-0.209
CHAINAGE	736.752	740	745.757	760	775.148	780	797.185	800	813.788

CONTROL LINE LEVELS	38.385	37.844	37.768	37.822	38.051	38.319	39.335	40.87	42.923
EXISTING SURFACE	38.04	37.135	36.928	37.014	37.296	37.626	39.143	41.334	43.599
DEPTH	-0.345	-0.709	-0.84	-0.808	-0.755	-0.694	-0.192	0.464	0.676
CHAINAGE	820	840	850.845	860	871.739	880	900	920	940

CONTROL LINE LEVELS	43.676	43.84	45.194	45.689	46.621	46.779	46.786
EXISTING SURFACE	44.271	44.406	45.595	45.988	46.66	46.78	46.786
DEPTH	0.594	0.566	0.401	0.299	0.039	0.001	0
CHAINAGE	946.293	947.615	960	965.615	980	983.615	983.778

LONGITUDINAL SECTION COURTNEY DRIVE/ROAD 01 (Cont.)

F:\Autocad Client\419 - HB Land\01 - Courtney Drive\Precinct-Stage 02\Engineering Drawings\Current\41901-02-200.dwg, COURTNEY DRIVE-ROAD 01 (Cont.) SHEET 02, 21/06/2024 1:23:25 PM, 1:2

PROJECT NAME

COURTNEY DR
UPPER COOMERA

STAGE 02

RP DESCRIPTION

LOT 188, 189, 190, 191 & 192 ON RP173728
COURTNEY DRIVE
LOCALITY OF UPPER COOMERA
LOCAL AUTHORITY - GOLD COAST CITY COUNCIL

CLIENT

HB Land

0 5 10 15 20 25m
Horiz. Scale 1:500 - A1 (1:1000 - A3)

0 1 2 3 4 5m
Vert. Scale 1:100 - A1 (1:200 - A3)

REV	DATE	DESCRIPTION	INT
B	15-01-24	LONG SECTION AMENDED	BL
A	13-10-23	COUNCIL ISSUE	EP

COPYRIGHT IS VESTED IN MORTONS-URBAN SOLUTIONS AND WRITTEN CONSENT IS REQUIRED PRIOR TO REPRODUCTION. DO NOT SCALE FROM THIS DRAWING.

ASSOCIATED CONSULTANTS

BIOME WATER AND ENVIRONMENTAL CONSULTING
Robin Russell & ASSOCIATES PTY. LTD.
BENNETT + BENNETT

DRAWING TITLE

LONGITUDINAL SECTIONS
COURTNEY DRIVE/ROAD 01 (Cont.)
SHEET 02

MORTONS urbansolutions
Urban & Regional Planning
Civil Engineering
Project Coordination
MUS Pty Ltd T/As:
Mortons-Urban Solutions
ABN: 39 116 375 065
mortons@urbansolutions.net.au
www.urbansolutions.net.au
Tel 07 5571 1099
Postal Address
PO Box 2484
Southport QLD 4215
Gold Coast Office
Suite 9, 19 Short St
Southport QLD 4215

DESIGNED RB | DRAWN EP
APPROVED [signature] | RPEQ 4706 | DATE 13-10-23


DRAWING NUMBER 41901-02-201 | REV B

PLANS AND DOCUMENTS referred to in the DEVELOPMENT APPROVAL

Application No: MIN/2024/337

Dated: 16 July 2024

Development shall comply with the conditions of approval as detailed in the Decision Notice and Council's Planning Scheme, Local Laws and Planning Policies

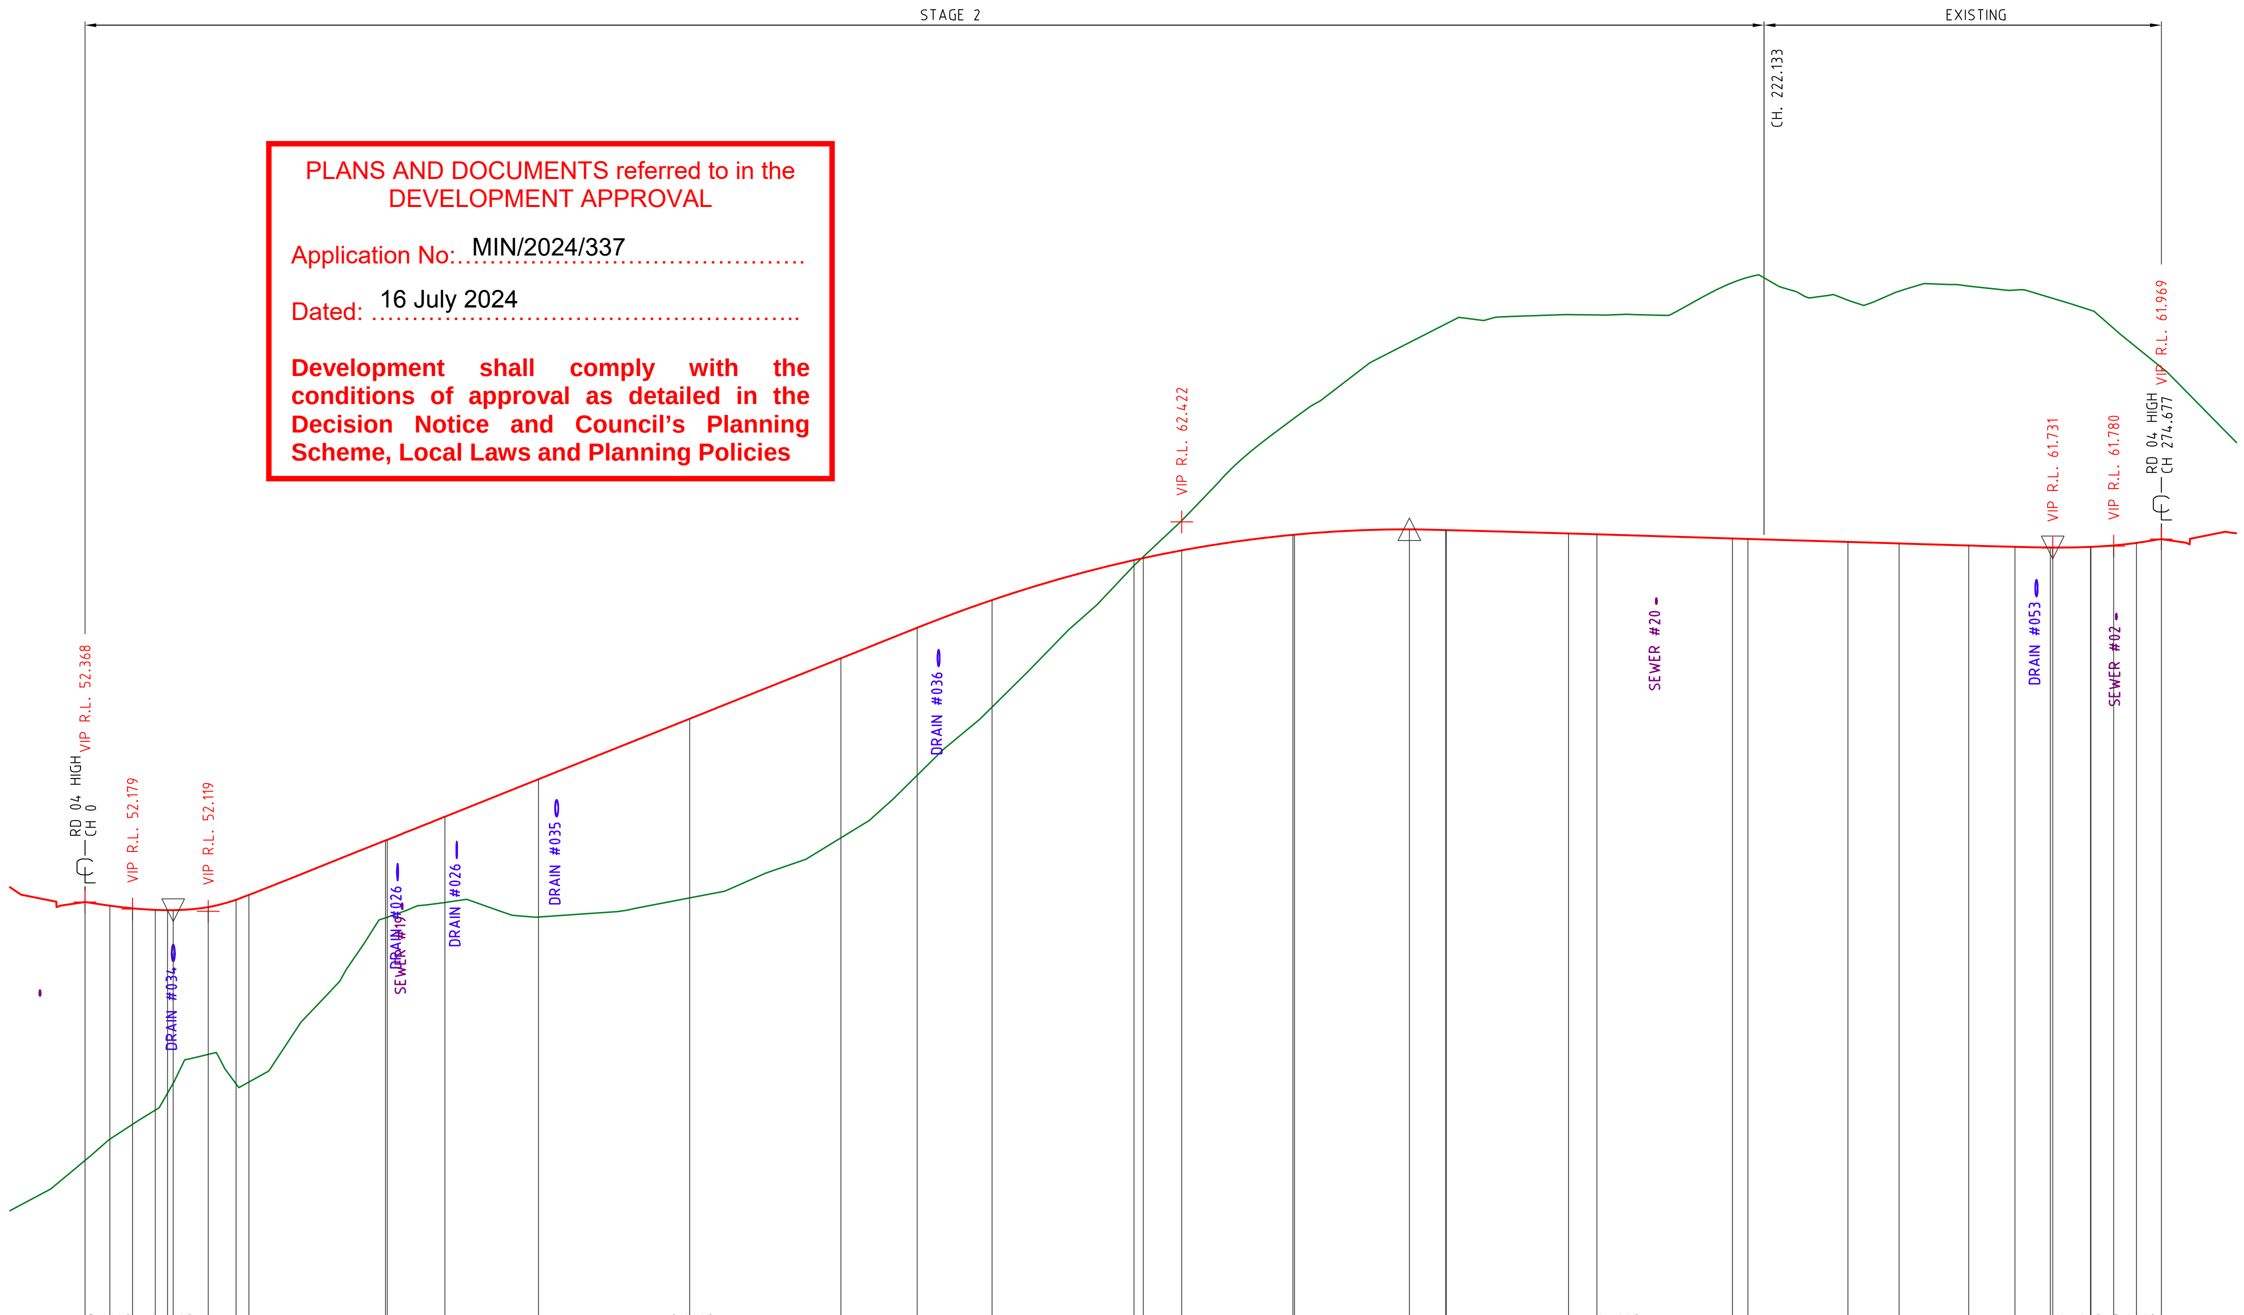

DESIGN GRADELINE: -3.000% | -0.600% | 8.000% | -0.600% | 0.600% | 3.000%

VERTICAL GEOMETRY: 6.00m R250m | 10.75m R125m | 70.00m R814m | 10.00m R833.3m | 6.00m R250m

HORIZONTAL GEOMETRY: 10 | 30 | 100 | -30

DATUM 38.0

CHAINAGE	CONTROL LINE LEVELS	EXISTING SURFACE	DEPTH
0	52.368	45.53	-6.838
3.3	52.269	46.094	-6.175
6.3	52.197	46.487	-5.71
9.3	52.161	46.861	-5.3
10.926	52.151	47.314	-4.837
11.676	52.149	47.576	-4.573
16.3	52.235	48.336	-3.898
20	52.426	47.549	-4.877
21.674	52.549	47.603	-4.946
39.752	53.995	51.947	-2.048
40	54.015	51.963	-2.052
47.606	54.623	52.353	-2.271
60	55.615	51.968	-3.647
80	57.215	52.476	-4.739
100	58.815	54.064	-4.751
110.094	59.622	55.718	-3.904
120	60.355	57.525	-2.829
138.772	61.412	61.267	-0.145
140	61.466	61.5	0.034
145.094	61.67	62.455	0.785
159.797	62.081	65.142	3.061
160	62.085	65.172	3.087
175.21	62.227	67.168	4.941
180	62.213	67.655	5.442
180.094	62.212	67.665	5.452
196.259	62.115	67.907	5.792
200	62.093	67.898	5.805
217.931	61.985	68.748	6.762
220	61.973	68.875	6.902
233.222	61.894	68.287	6.393
240	61.853	68.523	6.67
249.206	61.798	68.661	6.863
255.315	61.761	68.555	6.794
260	61.746	68.356	6.61
260.315	61.746	68.337	6.591
265.315	61.761	68.026	6.265
265.377	61.762	68.022	6.261
268.377	61.798	67.543	5.746
271.377	61.87	67.046	5.176
274.677	61.969	66.51	4.541

LONGITUDINAL SECTION ROAD 03

PROJECT NAME

COURTNEY DR UPPER COOMERA

STAGE 02

RP DESCRIPTION

LOT 188, 189, 190, 191 & 192 ON RP173728
COURTNEY DRIVE
LOCALITY OF UPPER COOMERA
LOCAL AUTHORITY - GOLD COAST CITY COUNCIL

CLIENT

HB Land

0 5 10 15 20 25m — Horiz. Scale 1:500 - A1 (1:1000 - A3)

0 1 2 3 4 5m — Vert. Scale 1:100 - A1 (1:200 - A3)

REV	DATE	DESCRIPTION	INT
A	13-10-23	COUNCIL ISSUE	EP

COPYRIGHT IS VESTED IN MORTONS-URBAN SOLUTIONS AND WRITTEN CONSENT IS REQUIRED PRIOR TO REPRODUCTION. DO NOT SCALE FROM THIS DRAWING.

ASSOCIATED CONSULTANTS

BIOME WATER AND ENVIRONMENTAL CONSULTING
Robin Russell & ASSOCIATES PTY. LTD.
BENNETT + BENNETT

DRAWING TITLE

LONGITUDINAL SECTIONS ROAD 03

MORTONS urbansolutions
Urban & Regional Planning
Civil Engineering
Project Coordination
MUS Pty Ltd T/As:
Mortons-Urban Solutions
ABN: 39 116 375 065
mortons@urbansolutions.net.au
www.urbansolutions.net.au
Tel 07 5571 1099
Postal Address
PO Box 2484
Southport QLD 4215
Gold Coast Office
Suite 9, 19 Short St
Southport QLD 4215

DESIGNED RB | DRAWN EP
APPROVED [signature] | RPEQ 4706 | DATE 13-10-23

DRAWING NUMBER 41901-02-202 | REV A


F:\Autocad Client\419 - HB Land\01 - Courtney Drive\Precinct-Stage 02\Engineering Drawings\Current\41901-02-200.dwg, ROAD 03, 21/06/2024 1:23:26 PM, 1:2

PLANS AND DOCUMENTS referred to in the DEVELOPMENT APPROVAL

Application No: MIN/2024/337


Dated: 16 July 2024

Development shall comply with the conditions of approval as detailed in the Decision Notice and Council's Planning Scheme, Local Laws and Planning Policies

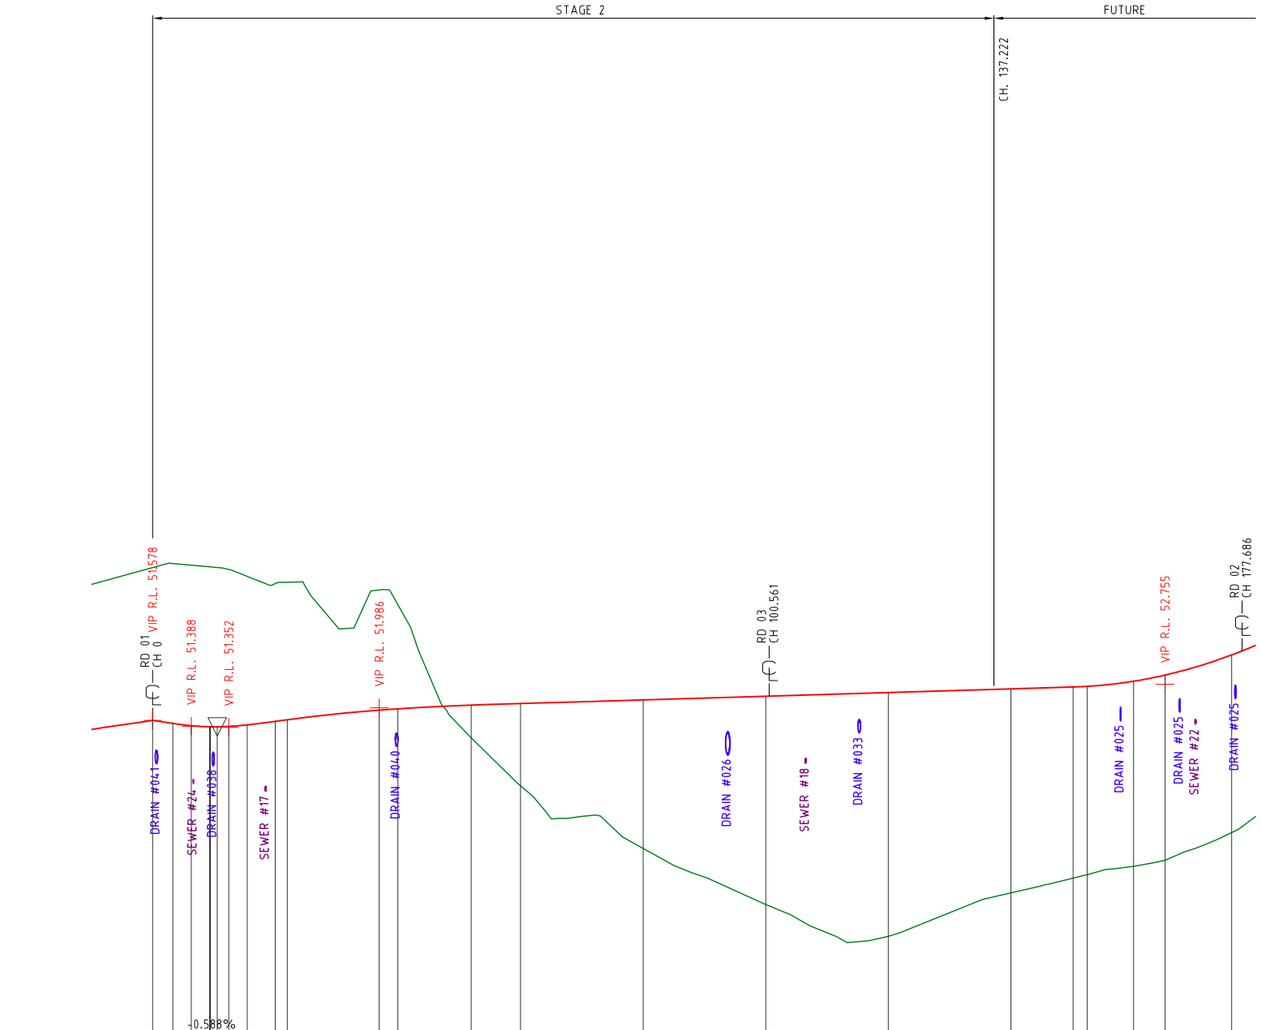

CHAINAGE	CONTROL LINE LEVELS	EXISTING SURFACE	DEPTH
0	51.578	56.559	4.982
3.3	51.478	56.692	5.214
6.3	51.406	56.638	5.232
9.3	51.37	56.584	5.213
9.422	51.37	56.582	5.212
10.535	51.366	56.562	5.195
12.422	51.376	56.496	5.121
15.422	51.429	56.272	4.843
20	51.548	56.035	4.487
21.964	51.599	56.082	4.483
36.964	51.912	55.832	3.92
40	51.957	55.351	3.394
51.964	52.076	51.008	-1.068
60	52.124	49.445	-2.679
80	52.244	47.402	-4.842
100	52.364	45.576	-6.788
120	52.484	44.539	-7.945
140	52.604	45.953	-6.652
150.127	52.665	46.436	-6.229
152.428	52.686	46.549	-6.137
160	52.854	46.819	-6.035
165.127	53.055	47.015	-6.039
175.989	53.711	47.917	-5.793
180	54.033	48.457	-5.575

LONGITUDINAL SECTION ROAD 04

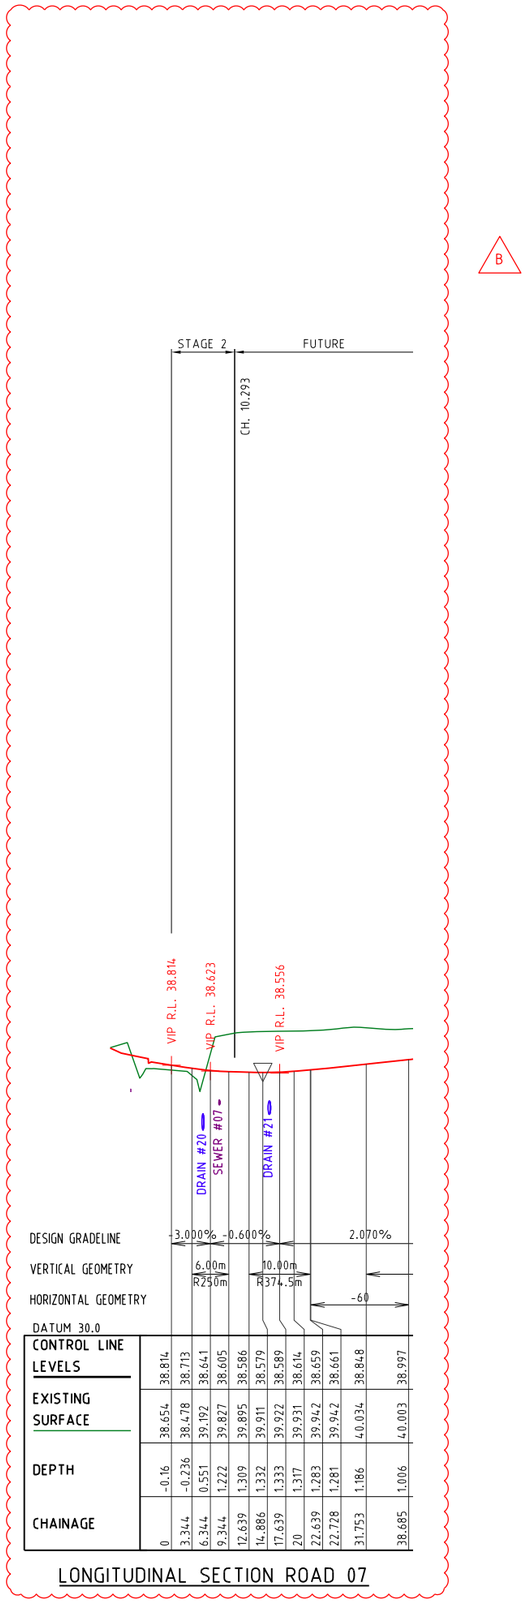

CHAINAGE	CONTROL LINE LEVELS	EXISTING SURFACE	DEPTH
0	38.814	38.654	-0.16
3.344	38.713	38.478	-0.236
6.344	38.641	39.192	0.551
9.344	38.605	39.827	1.222
12.639	38.586	39.895	1.309
14.886	38.579	39.911	1.332
17.639	38.589	39.922	1.333
20	38.614	39.931	1.317
22.639	38.659	39.942	1.283
22.728	38.661	39.942	1.281
31.753	38.848	40.034	1.186
38.685	38.997	40.003	1.006

LONGITUDINAL SECTION ROAD 07

PROJECT NAME

COURTNEY DR UPPER COOMERA

STAGE 02

RP DESCRIPTION

LOT 188, 189, 190, 191 & 192 ON RP173728
COURTNEY DRIVE
LOCALITY OF UPPER COOMERA
LOCAL AUTHORITY - GOLD COAST CITY COUNCIL

CLIENT

HB Land

0 5 10 15 20 25m
Horiz. Scale 1:500 - A1 (1:1000 - A3)

0 1 2 3 4 5m
Vert. Scale 1:100 - A1 (1:200 - A3)

REV	DATE	DESCRIPTION	INT
B	15-01-24	LONG SECTION AMENDED	BL
A	13-10-23	COUNCIL ISSUE	EP

COPYRIGHT IS VESTED IN MORTONS-URBAN SOLUTIONS AND WRITTEN CONSENT IS REQUIRED PRIOR TO REPRODUCTION. DO NOT SCALE FROM THIS DRAWING.

ASSOCIATED CONSULTANTS

BIOME WATER AND ENVIRONMENTAL CONSULTING
Robin Russell & ASSOCIATES PTY. LTD.
BENNETT + BENNETT

DRAWING TITLE

LONGITUDINAL SECTIONS
ROAD 04
&
ROAD 07

MORTONS urbansolutions
Urban & Regional Planning
Civil Engineering
Project Coordination
MUS Pty Ltd T/As:
Mortons-Urban Solutions
ABN: 39 116 375 065
mortons@urbansolutions.net.au
www.urbansolutions.net.au
Tel 07 5571 1099
Postal Address
PO Box 2484
Southport QLD 4215
Gold Coast Office
Suite 9, 19 Short St
Southport QLD 4215

DESIGNED	RB	DRAWN	EP
APPROVED	RPEQ 4706	DATE	13-10-23

DRAWING NUMBER: 41901-02-203
REV: B


F:\Autocad Client\419 - HB Land\01 - Courtney Drive\Precinct-Stage 02\Engineering Drawings\Current\41901-02-200.dwg, ROAD 04 & ROAD 07, 21/06/2024 1:23:26 PM, 1:2

PLANS AND DOCUMENTS referred to in the DEVELOPMENT APPROVAL

Application No: MIN/2024/337


Dated: 16 July 2024

Development shall comply with the conditions of approval as detailed in the Decision Notice and Council's Planning Scheme, Local Laws and Planning Policies

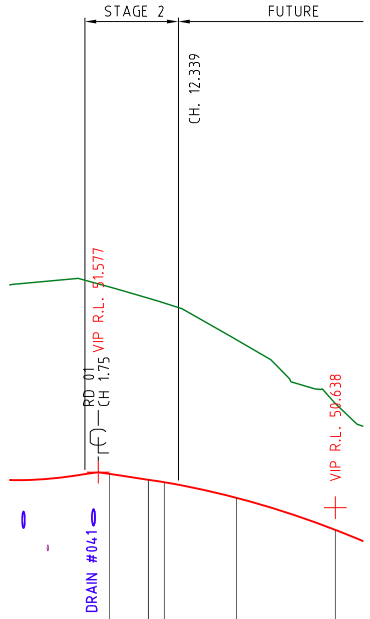

DESIGN GRADELINE	-3.000%					
VERTICAL GEOMETRY	49.40m R520m					
HORIZONTAL GEOMETRY	-85					
DATUM 32.0						
CONTROL LINE LEVELS		51.532	51.379	51.312	50.9	50.051
EXISTING SURFACE	56.655	56.475	56.183	56.055	55.082	53.394
DEPTH		4.944	4.805	4.743	4.182	3.343
CHAINAGE	0	3.277	8.374	10.464	20	33.074

LONGITUDINAL SECTION ROAD 10

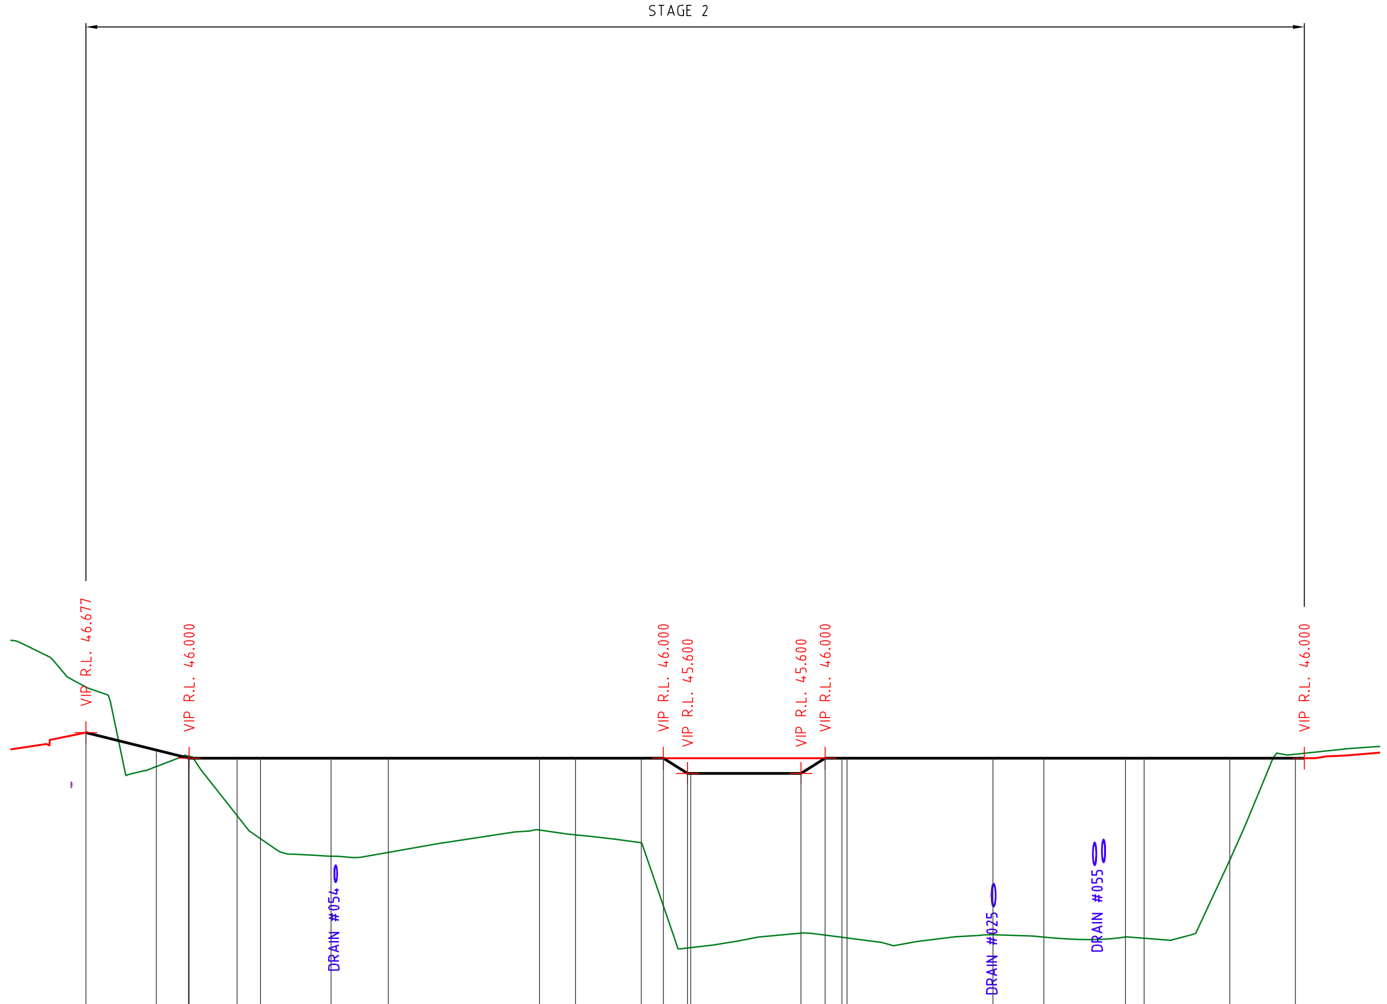

DESIGN GRADELINE	-4.966%, 0.000%, -12.500%, 0.000%, 12.500%, 0.000%
VERTICAL GEOMETRY	
HORIZONTAL GEOMETRY	10, -10, 23, 33, -19.2, -16
DATUM 34.0	

CHAINAGE	CONTROL LINE LEVELS	EXISTING SURFACE	DEPTH
0	46.677	47.886	1.209
9.318	46.215	45.78	-0.435
13.562	46.004	46.056	0.052
13.641	46	46.052	0.052
20	46	44.481	-1.519
23.09	46	43.87	-2.13
32.419	46	43.406	-2.594
40	46	43.509	-2.491
60	46	44.102	-1.898
64.769	46	43.972	-2.028
73.472	46	43.76	-2.24
76.383	46	42.094	-3.906
79.583	45.6	40.98	-4.62
80	45.6	40.99	-4.61
94.583	45.6	41.374	-4.226
97.783	46	41.322	-4.678
100	46	41.266	-4.734
100.695	46	41.248	-4.752
120	46	41.329	-4.671
126.728	46	41.267	-4.733
137.523	46	41.273	-4.727
140	46	41.236	-4.764
151.324	46	43.306	-2.694
160	46	46.107	0.107
161.209		46.132	

LONGITUDINAL SECTION ACCESS BASIN 01

PROJECT NAME

COURTNEY DR UPPER COOMERA

STAGE 02

RP DESCRIPTION

LOT 188, 189, 190, 191 & 192 ON RP173728
COURTNEY DRIVE
LOCALITY OF UPPER COOMERA
LOCAL AUTHORITY - GOLD COAST CITY COUNCIL

CLIENT

HB Land

0 5 10 15 20 25m
Horiz. Scale 1:500 - A1 (1:1000 - A3)

0 1 2 3 4 5m
Vert. Scale 1:100 - A1 (1:200 - A3)

REV	DATE	DESCRIPTION	INT
A	13-10-23	COUNCIL ISSUE	EP

COPYRIGHT IS VESTED IN MORTONS-URBAN SOLUTIONS AND WRITTEN CONSENT IS REQUIRED PRIOR TO REPRODUCTION. DO NOT SCALE FROM THIS DRAWING.

ASSOCIATED CONSULTANTS

BIOME WATER AND ENVIRONMENTAL CONSULTING
Robin Russell & ASSOCIATES PTY. LTD.
BENNETT + BENNETT

DRAWING TITLE

LONGITUDINAL SECTIONS
ROAD 10
&
ACCESS BASIN 01

MORTONS urbansolutions
Urban & Regional Planning
Civil Engineering
Project Coordination
MUS Pty Ltd T/As:
Mortons-Urban Solutions
ABN: 39 116 375 065
Postal Address
PO Box 2484
Southport QLD 4215
mortons@urbansolutions.net.au
www.urbansolutions.net.au
Tel 07 5571 1099
Gold Coast Office
Suite 9, 19 Short St
Southport QLD 4215

DESIGNED RB | DRAWN EP
APPROVED [signature] | RPEQ 4706 | DATE 13-10-23

DRAWING NUMBER 41901-02-204 | REV A


F:\Autocad Client\419 - HB Land\01 - Courtney Drive\Precinct-Stage 02\Engineering Drawings\Current\41901-02-200.dwg, ROAD 10 & ACCESS BASIN 01, 21/06/2024 1:23:27 PM, 1:2

PLANS AND DOCUMENTS referred to in the DEVELOPMENT APPROVAL


Application No: MIN/2024/337

Dated: 16 July 2024


Development shall comply with the conditions of approval as detailed in the Decision Notice and Council's Planning Scheme, Local Laws and Planning Policies

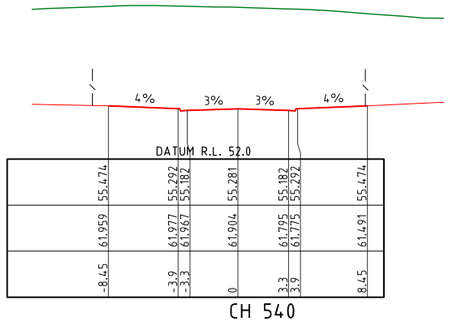


CH 540

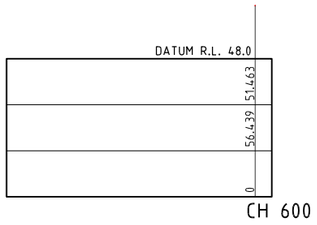


CH 600

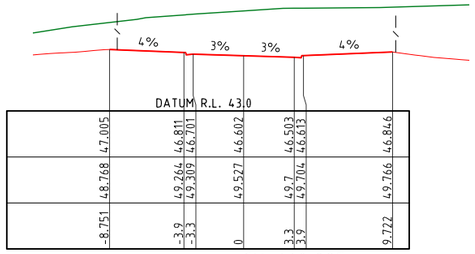


CH 660.985

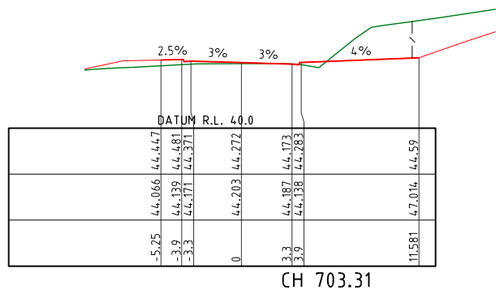


CH 703.31

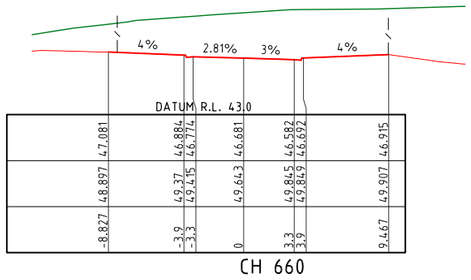


CH 660

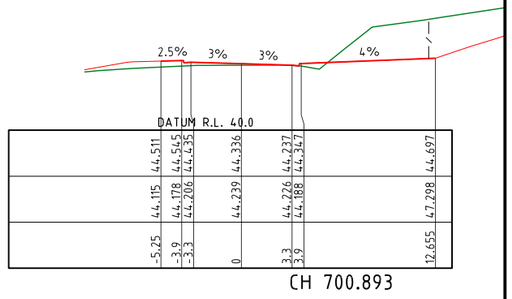


CH 700.893

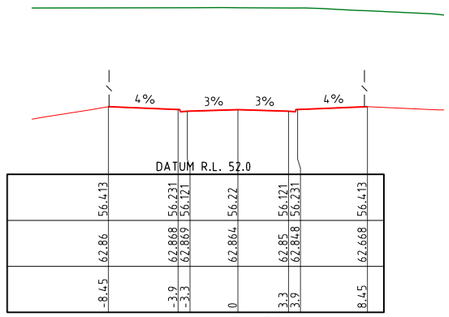


CH 520

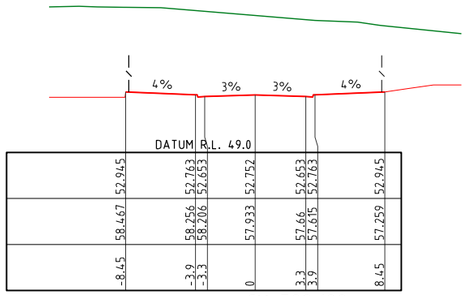


CH 582.199

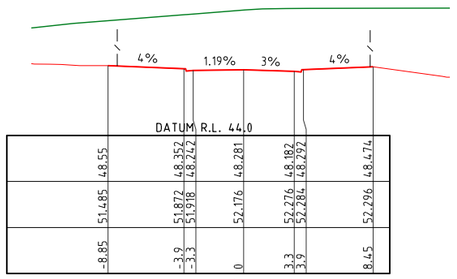


CH 640

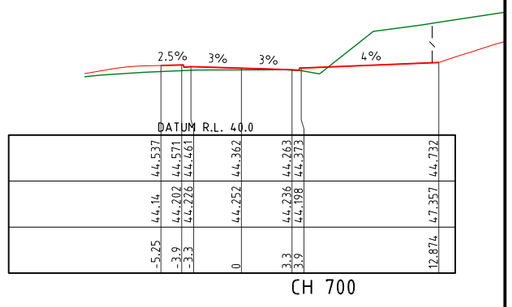


CH 700

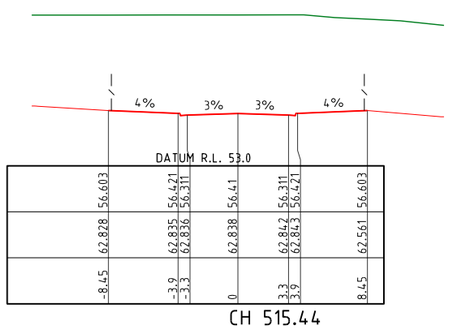


CH 515.44

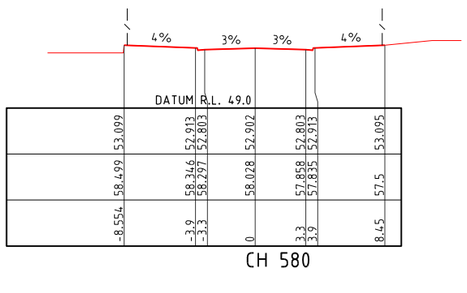


CH 580

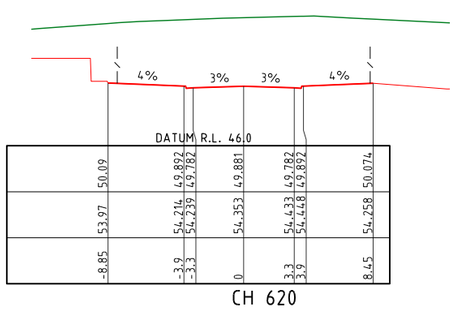


CH 620

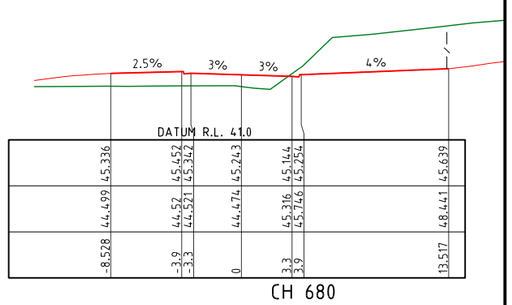


CH 680

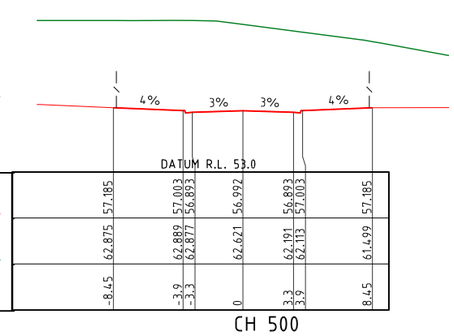


CH 500

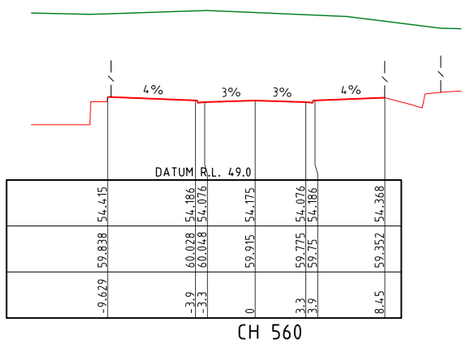

CH 560

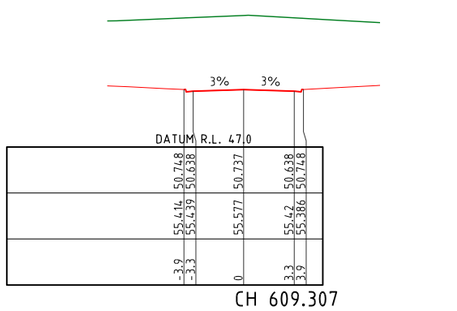

CH 609.307

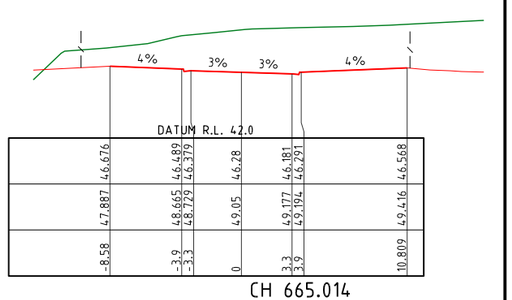

CH 665.014

NOTES:

1. REFER TO 080 SERIES FINAL SURFACE PLAN DWGS FOR EARTHWORKS BEYOND ROAD RESERVE.

2. CROSS SECTIONS WITH NO TEMPLATE REPRESENT CONTROL LINE LEVELS AT THAT CHAINAGE.

DESIGN SURFACE LEVEL

EXISTING SURFACE LEVEL

OFFSET

COURTNEY DRIVE/ROAD 01

PROJECT NAME

COURTNEY DR UPPER COOMERA

STAGE 02

RP DESCRIPTION

LOT 188, 189, 190, 191 & 192 ON RP173728
COURTNEY DRIVE
LOCALITY OF UPPER COOMERA
LOCAL AUTHORITY - GOLD COAST CITY COUNCIL

CLIENT

HB Land

0 2 4 6 8 10m
Scale 1:200 - A1 (1:400 - A3)

REV	DATE	DESCRIPTION	INT
A	13-10-23	COUNCIL ISSUE	EP

COPYRIGHT IS VESTED IN MORTONS-URBAN SOLUTIONS AND WRITTEN CONSENT IS REQUIRED PRIOR TO REPRODUCTION.
DO NOT SCALE FROM THIS DRAWING.

ASSOCIATED CONSULTANTS

BIOME WATER AND ENVIRONMENTAL CONSULTING

Robin Russell & ASSOCIATES PTY. LTD.

BENNETT + BENNETT

DRAWING TITLE

CROSS SECTIONS
COURTNEY DRIVE/ROAD 01
SHEET 01

MORTONS urbansolutions
Urban & Regional Planning
Civil Engineering
Project Coordination

MUS Pty Ltd T/As
Mortons-Urban Solutions
ABN: 39 116 375 065
mortons@urbansolutions.net.au
www.urbansolutions.net.au
Tel 07 5571 1099

Postal Address
PO Box 2484
Southport QLD 4215

Gold Coast Office
Suite 9, 19 Short St
Southport QLD 4215

DESIGNED	RB	DRAWN	EP
APPROVED	RPEQ 4706	DATE	13-10-23

DRAWING NUMBER: 41901-02-300

REV: A


F:\Autocad Client\419 - HB Land\01 - Courtney Drive\Precinct-Stage 02\Engineering Drawings\Current\41901-02-300.dwg, COURTNEY DRIVE-ROAD 01 SHEET 01, 21/06/2024 1:23:31 PM, 1:2


PLANS AND DOCUMENTS referred to in the DEVELOPMENT APPROVAL


Application No: MIN/2024/337


Dated: 16 July 2024


Development shall comply with the conditions of approval as detailed in the Decision Notice and Council's Planning Scheme, Local Laws and Planning Policies

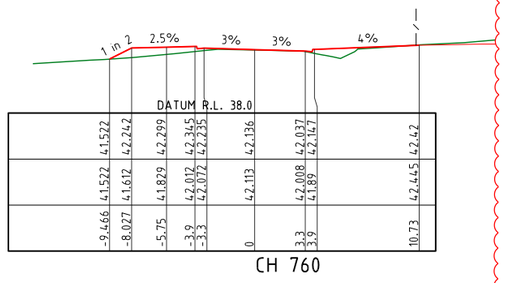


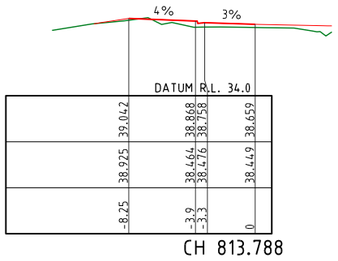

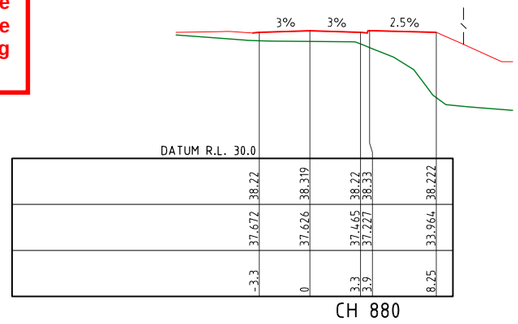


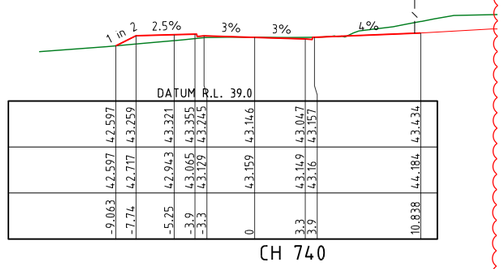


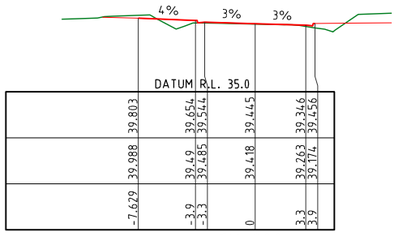


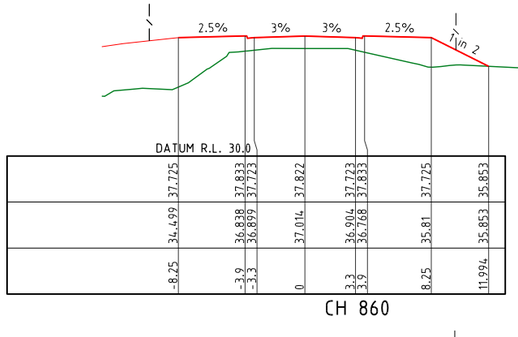



B

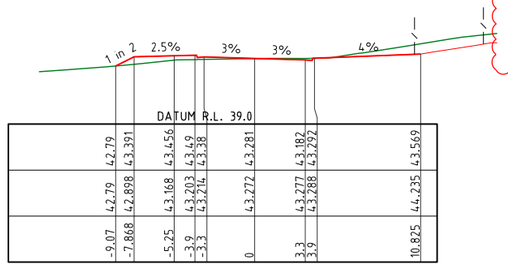


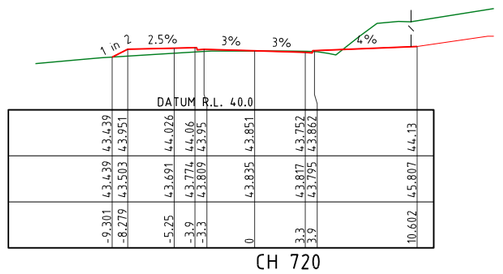


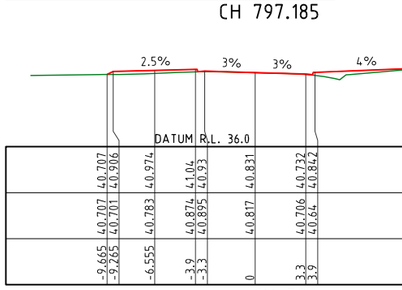

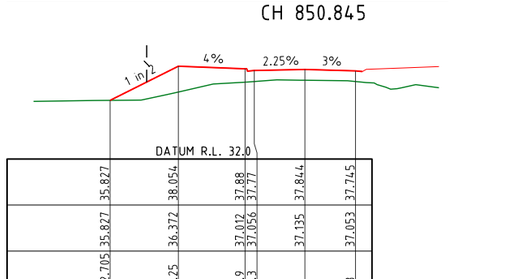

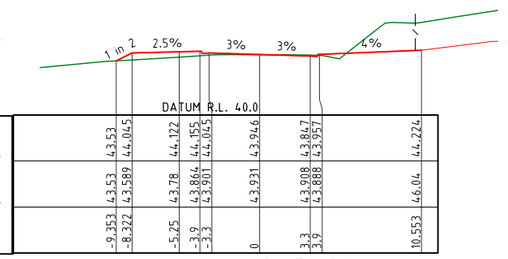

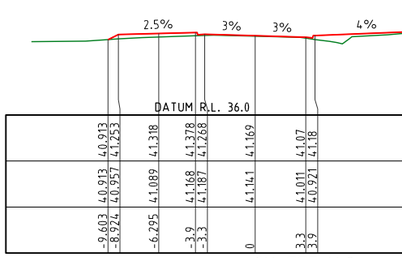

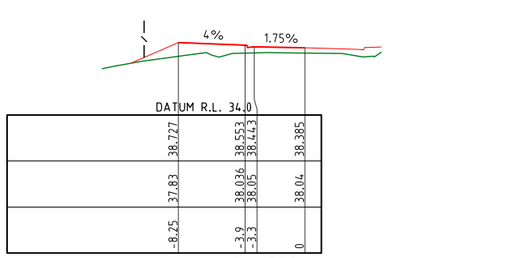

NOTES:

1. REFER TO 080 SERIES FINAL SURFACE PLAN DWGS FOR EARTHWORKS BEYOND ROAD RESERVE.

2. CROSS SECTIONS WITH NO TEMPLATE REPRESENT CONTROL LINE LEVELS AT THAT CHAINAGE.

DESIGN SURFACE LEVEL
EXISTING SURFACE LEVEL
OFFSET

COURTNEY DRIVE/ROAD 01 (Cont.)

PROJECT NAME

COURTNEY DR UPPER COOMERA

STAGE 02

RP DESCRIPTION

LOT 188, 189, 190, 191 & 192 ON RP173728
COURTNEY DRIVE
LOCALITY OF UPPER COOMERA
LOCAL AUTHORITY - GOLD COAST CITY COUNCIL

CLIENT

HB Land

0 2 4 6 8 10m
Scale 1:200 - A1 (1:400 - A3)

REV	DATE	DESCRIPTION	INT
B	15-01-24	CROSS SECTIONS AMENDED	BL
A	13-10-23	COUNCIL ISSUE	EP

COPYRIGHT IS VESTED IN MORTONS-URBAN SOLUTIONS AND WRITTEN CONSENT IS REQUIRED PRIOR TO REPRODUCTION. DO NOT SCALE FROM THIS DRAWING.

ASSOCIATED CONSULTANTS

BIOME WATER AND ENVIRONMENTAL CONSULTING
Robin Russell & ASSOCIATES PTY. LTD.
BENNETT + BENNETT

DRAWING TITLE

CROSS SECTIONS
COURTNEY DRIVE/ROAD 01 (Cont.)
SHEET 02


MORTONS urbansolutions
Urban & Regional Planning
Civil Engineering
Project Coordination
MUS Pty Ltd T/As
Mortons-Urban Solutions
ABN: 39 116 375 065
mortons@urbansolutions.net.au
www.urbansolutions.net.au
Tel 07 5571 1099
Postal Address
PO Box 2484
Southport QLD 4215
Gold Coast Office
Suite 9, 19 Short St
Southport QLD 4215


DESIGNED RB	DRAWN EP
APPROVED RPEQ 4706	DATE 13-10-23


DRAWING NUMBER 41901-02-301


REV B


F:\Autocad Client\419 - HB Land\01 - Courtney Drive\Precinct-Stage 02\Engineering Drawings\Current\41901-02-300.dwg, COURTNEY DRIVE-ROAD 01 (Cont.) SHEET 02, 21/06/2024 1:23:32 PM, 12

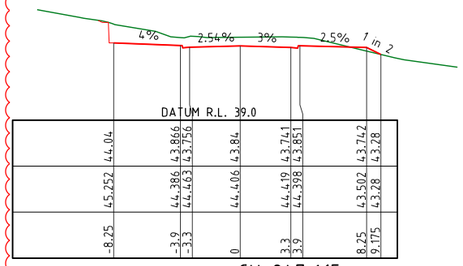


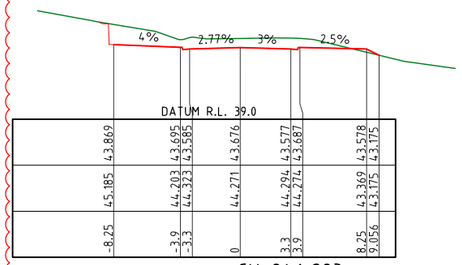


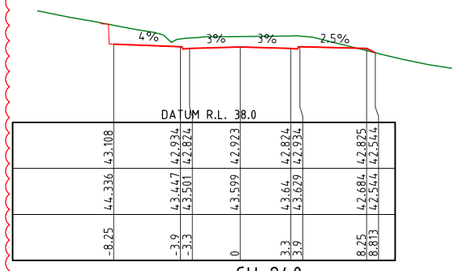


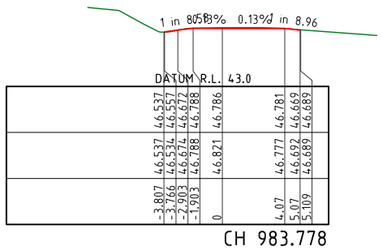


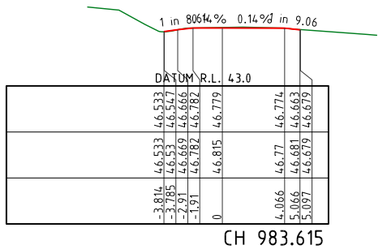

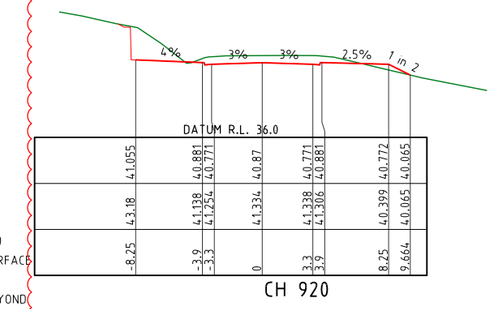

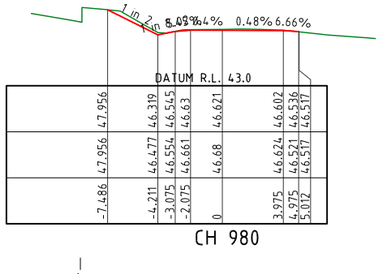

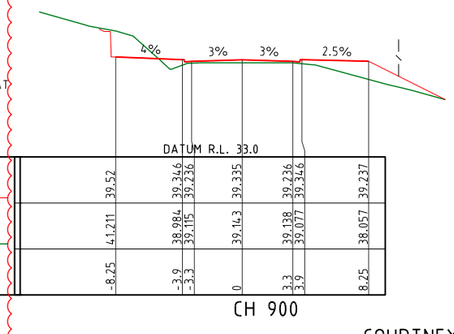

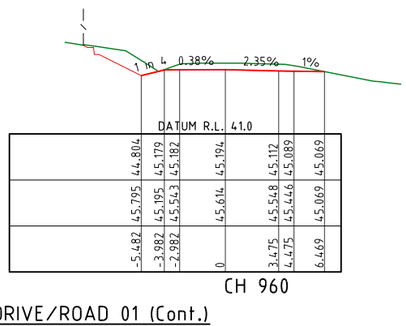

NOTES:

1. REFER TO 080 SERIES FINAL SURFACE PLAN DWGS FOR EARTHWORKS BEYOND ROAD RESERVE.

2. CROSS SECTIONS WITH NO TEMPLATE REPRESENT CONTROL LINE LEVELS AT THAT CHAINAGE.

COURTNEY DRIVE/ROAD 01 (Cont.)

C

PLANS AND DOCUMENTS referred to in the DEVELOPMENT APPROVAL

Application No: MIN/2024/337

Dated: 16 July 2024

Development shall comply with the conditions of approval as detailed in the Decision Notice and Council's Planning Scheme, Local Laws and Planning Policies

PROJECT NAME

COURTNEY DR UPPER COOMERA

STAGE 02

RP DESCRIPTION

LOT 188, 189, 190, 191 & 192 ON RP173728
COURTNEY DRIVE
LOCALITY OF UPPER COOMERA
LOCAL AUTHORITY - GOLD COAST CITY COUNCIL

CLIENT

HB Land

0 2 4 6 8 10m
Scale 1:200 - A1 (1:400 - A3)

REV	DATE	DESCRIPTION	INT
C	14-06-24	CROSS SECTIONS AMENDED	RK
B	15-01-24	CROSS SECTIONS AMENDED	BL
A	13-10-23	COUNCIL ISSUE	EP

COPYRIGHT IS VESTED IN MORTONS-URBAN SOLUTIONS AND WRITTEN CONSENT IS REQUIRED PRIOR TO REPRODUCTION. DO NOT SCALE FROM THIS DRAWING.

ASSOCIATED CONSULTANTS

BIOME WATER AND ENVIRONMENTAL CONSULTING
Robin Russell & ASSOCIATES PTY. LTD.
BENNETT+BENNETT

DRAWING TITLE

CROSS SECTIONS
COURTNEY DRIVE/ROAD 01 (Cont.)
SHEET 03

MORTONS urbansolutions
Urban & Regional Planning
Civil Engineering
Project Coordination
MUS Pty Ltd T/As:
Mortons-Urban Solutions
ABN: 39 116 375 065
mortons@urbansolutions.net.au
www.urbansolutions.net.au
Tel 07 5571 1099
Postal Address
PO Box 2484
Southport QLD 4215
Gold Coast Office
Suite 9, 19 Short St
Southport QLD 4215

DESIGNED	RB	DRAWN	EP
APPROVED	RPEQ 4706	DATE	13-10-23

DRAWING NUMBER 41901-02-302

REV C


F:\Autocad Client\419 - HB Land\01 - Courtney Drive\Precinct-Stage 02\Engineering Drawings\Current\41901-02-300.dwg, COURTNEY DRIVE-ROAD 01 (Cont.), SHEET 03, 21/06/2024 1:22:33 PM, 1:2


PLANS AND DOCUMENTS referred to in the DEVELOPMENT APPROVAL


Application No: MIN/2024/337


Dated: 16 July 2024


Development shall comply with the conditions of approval as detailed in the Decision Notice and Council's Planning Scheme, Local Laws and Planning Policies

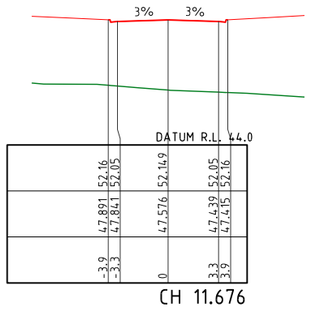


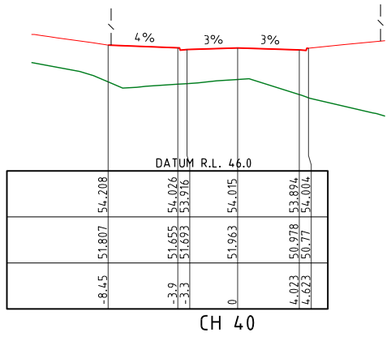


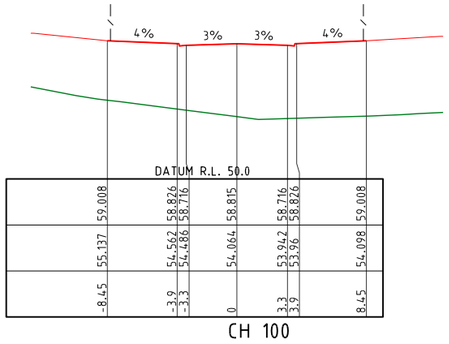


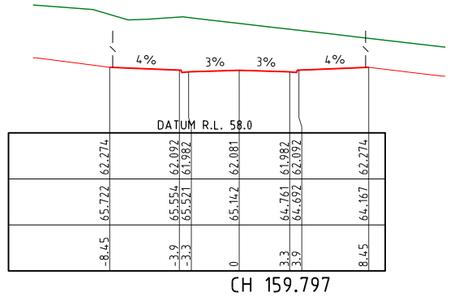


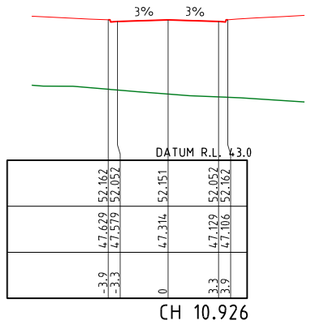


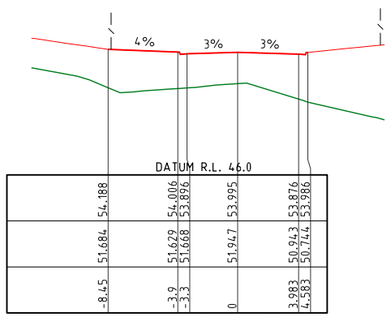


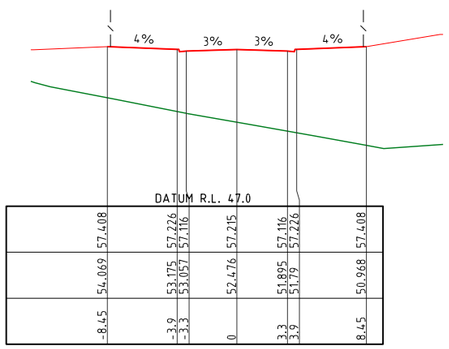


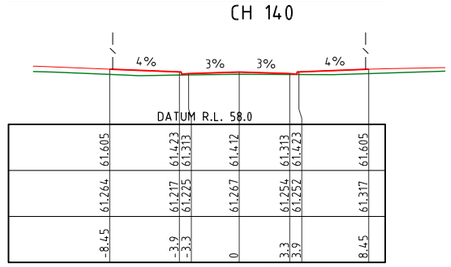


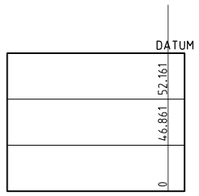


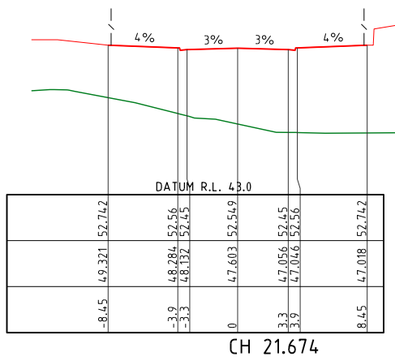


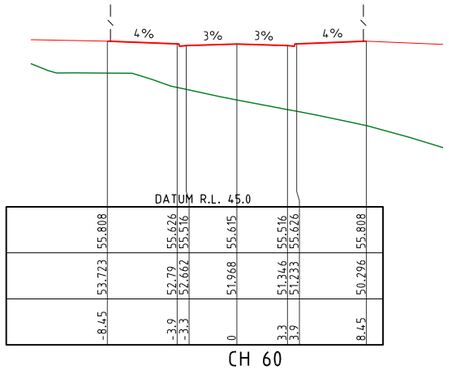


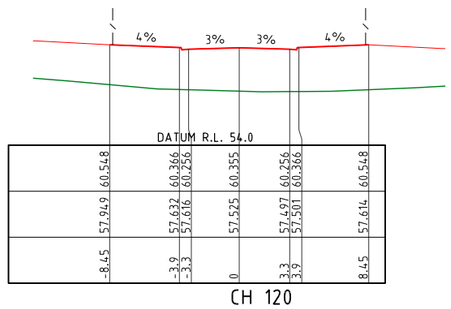

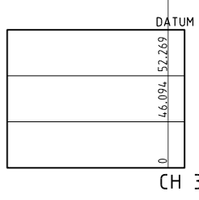

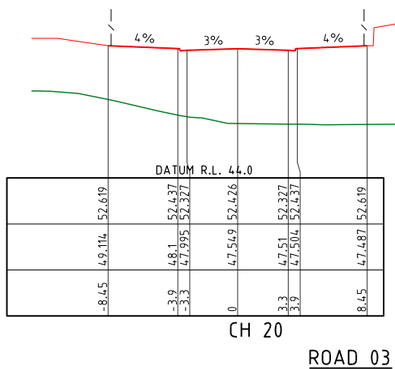


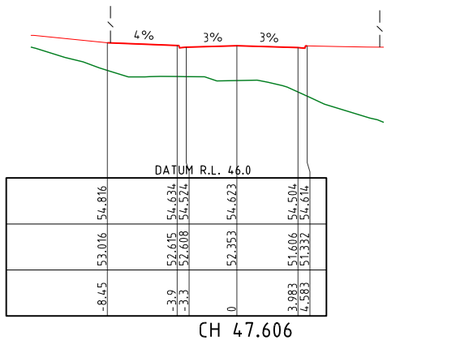

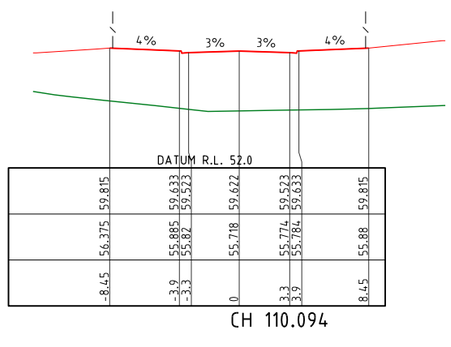

NOTES:

1. REFER TO 080 SERIES FINAL SURFACE PLAN DWGS FOR EARTHWORKS BEYOND ROAD RESERVE.
2. CROSS SECTIONS WITH NO TEMPLATE REPRESENT CONTROL LINE LEVELS AT THAT CHAINAGE.

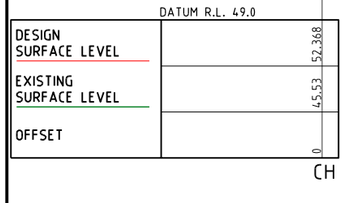

ROAD 03

PROJECT NAME

COURTNEY DR UPPER COOMERA

STAGE 02

RP DESCRIPTION

LOT 188, 189, 190, 191 & 192 ON RP173728
COURTNEY DRIVE
LOCALITY OF UPPER COOMERA
LOCAL AUTHORITY - GOLD COAST CITY COUNCIL

CLIENT

HB Land

0 2 4 6 8 10m
Scale 1:200 - A1 (1:400 - A3)

REV	DATE	DESCRIPTION	INT
A	13-10-23	COUNCIL ISSUE	EP

COPYRIGHT IS VESTED IN MORTONS-URBAN SOLUTIONS AND WRITTEN CONSENT IS REQUIRED PRIOR TO REPRODUCTION. DO NOT SCALE FROM THIS DRAWING.

ASSOCIATED CONSULTANTS

BIOME WATER AND ENVIRONMENTAL CONSULTING
Robin Russell & ASSOCIATES PTY. LTD.
BENNETT+BENNETT

DRAWING TITLE

CROSS SECTIONS
ROAD 03
SHEET 01

MORTONS urbansolutions
Urban & Regional Planning
Civil Engineering
Project Coordination
MUS Pty Ltd T/As
Mortons-Urban Solutions
ABN 39 116 375 065
mortons@urbansolutions.net.au
www.urbansolutions.net.au
Tel 07 5571 1099
Postal Address
PO Box 2484
Southport QLD 4215
Gold Coast Office
Suite 9, 19 Short St
Southport QLD 4215

DESIGNED	RB	DRAWN	EP
APPROVED		RPEQ 4706	DATE 13-10-23

DRAWING NUMBER 41901-02-303

REV A


F:\Autocad Client\419 - HB Land\01 - Courtney Drive\Precinct-Stage 02\Engineering Drawings\Current\41901-02-300.dwg, ROAD 03 SHEET 01, 21/06/2024 1:23:34 PM, 1:2


PLANS AND DOCUMENTS referred to in the DEVELOPMENT APPROVAL


Application No: MIN/2024/337


Dated: 16 July 2024


Development shall comply with the conditions of approval as detailed in the Decision Notice and Council's Planning Scheme, Local Laws and Planning Policies

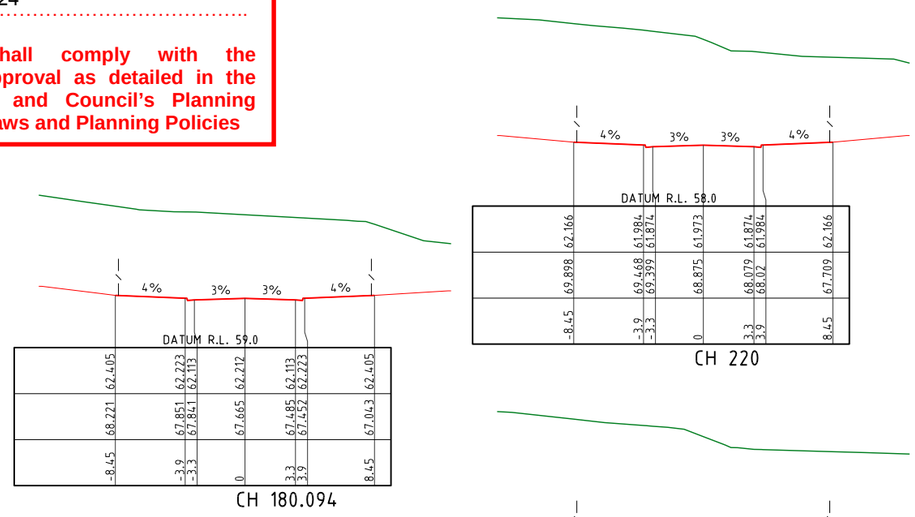

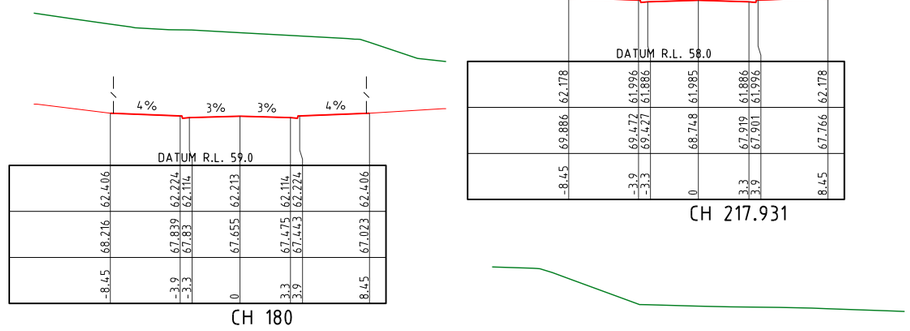

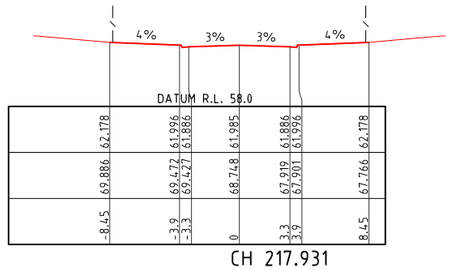

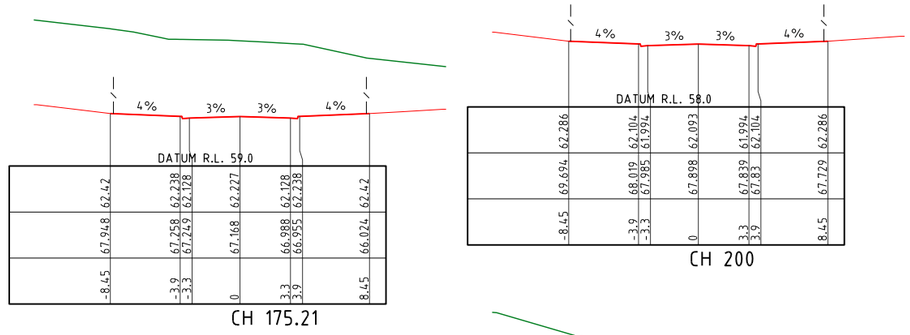

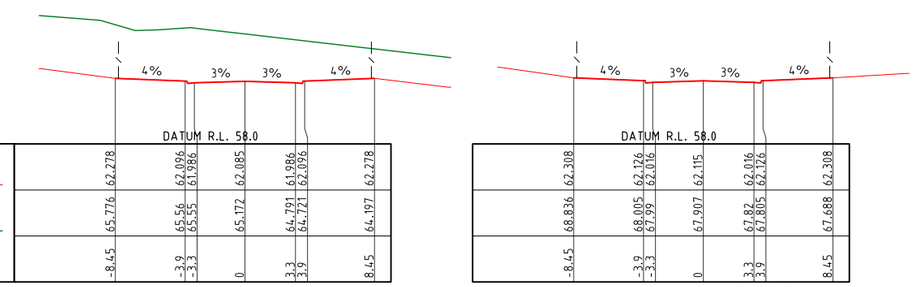

NOTES:

1. REFER TO 080 SERIES FINAL SURFACE PLAN DWGS FOR EARTHWORKS BEYOND ROAD RESERVE.

2. CROSS SECTIONS WITH NO TEMPLATE REPRESENT CONTROL LINE LEVELS AT THAT CHAINAGE.

ROAD 03 (Cont.)

PROJECT NAME

COURTNEY DR UPPER COOMERA

STAGE 02

RP DESCRIPTION

LOT 188, 189, 190, 191 & 192 ON RP173728
COURTNEY DRIVE
LOCALITY OF UPPER COOMERA
LOCAL AUTHORITY - GOLD COAST CITY COUNCIL

CLIENT

HB Land

0 2 4 6 8 10m
Scale 1:200 - A1 (1:400 - A3)

REV	DATE	DESCRIPTION	INT
A	13-10-23	COUNCIL ISSUE	EP

COPYRIGHT IS VESTED IN MORTONS-URBAN SOLUTIONS AND WRITTEN CONSENT IS REQUIRED PRIOR TO REPRODUCTION. DO NOT SCALE FROM THIS DRAWING.

ASSOCIATED CONSULTANTS

BIOME WATER AND ENVIRONMENTAL CONSULTING
Robin Russell & ASSOCIATES PTY. LTD.
BENNETT + BENNETT

DRAWING TITLE

CROSS SECTIONS
ROAD 03 (Cont.)
SHEET 02

MORTONS urbansolutions
Urban & Regional Planning
Civil Engineering
Project Coordination
MUS Pty Ltd T/As:
Mortons-Urban Solutions
ABN: 39 116 375 065
mortons@urbansolutions.net.au
www.urbansolutions.net.au
Tel 07 5571 1099
Postal Address
PO Box 2484
Southport QLD 4215
Gold Coast Office
Suite 9, 19 Short St
Southport QLD 4215

DESIGNED	RB	DRAWN	EP
APPROVED	RPEQ 4706	DATE	13-10-23

DRAWING NUMBER 41901-02-304

REV A


F:\Autocad Client\419 - HB Land\01 - Courtney Drive\Precinct-Stage 02\Engineering Drawings\Current\41901-02-300.dwg, ROAD 03 (Cont.), SHEET 02, 21/06/2024 1:23:35 PM, 1:2


PLANS AND DOCUMENTS referred to in the DEVELOPMENT APPROVAL


Application No: MIN/2024/337


Dated: 16 July 2024


Development shall comply with the conditions of approval as detailed in the Decision Notice and Council's Planning Scheme, Local Laws and Planning Policies

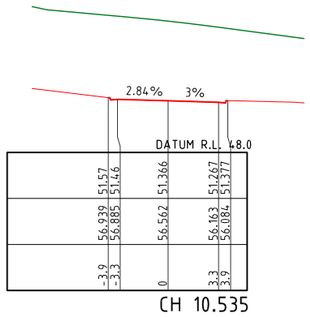


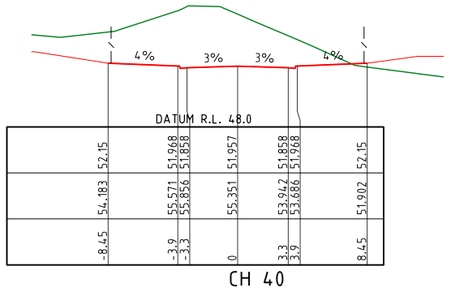


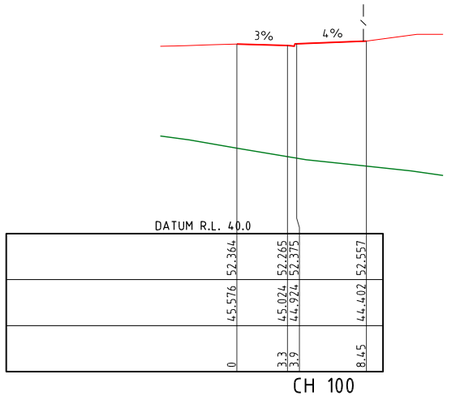


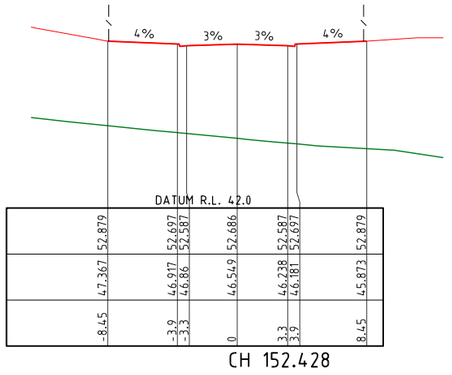


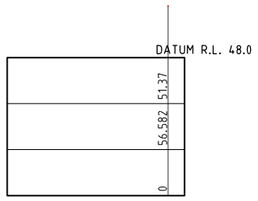


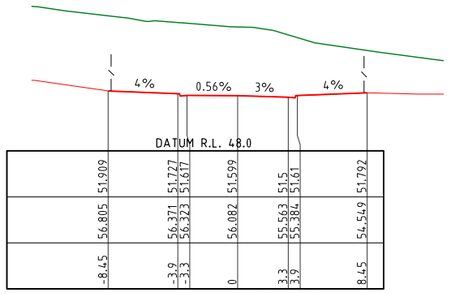


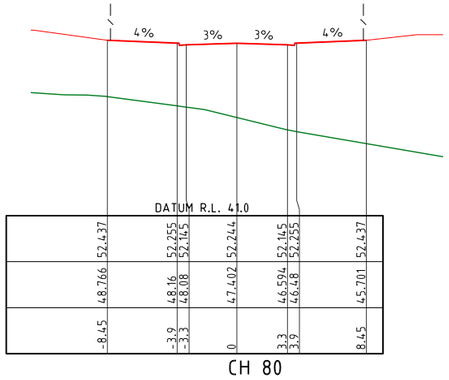


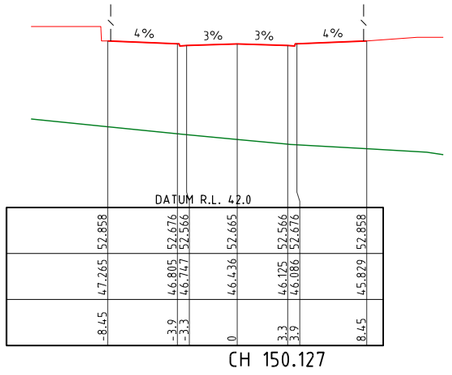


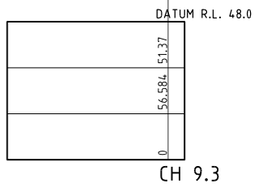

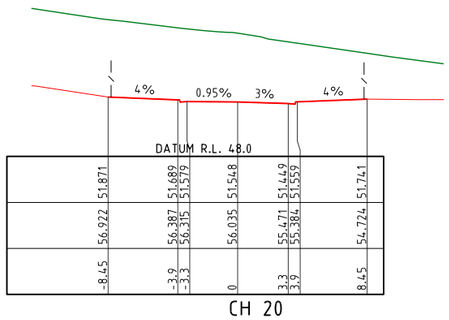

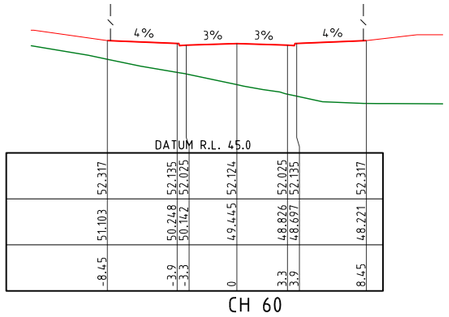

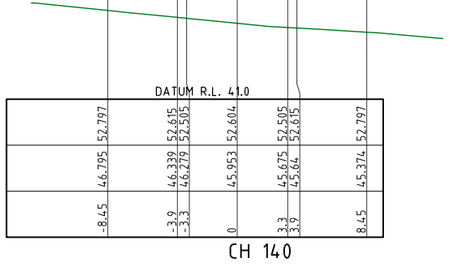


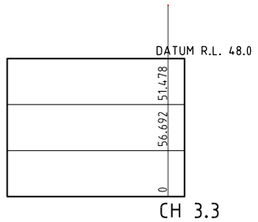



NOTES:


1. REFER TO 080 SERIES FINAL SURFACE PLAN DWGS FOR EARTHWORKS BEYOND ROAD RESERVE.

2. CROSS SECTIONS WITH NO TEMPLATE REPRESENT CONTROL LINE LEVELS AT THAT CHAINAGE.

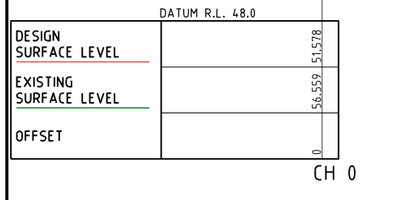

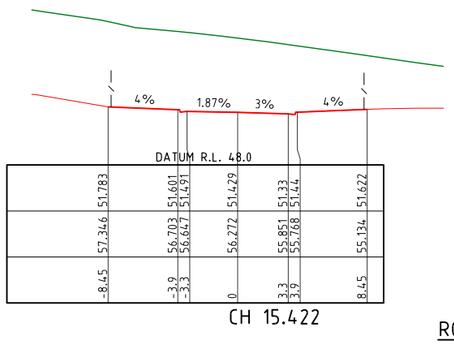

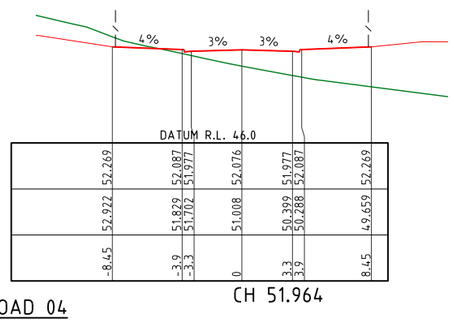

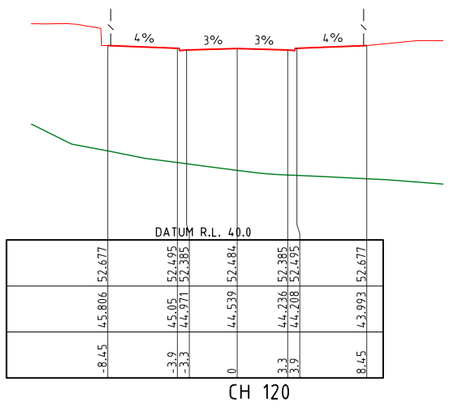

ROAD 04

PROJECT NAME

COURTNEY DR UPPER COOMERA

STAGE 02

RP DESCRIPTION

LOT 188, 189, 190, 191 & 192 ON RP173728
COURTNEY DRIVE
LOCALITY OF UPPER COOMERA
LOCAL AUTHORITY - GOLD COAST CITY COUNCIL

CLIENT

HB Land

0 2 4 6 8 10m
Scale 1:200 - A1 (1:400 - A3)

REV	DATE	DESCRIPTION	INT
A	13-10-23	COUNCIL ISSUE	EP

COPYRIGHT IS VESTED IN MORTONS-URBAN SOLUTIONS AND WRITTEN CONSENT IS REQUIRED PRIOR TO REPRODUCTION. DO NOT SCALE FROM THIS DRAWING.

ASSOCIATED CONSULTANTS

BIOME WATER AND ENVIRONMENTAL CONSULTING

Robin Russell & ASSOCIATES PTY. LTD.

BENNETT+BENNETT

DRAWING TITLE

CROSS SECTIONS
ROAD 04

MORTONS urbansolutions
Urban & Regional Planning
Civil Engineering
Project Coordination

MUS Pty Ltd T/As:
Mortons-Urban Solutions
ABN: 39 116 375 065

mortons@urbansolutions.net.au
www.urbansolutions.net.au
Tel 07 5571 1099

Postal Address
PO Box 2484
Southport QLD 4215

Gold Coast Office
Suite 9, 19 Short St
Southport QLD 4215

DESIGNED	RB	DRAWN	EP
APPROVED	RPEQ 4706	DATE	13-10-23

DRAWING NUMBER 41901-02-305

REV A

F:\Autocad Client\419 - HB Land\01 - Courtney Drive\Precinct-Stage 02\Engineering Drawings\Current\41901-02-300.dwg, ROAD 04, 21/06/2024 12:35:36 PM, 1:2


PLANS AND DOCUMENTS referred to in the DEVELOPMENT APPROVAL


Application No: MIN/2024/337

Dated: 16 July 2024

Development shall comply with the conditions of approval as detailed in the Decision Notice and Council's Planning Scheme, Local Laws and Planning Policies

B

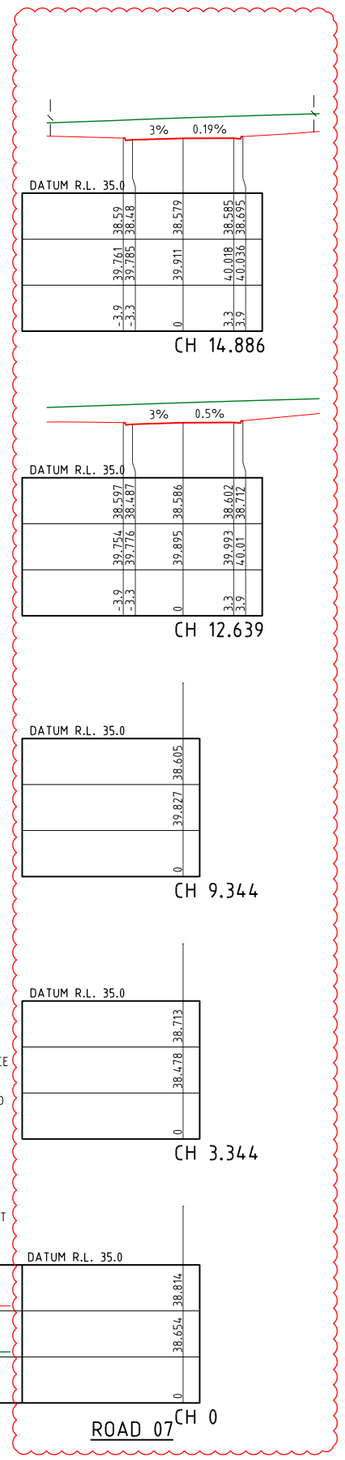

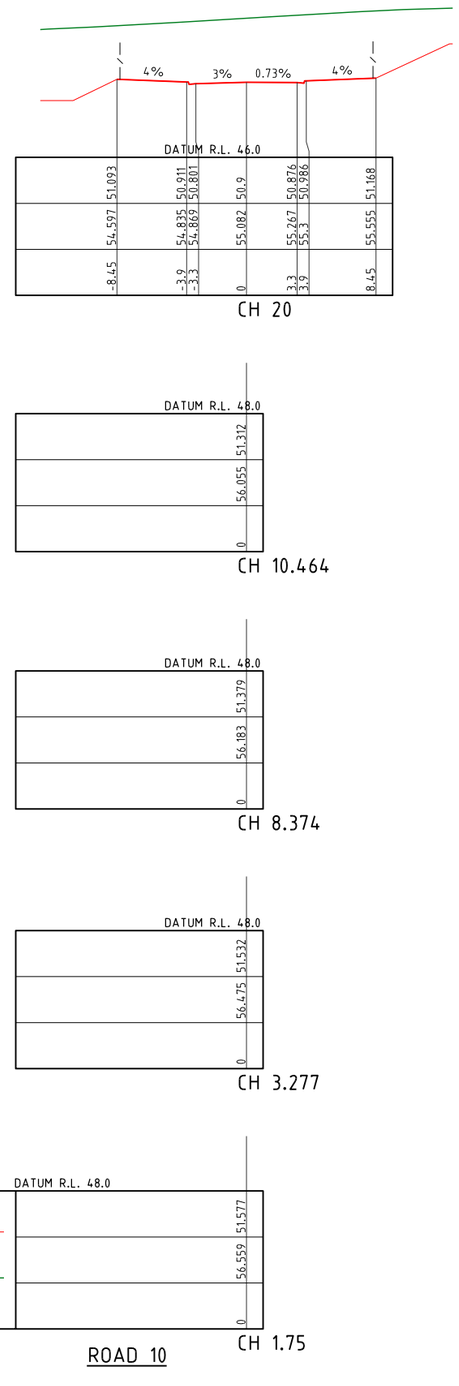

NOTES:

1. REFER TO 080 SERIES FINAL SURFACE PLAN DWGS FOR EARTHWORKS BEYOND ROAD RESERVE.

2. CROSS SECTIONS WITH NO TEMPLATE REPRESENT CONTROL LINE LEVELS AT THAT CHAINAGE.

PROJECT NAME

COURTNEY DR UPPER COOMERA

STAGE 02

RP DESCRIPTION

LOT 188, 189, 190, 191 & 192 ON RP173728
COURTNEY DRIVE
LOCALITY OF UPPER COOMERA
LOCAL AUTHORITY - GOLD COAST CITY COUNCIL

CLIENT

HB Land

0 2 4 6 8 10m
Scale 1:200 - A1 (1:400 - A3)

REV	DATE	DESCRIPTION	INT
B	15-01-24	CROSS SECTIONS AMENDED	BL
A	13-10-23	COUNCIL ISSUE	EP

COPYRIGHT IS VESTED IN MORTONS-URBAN SOLUTIONS AND WRITTEN CONSENT IS REQUIRED PRIOR TO REPRODUCTION. DO NOT SCALE FROM THIS DRAWING.

ASSOCIATED CONSULTANTS

BIOME WATER AND ENVIRONMENTAL CONSULTING
Robin Russell & ASSOCIATES PTY. LTD.
BENNETT + BENNETT

DRAWING TITLE


CROSS SECTIONS
ROAD 07
&
ROAD 10

MORTONS urbansolutions
Urban & Regional Planning
Civil Engineering
Project Coordination
MUS Pty Ltd T/As:
Mortons-Urban Solutions
ABN: 39 116 375 065
mortons@urbansolutions.net.au
www.urbansolutions.net.au
Tel 07 5571 1099
Postal Address
PO Box 2484
Southport QLD 4215
Gold Coast Office
Suite 9, 19 Short St
Southport QLD 4215

DESIGNED	RB	DRAWN	EP
APPROVED		RPEQ 4706	DATE 13-10-23

DRAWING NUMBER 41901-02-306 REV B

F:\Autocad Client\419 - HB Land\01 - Courtney Drive\Precinct-Stage 02\Engineering Drawings\Current\41901-02-300.dwg, ROAD 07 & ROAD 10, 21/06/2024 1:23:37 PM, 1:2

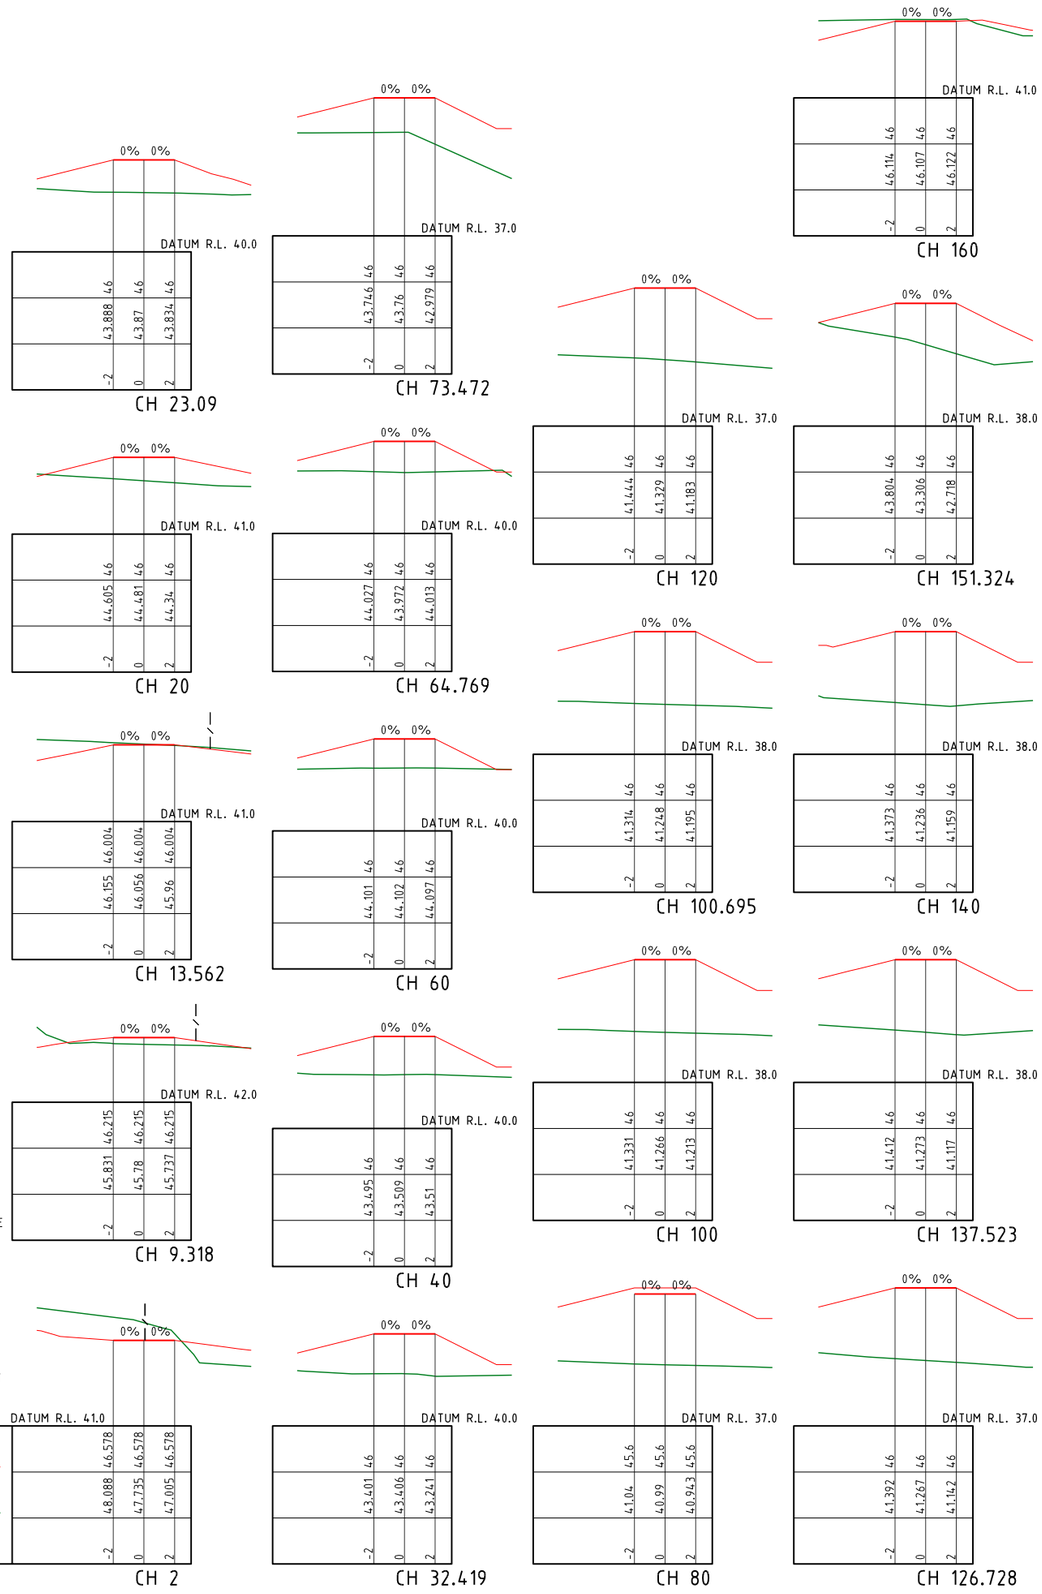

NOTES:

1. REFER TO 080 SERIES FINAL SURFACE PLAN DWGS FOR EARTHWORKS BEYOND ROAD RESERVE.

2. CROSS SECTIONS WITH NO TEMPLATE REPRESENT CONTROL LINE LEVELS AT THAT CHAINAGE.

ACCESS BASIN 01

PLANS AND DOCUMENTS referred to in the DEVELOPMENT APPROVAL

Application No: MIN/2024/337

Dated: 16 July 2024

Development shall comply with the conditions of approval as detailed in the Decision Notice and Council's Planning Scheme, Local Laws and Planning Policies

PROJECT NAME

COURTNEY DR UPPER COOMERA

STAGE 02

RP DESCRIPTION

LOT 188, 189, 190, 191 & 192 ON RP173728
COURTNEY DRIVE
LOCALITY OF UPPER COOMERA
LOCAL AUTHORITY - GOLD COAST CITY COUNCIL

CLIENT

HB Land

0 2 4 6 8 10m
Scale 1:200 - A1 (1:400 - A3)

REV	DATE	DESCRIPTION	INT
A	13-10-23	COUNCIL ISSUE	EP

COPYRIGHT IS VESTED IN MORTONS-URBAN SOLUTIONS AND WRITTEN CONSENT IS REQUIRED PRIOR TO REPRODUCTION.
DO NOT SCALE FROM THIS DRAWING.

ASSOCIATED CONSULTANTS

BIOME WATER AND ENVIRONMENTAL CONSULTING
Robin Russell & ASSOCIATES PTY. LTD.
BENNETT+BENNETT

DRAWING TITLE

CROSS SECTIONS
ACCESS BASIN 01

MORTONS urbansolutions
Urban & Regional Planning
Civil Engineering
Project Coordination
MUS Pty Ltd T/As:
Mortons-Urban Solutions
ABN: 39 116 375 065
mortons@urbansolutions.net.au
www.urbansolutions.net.au
Tel 07 5571 1099
Postal Address
PO Box 2484
Southport QLD 4215
Gold Coast Office
Suite 9, 19 Short St
Southport QLD 4215

DESIGNED	RB	DRAWN	EP
APPROVED	RPEQ 4706	DATE	13-10-23

DRAWING NUMBER	REV
41901-02-307	A

F:\Autocad Client\419 - HB Land\01 - Courtney Drive\Precinct-Stage 02\Engineering Drawings\Current\41901-02-300.dwg, ACCESS BASIN 01, 21/06/2024 1:23:38 PM, 1:2

PLANS AND DOCUMENTS referred to in the DEVELOPMENT APPROVAL

Application No: MIN/2024/337

Dated: 16 July 2024

Development shall comply with the conditions of approval as detailed in the Decision Notice and Council's Planning Scheme, Local Laws and Planning Policies

LEGEND

- EXISTING KERB (INVERT)
- EXISTING KERB (LIP & BACK)
- EXISTING FOOTPATH
- EXISTING PROPERTY LINE
- EXISTING CONTOURS
- FUTURE KERB
- FUTURE FOOTPATH
- FUTURE PROPERTY LINE
- FUTURE CONTOURS
- CONTROL LINE / CENTER OF ROAD
- PROPOSED KERB (INVERT)
- PROPOSED KERB (LIP & BACK)
- PROPOSED FOOTPATH
- PROPOSED PROPERTY LINE
- SITE BOUNDARY
- STAGE BOUNDARY
- DESIGN CONTOURS
- PROPOSED CONCRETE


24.0 _41.065 INTERSECTION CHAINAGE & LEVEL

B1 BARRIER KERB & CHANNEL


REFER TO DRG. 120 FOR KERB TYPES

NOTES:


1. SETOUT POINT DENOTES LIP OF KERB WHERE LIP OF KERB, OR FACE OF KERB WHERE NO LIP.
2. FOR KERB TYPES REFER TO SCHEDULE OF KERB TYPES ON DWG. 120

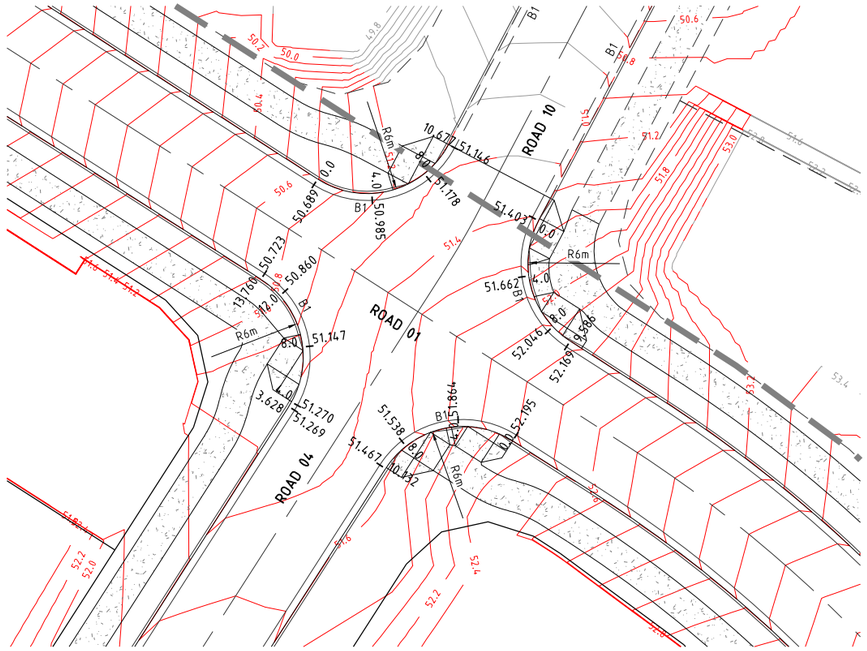

INTERSECTION
ROAD 01, 04 & 10

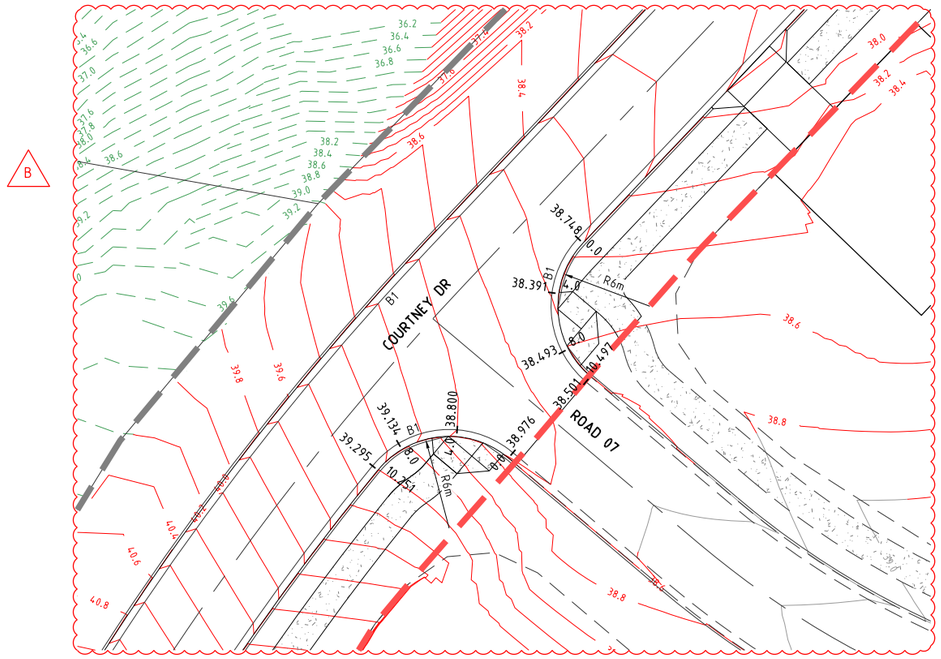

INTERSECTION
COURTNEY DRIVE & ROAD 07

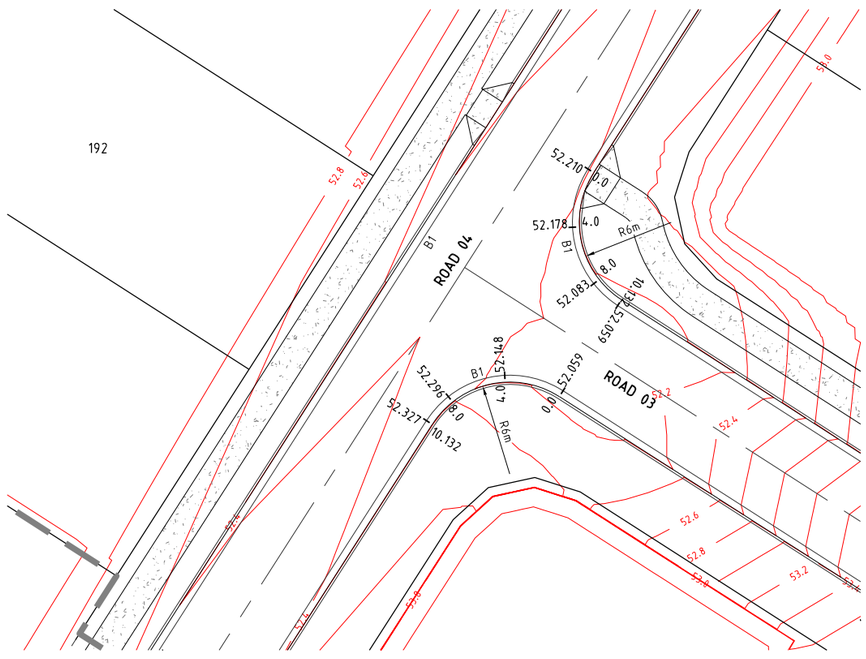

INTERSECTION
ROAD 03 & ROAD 04

PROJECT NAME

COURTNEY DR UPPER COOMERA

STAGE 02

RP DESCRIPTION

LOT 188, 189, 190, 191 & 192 ON RP173728
COURTNEY DRIVE
LOCALITY OF UPPER COOMERA
LOCAL AUTHORITY - GOLD COAST CITY COUNCIL

CLIENT

HB Land

NORTH

0 2 4 6 8 10m

Scale 1:200 - A1 (1:400 - A3)

REV	DATE	DESCRIPTION	INT
B	15-01-24	CONTOURS & GRADING AMENDED	BL
A	13-10-23	COUNCIL ISSUE	EP

COPYRIGHT IS VESTED IN MORTONS-URBAN SOLUTIONS AND WRITTEN CONSENT IS REQUIRED PRIOR TO REPRODUCTION.
DO NOT SCALE FROM THIS DRAWING.

ASSOCIATED CONSULTANTS

BIOME WATER AND ENVIRONMENTAL CONSULTING

Robin Russell & ASSOCIATES PTY. LTD.

BENNETT + BENNETT

DRAWING TITLE

INTERSECTION
GRADING DETAILS

MORTONS urbansolutions
Urban & Regional Planning
Civil Engineering
Project Coordination

MUS Pty Ltd T/As
Mortons-Urban Solutions
ABN: 39 116 375 065
mortons@urbansolutions.net.au
www.urbansolutions.net.au
Tel 07 5571 1099

Postal Address
PO Box 2484
Southport QLD 4215

Gold Coast Office
Suite 9, 19 Short St
Southport QLD 4215

DESIGNED	RB	DRAWN	EP
APPROVED	RPEQ 4706	DATE	13-10-23


DRAWING NUMBER 41901-02-400

REV B

F:\Autocad Client\419 - HB Land\01 - Courtney Drive\Precinct-Stage 02\Engineering Drawings\Current\41901-02-400.dwg, DETAILS, 21/06/2024 1:24:31 PM, 1:2

CONCRETE PAVEMENT DRIVEWAY:

1. CONCRETE MIX
   THE CONCRETE SHALL HAVE A MINIMUM 28 DAY CHARACTERISTIC COMPRESSIVE STRENGTH AS SPECIFIED IN THE SCHEDULE OF CONCRETE PAVEMENTS TABLE, MAXIMUM WATER/CEMENT RATIO OF 0.45 & A MINIMUM CEMENT CONTENT OF 300kg/m³.
2. SUBGRADE PREPARATION
   THE SUBGRADE TO THE CONCRETE PAVEMENT AREAS SHALL BE PREPARED THE SAME AS CONVENTIONAL ROADS. REFER TO SCHEDULE OF CONCRETE PAVEMENTS TABLE.
3. TRAFFIC
   TRAFFIC SHALL NOT BE ALLOWED ON THE FINISHED CONCRETE PAVEMENT FOR AT LEAST 14 DAYS AFTER COMPLETION OF CONSTRUCTION. THE CONTRACTOR IS RESPONSIBLE FOR INSTALLING MEASURES TO PREVENT UNAUTHORISED ACCESS.
4. JOINTS
   ALL JOINTS SHALL BE LOCATED GENERALLY PERPENDICULAR TO THE CENTRELINE. ALL CONTROL JOINTS TO BE COMPLETED AS SOON AS CONCRETE HAS CURED SUFFICIENTLY SO AS NOT TO DAMAGE THE SLAB SURFACE.
   ALL JOINTS ARE TO BE INSTALLED AS DETAILED ON IPWEAQ STD DWG RS-065.
5. GENERAL
   THE GRAVEL PAVEMENT SHALL BE NEATLY PROFILED & TRIMMED TO ENSURE CONSTANT CONCRETE DEPTHS & PROFILES. ACTUAL CONSTRUCTION REQUIREMENTS MAY VARY FROM THE DETAILS SHOWN & THEREFORE ALL CONSTRUCTION DETAILS SHOULD BE VERIFIED BY THE SUPERINTENDENT PRIOR TO CONSTRUCTION COMMENCING. PROVIDE ABLEFLEX BETWEEN KERB & DRIVEWAY.
6. COMPLIANCE STANDARDS
   SLIP RESISTANCE OF SURFACE MATERIALS IN ACCORDANCE WITH AUSTRALIAN STANDARDS.
   AS/NZS 4586: 2013 SLIP RESISTANCE OF NEW PEDESTRIAN SURFACE MATERIALS.
   AS/NZS 4663: 2013 SLIP RESISTANCE MEASUREMENT OF EXISTING PEDESTRIAN SURFACES
   HB:A:A 197: 1999 "AN INTRODUCTORY GUIDE TO THE SLIP RESISTANCE OF PEDESTRIAN SURFACE MATERIALS"

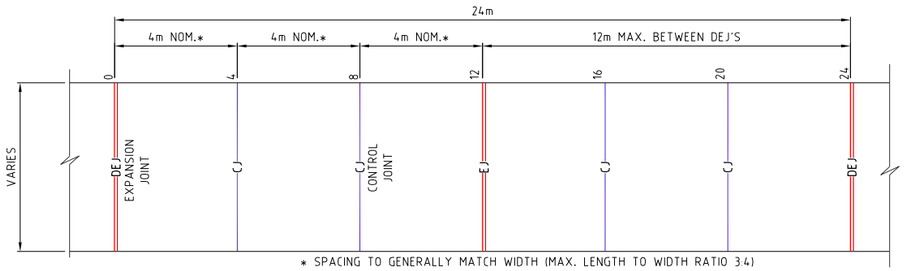

TYPICAL CONCRETE PAVEMENT DETAIL FOR DRIVEWAYS AND ROADS


SCALE 1:50 - A1 (1:100 - A3)

0 0.5 1.0 1.5 2.0 2.5m

Scale 1:50 - A1 (1:100 - A3)


SCHEDULE OF CONCRETE PAVEMENTS					
FUNCTION	SURFACING	SUBGRADE PREPARATION	THICKNESS 'T'	STRENGTH	REINCORCING
FOOTPATH 2m WIDE	HEAVY BROOM FINISH	50mm SAND BLINDING LAYER	100mm	32 mPa	SL 72 MESH
DRIVEWAY STORMWATER BASIN	HEAVY BROOM FINISH	100mm (CBR 15)	175mm	32 mPa	SL 72 MESH

NOTE: FOOTPATH JOINTING TO BE IN ACCORDANCE WITH IPWEAQ DWG RS-065 SUPERINTENDENT TO CONFIRM SUBGRADE PREPARATION

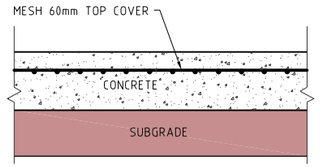


TYPICAL BROOM FINISHED CONCRETE PAVEMENT DETAIL

NOT TO SCALE

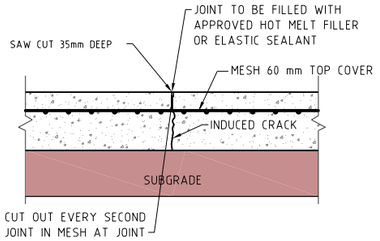


CONTROL JOINT (4m SPACING) (CJ)

NOT TO SCALE

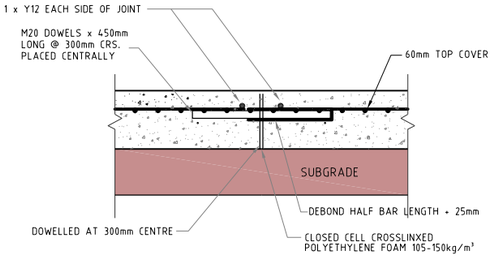

DOWELLED EXPANSION JOINT DETAIL (24m SPACING) (DEJ)

NOT TO SCALE

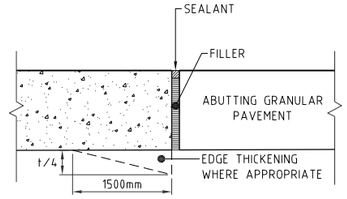


ISOLATION JOINT (IJ)

NOT TO SCALE

LEGEND

- EXISTING PROPERTY LINE
- EXISTING KERB
- FUTURE KERB
- FUTURE PROPERTY LINE
- PROPERTY LINE
- FACE OF KERB, FOOTPATHS
- LIP AND BACK OF KERB
- CONTROL LINE / CENTER OF ROAD
- SITE BOUNDARY
- STAGE BOUNDARY
- EJ EXPANSION JOINT
- DEJ DOWELED EXPANSION JOINT
- IJ ISOLATION JOINT
- SJ SAW JOINT
- CJ CONTROL JOINT
- KJ KEY JOINT
- 2xN12 BARS AROUND PENETRATIONS TYP.

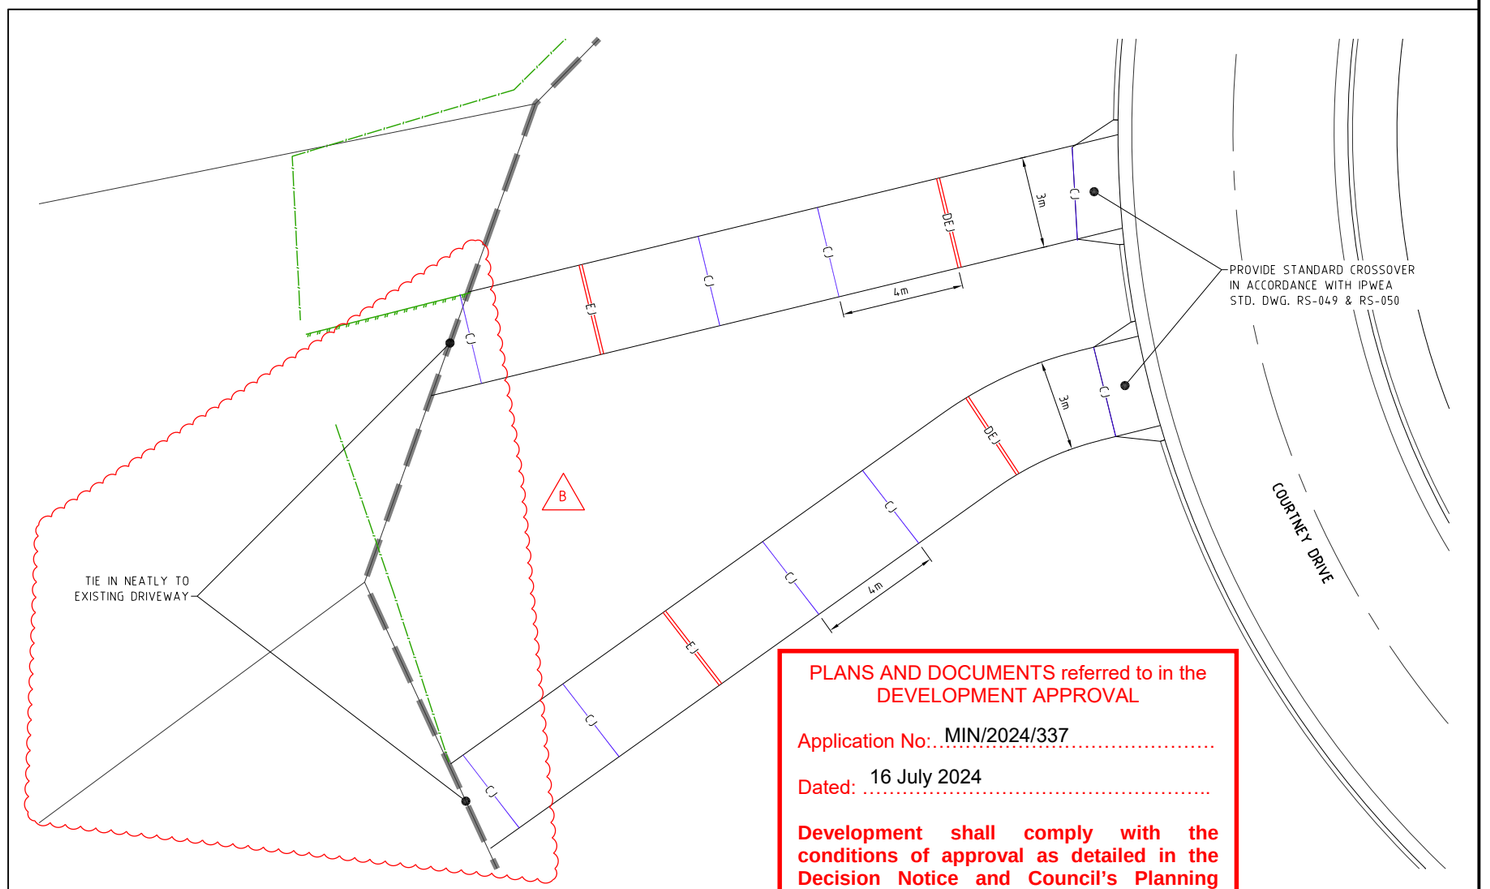

PLANS AND DOCUMENTS referred to in the DEVELOPMENT APPROVAL

Application No: MIN/2024/337

Dated: 16 July 2024

Development shall comply with the conditions of approval as detailed in the Decision Notice and Council's Planning Scheme, Local Laws and Planning Policies

DIAL BEFORE YOU DIG www.1100.com.au

PROJECT NAME

COURTNEY DR UPPER COOMERA

STAGE 02

RP DESCRIPTION

LOT 188, 189, 190, 191 & 192 ON RP173728
COURTNEY DRIVE
LOCALITY OF UPPER COOMERA
LOCAL AUTHORITY - GOLD COAST CITY COUNCIL

CLIENT

HB Land



0 1 2 3 4 5m

Scale 1:100 - A1 (1:200 - A3)

REV	DATE	DESCRIPTION	INT
B	17-01-24	NOTE ADDED	EP
A	13-10-23	COUNCIL ISSUE	EP

COPYRIGHT IS VESTED IN MORTONS-URBAN SOLUTIONS AND WRITTEN CONSENT IS REQUIRED PRIOR TO REPRODUCTION. DO NOT SCALE FROM THIS DRAWING.

ASSOCIATED CONSULTANTS

BIOME WATER AND ENVIRONMENTAL CONSULTING

Robin Russell & ASSOCIATES PTY. LTD.

BENNETT + BENNETT

DRAWING TITLE

CONCRETE JOINTING DETAILS SHEET 01

MORTONS urbansolutions
Urban & Regional Planning
Civil Engineering
Project Coordination
MUS Pty Ltd T/As
Mortons-Urban Solutions
ABN: 39 116 375 065
mortons@urbansolutions.net.au
www.urbansolutions.net.au
Tel 07 5571 1099
Postal Address
PO Box 2484
Southport QLD 4215
Gold Coast Office
Suite 9, 19 Short St
Southport QLD 4215

DESIGNED	RB	DRAWN	EP
APPROVED		RPEQ 4706	DATE 13-10-23

DRAWING NUMBER 41901-02-410 REV B

F:\Autocad Client\419 - HB Land\01 - Courtney Drive\Precinct-Stage 02\Engineering Drawings\Current\41901-02-410.dwg, DETAILS SHEET 01, 21/06/2024 12:46:46 PM, 1:2

LEGEND

- EXISTING PROPERTY LINE
- EXISTING KERB
- FUTURE KERB
- FUTURE PROPERTY LINE
- PROPERTY LINE
- FACE OF KERB, FOOTPATHS
- LIP AND BACK OF KERB
- CONTROL LINE / CENTER OF ROAD
- SITE BOUNDARY
- STAGE BOUNDARY
- EJ — EXPANSION JOINT
- DEJ — DOWELED EXPANSION JOINT
- IJ — ISOLATION JOINT
- SJ — SAW JOINT
- CJ — CONTROL JOINT
- KJ — KEY JOINT
- 2xN12 BARS AROUND PENETRATIONS TYP.


DIAL BEFORE YOU DIG www.1100.com.au


PLANS AND DOCUMENTS referred to in the DEVELOPMENT APPROVAL


Application No: MIN/2024/337


Dated: 16 July 2024


Development shall comply with the conditions of approval as detailed in the Decision Notice and Council's Planning Scheme, Local Laws and Planning Policies

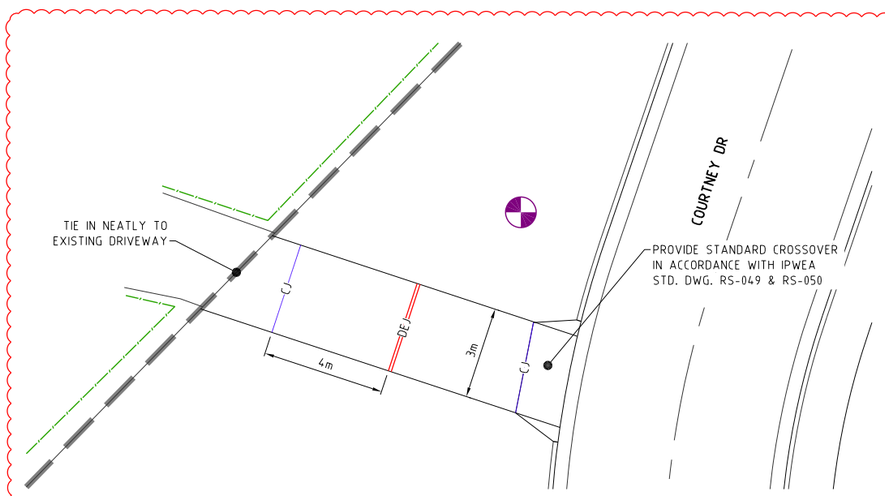


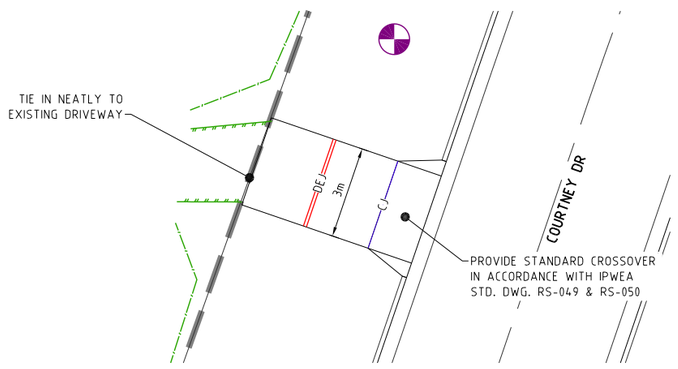

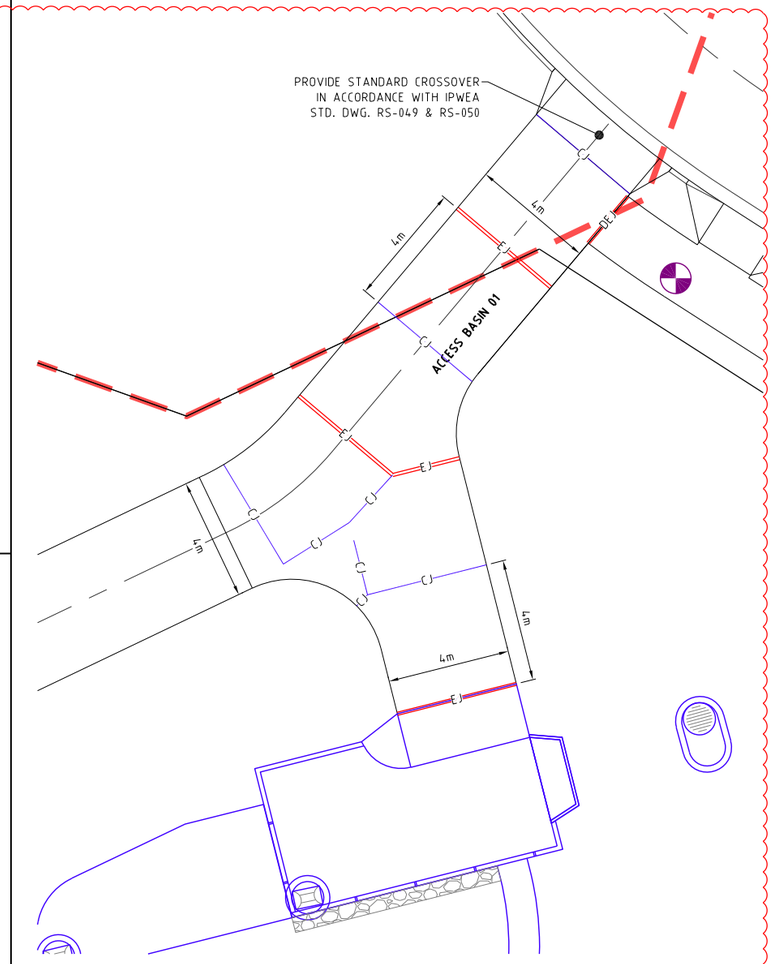

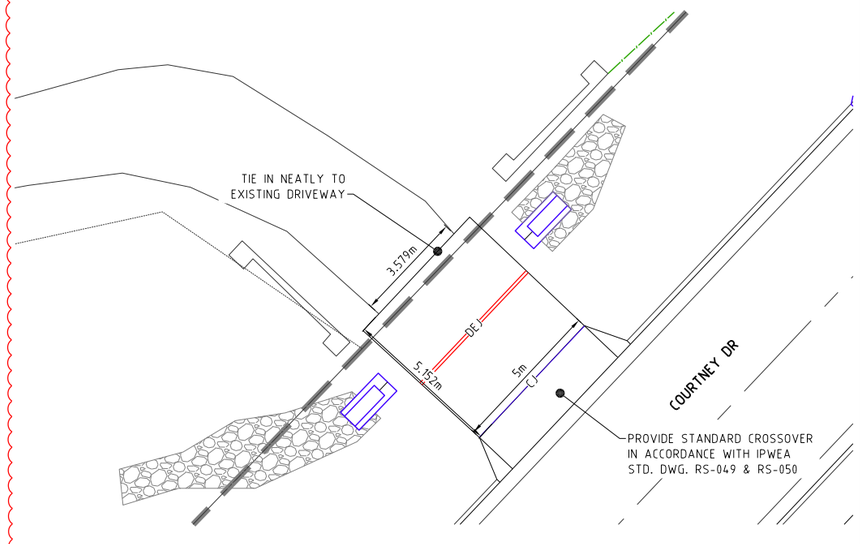

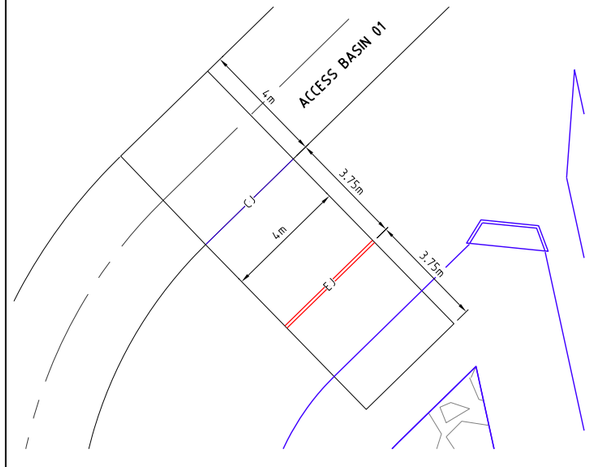

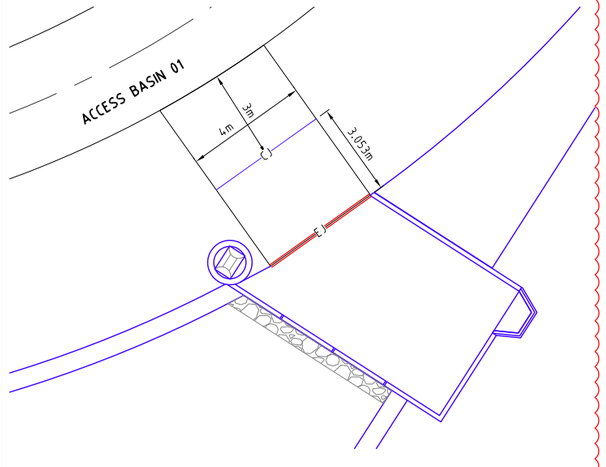

PROJECT NAME

COURTNEY DR UPPER COOMERA

STAGE 02

RP DESCRIPTION

LOT 188, 189, 190, 191 & 192 ON RP173728
COURTNEY DRIVE
LOCALITY OF UPPER COOMERA
LOCAL AUTHORITY - GOLD COAST CITY COUNCIL

CLIENT

HB Land

NORTH

0 1 2 3 4 5m

Scale 1:100 - A1 (1:200 - A3)

REV	DATE	DESCRIPTION	INT
C	14-06-24	DRIVEWAY REMOVED, JOINTING DETAIL AMENDED	RK
B	29-11-23	JOINTING AMENDED, D.WAY ADDED	BL
A	13-10-23	COUNCIL ISSUE	EP

COPYRIGHT IS VESTED IN MORTONS-URBAN SOLUTIONS AND WRITTEN CONSENT IS REQUIRED PRIOR TO REPRODUCTION. DO NOT SCALE FROM THIS DRAWING.

ASSOCIATED CONSULTANTS

BIOME WATER AND ENVIRONMENTAL CONSULTING

Robin Russell & ASSOCIATES PTY. LTD.

BENNETT+BENNETT

DRAWING TITLE

CONCRETE JOINTING DETAILS SHEET 02

MORTONS urbansolutions
Urban & Regional Planning
Civil Engineering
Project Coordination

MUS Pty Ltd T/As
Mortons-Urban Solutions
ABN: 39 116 375 065

Postal Address
PO Box 2484
Southport QLD 4215

mortons@urbansolutions.net.au
www.urbansolutions.net.au
Tel 07 5571 1099

Gold Coast Office
Suite 9, 19 Short St
Southport QLD 4215

DESIGNED	RB	DRAWN	EP
APPROVED	RPEQ 4706	DATE	13-10-23

DRAWING NUMBER 41901-02-411

REV C

F:\Autocad Client\419 - HB Land\01 - Courtney Drive\Precinct-Stage 02\Engineering Drawings\Current\41901-02-410.dwg, DETAILS SHEET 02, 21/06/2024 1:24:51 PM, 12

PLANS AND DOCUMENTS referred to in the DEVELOPMENT APPROVAL

Application No: MIN/2024/337

Dated: 16 July 2024

Development shall comply with the conditions of approval as detailed in the Decision Notice and Council's Planning Scheme, Local Laws and Planning Policies


NOTES

1. LINEMARKING & SIGNAGE IS TO BE CONSTRUCTED IN ACCORDANCE WITH THE LATEST EDITION OF THE "MANUAL OF UNIFORM TRAFFIC CONTROL DEVICES". ALL SIGNAGE SHOWN IS DIAGRAMMATIC ONLY, & MUST BE INSTALLED AT THE HEIGHT, ORIENTATION & WITH APPROPRIATE POLE SUPPORT AS SPECIFIED IN THE MANUAL OF UNIFORM TRAFFIC CONTROL DEVICES.
2. ALL SIGN POSTS & SIGN RAILS TO BE GALVANISED UNLESS NOTED OTHERWISE.

PAVEMENT MARKING LEGEND

- EXISTING EDGE LINE - EL
- EXISTING EDGE LINE YELLOW - EL(Y)
- EXISTING CONTINUITY LINE - CL
- EXISTING TURN LINE - TL
- EXISTING BARRIER LINE - BL(B)
- EXISTING BARRIER LINE - BL
- EXISTING LANE LINE - LL
- EXISTING LANE LINE - LL(B)
- EXISTING GIVE WAY LINE - GWL
- EXISTING STOP LINE - SL
- EDGE LINE - EL
- EDGE LINE YELLOW - EL(Y)
- CONTINUITY LINE - CL
- TURN LINE - TL
- BARRIER LINE - BL(B)
- BARRIER LINE - BL
- LANE LINE - LL
- LANE LINE - LL(B)
- GIVE WAY LINE - GWL
- STOP LINE - SL

NOTE REFER TO MANUAL OF UNIFORM TRAFFIC CONTROL DEVICES FOR ALL LINEMARKING AND SIGN STANDARDS

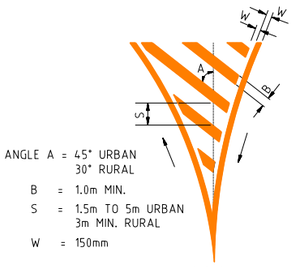


ANGLE A = 45° URBAN
30° RURAL
B = 1.0m MIN.
S = 1.5m TO 5m URBAN
3m MIN. RURAL
W = 150mm

CHEVRONS


LEGEND

- EXISTING KERB (INVERT)
- EXISTING PROPERTY LINE
- EXISTING FOOTPATH
- FUTURE KERB (INVERT)
- FUTURE FOOTPATH
- FUTURE PROPERTY LINE
- PROPOSED KERB (INVERT)
- PROPOSED FOOTPATH
- PROPOSED PROPERTY LINE
- SITE BOUNDARY
- STAGE BOUNDARY
- SIGN POST
- SIGN POST
- SIGN POST

SHEET LAYOUT

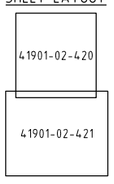

DIAL BEFORE YOU DIG www.1100.com.au

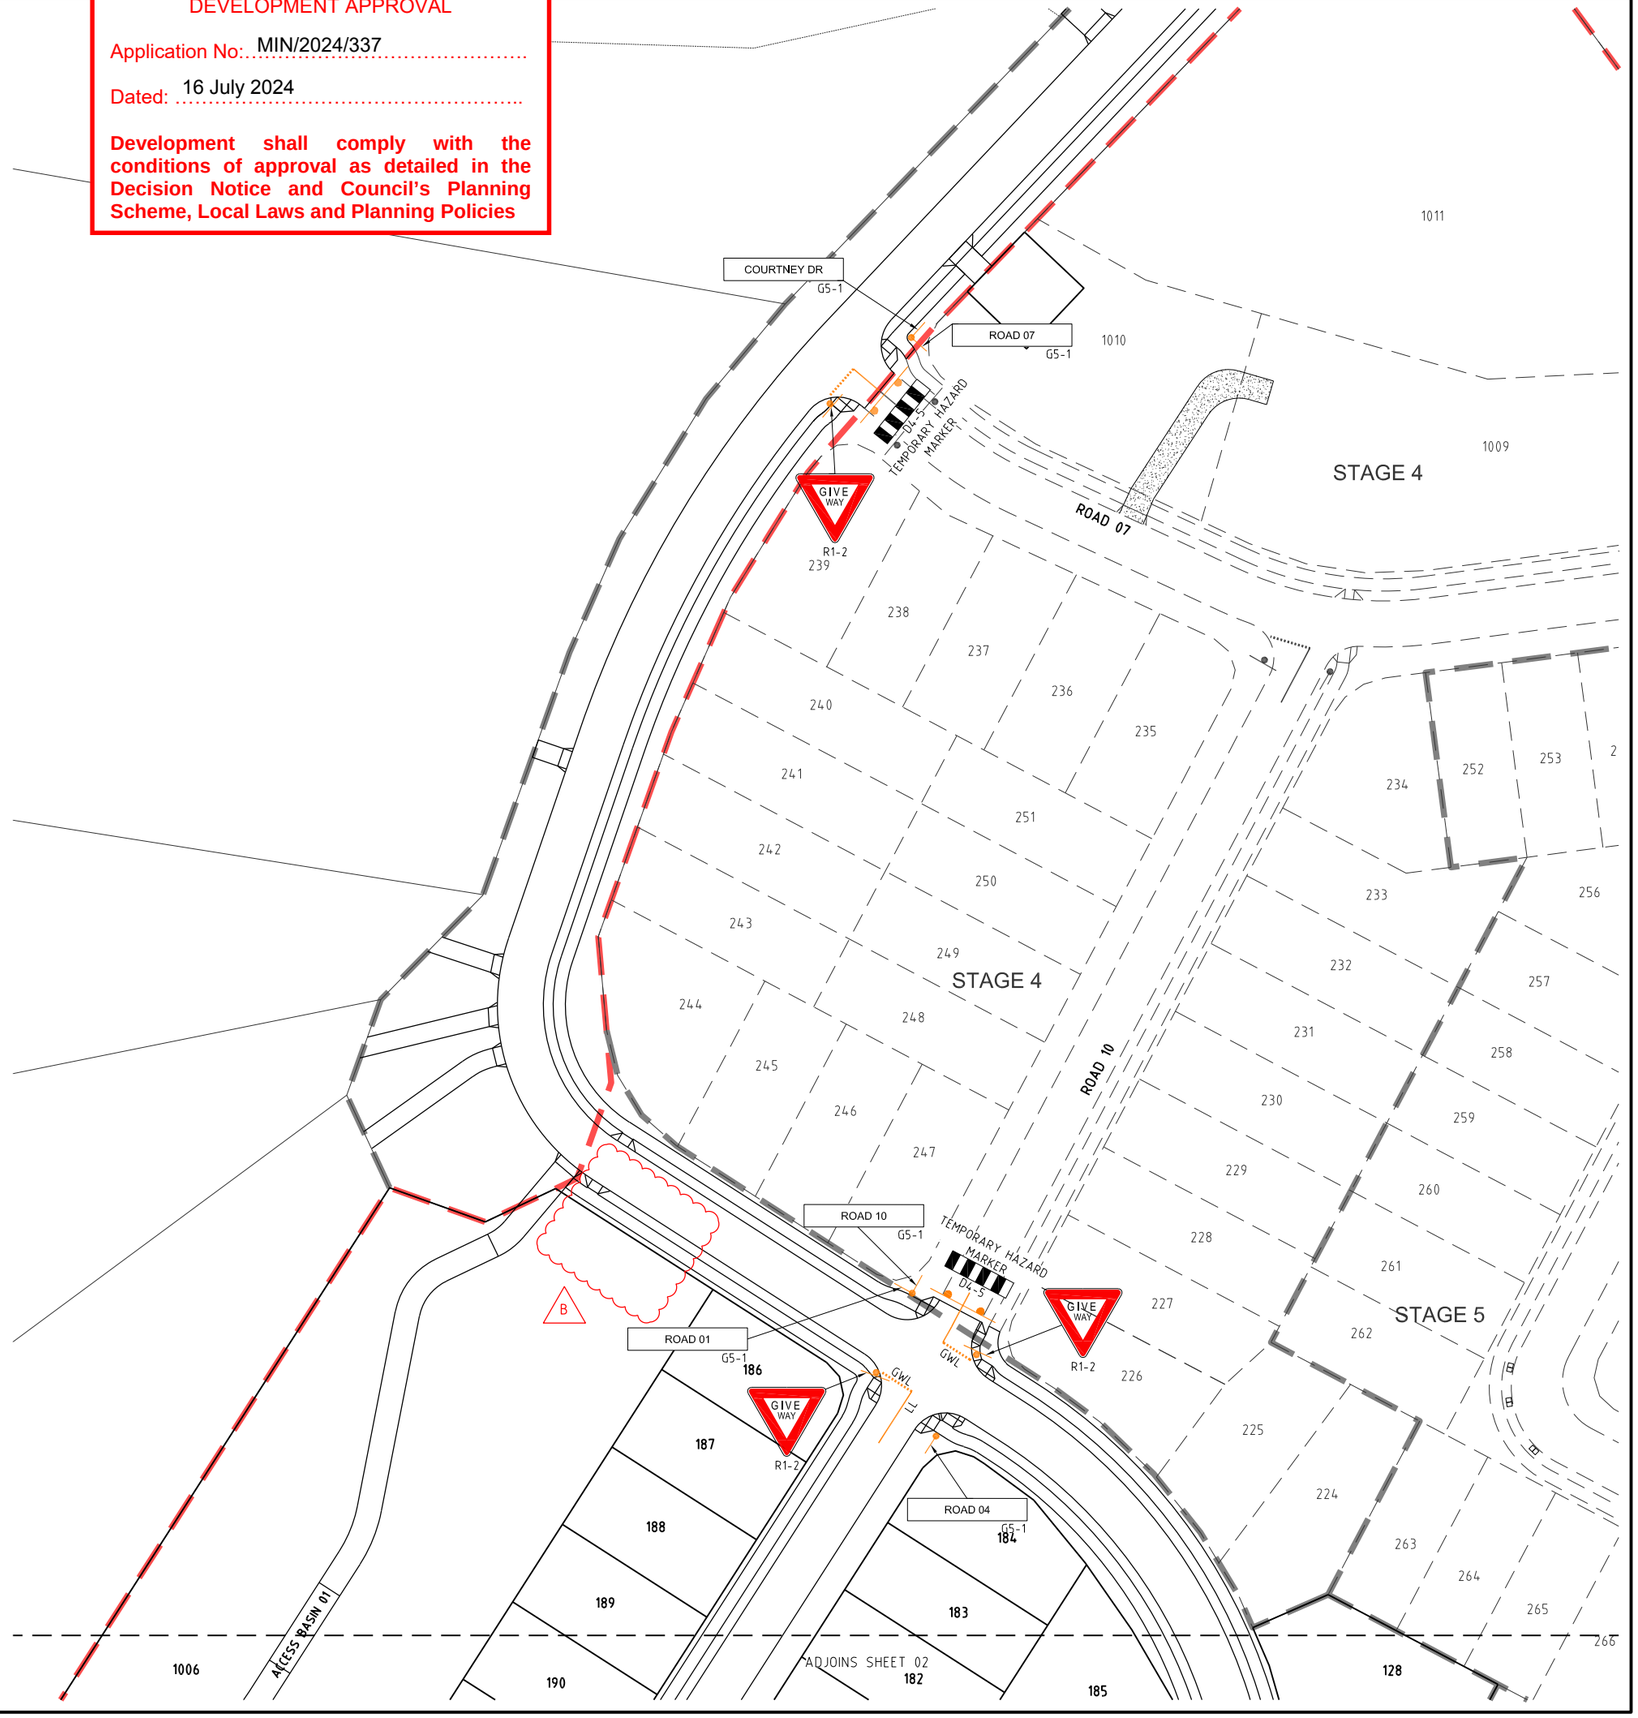

PROJECT NAME

COURTNEY DR UPPER COOMERA

STAGE 02

RP DESCRIPTION

LOT 188, 189, 190, 191 & 192 ON RP173728
COURTNEY DRIVE
LOCALITY OF UPPER COOMERA
LOCAL AUTHORITY - GOLD COAST CITY COUNCIL

CLIENT

HB Land

NORTH

0 5 10 15 20 25m
Scale 1:500 - A1 (1:1000 - A3)

REV	DATE	DESCRIPTION	INT
B	19-06-24	PMT UPDATED	RK
A	13-10-23	COUNCIL ISSUE	EP

COPYRIGHT IS VESTED IN MORTONS-URBAN SOLUTIONS AND WRITTEN CONSENT IS REQUIRED PRIOR TO REPRODUCTION. DO NOT SCALE FROM THIS DRAWING.

ASSOCIATED CONSULTANTS

BIOME WATER AND ENVIRONMENTAL CONSULTING
Robin Russell & ASSOCIATES PTY. LTD.
BENNETT + BENNETT

DRAWING TITLE

LINEMARKING & SIGNAGE PLAN SHEET 01

MORTONS urbansolutions
Urban & Regional Planning
Civil Engineering
Project Coordination
MUS Pty Ltd T/As
Mortons-Urban Solutions
ABN: 39 116 375 065
mortons@urbansolutions.net.au
www.urbansolutions.net.au
Tel 07 5571 1099
Postal Address
PO Box 2484
Southport QLD 4215
Gold Coast Office
Suite 9, 19 Short St
Southport QLD 4215

DESIGNED	RB	DRAWN	EP
APPROVED		RPEQ 4706	DATE 13-10-23

DRAWING NUMBER 41901-02-420 REV B

F:\Autocad Client\419 - HB Land\01 - Courtney Drive\Precinct-Stage 02\Engineering Drawings\Current\41901-02-420.dwg, PLAN SHEET 01, 21/06/2024 12:52:09 PM, 1:2

ADJOINS SHEET 01

ACCESS BASIN 01

ROAD 03

ROAD 01

ROAD 02

ROAD 04

ROAD 06

STAGE 1

STAGE 2

STAGE 3

GIVE WAY R1-2

TEMPORARY HAZARD MARKER D4-5

G5-1

GML

LL

B

1005

1006

1007

PLANS AND DOCUMENTS referred to in the DEVELOPMENT APPROVAL

Application No: MIN/2024/337

Dated: 16 July 2024

Development shall comply with the conditions of approval as detailed in the Decision Notice and Council's Planning Scheme, Local Laws and Planning Policies

F:\Autocad Client\419 - HB Land\01 - Courtney Drive\Precinct-Stage 02\Engineering Drawings\Current\41901-02-420.dwg, PLAN SHEET 02, 21/06/2024 1:25:10 PM, 1:2

PROJECT NAME

COURTNEY DR UPPER COOMERA

STAGE 02

RP DESCRIPTION

LOT 188, 189, 190, 191 & 192 ON RP173728
COURTNEY DRIVE
LOCALITY OF UPPER COOMERA
LOCAL AUTHORITY - GOLD COAST CITY COUNCIL

CLIENT

HB Land

NORTH

0 5 10 15 20 25m

Scale 1:500 - A1 (1:1000 - A3)

REV	DATE	DESCRIPTION	INT
B	19-06-24	PMT UPDATED	RK
A	13-10-23	COUNCIL ISSUE	EP

COPYRIGHT IS VESTED IN MORTONS-URBAN SOLUTIONS AND WRITTEN CONSENT IS REQUIRED PRIOR TO REPRODUCTION.
DO NOT SCALE FROM THIS DRAWING.

ASSOCIATED CONSULTANTS

BIOME WATER AND ENVIRONMENTAL CONSULTING

Robin Russell & ASSOCIATES PTY. LTD.

BENNETT + BENNETT

DRAWING TITLE

LINEMARKING & SIGNAGE
PLAN
SHEET 02

MORTONS urbansolutions
Urban & Regional Planning
Civil Engineering
Project Coordination

MUS Pty Ltd T/As:
Mortons-Urban Solutions
ABN: 39 116 375 065
mortons@urbansolutions.net.au
www.urbansolutions.net.au
Tel 07 5571 1099

Postal Address
PO Box 2484
Southport QLD 4215

Gold Coast Office
Suite 9, 19 Short St
Southport QLD 4215

DESIGNED	RB	DRAWN	EP
APPROVED	RPEQ 4706	DATE	13-10-23

DRAWING NUMBER	REV
41901-02-421	B

PLANS AND DOCUMENTS referred to in the DEVELOPMENT APPROVAL

Application No: MIN/2024/337

Dated: 16 July 2024

Development shall comply with the conditions of approval as detailed in the Decision Notice and Council's Planning Scheme, Local Laws and Planning Policies

SEQ CODE SEWER NOTES

SEQ CODE NOTES COPIED DIRECTLY FROM DRAWING SEQ-SEW-1101-3.

VEGETATION PROTECTION

A. TREES LOCATED ALONG THE FOOTPATH SHALL BE, TRANSPLANTED PRIOR TO CONSTRUCTION, OR REPLACED IF DESTROYED.
B. WHEN WORKING WITHIN 4m OF TREES, RUBBER OR HARDWOOD GIRDLES SHALL BE CONSTRUCTED WITH 1.8 m BATTENS CLOSELY SPACED & ARRANGED VERTICALLY FROM GROUND LEVEL. GIRDLES SHALL BE STRAPPED TO TREES PRIOR TO CONSTRUCTION & REMAIN UNTIL COMPLETION.
C. TREE ROOTS SHALL BE TUNNELLED UNDER, RATHER THAN SEVERED. IF ROOTS ARE SEVERED THE DAMAGED AREA SHALL BE TREATED WITH A SUITABLE FUNGICIDE. CONTACT RELEVANT COUNCIL ARBORIST FOR FURTHER ADVICE.
D. ANY TREE LOPPING REQUIRED SHOULD BE UNDERTAKEN BY AN APPROVED ARBORIST.

SOIL

A. TOPSOIL & SUBSOIL SHALL BE STOCKPILED SEPARATELY.
B. CARE SHALL BE TAKEN TO PREVENT SEDIMENT FROM ENTERING THE STORMWATER SYSTEM. THIS MAY INVOLVE PLACING APPROPRIATE SEDIMENT CONTROLS AROUND STOCKPILES.
C. IF ACID SULPHATE SOILS EXIST IN THE WORKS AREA. THE CONTRACTOR MUST PREPARE A RISK ASSESSMENT BASED ON THE QUEENSLAND ACID SULPHATE SOIL TECHNICAL MANUAL & MANAGE THE ACID SULPHATE SOILS AS PER THE MANUAL.

CREEK CROSSINGS

A. SILTATION CONTROL MEASURES SHALL BE PLACED DOWNSTREAM OF ANY EXCAVATION WORK.
B. APPROPRIATE SEDIMENT CONTROLS SHALL BE USED TO PREVENT SEDIMENT FROM ENTERING THE CREEK.
C. NO SOIL SHALL BE STOCKPILED WITHIN 5 m OF THE CREEK.

REHABILITATION

A. PREDISTURBANCE SOIL PROFILES & COMPACTION LEVELS SHALL BE REINSTATED.
B. PREDISTURBANCE VEGETATION PATTERNS SHALL BE RESTORED.

SAFETY


A. THE DESIGN & CONSTRUCTION OF THE WORKS SHALL COMPLY WITH ALL QUEENSLAND LEGISLATION.

GENERAL

1. ALL WORK & MATERIALS SHALL BE IN ACCORDANCE WITH CURRENT SOUTH EAST QUEENSLAND SEWERAGE CODE SPECIFICATIONS & STANDARDS.
2. UNLESS SPECIFIED OTHERWISE ALL MATERIALS & WORK SHALL COMPLY WITH THE RELEVANT AUSTRALIAN STANDARDS.
3. THE CONSTRUCTION OF THE SEWERAGE WORK SHOWN ON THIS DRAWING SHALL BE SUPERVISED BY AN ENGINEER WHO HAS RPEQ REGISTRATION. SEWERAGE WORKS NOT COMPLYING WITH THIS REQUIREMENT WILL NOT BE PERMITTED TO CONNECT INTO THE SEQ SERVICE PROVIDER SEWERAGE SYSTEM.
4. ALL WORK ASSOCIATED WITH LIVE SEWERS OR MAINTENANCE HOLES SHALL BE CARRIED OUT BY DEVELOPER'S APPROVED CONTRACTOR UNDER THE SUPERVISION OF SEQ'S AGENT AT THE DEVELOPER'S COST.
5. ALL PIPES & MATERIALS SHALL COMPLY WITH THE REQUIREMENTS OF THE "ACCEPTED PRODUCTS & MATERIALS" LIST.
6. EACH ALLOTMENT SHALL BE SERVED BY A DN100 PVC PROPERTY CONNECTION. FOR ALLOTMENTS OTHER THAN SINGLE RESIDENTIAL, A DN160 PE (OR DN150 PVC) PROPERTY CONNECTION SHALL BE PROVIDED.
7. PROPERTY CONNECTIONS SHALL BE LOCATED WITHIN THE PROPERTY AS SHOWN IN THE DRAWINGS.
8. PROPERTY CONNECTION BRANCHES SHALL EXTEND INTO THE PROPERTY A MINIMUM OF 300 mm & A MAXIMUM OF 750 mm. UNITYWATER REQUIRES MINIMUM EXTENSION OF 500 mm INTO PROPERTY.
9. WHERE PIPES ARE LAID IN FILL, THE FILLING SHALL BE CARRIED OUT IN LAYERS NOT EXCEEDING 300 mm (LOOSE) IN DEPTH & SHALL BE COMPACTED UNTIL THE COMPACTION IS NOT LESS THAN 95% OF THE MATERIALS MAXIMUM COMPACTION WHEN TESTED IN ACCORDANCE WITH A.S. 1289 (MODIFIED COMPACTION). TESTING SHALL BE CARRIED OUT AFTER EACH ALTERNATE LAYER. IN ALL SUCH CASES APPROVAL OF CONSTRUCTED SEWERS WILL NOT BE ISSUED BY THE SEQ SERVICE PROVIDER UNLESS CERTIFICATES ARE PRODUCED CERTIFYING THAT THE REQUIRED COMPACTION HAS BEEN ACHIEVED.
10. WHERE SEWERS HAVE A GRADE OF 1 IN 20 OR STEEPER,BULKHEADS SHALL BE CONSTRUCTED IN ACCORDANCE WITH THE SEQ SEWER CODE.
11. THE CONTRACTOR SHALL VERIFY THE LOCATION & DEPTH OF EXISTING SERVICES WITH RELEVANT AUTHORITIES BEFORE COMMENCING WORKS.
12. SEWERS SHALL BE DISUSED /ABANDONED IN ACCORDANCE WITH PROCEDURES SET OUT IN THE SEQ SEWER CODE.
13. BENCH MARK & LEVELS TO AHD.
14. ~~THE EXISTING DWELLING ON LOT 3, REFER SEQ-SEW-1100, SERVED BY A SEPTIC SYSTEM, SHALL BE CONNECTED TO THE NEW SEWER BY A LICENCED PLUMBER IN ACCORDANCE WITH THE RELEVANT STATUTORY & COUNCIL REQUIREMENTS. THE SEPTIC SYSTEM, INCLUDING TRENCHES,SHALL BE REMOVED AT THE DEVELOPER'S COST. ALL FIXTURES SHALL BE UPGRADED IF REQUIRED BY PLUMBING CODE.~~ STANDARD NOTE NOT APPLICABLE & THEREFORE DELETED.
15. EXISTING ALLOTMENTS REQUIRING A PROPERTY CONNECTION FROM EXISTING SEWERS SHALL BE PROVIDED BY THE SEQ SERVICE PROVIDER AT THE DEVELOPERS COST.

PROJECT SPECIFIC SEWER NOTES

a. ALL SEWER MAINS TO BE AS PER SEWER PIPE SPECIFICATIONS TABLE.
b. NOTWITHSTANDING THE STANDARD SEQ NOTES ABOVE, ALL MATERIALS & WORKS MUST BE IN ACCORDANCE WITH THE SERVICE PROVIDER'S APPROVAL CONDITIONS & THE SEQ WS&S D&C CODE.
c. THE CONTRACTOR IS TO INCLUDE ROCK EXCAVATION AS PART OF THEIR SEWER RATES UNLESS SCHEDULED OTHERWISE WITHIN THE CONTRACT.
d. THE CONTRACTOR TO PROVIDE CALCAREOUS CONCRETE WHERE SPECIFIED IN THE SEQ CODE BY THE RELEVANT AUTHORITY.
e. WATER & ELECTRICAL CROSSING LOCATIONS ARE INDICATIVE ONLY. REFER TO PLANS TO DETERMINE PRECISE CROSSING LOCATIONS. WHERE SERVICE INDICATES CLASH WITH SEWER, SEWER TO TAKE PRECEDENCE, SERVICE TO BE CONSTRUCTED OVER OR UNDER SEWER ACCORDING TO SUPERINTENDENT'S INSTRUCTION
f. ALL BENDS TO BE LONG RADIUS BEND TO MEET MANUFACTURER'S MINIMUM RADIUS REQUIREMENTS U.N.O.
g. CONTRACTOR TO VERIFY DOWNSTREAM EXISTING PIPE LEVELS PRIOR TO COMMENCEMENT OF WORKS ON-SITE.
h. PROPERTY CONNECTIONS HAVE BEEN DESIGNED TO CONTROL THE REQUIRED SERVICE AREA OF EACH LOT AT A GRADE OF 1:60 & A MAXIMUM DEPTH OF PROPERTY CONNECTION AT 1.5m. UNLESS OTHERWISE STATED.
i. CONTRACTOR TO PAY ALL FEES & CHARGES ASSOCIATED WITH CONNECTIONS.

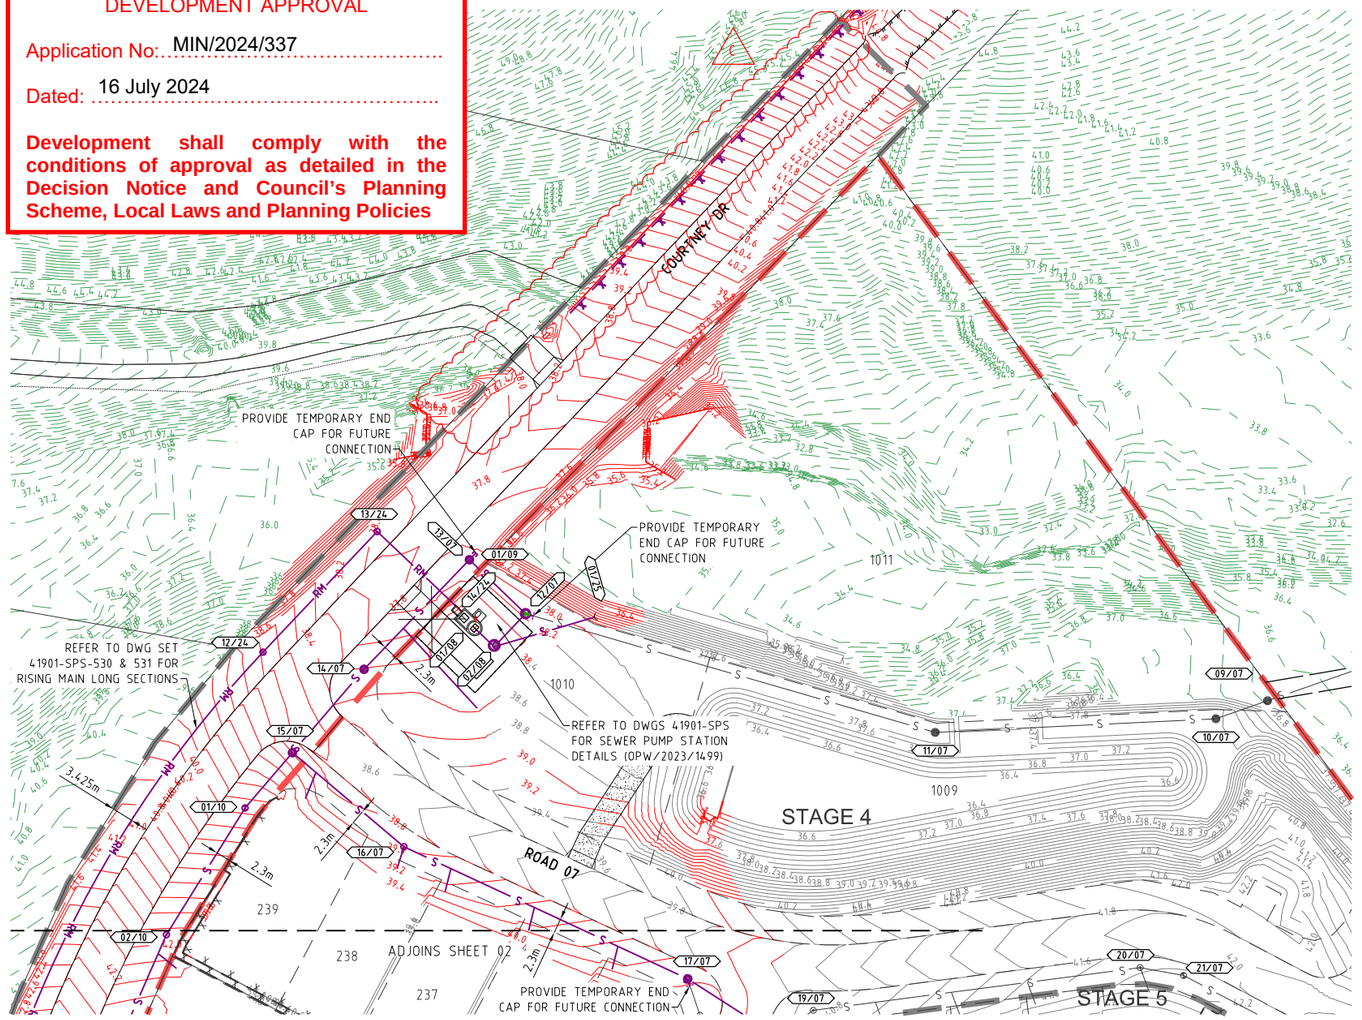


ALL ENVIRONMENT PROTECTION MEASURES SHALL BE IMPLEMENTED PRIOR TO ANY CONSTRUCTION WORK, INCLUDING CLEARING, COMMENCING.

DIAL BEFORE YOU DIG www.1100.com.au

SEWER PIPE SPECIFICATIONS

SEWER MAIN LOCATION	PIPE MATERIAL SPECIFICATION
GRAVITY VERGE	PVC-U SN8
GRAVITY ROAD CROSSING	PVC-U SN8
HOUSE CONNECTIONS	PVC-U SN10
RISING MAIN TRENCHED	PE100 PN16 SDR11

SHEET LAYOUT

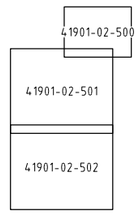

LEGEND

- EXISTING SEWER
- EXISTING RISING MAIN
- EXISTING KERB (INVERT)
- EXISTING PROPERTY LINE
- EXISTING RETAINING WALL
- EXISTING CONTOURS
- FUTURE SEWER
- FUTURE RISING MAIN
- FUTURE KERB (INVERT)
- FUTURE PROPERTY LINE
- FUTURE RETAINING WALL
- FUTURE CONTOURS
- SITE BOUNDARY
- STAGE BOUNDARY
- PROPOSED KERB (INVERT)
- PROPOSED PROPERTY LINE
- PROPOSED RETAINING WALL
- DESIGN CONTOURS
- PROPOSED SEWER
- PROPOSED RISING MAIN
- SEWER MANHOLE
- SEWER RODDING END
- SEWER BEND
- SEWER MAINTENANCE SHAFT
- SEWER END CAP
- SEWER PUMP STATION

SERVICE PROVIDER AND CONSTRUCTOR LIVE SEWER WORKS SCHEDULE

No.	Description	Dia. Sewer	MH No.	MH/MS Type	Cover Type	Lot no	F.S.L	E.S.L	I.L	Depth to invert	Alteration to existing MH benching required (y/n)
1(A)	PLUG EXISTING STUB FROM MH 10/03 CIVIL CONTRACTOR TO LAY NEW LINE 24 AFTER TESTING AND INSPECTING, NOTIFY GOLD COAST WATER AND WASTE AND PROVIDE ALL NECESSARY DOCUMENTATION.	150	10/03	Stub from receiving MH	B	-	56.824	56.824	55.383	1.440	N
1(B)	CONTRACTOR TO MAKE LIVE CONNECTIONS UNDER SUPERVISION OF GOLD COAST WATER AND WASTE. AFTER SUCCESSFUL "ON MAINTENANCE" INSPECTION.										
2(A)	PLUG EXISTING STUB FROM MH 01/20 CIVIL CONTRACTOR TO LAY NEW LINE 20 AFTER TESTING AND INSPECTING, NOTIFY GOLD COAST WATER AND WASTE AND PROVIDE ALL NECESSARY DOCUMENTATION.	150	01/20	Stub from MH	B	-	62.106	62.106	60.304	1.803	N
2(B)	CONTRACTOR TO MAKE LIVE CONNECTIONS UNDER SUPERVISION OF GOLD COAST WATER AND WASTE. AFTER SUCCESSFUL "ON MAINTENANCE" INSPECTION.										
3(A)	PLUG EXISTING STUB FROM MH 01/20 CIVIL CONTRACTOR TO LAY NEW LINE 21 AFTER TESTING AND INSPECTING, NOTIFY GOLD COAST WATER AND WASTE AND PROVIDE ALL NECESSARY DOCUMENTATION.	150	01/20	Stub from MH	B	-	62.106	62.106	60.3843	1.723	N
3(B)	CONTRACTOR TO MAKE LIVE CONNECTIONS UNDER SUPERVISION OF GOLD COAST WATER AND WASTE. AFTER SUCCESSFUL "ON MAINTENANCE" INSPECTION.										

PROJECT NAME

COURTNEY DR UPPER COOMERA

STAGE 02

RP DESCRIPTION

LOT 188, 189, 190, 191 & 192 ON RP173728
COURTNEY DRIVE
LOCALITY OF UPPER COOMERA
LOCAL AUTHORITY - GOLD COAST CITY COUNCIL

CLIENT

HB Land

NORTH

0 5 10 15 20 25m
Scale 1:500 - A1 (1:1000 - A3)

REV	DATE	DESCRIPTION	INT
C	14-06-24	CONTOURS AMENDED	RK
B	29-11-23	NOTES ADDED & CONTOURS AMENDED	BL
A	13-10-23	COUNCIL ISSUE	EP

COPYRIGHT IS VESTED IN MORTONS-URBAN SOLUTIONS AND WRITTEN CONSENT IS REQUIRED PRIOR TO REPRODUCTION. DO NOT SCALE FROM THIS DRAWING.

ASSOCIATED CONSULTANTS

BIOME WATER AND ENVIRONMENTAL CONSULTING
Robin Russell & ASSOCIATES PTY. LTD.
BENNETT+BENNETT

DRAWING TITLE

SEWER RETICULATION PLAN
SHEET 01

MORTONS urbansolutions
Urban & Regional Planning
Civil Engineering
Project Coordination
MUS Pty Ltd T/As:
Mortons-Urban Solutions
ABN: 39 116 375 065
mortons@urbansolutions.net.au
www.urbansolutions.net.au
Tel 07 5571 1099
Postal Address
PO Box 2484
Southport QLD 4215
Gold Coast Office
Suite 9, 19 Short St
Southport QLD 4215

DESIGNED	RB	DRAWN	EP
APPROVED	RPEQ 4706	DATE	13-10-23

DRAWING NUMBER 41901-02-500 REV C


F:\Autocad Client\419 - HB Land\01 - Courtney Drive\Precinct-Stage 02\Engineering Drawings\Current\41901-02-500.dwg, PLAN SHEET 01, 21/06/2024 1:25:28 PM, 1:2

PLANS AND DOCUMENTS referred to in the DEVELOPMENT APPROVAL

Application No: MIN/2024/337

Dated: 16 July 2024

Development shall comply with the conditions of approval as detailed in the Decision Notice and Council's Planning Scheme, Local Laws and Planning Policies

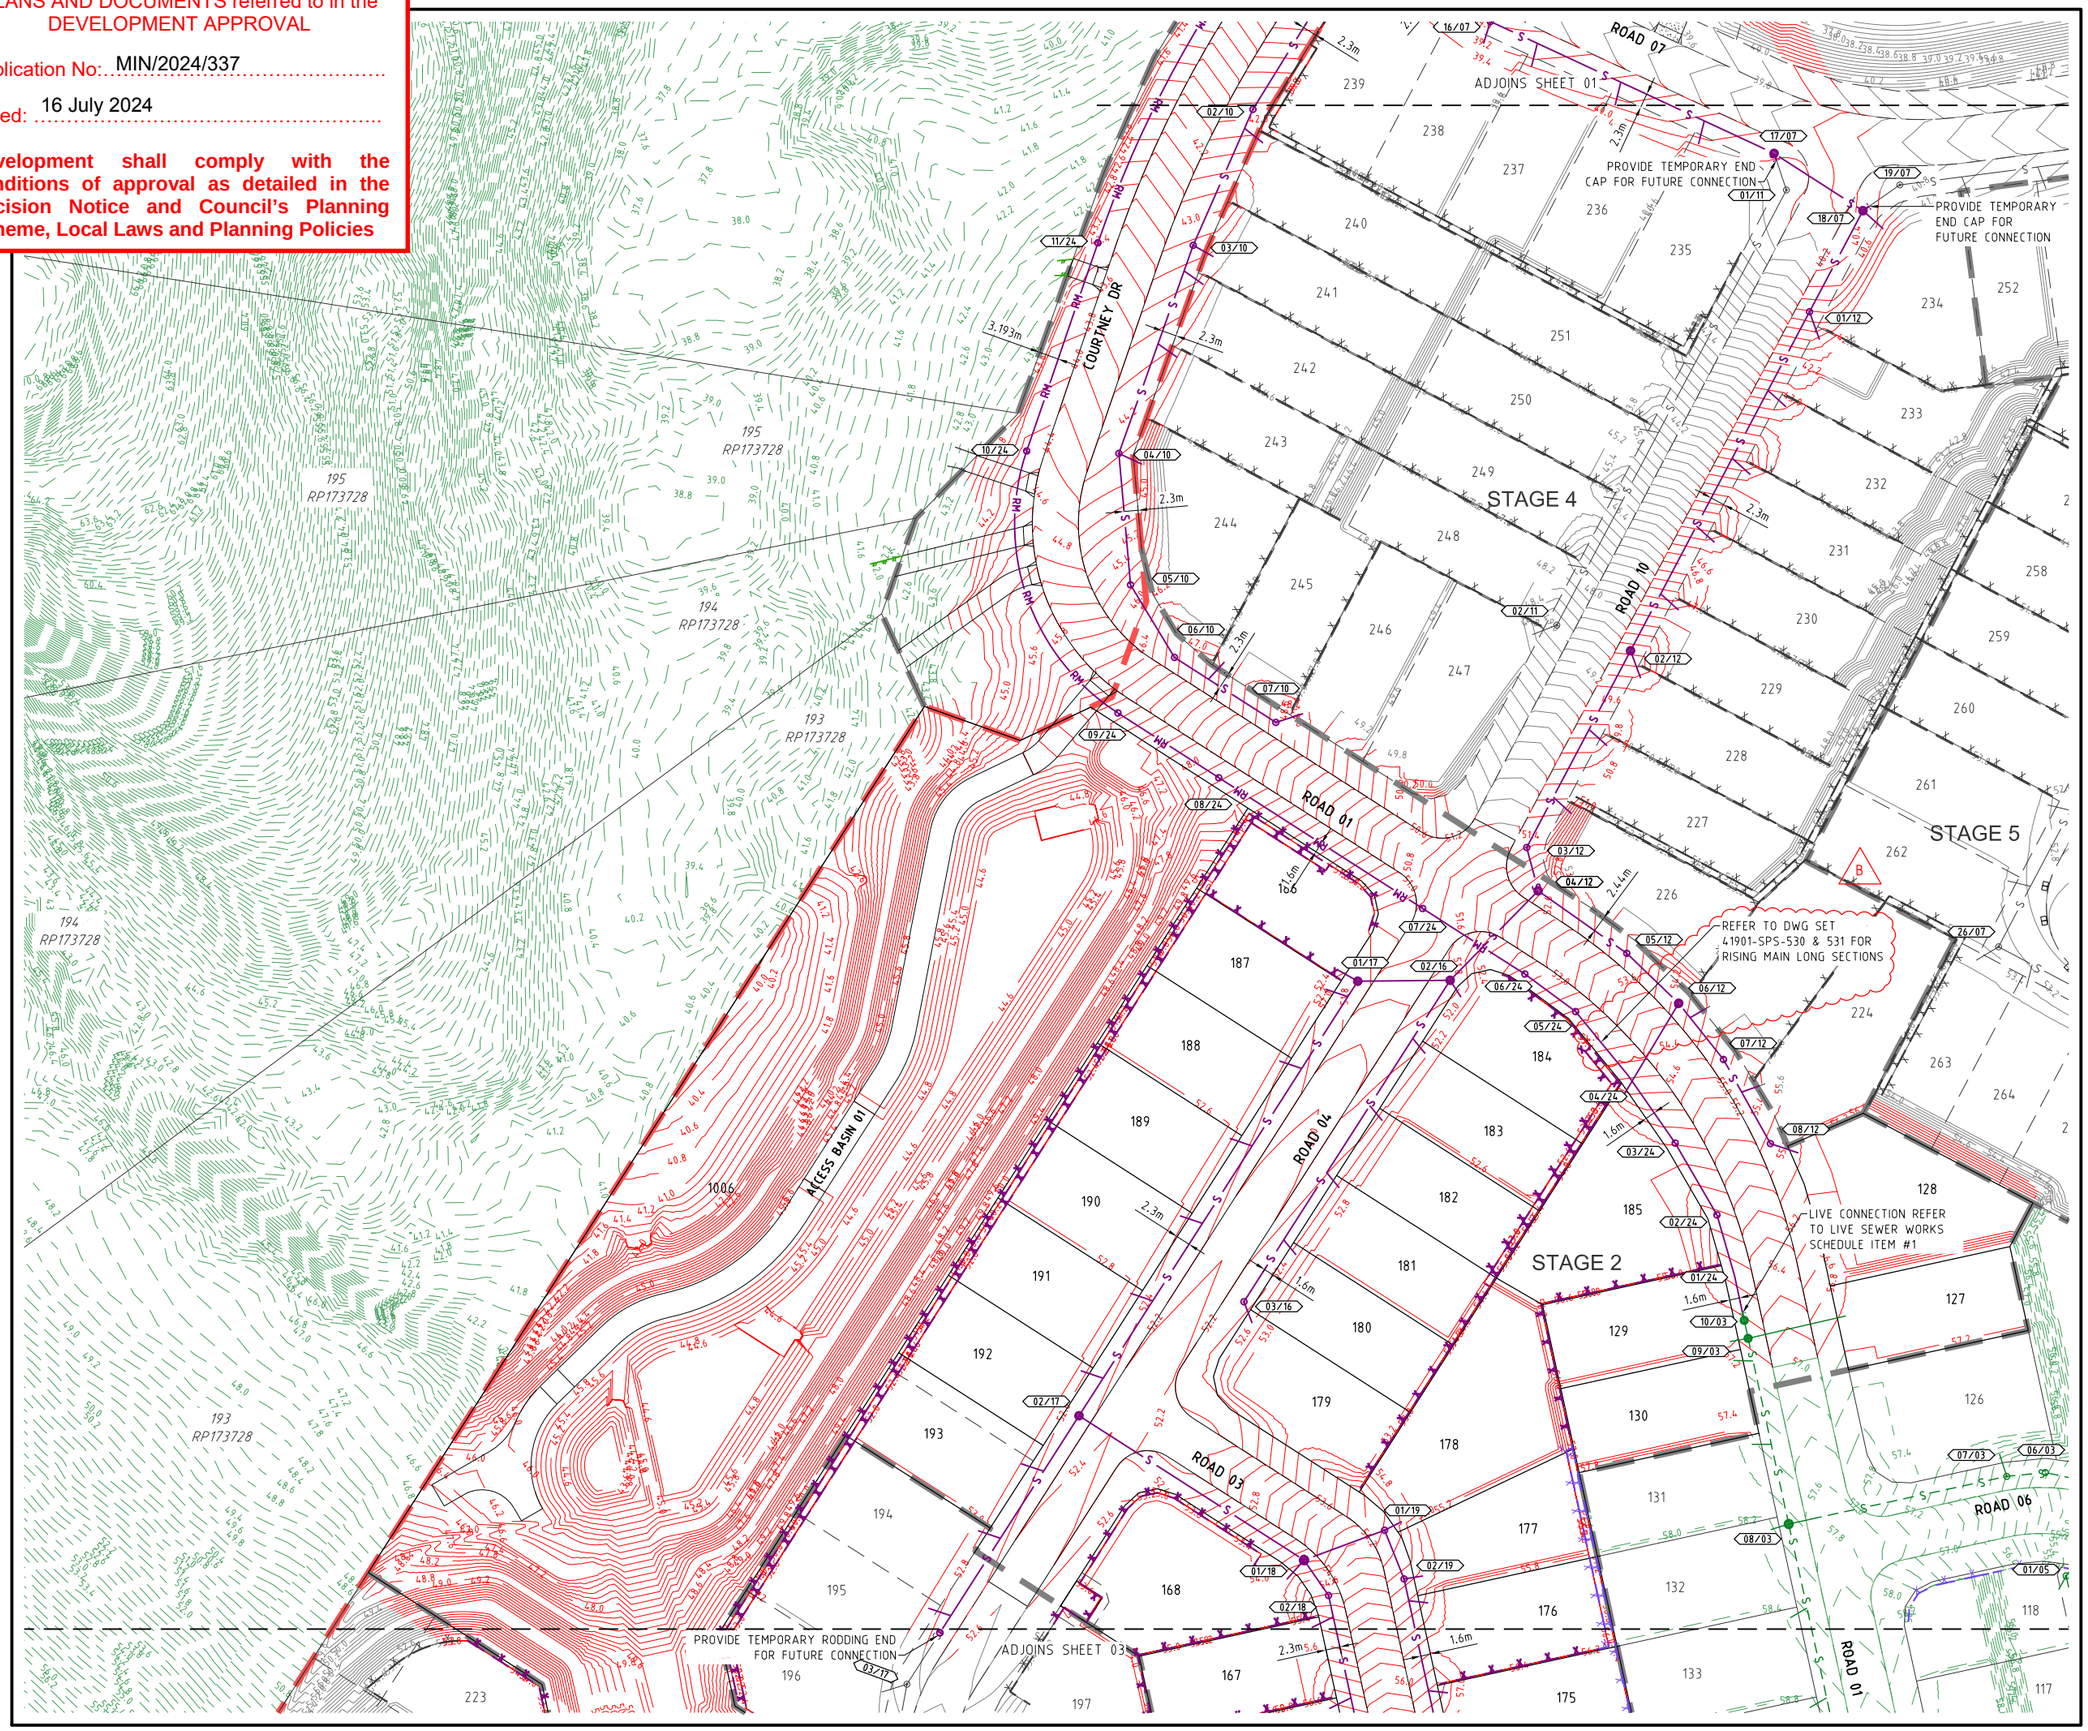

PROJECT NAME

COURTNEY DR UPPER COOMERA

STAGE 02

RP DESCRIPTION

LOT 188, 189, 190, 191 & 192 ON RP173728
COURTNEY DRIVE
LOCALITY OF UPPER COOMERA
LOCAL AUTHORITY - GOLD COAST CITY COUNCIL

CLIENT

HB Land

NORTH

0 5 10 15 20 25m

Scale 1:500 - A1 (1:1000 - A3)

REV	DATE	DESCRIPTION	INT
B	29-11-23	NOTE ADDED	BL
A	13-10-23	COUNCIL ISSUE	EP

COPYRIGHT IS VESTED IN MORTONS-URBAN SOLUTIONS AND WRITTEN CONSENT IS REQUIRED PRIOR TO REPRODUCTION. DO NOT SCALE FROM THIS DRAWING.

ASSOCIATED CONSULTANTS

BIOME WATER AND ENVIRONMENTAL CONSULTING

Robin Russell & ASSOCIATES PTY. LTD.

BENNETT+BENNETT

DRAWING TITLE

SEWER RETICULATION PLAN SHEET 02

MORTONS urbansolutions
Urban & Regional Planning
Civil Engineering
Project Coordination

MUS Pty Ltd T/As:
Mortons-Urban Solutions
ABN 39 116 375 065

mortons@urbansolutions.net.au
www.urbansolutions.net.au
Tel 07 5571 1099


Postal Address
PO Box 2484
Southport QLD 4215

Gold Coast Office
Suite 9, 19 Short St
Southport QLD 4215

DESIGNED	RB	DRAWN	EP
APPROVED	RPEQ 4706	DATE	13-10-23

DRAWING NUMBER	REV
41901-02-501	B

F:\Autocad Client\419 - HB Land\01 - Courtney Drive\Precinct-Stage 02\Engineering Drawings\Current\41901-02-500.dwg, PLAN SHEET 02, 21/06/2024 1:25:42 PM, 1:2

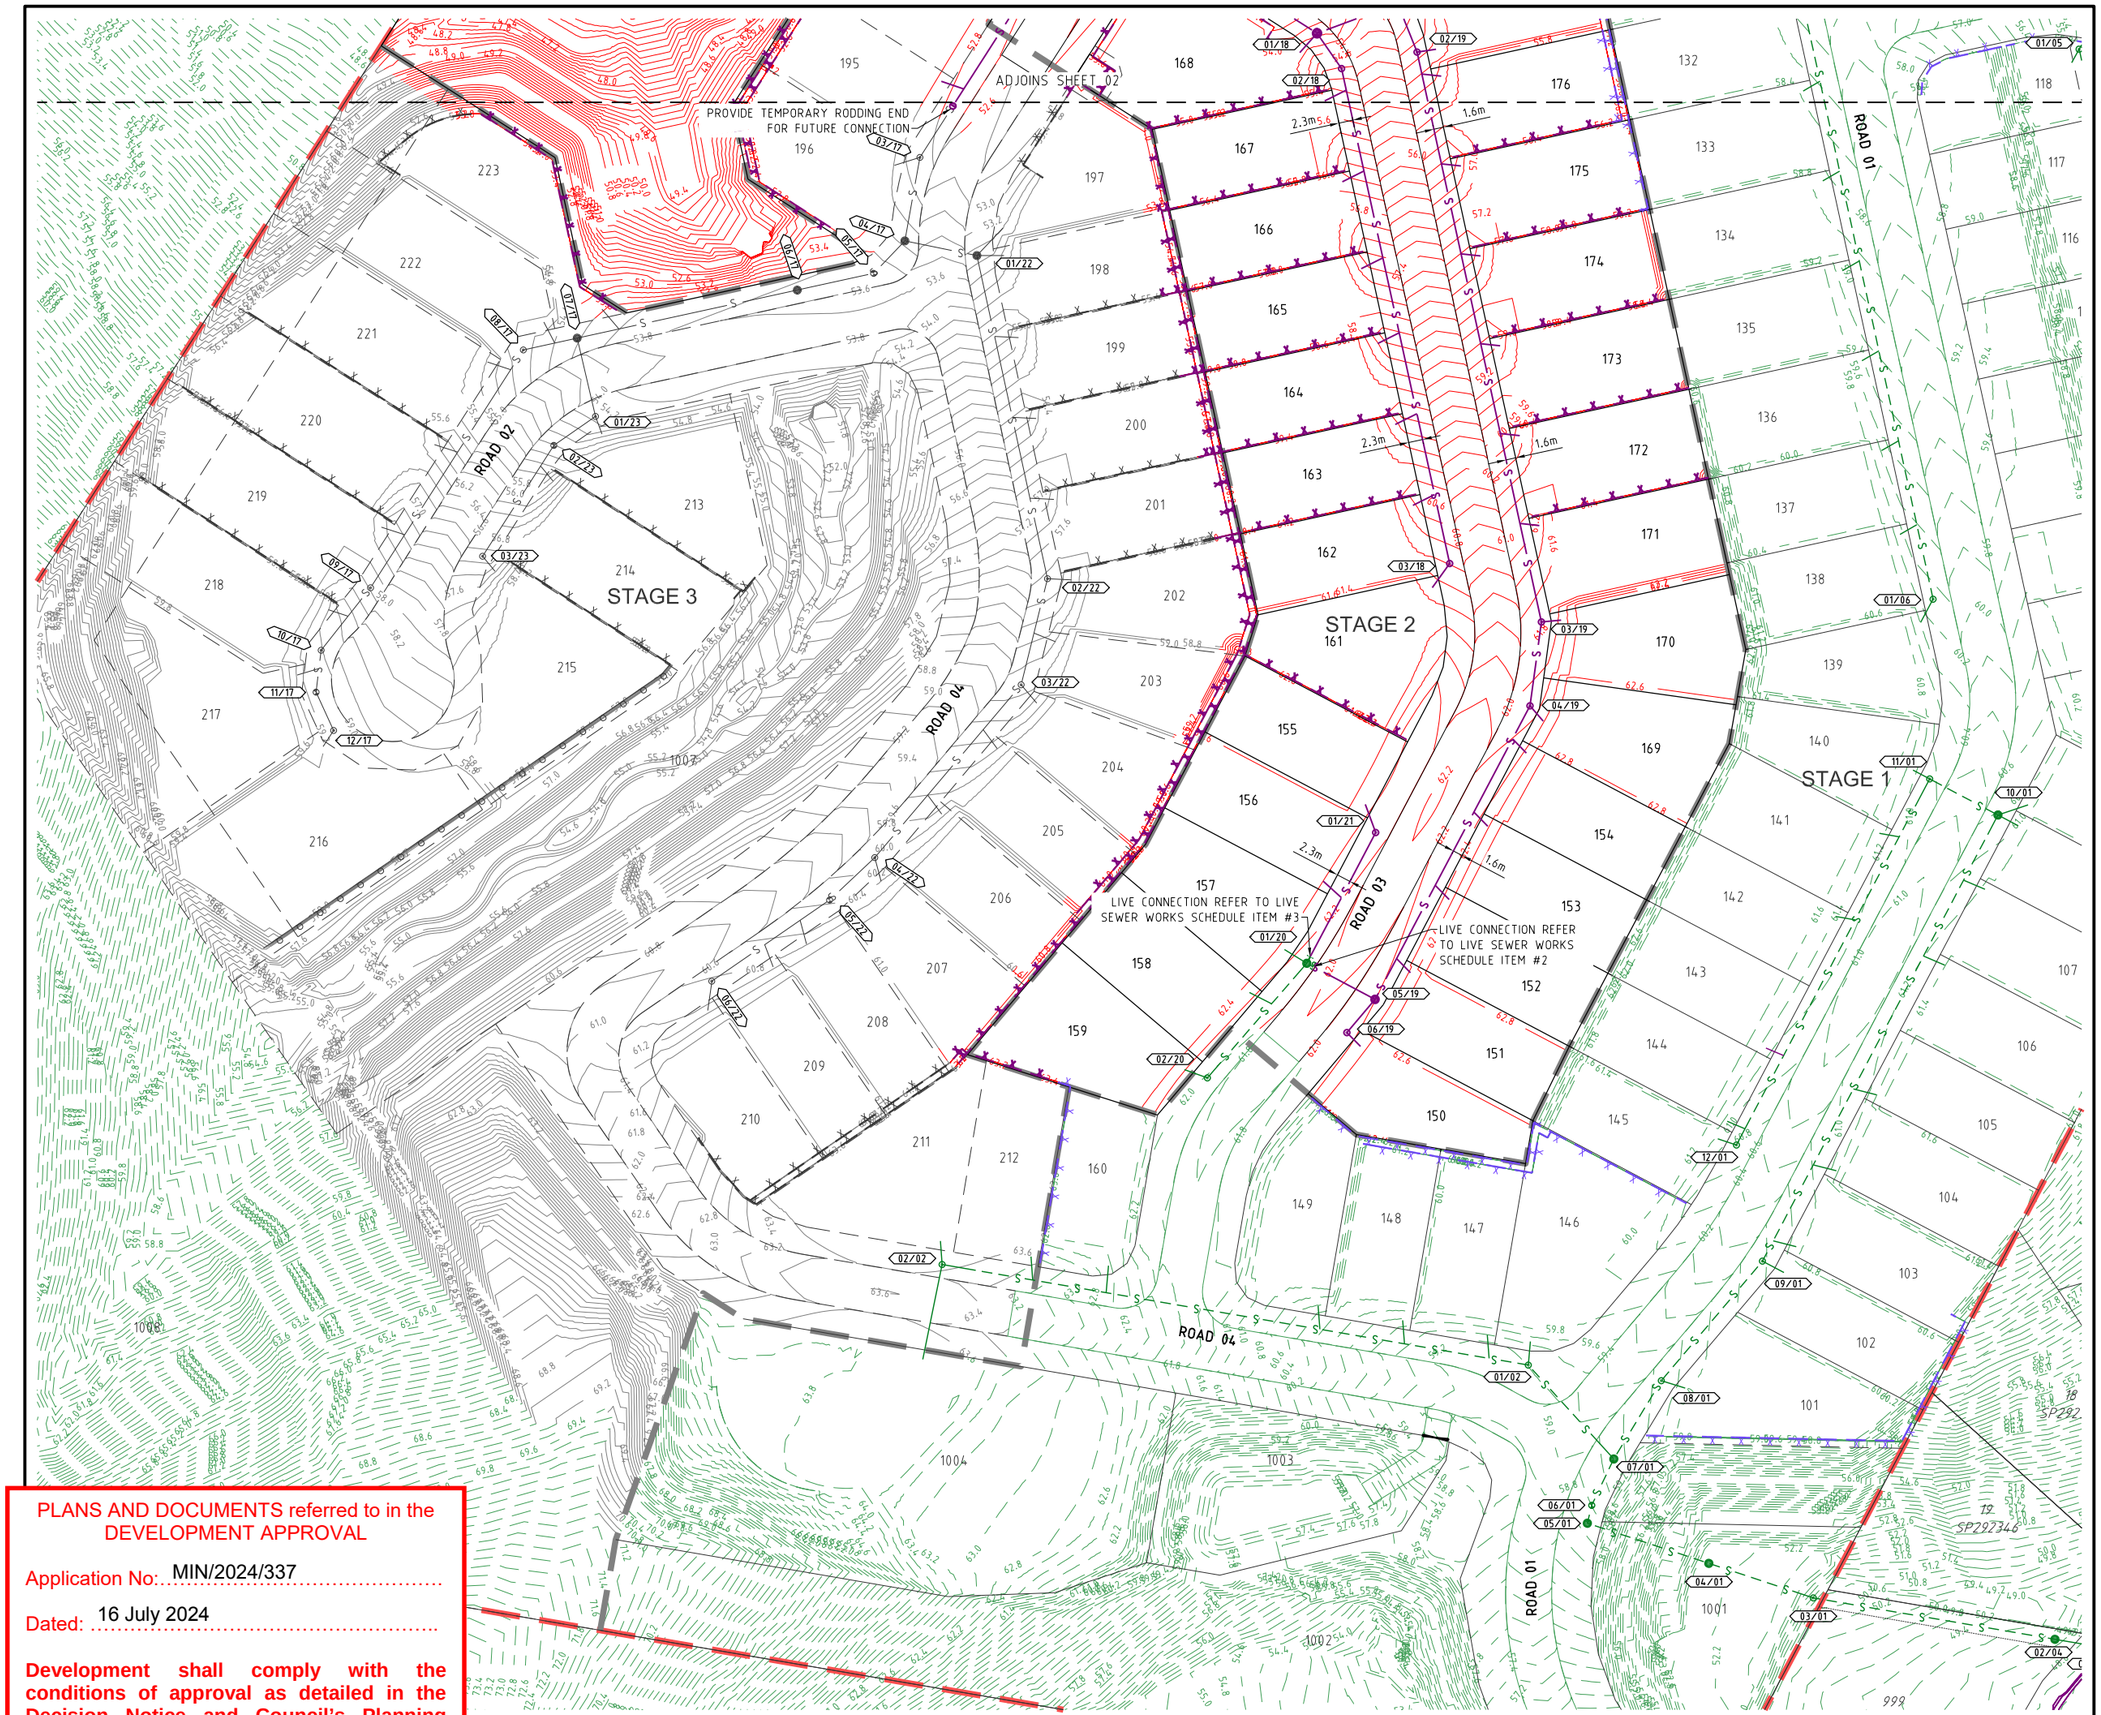

PROJECT NAME

COURTNEY DR UPPER COOMERA

STAGE 02

RP DESCRIPTION

LOT 188, 189, 190, 191 & 192 ON RP173728
COURTNEY DRIVE
LOCALITY OF UPPER COOMERA
LOCAL AUTHORITY - GOLD COAST CITY COUNCIL

CLIENT

HB Land

NORTH

0 5 10 15 20 25m
Scale 1:500 - A1 (1:1000 - A3)

REV	DATE	DESCRIPTION	
A	13-10-23	COUNCIL ISSUE	EP

COPYRIGHT IS VESTED IN MORTONS-URBAN SOLUTIONS AND WRITTEN CONSENT IS REQUIRED PRIOR TO REPRODUCTION. DO NOT SCALE FROM THIS DRAWING.

ASSOCIATED CONSULTANTS

BIOME WATER AND ENVIRONMENTAL CONSULTING
Robin Russell & ASSOCIATES PTY. LTD.
BENNETT + BENNETT

DRAWING TITLE

SEWER RETICULATION PLAN
SHEET 03

MORTONS urbansolutions
Urban & Regional Planning
Civil Engineering
Project Coordination

MUS Pty Ltd T/As:
Mortons-Urban Solutions
ABN: 39 116 375 065
mortons@urbansolutions.net.au
www.urbansolutions.net.au
Tel 07 5571 1099

Postal Address
PO Box 2484
Southport QLD 4215

Gold Coast Office
Suite 9, 19 Short St
Southport QLD 4215

DESIGNED	RB	DRAWN	EP
APPROVED		RPEQ 4706	DATE 13-10-23

DRAWING NUMBER 41901-02-502 REV A


PLANS AND DOCUMENTS referred to in the DEVELOPMENT APPROVAL

Application No: MIN/2024/337

Dated: 16 July 2024


Development shall comply with the conditions of approval as detailed in the Decision Notice and Council's Planning Scheme, Local Laws and Planning Policies

F:\Autocad Client\419 - HB Land\01 - Courtney Drive\Precinct-Stage 02\Engineering Drawings\Current\41901-02-500.dwg, PLAN SHEET 03, 21/06/2024 12:58:03 PM, 1:2

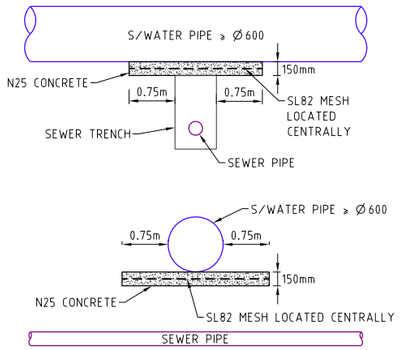

BRIDGING DETAILS FOR STORMWATER PIPES ≥ Ø600


NOT TO SCALE

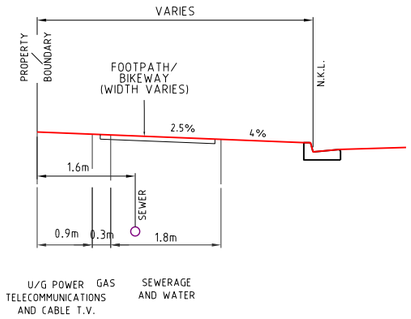

G.C.C.C. TYPICAL SERVICES SEWER RETICULATION ONLY

SCALE 1:50 - A1 (1:100 - A3)

1. PUBLIC UTILITIES ALLOCATIONS ARE MEASURED FROM THE REAL PROPERTY BOUNDARY.
2. LIGHT POLE, TREE ALLOCATIONS AND FOOTPATHS ARE MEASURED FROM THE NOMINAL KERB LINE.

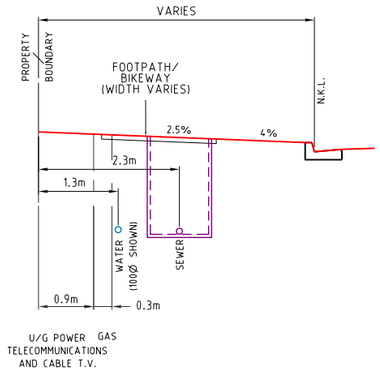

G.C.C.C. TYPICAL POTABLE WATER AND SEWER RETICULATION (SAME SIDE)

SCALE 1:50

PLANS AND DOCUMENTS referred to in the DEVELOPMENT APPROVAL

Application No: MIN/2024/337

Dated: 16 July 2024

Development shall comply with the conditions of approval as detailed in the Decision Notice and Council's Planning Scheme, Local Laws and Planning Policies

F:\Autocad Client\419 - HB Land\01 - Courtney Drive\Precinct-Stage 02\Engineering Drawings\Current\41901-02-510.dwg, DETAILS, 21/06/2024 1:26:10 PM, 1:2

PROJECT NAME

COURTNEY DR UPPER COOMERA

STAGE 02

RP DESCRIPTION

LOT 188, 189, 190, 191 & 192 ON RP173728
COURTNEY DRIVE
LOCALITY OF UPPER COOMERA
LOCAL AUTHORITY - GOLD COAST CITY COUNCIL

CLIENT

HB Land

0 0.5 1.0 1.5 2.0 2.5m
Scale 1:50 - A1 (1:100 - A3)

REV	DATE	DESCRIPTION	INT
A	13-10-23	COUNCIL ISSUE	EP

COPYRIGHT IS VESTED IN MORTONS-URBAN SOLUTIONS AND WRITTEN CONSENT IS REQUIRED PRIOR TO REPRODUCTION.
DO NOT SCALE FROM THIS DRAWING.

ASSOCIATED CONSULTANTS

BIOME WATER AND ENVIRONMENTAL CONSULTING
Robin Russell & ASSOCIATES PTY. LTD.
BENNETT + BENNETT

DRAWING TITLE

SEWER RETICULATION DETAILS

MORTONS urbansolutions
Urban & Regional Planning
Civil Engineering
Project Coordination
MUS Pty Ltd T/As:
Mortons-Urban Solutions
ABN: 39 116 375 065
mortons@urbansolutions.net.au
www.urbansolutions.net.au
Tel 07 5571 1099
Postal Address
PO Box 2484
Southport QLD 4215
Gold Coast Office
Suite 9, 19 Short St
Southport QLD 4215

DESIGNED	RB	DRAWN	EP
APPROVED	RPEQ 4706	DATE	13-10-23

DRAWING NUMBER: 41901-02-510
REV: A

SEWER STRUCTURE LIDS

D	TRAFFICABLE LID
B	NON-TRAFFICABLE LID
M	'M' PREFIX DESIGNATES BOLT DOWN LID

RIGS STRUCTURE TYPES

P(x)	PRECAST CONCRETE SEWER MAINTENANCE STRUCTURE REFER TO SEQ STD DWG SEQ-SEW-1300-1
A	TYPE 'A' 1050mm DIA. MAINTENANCE STRUCTURE REFER TO SEQ STD DWGS SEQ-SEW-1307-1
B	TYPE 'B' 1200mm DIA. MAINTENANCE STRUCTURE REFER TO SEQ STD DWGS SEQ-SEW-1307-1
C	TYPE 'C' 1500mm DIA. MAINTENANCE STRUCTURE REFER TO SEQ STD DWGS SEQ-SEW-1307-1
J1	TYPE 'J1' MAINTENANCE STRUCTURE REFER TO SEQ STD DWGS SEQ-SEW-1314-2
BND	BEND REFER TO SEQ STD DWGS SEQ-SEW-1314-3
RE	RODDING END MAINTENANCE STRUCTURE REFER TO SEQ STD DWGS SEQ-SEW-1314-1
END	PROPRIETORY END CAP
PS	SEWER PUMP STATION REFER TO RELEVANT SEQ STD DWGS
RCM	RECEIVING MAINTENANCE STRUCTURE REFER TO RELEVANT SEQ STD SEWER PUMP STATION DWGS
G6	TYPE 'G6' TERMINAL MAINTENANCE SHAFT REFER TO SEQ STD DWGS SEQ-SEW-1314-1

RIGS STRUCTURE DROPS

V	STRAIGHT THROUGH SEWER REFER TO SEQ STD DWG SEQ-SEW-1303-1
W	OBLIQUE BACKDROP REFER TO SEQ STD DWG SEQ-SEW-1303-1
X	INTERNAL BACKDROP REFER TO SEQ STD DWG SEQ-SEW-1303-1
Y	EXTERNAL BACKDROP REFER TO SEQ STD DWG SEQ-SEW-1303-1


STRUCTURE TYPE
LID CLASS
DROP TYPE

* CONSTRUCT BRIDGING STRUCTURE SPANNING THE SEWER TRENCH REFER TYPICAL SECTIONS & DETAILS FOR BRIDGING STRUCTURE DETAILS

| TRENCHSTOPS, BULKHEADS & CONCRETE ENCASEMENTS TO BE INSTALLED IN ACCORDANCE WITH SEQ SEWER CODE

NOTES

1. IF SHOWN, WATER AND ELECTRICAL CROSSING LOCATIONS ARE INDICATIVE ONLY. REFER TO PLANS TO DETERMINE CROSSING LOCATIONS. WHERE SERVICE INDICATES CLASH WITH SEWER, SEWER TO TAKE PRECEDENCE, SERVICE TO BE CONSTRUCTED OVER OR UNDER SEWER ACCORDING TO SUPERINTENDENTS INSTRUCTION
2. ALL GRAVITY uPVC SEWER PIPE TO BE CLASS SN8 U.N.O.
3. ALL PRESSURE MAINS PE100 PN16 SDR11
4. ALL EMBEDMENT TYPE IS TO BE TYPE 3 U.N.O
5. ALL BENDS TO BE LONG RADIUS BEND, 1.2m RADIUS MIN.
6. CONTRACTOR TO VERIFY DOWNSTREAM EXISTING PIPE LEVELS PRIOR TO COMMENCEMENT OF PIPEWORK
7. PROTECTIVE COATING IS TO BE INSTALLED TO MAINTENANCE STRUCTURES (WHERE REQUIRED) IN ACCORDANCE WITH CLAUSE 4.7.2 OF SEQ SEWERAGE CODE.
8. TRENCHSTOPS IN ACCORDANCE WITHSEQ-WAT-1209-1

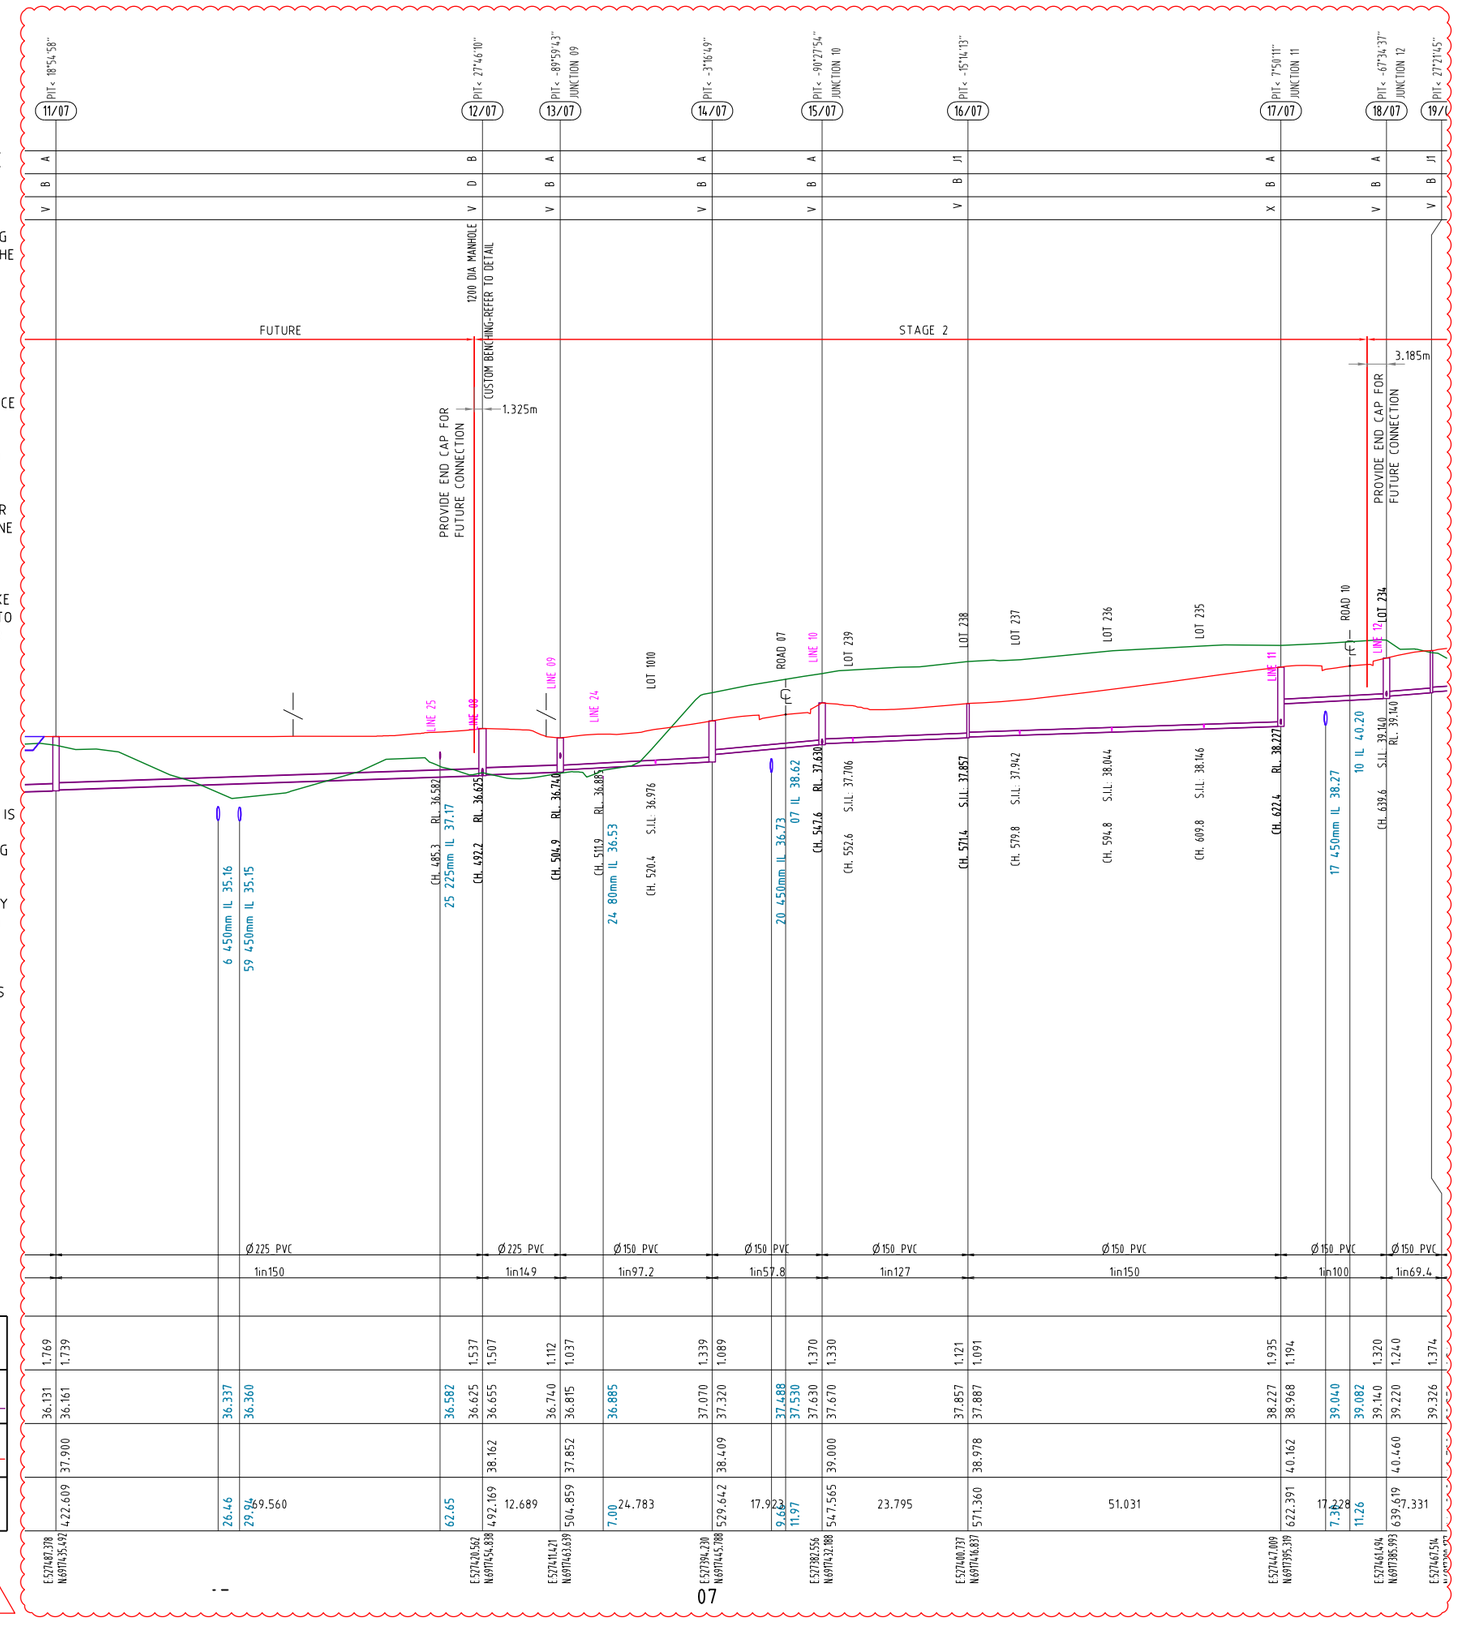

PLANS AND DOCUMENTS referred to in the DEVELOPMENT APPROVAL

Application No: MIN/2024/337

Dated: 16 July 2024

Development shall comply with the conditions of approval as detailed in the Decision Notice and Council's Planning Scheme, Local Laws and Planning Policies

DIAL BEFORE YOU DIG www.1100.com.au

PROJECT NAME

COURTNEY DR UPPER COOMERA

STAGE 02

RP DESCRIPTION

LOT 188, 189, 190, 191 & 192 ON RP173728
COURTNEY DRIVE
LOCALITY OF UPPER COOMERA
LOCAL AUTHORITY - GOLD COAST CITY COUNCIL

CLIENT

HB Land

0 5 10 15 20 25m
Horiz. Scale 1:500 - A1 (1:1000 - A3)

0 1 2 3 4 5m
Vert. Scale 1:100 - A1 (1:200 - A3)

REV	DATE	DESCRIPTION	INT
B	17-01-24	PROFILE AMENDED	EP
A	13-10-23	COUNCIL ISSUE	EP

COPYRIGHT IS VESTED IN MORTONS-URBAN SOLUTIONS AND WRITTEN CONSENT IS REQUIRED PRIOR TO REPRODUCTION. DO NOT SCALE FROM THIS DRAWING.

ASSOCIATED CONSULTANTS

BIOME WATER AND ENVIRONMENTAL CONSULTING
Robin Russell & ASSOCIATES PTY. LTD.
BENNETT+BENNETT

DRAWING TITLE

SEWER RETICULATION
PROFILES
SHEET 01

MORTONS urbansolutions
Urban & Regional Planning
Civil Engineering
Project Coordination
MUS Pty Ltd T/As:
Mortons-Urban Solutions
ABN: 39 116 375 065
mortons@urbansolutions.net.au
www.urbansolutions.net.au
Tel 07 5571 1099
Postal Address
PO Box 2484
Southport QLD 4215
Gold Coast Office
Suite 9, 19 Short St
Southport QLD 4215

DESIGNED	RB	DRAWN	EP
APPROVED	RPEQ 4706	DATE	13-10-23

DRAWING NUMBER 41901-02-530 | REV B

F:\Autocad Client\419 - HB Land\01 - Courtney Drive\Precinct-Stage 02\Engineering Drawings\Current\41901-02-530.dwg, SHEET 01, 21/06/2024 1:26:14 PM, 1:2

PLANS AND DOCUMENTS referred to in the DEVELOPMENT APPROVAL

Application No: MIN/2024/337

Dated: 16 July 2024

Development shall comply with the conditions of approval as detailed in the Decision Notice and Council's Planning Scheme, Local Laws and Planning Policies


STRUCTURE TYPE
LID CLASS
DROP TYPE

* CONSTRUCT BRIDGING STRUCTURE SPANNING THE SEWER TRENCH REFER TYPICAL SECTIONS & DETAILS FOR BRIDGING STRUCTURE DETAILS

| TRENCHSTOPS, BULKHEADS & CONCRETE ENCASEMENTS TO BE INSTALLED IN ACCORDANCE WITH SEQ SEWER CODE

NOTES

1. IF SHOWN, WATER AND ELECTRICAL CROSSING LOCATIONS ARE INDICATIVE ONLY. REFER TO PLANS TO DETERMINE CROSSING LOCATIONS. WHERE SERVICE INDICATES CLASH WITH SEWER, SEWER TO TAKE PRECEDENCE, SERVICE TO BE CONSTRUCTED OVER OR UNDER SEWER ACCORDING TO SUPERINTENDENTS INSTRUCTION
2. ALL GRAVITY uPVC SEWER PIPE TO BE CLASS SN8 U.N.O.
3. ALL PRESSURE MAINS PE100 PN16 SDR11
4. ALL EMBEDMENT TYPE IS TO BE TYPE 3 U.N.O
5. ALL BENDS TO BE LONG RADIUS BEND, 1.2m RADIUS MIN.
6. CONTRACTOR TO VERIFY DOWNSTREAM EXISTING PIPE LEVELS PRIOR TO COMMENCEMENT OF PIPEWORK
7. PROTECTIVE COATING IS TO BE INSTALLED TO MAINTENANCE STRUCTURES (WHERE REQUIRED) IN ACCORDANCE WITH CLAUSE 4.7.2 OF SEQ SEWERAGE CODE.
8. TRENCHSTOPS IN ACCORDANCE WITHSEQ-WAT-1209-1

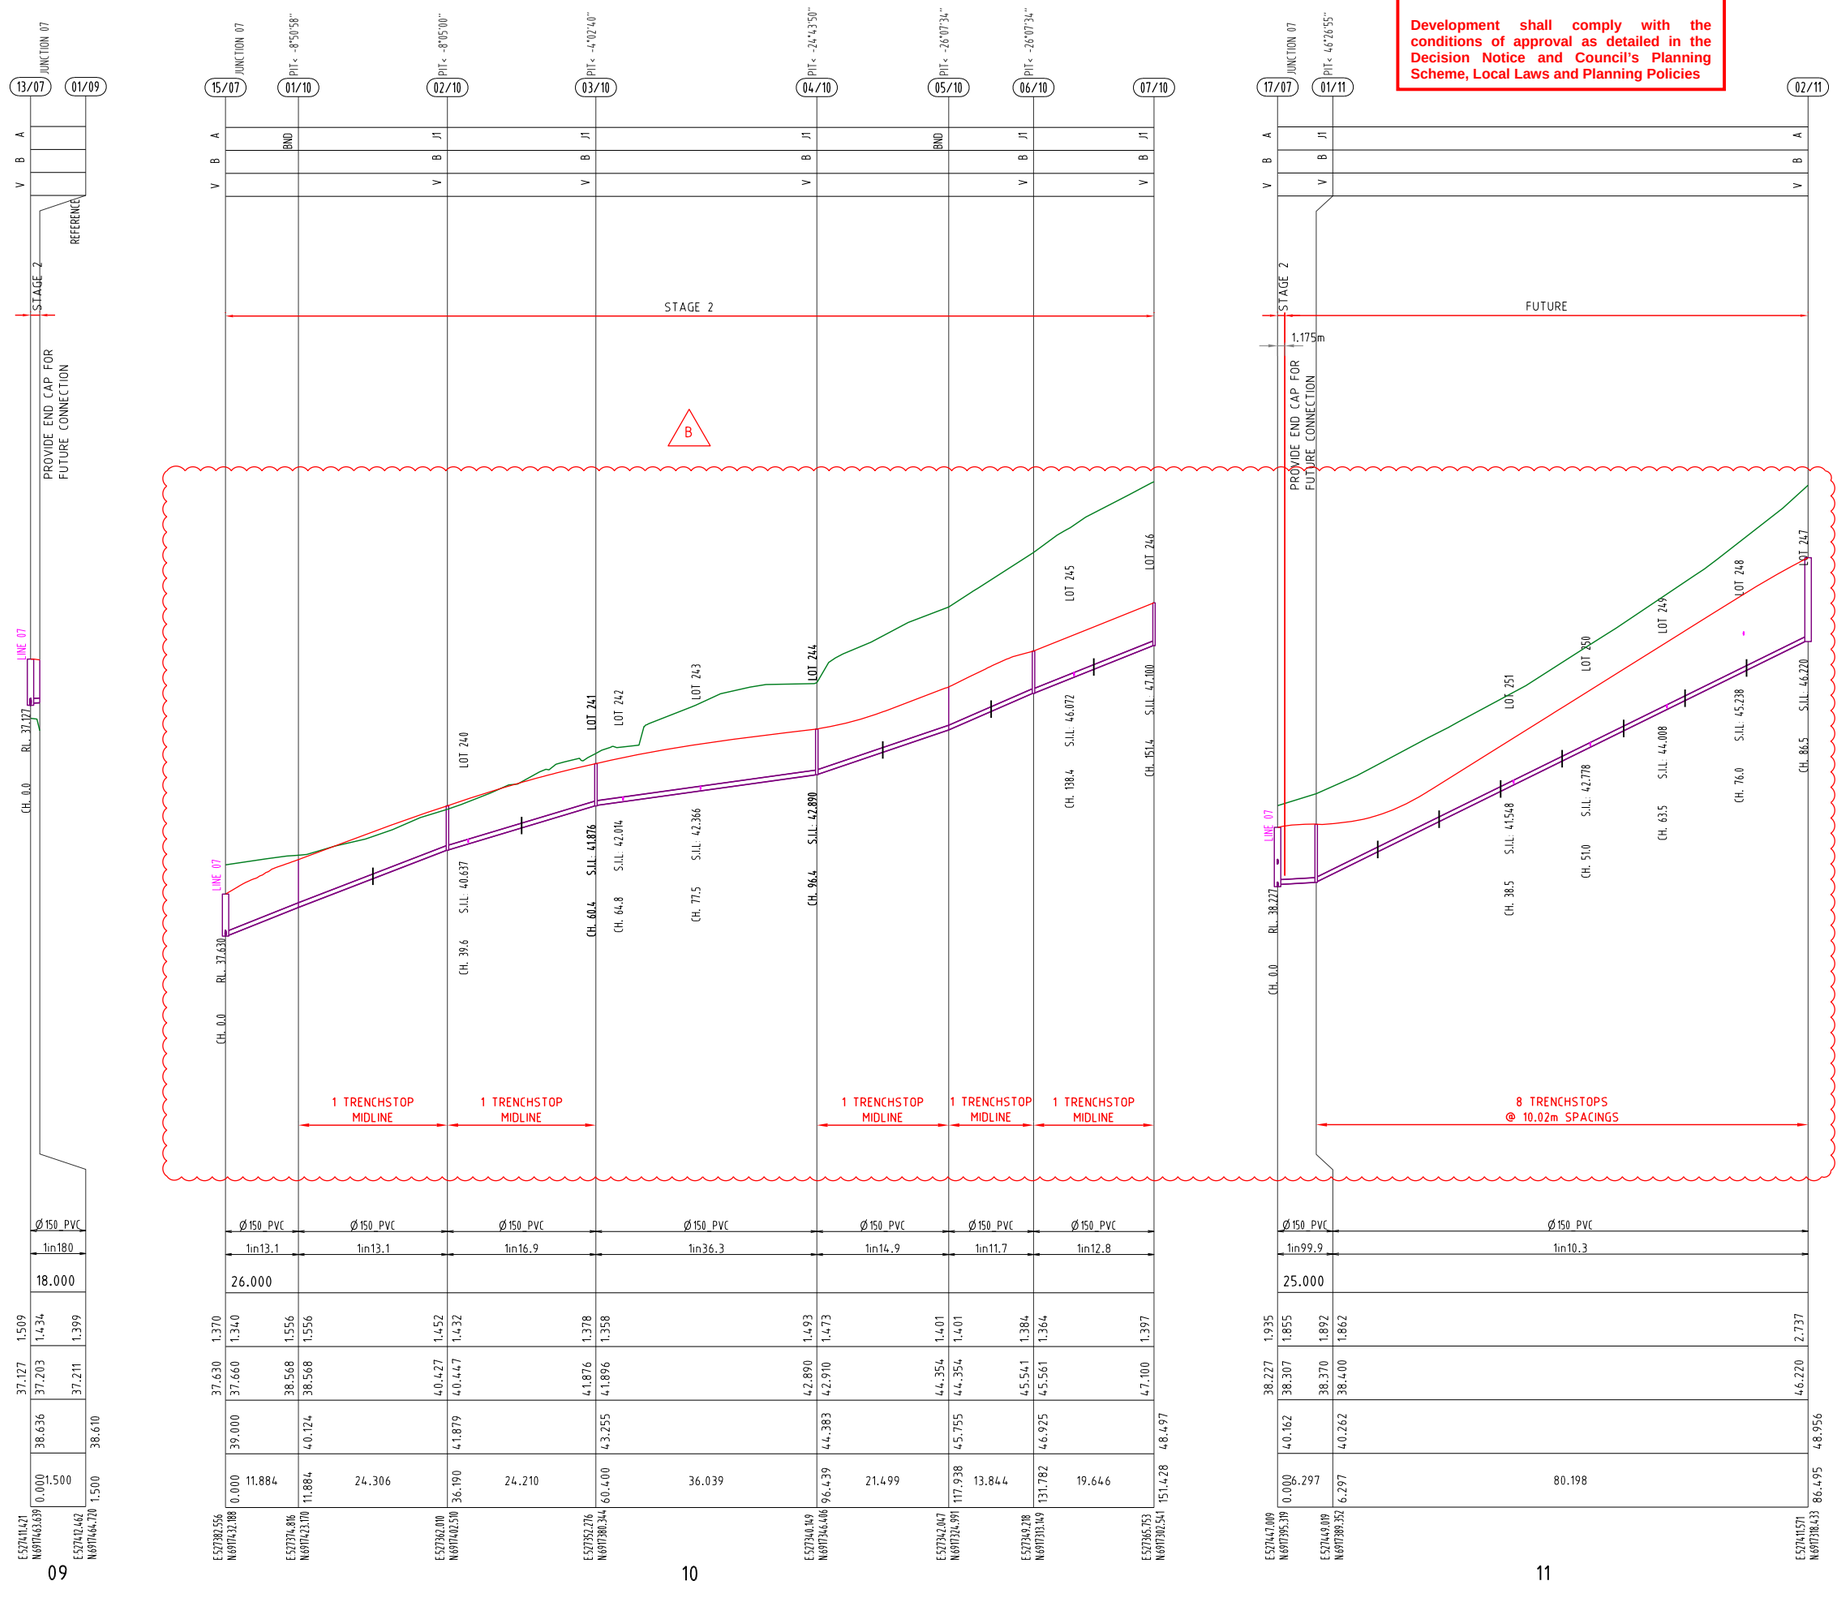

PROJECT NAME

COURTNEY DR
UPPER COOMERA

STAGE 02

RP DESCRIPTION

LOT 188, 189, 190, 191 & 192 ON RP173728
COURTNEY DRIVE
LOCALITY OF UPPER COOMERA
LOCAL AUTHORITY - GOLD COAST CITY COUNCIL

CLIENT

HB Land

0 5 10 15 20 25m
Horiz. Scale 1:500 - A1 (1:1000 - A3)

0 1 2 3 4 5m
Vert. Scale 1:100 - A1 (1:200 - A3)

REV	DATE	DESCRIPTION	INT
B	29-11-23	TRENCH STOPS ADDED	BL
A	13-10-23	COUNCIL ISSUE	EP

COPYRIGHT IS VESTED IN MORTONS-URBAN SOLUTIONS AND WRITTEN CONSENT IS REQUIRED PRIOR TO REPRODUCTION. DO NOT SCALE FROM THIS DRAWING.

ASSOCIATED CONSULTANTS

BIOME WATER AND ENVIRONMENTAL CONSULTING

Robin Russell & ASSOCIATES PTY. LTD.

BENNETT + BENNETT

DRAWING TITLE

SEWER RETICULATION
PROFILES
SHEET 02

MORTONS urbansolutions
Urban & Regional Planning
Civil Engineering
Project Coordination

MUS Pty Ltd T/As:
Mortons-Urban Solutions
ABN: 39 116 375 065

mortons@urbansolutions.net.au
www.urbansolutions.net.au
Tel 07 5571 1099

Postal Address
PO Box 2484
Southport QLD 4215

Gold Coast Office
Suite 9, 19 Short St
Southport QLD 4215

DESIGNED	RB	DRAWN	EP
APPROVED	RPEQ 4706	DATE	13-10-23

DRAWING NUMBER	REV
41901-02-531	B

F:\Autocad Client\419 - HB Land\01 - Courtney Drive\Precinct-Stage 02\Engineering Drawings\Current\41901-02-530.dwg, SHEET 02, 21/06/2024 1:26:17 PM, 1:2

STRUCTURE TYPE
LID CLASS
DROP TYPE

* CONSTRUCT BRIDGING STRUCTURE SPANNING THE SEWER TRENCH REFER TYPICAL SECTIONS & DETAILS FOR BRIDGING STRUCTURE DETAILS

| TRENCHSTOPS, BULKHEADS & CONCRETE ENCASEMENTS TO BE INSTALLED IN ACCORDANCE WITH SEQ SEWER CODE

NOTES


1. IF SHOWN, WATER AND ELECTRICAL CROSSING LOCATIONS ARE INDICATIVE ONLY. REFER TO PLANS TO DETERMINE CROSSING LOCATIONS. WHERE SERVICE INDICATES CLASH WITH SEWER, SEWER TO TAKE PRECEDENCE, SERVICE TO BE CONSTRUCTED OVER OR UNDER SEWER ACCORDING TO SUPERINTENDENTS INSTRUCTION
2. ALL GRAVITY uPVC SEWER PIPE TO BE CLASS SN8 U.N.O.
3. ALL PRESSURE MAINS PE100 PN16 SDR11
4. ALL EMBEDMENT TYPE IS TO BE TYPE 3 U.N.O
5. ALL BENDS TO BE LONG RADIUS BEND, 1.2m RADIUS MIN.
6. CONTRACTOR TO VERIFY DOWNSTREAM EXISTING PIPE LEVELS PRIOR TO COMMENCEMENT OF PIPEWORK
7. PROTECTIVE COATING IS TO BE INSTALLED TO MAINTENANCE STRUCTURES (WHERE REQUIRED) IN ACCORDANCE WITH CLAUSE 4.7.2 OF SEQ SEWERAGE CODE.
8. TRENCHSTOPS IN ACCORDANCE WITHSEQ-WAT-1209-1

PLANS AND DOCUMENTS referred to in the DEVELOPMENT APPROVAL

Application No: MIN/2024/337

Dated: 16 July 2024

Development shall comply with the conditions of approval as detailed in the Decision Notice and Council's Planning Scheme, Local Laws and Planning Policies

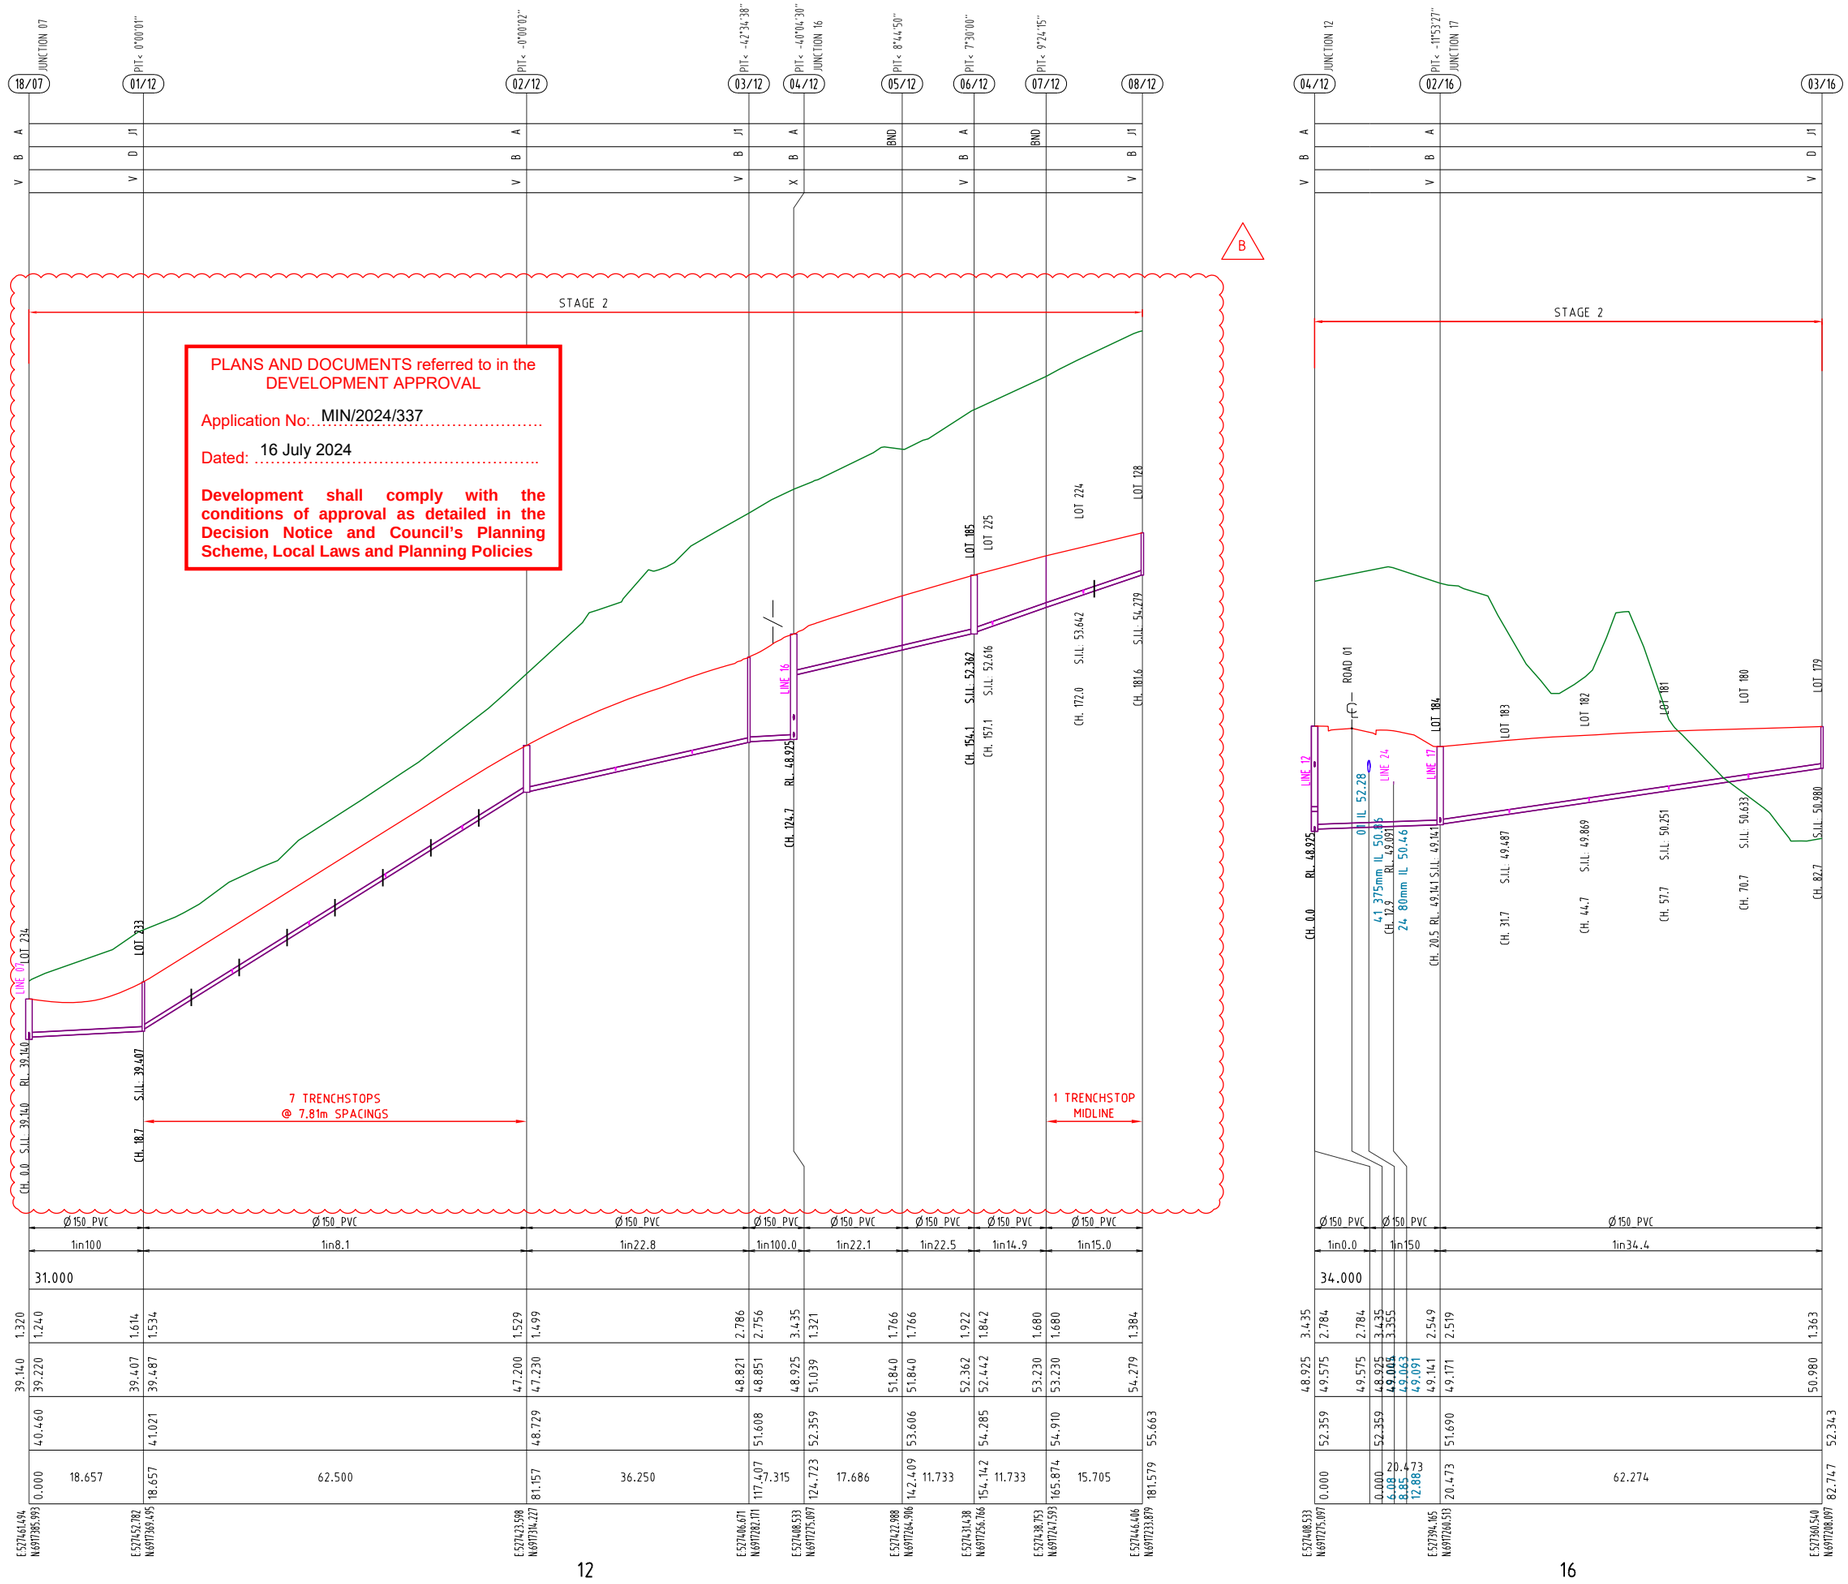

PROJECT NAME

COURTNEY DR UPPER COOMERA

STAGE 02

RP DESCRIPTION

LOT 188, 189, 190, 191 & 192 ON RP173728
COURTNEY DRIVE
LOCALITY OF UPPER COOMERA
LOCAL AUTHORITY - GOLD COAST CITY COUNCIL

CLIENT

HB Land

0 5 10 15 20 25m
Horiz. Scale 1:500 - A1 (1:1000 - A3)

0 1 2 3 4 5m
Vert. Scale 1:100 - A1 (1:200 - A3)

REV	DATE	DESCRIPTION	INT
B	17-01-24	TEXT ADDED & TRENCHSTOPS AMENDED	EP
A	13-10-23	COUNCIL ISSUE	EP

COPYRIGHT IS VESTED IN MORTONS-URBAN SOLUTIONS AND WRITTEN CONSENT IS REQUIRED PRIOR TO REPRODUCTION. DO NOT SCALE FROM THIS DRAWING.

ASSOCIATED CONSULTANTS

BIOME WATER AND ENVIRONMENTAL CONSULTING
Robin Russell & ASSOCIATES PTY. LTD.
BENNETT+BENNETT

DRAWING TITLE

SEWER RETICULATION
PROFILES
SHEET 03

MORTONS urbansolutions
Urban & Regional Planning
Civil Engineering
Project Coordination
MUS Pty Ltd T/As:
Mortons-Urban Solutions
ABN: 39 116 375 065
mortons@urbansolutions.net.au
www.urbansolutions.net.au
Tel 07 5571 1099
Postal Address
PO Box 2484
Southport QLD 4215
Gold Coast Office
Suite 9, 19 Short St
Southport QLD 4215

DESIGNED	RB	DRAWN	EP
APPROVED	RPEQ 4706	DATE	13-10-23

DRAWING NUMBER 41901-02-532
REV B

F:\Autocad Client\419 - HB Land\01 - Courtney Drive\Precinct-Stage 02\Engineering Drawings\Current\41901-02-53Dwg, SHEET 03, 21/06/2024 1:26:19 PM, 1:2

PLANS AND DOCUMENTS referred to in the DEVELOPMENT APPROVAL

Application No: MIN/2024/337

Dated: 16 July 2024

Development shall comply with the conditions of approval as detailed in the Decision Notice and Council's Planning Scheme, Local Laws and Planning Policies


STRUCTURE TYPE
LID CLASS
DROP TYPE

* CONSTRUCT BRIDGING STRUCTURE SPANNING THE SEWER TRENCH REFER TYPICAL SECTIONS & DETAILS FOR BRIDGING STRUCTURE DETAILS

| TRENCHSTOPS, BULKHEADS & CONCRETE ENCASEMENTS TO BE INSTALLED IN ACCORDANCE WITH SEQ SEWER CODE

NOTES

1. IF SHOWN, WATER AND ELECTRICAL CROSSING LOCATIONS ARE INDICATIVE ONLY. REFER TO PLANS TO DETERMINE CROSSING LOCATIONS. WHERE SERVICE INDICATES CLASH WITH SEWER, SEWER TO TAKE PRECEDENCE, SERVICE TO BE CONSTRUCTED OVER OR UNDER SEWER ACCORDING TO SUPERINTENDENTS INSTRUCTION
2. ALL GRAVITY uPVC SEWER PIPE TO BE CLASS SN8 U.N.O.
3. ALL PRESSURE MAINS PE100 PN16 SDR11
4. ALL EMBEDMENT TYPE IS TO BE TYPE 3 U.N.O
5. ALL BENDS TO BE LONG RADIUS BEND, 1.2m RADIUS MIN.
6. CONTRACTOR TO VERIFY DOWNSTREAM EXISTING PIPE LEVELS PRIOR TO COMMENCEMENT OF PIPEWORK
7. PROTECTIVE COATING IS TO BE INSTALLED TO MAINTENANCE STRUCTURES (WHERE REQUIRED) IN ACCORDANCE WITH CLAUSE 4.7.2 OF SEQ SEWERAGE CODE.
8. TRENCHSTOPS IN ACCORDANCE WITHSEQ-WAT-1209-1

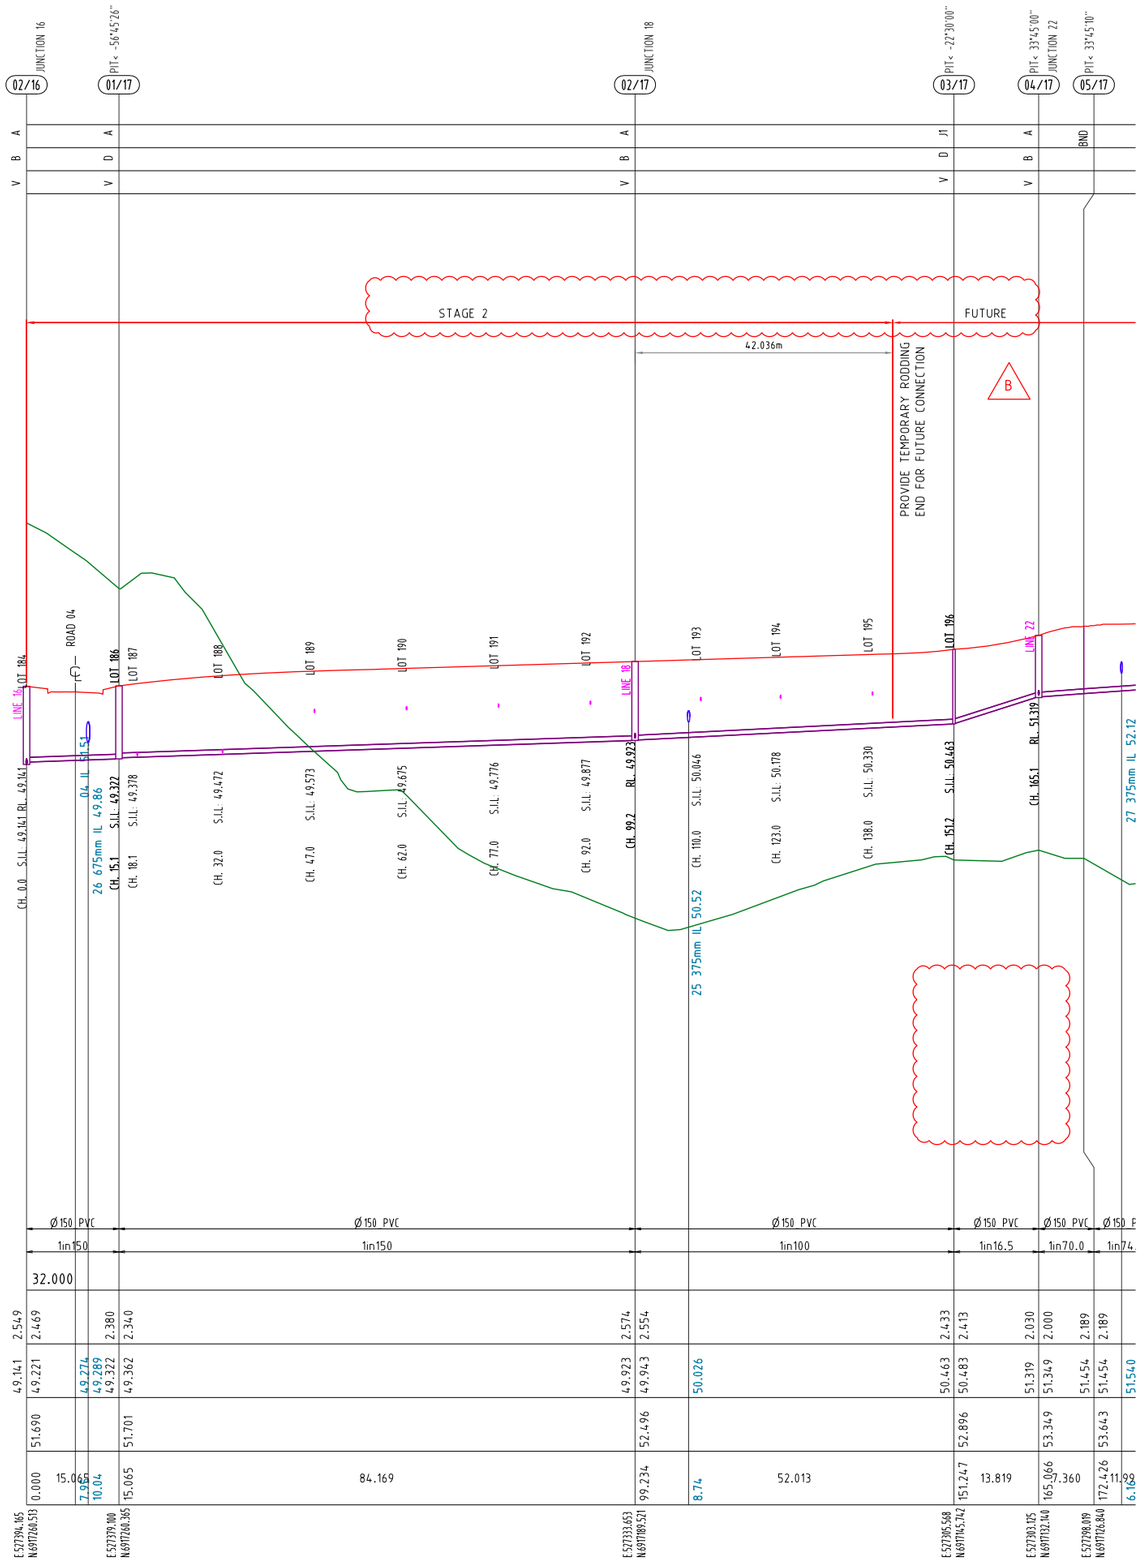

LINE NO.

17

PROJECT NAME

COURTNEY DR
UPPER COOMERA

STAGE 02

RP DESCRIPTION

LOT 188, 189, 190, 191 & 192 ON RP173728
COURTNEY DRIVE
LOCALITY OF UPPER COOMERA
LOCAL AUTHORITY - GOLD COAST CITY COUNCIL

CLIENT

HB Land

0 5 10 15 20 25m
Horiz. Scale 1:500 - A1 (1:1000 - A3)

0 1 2 3 4 5m
Vert. Scale 1:100 - A1 (1:200 - A3)

REV	DATE	DESCRIPTION	INT
B	17-01-24	TEXT ADDED & TRENCHSTOPS REMOVED	EP
A	13-10-23	COUNCIL ISSUE	EP

COPYRIGHT IS VESTED IN MORTONS-URBAN SOLUTIONS AND WRITTEN CONSENT IS REQUIRED PRIOR TO REPRODUCTION. DO NOT SCALE FROM THIS DRAWING.

ASSOCIATED CONSULTANTS

BIOME WATER AND ENVIRONMENTAL CONSULTING
Robin Russell & ASSOCIATES PTY. LTD.
BENNETT + BENNETT

DRAWING TITLE

SEWER RETICULATION
PROFILES
SHEET 04

MORTONS urbansolutions
Urban & Regional Planning
Civil Engineering
Project Coordination
MUS Pty Ltd T/As:
Mortons-Urban Solutions
ABN: 39 116 375 065
mortons@urbansolutions.net.au
www.urbansolutions.net.au
Tel 07 5571 1099
Postal Address
PO Box 2484
Southport QLD 4215
Gold Coast Office
Suite 9, 19 Short St
Southport QLD 4215

DESIGNED	RB	DRAWN	EP
APPROVED		RPEQ	4706
		DATE	13-10-23

DRAWING NUMBER 41901-02-533

REV B

F:\Autocad Client\419 - HB Land\01 - Courtney Drive\Precinct-Stage 02\Engineering Drawings\Current\41901-02-S30.dwg, SHEET 04, 21/06/2024 1:26:21 PM, 12

PLANS AND DOCUMENTS referred to in the DEVELOPMENT APPROVAL

Application No: MIN/2024/337

Dated: 16 July 2024

Development shall comply with the conditions of approval as detailed in the Decision Notice and Council's Planning Scheme, Local Laws and Planning Policies


STRUCTURE TYPE
LID CLASS
DROP TYPE

* CONSTRUCT BRIDGING STRUCTURE SPANNING THE SEWER TRENCH REFER TYPICAL SECTIONS & DETAILS FOR BRIDGING STRUCTURE DETAILS

| TRENCHSTOPS, BULKHEADS & CONCRETE ENCASEMENTS TO BE INSTALLED IN ACCORDANCE WITH SEQ SEWER CODE

NOTES

1. IF SHOWN, WATER AND ELECTRICAL CROSSING LOCATIONS ARE INDICATIVE ONLY. REFER TO PLANS TO DETERMINE CROSSING LOCATIONS. WHERE SERVICE INDICATES CLASH WITH SEWER, SEWER TO TAKE PRECEDENCE, SERVICE TO BE CONSTRUCTED OVER OR UNDER SEWER ACCORDING TO SUPERINTENDENTS INSTRUCTION
2. ALL GRAVITY uPVC SEWER PIPE TO BE CLASS SN8 U.N.O.
3. ALL PRESSURE MAINS PE100 PN16 SDR11
4. ALL EMBEDMENT TYPE IS TO BE TYPE 3 U.N.O
5. ALL BENDS TO BE LONG RADIUS BEND, 1.2m RADIUS MIN.
6. CONTRACTOR TO VERIFY DOWNSTREAM EXISTING PIPE LEVELS PRIOR TO COMMENCEMENT OF PIPEWORK
7. PROTECTIVE COATING IS TO BE INSTALLED TO MAINTENANCE STRUCTURES (WHERE REQUIRED) IN ACCORDANCE WITH CLAUSE 4.7.2 OF SEQ SEWERAGE CODE.
8. TRENCHSTOPS IN ACCORDANCE WITHSEQ-WAT-1209-1

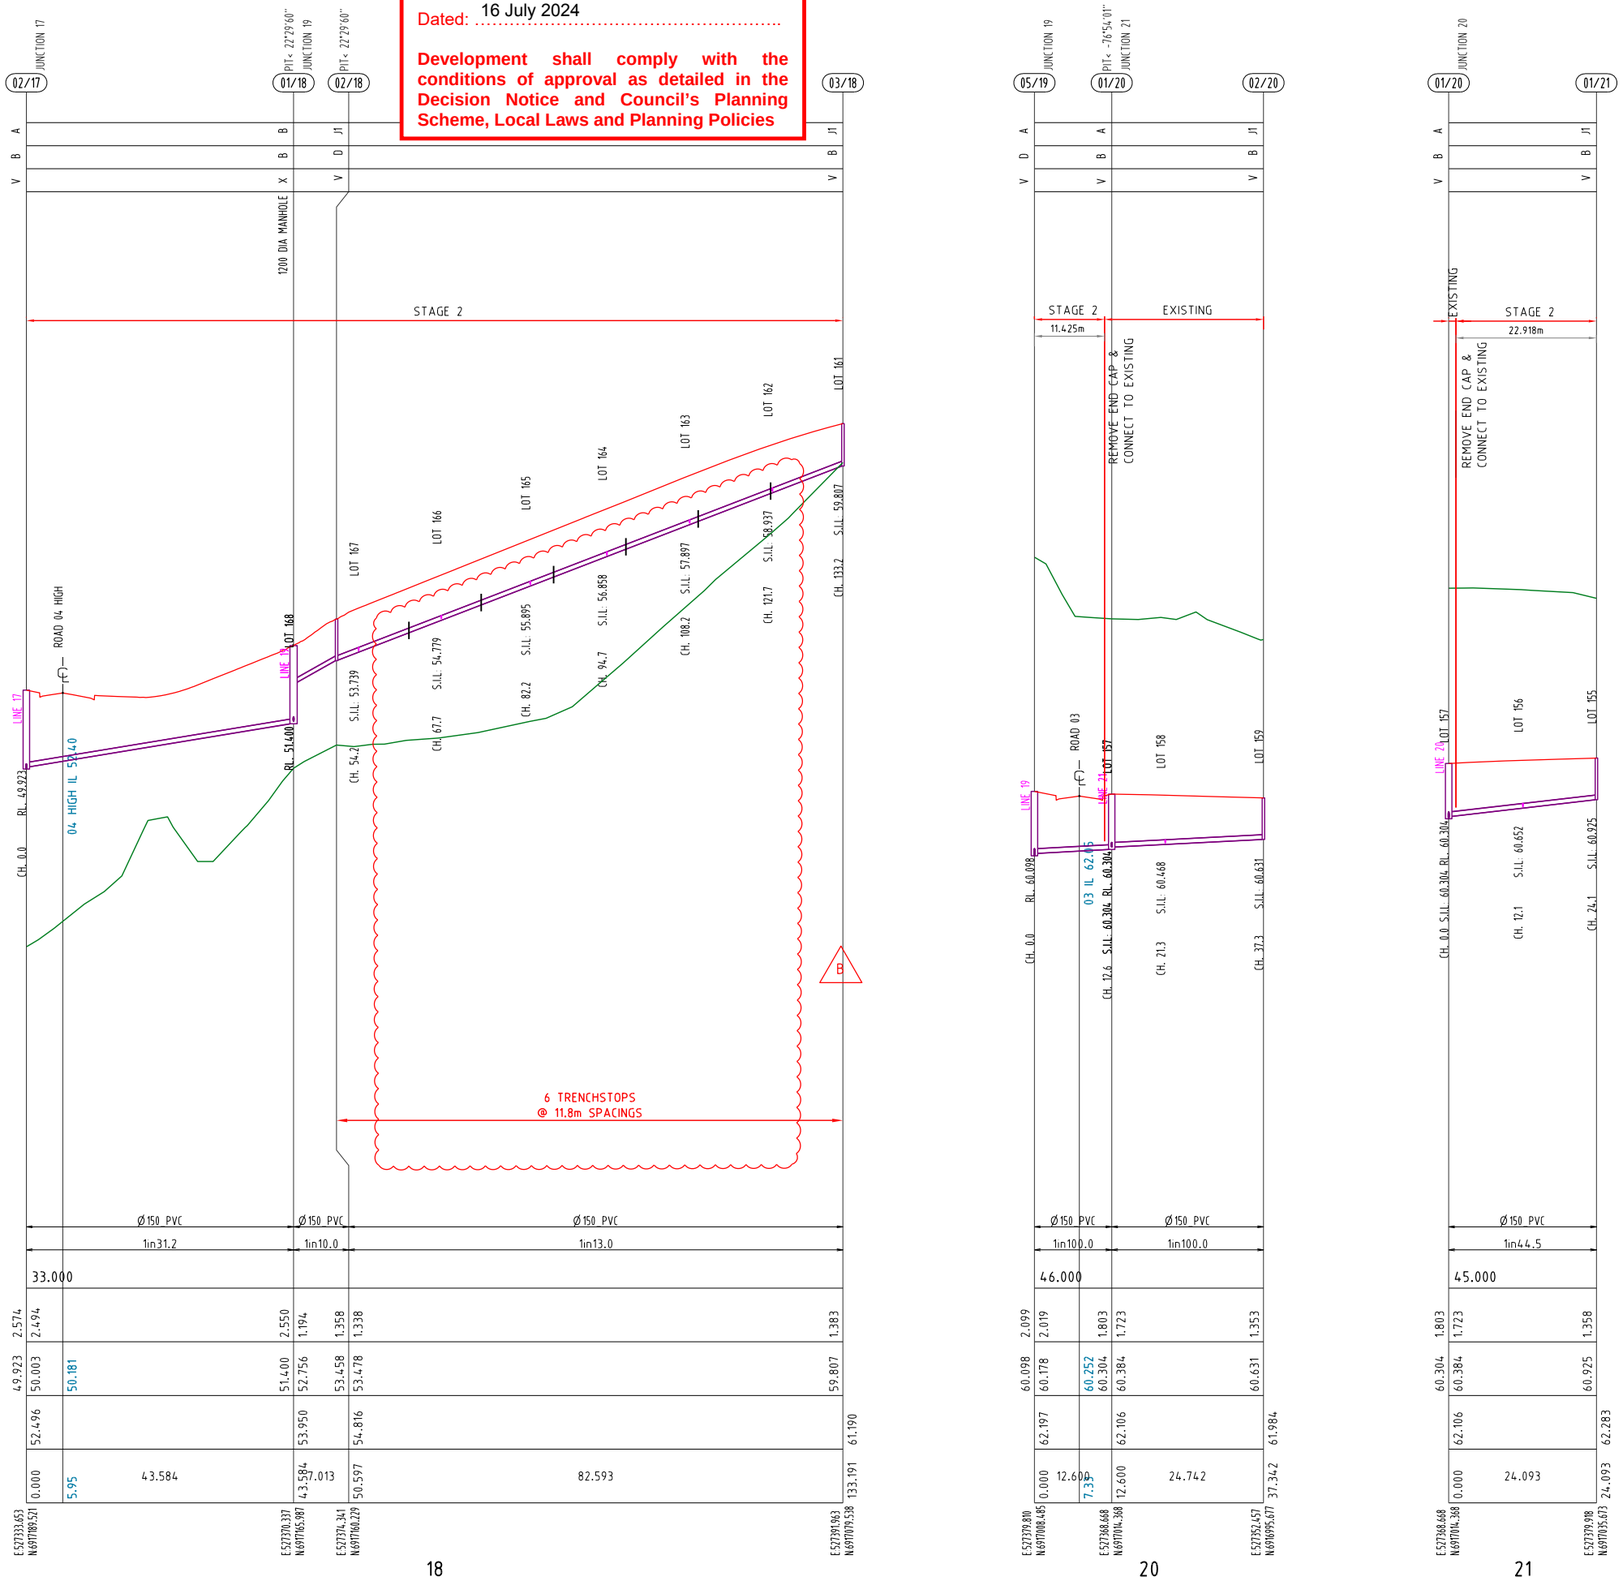

PIPE DIAMETER (mm)	
PIPE GRADE	
DATUM R.L.	
DEPTH TO INVERT	
PIPE INVERT LEVELS	
DESIGN SURFACE LEVELS	
CHAINAGE	
LINE NO.	

PROJECT NAME

COURTNEY DR UPPER COOMERA

STAGE 02

RP DESCRIPTION

LOT 188, 189, 190, 191 & 192 ON RP173728
COURTNEY DRIVE
LOCALITY OF UPPER COOMERA
LOCAL AUTHORITY - GOLD COAST CITY COUNCIL

CLIENT

HB Land

0 5 10 15 20 25m
Horiz. Scale 1:500 - A1 (1:1000 - A3)

0 1 2 3 4 5m
Vert. Scale 1:100 - A1 (1:200 - A3)

REV	DATE	DESCRIPTION	INIT
B	17-01-24	TRENCHSTOPS AMENDED	EP
A	13-10-23	COUNCIL ISSUE	EP

COPYRIGHT IS VESTED IN MORTONS-URBAN SOLUTIONS AND WRITTEN CONSENT IS REQUIRED PRIOR TO REPRODUCTION. DO NOT SCALE FROM THIS DRAWING.

ASSOCIATED CONSULTANTS

BIOME WATER AND ENVIRONMENTAL CONSULTING
Robin Russell & ASSOCIATES PTY. LTD.
BENNETT+BENNETT

DRAWING TITLE

SEWER RETICULATION
PROFILES
SHEET 05

MORTONS urbansolutions
Urban & Regional Planning
Civil Engineering
Project Coordination
MUS Pty Ltd T/As:
Mortons-Urban Solutions
ABN: 39 116 375 065
mortons@urbansolutions.net.au
www.urbansolutions.net.au
Tel 07 5571 1099
Postal Address
PO Box 2484
Southport QLD 4215
Gold Coast Office
Suite 9, 19 Short St
Southport QLD 4215

DESIGNED	RB	DRAWN	EP
APPROVED		RPEQ 4706	DATE 13-10-23

DRAWING NUMBER 41901-02-534 REV B

F:\Autocad Client\419 - HB Land\01 - Courtney Drive\Precinct-Stage 02\Engineering Drawings\Current\41901-02-530.dwg, SHEET 05, 21/06/2024 1:26:25 PM, 1:2

PLANS AND DOCUMENTS referred to in the DEVELOPMENT APPROVAL

Application No: MIN/2024/337

Dated: 16 July 2024

Development shall comply with the conditions of approval as detailed in the Decision Notice and Council's Planning Scheme, Local Laws and Planning Policies


STRUCTURE TYPE
LID CLASS
DROP TYPE

* CONSTRUCT BRIDGING STRUCTURE SPANNING THE SEWER TRENCH REFER TYPICAL SECTIONS & DETAILS FOR BRIDGING STRUCTURE DETAILS

| TRENCHSTOPS, BULKHEADS & CONCRETE ENCASEMENTS TO BE INSTALLED IN ACCORDANCE WITH SEQ SEWER CODE

NOTES

1. IF SHOWN, WATER AND ELECTRICAL CROSSING LOCATIONS ARE INDICATIVE ONLY. REFER TO PLANS TO DETERMINE CROSSING LOCATIONS. WHERE SERVICE INDICATES CLASH WITH SEWER, SEWER TO TAKE PRECEDENCE, SERVICE TO BE CONSTRUCTED OVER OR UNDER SEWER ACCORDING TO SUPERINTENDENTS INSTRUCTION
2. ALL GRAVITY uPVC SEWER PIPE TO BE CLASS SN8 U.N.O.
3. ALL PRESSURE MAINS PE100 PN16 SDR11
4. ALL EMBEDMENT TYPE IS TO BE TYPE 3 U.N.O
5. ALL BENDS TO BE LONG RADIUS BEND, 1.2m RADIUS MIN.
6. CONTRACTOR TO VERIFY DOWNSTREAM EXISTING PIPE LEVELS PRIOR TO COMMENCEMENT OF PIPEWORK
7. PROTECTIVE COATING IS TO BE INSTALLED TO MAINTENANCE STRUCTURES (WHERE REQUIRED) IN ACCORDANCE WITH CLAUSE 4.7.2 OF SEQ SEWERAGE CODE.
8. TRENCHSTOPS IN ACCORDANCE WITHSEQ-WAT-1209-1

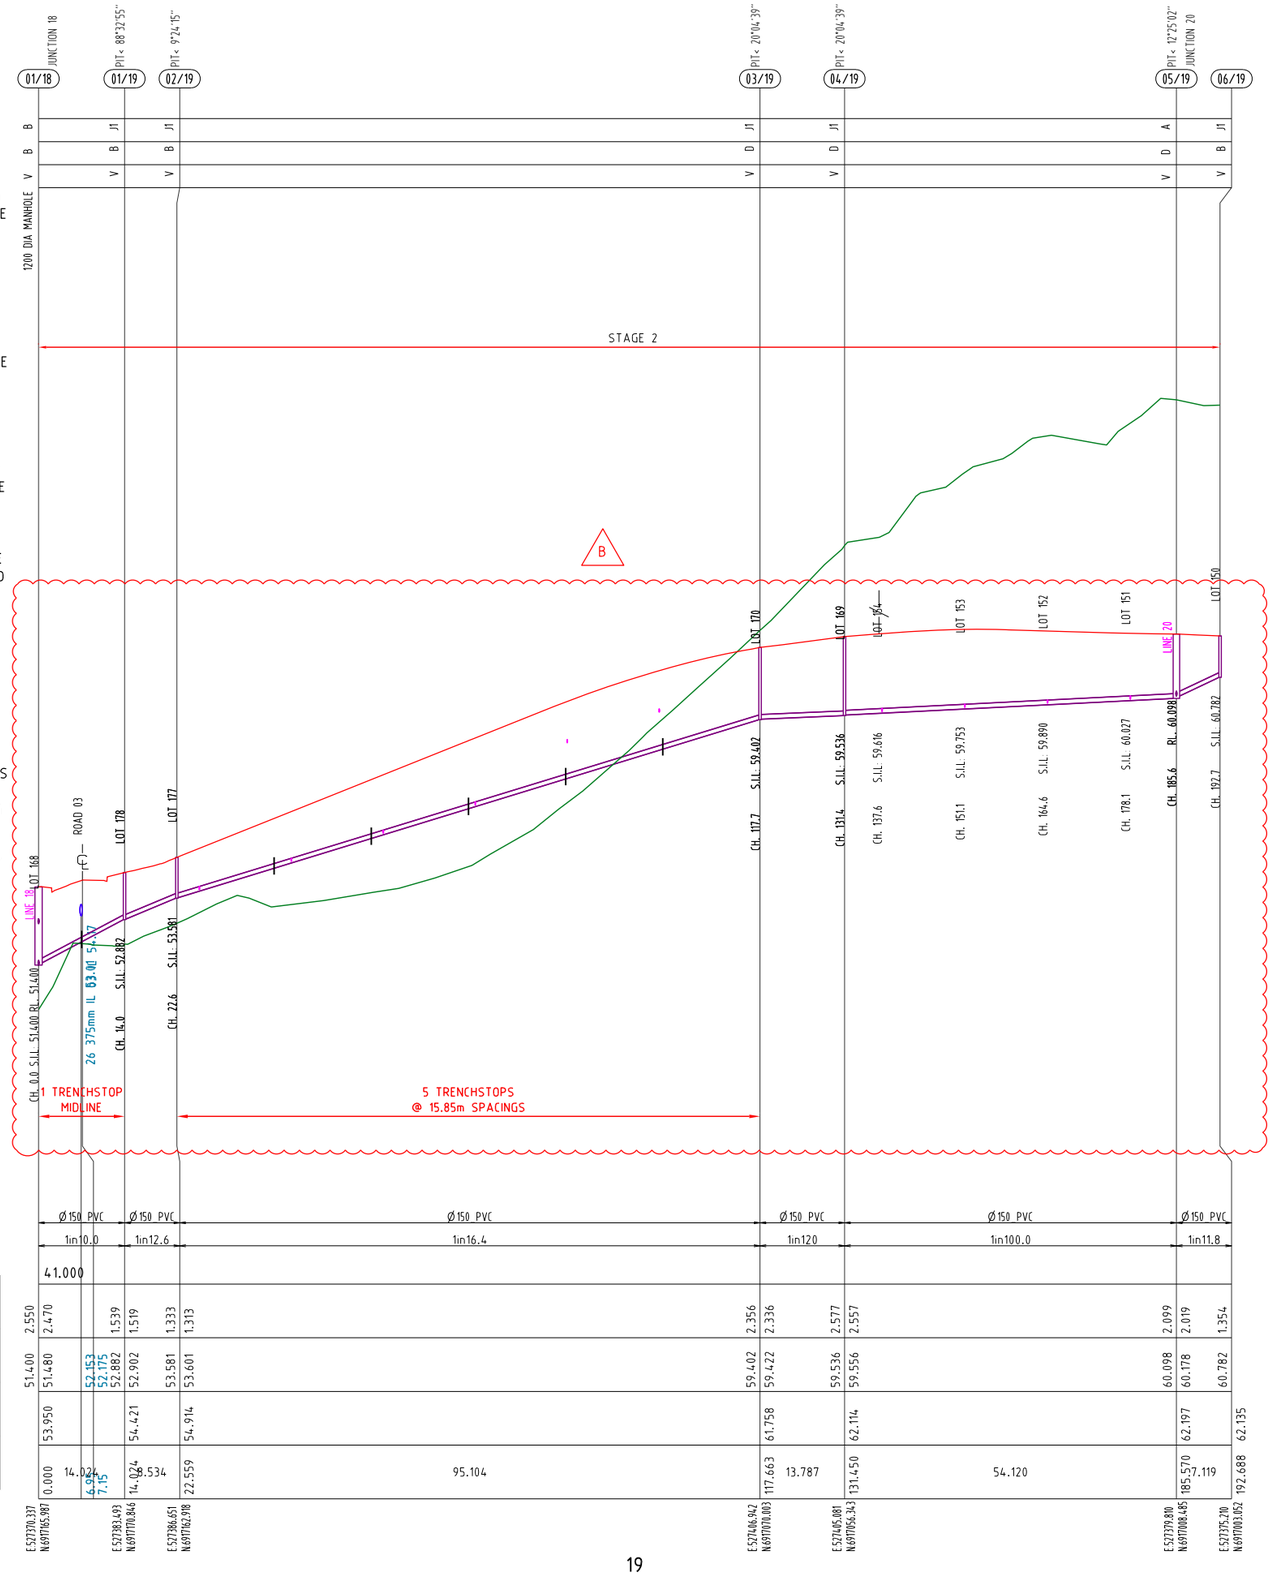

PIPE DIAMETER (mm)	Ø150 PVC	Ø150 PVC	Ø150 PVC	Ø150 PVC	Ø150 PVC	Ø150 PVC	
PIPE GRADE	1in10.0	1in12.6	1in16.4	1in120	1in100.0	1in11.8	
DATUM R.L.	41.000						
DEPTH TO INVERT	2.550	2.470	1.539	1.519	1.333	1.313	2.356	2.336	2.577	2.557	2.099	2.019	1.354
PIPE INVERT LEVELS	51.400	51.480	52.153 52.175 52.882	52.902	53.581	53.601	59.402	59.422	59.536	59.556	60.098	60.178	60.782
DESIGN SURFACE LEVELS	53.950			54.421		54.914	61.758		62.114		62.197		62.135
CHAINAGE	0.000	14.024	6.951 7.15	14.024	8.534	22.559	95.104	117.663	13.787	131.450	54.120	185.570	7.119	192.688
	E 527370.337 N 6977165.987			E 527381.493 N 6977170.846		E 527386.651 N 6977162.918		E 527406.942 N 6977078.003		E 527415.081 N 6977056.343		E 527379.810 N 6977068.485		E 527375.210 N 6977061.652

LINE NO.

PROJECT NAME

COURTNEY DR
UPPER COOMERA

STAGE 02

RP DESCRIPTION

LOT 188, 189, 190, 191 & 192 ON RP173728
COURTNEY DRIVE
LOCALITY OF UPPER COOMERA
LOCAL AUTHORITY - GOLD COAST CITY COUNCIL

CLIENT

HB Land

0 5 10 15 20 25m
Horiz. Scale 1:500 - A1 (1:1000 - A3)

0 1 2 3 4 5m
Vert. Scale 1:100 - A1 (1:200 - A3)

REV	DATE	DESCRIPTION	INI
B	17-01-24	TRENCHSTOPS AMENDED	EP
A	13-10-23	COUNCIL ISSUE	EP

COPYRIGHT IS VESTED IN MORTONS-URBAN SOLUTIONS AND WRITTEN CONSENT IS REQUIRED PRIOR TO REPRODUCTION. DO NOT SCALE FROM THIS DRAWING.

ASSOCIATED CONSULTANTS

BIOME WATER AND ENVIRONMENTAL CONSULTING
Robin Russell & ASSOCIATES PTY. LTD.
BENNETT+BENNETT

DRAWING TITLE

SEWER RETICULATION
PROFILES
SHEET 06

MORTONS urbansolutions
Urban & Regional Planning
Civil Engineering
Project Coordination
MUS Pty Ltd T/As:
Mortons-Urban Solutions
ABN: 39 116 375 065
mortons@urbansolutions.net.au
www.urbansolutions.net.au
Tel 07 5571 1099
Postal Address
PO Box 2484
Southport QLD 4215
Gold Coast Office
Suite 9, 19 Short St
Southport QLD 4215

DESIGNED RB	DRAWN EP	
APPROVED	RPEQ 4706	DATE 13-10-23
DRAWING NUMBER 41901-02-535		REV B

F:\Autocad Client\419 - HB Land\01 - Courtney Drive\Precinct-Stage 02\Engineering Drawings\Current\41901-02-530.dwg, SHEET 06, 21/06/2024 1:26:27 PM, 1:2

RIGS STRUCTURE DROPS	
A	SEWER PROPERTY CONNECTION (STANDARD & EXTENDED) REFER TO SEQ STD DWGS SEQ-SEW-1104-1
B	SEWER PROPERTY CONNECTION (SLOPED CONNECTION) REFER TO SEQ STD DWGS SEQ-SEW-1104-1
D	SEWER PROPERTY CONNECTION (VERTICAL RISER) REFER TO SEQ STD DWG SEQ-SEW-1105-1
V	SEWER PROPERTY CONNECTION (STRAIGHT THROUGH SEWER) REFER TO SEQ STD DWG SEQ-SEW-1303-1
X	SEWER PROPERTY CONNECTION (INTERNAL BACKDROP) REFER TO SEQ STD DWG SEQ-SEW-1303-1
Z	RISER CONNECTION TO PORTION OF MAINTENANCE SHAFT

PLANS AND DOCUMENTS referred to in the DEVELOPMENT APPROVAL

Application No: MIN/2024/337

Dated: 16 July 2024

Development shall comply with the conditions of approval as detailed in the Decision Notice and Council's Planning Scheme, Local Laws and Planning Policies

DIAL BEFORE YOU DIG www.1100.com.au

NOTES

1. WATER AND ELECTRICAL CROSSING LOCATIONS ARE INDICATIVE ONLY. REFER TO PLANS TO DETERMINE PRECISE CROSSING LOCATIONS. WHERE SERVICE INDICATES CLASH WITH SEWER, SEWER TO TAKE PRECEDENCE, SERVICE TO BE CONSTRUCTED OVER OR UNDER SEWER ACCORDING TO SUPERINTENDANTS INSTRUCTION.

2. ALL HOUSE CONNECTIONS TO BE 100Ø CLASS SN6 UNLESS NOTED OTHERWISE

PIPE DIAMETER (mm)

PIPE GRADE

DATUM R.L.


DEPTH TO INVERT


PIPE INVERT LEVELS

DESIGN SURFACE LEVELS

CHAINAGE

LOT NO.

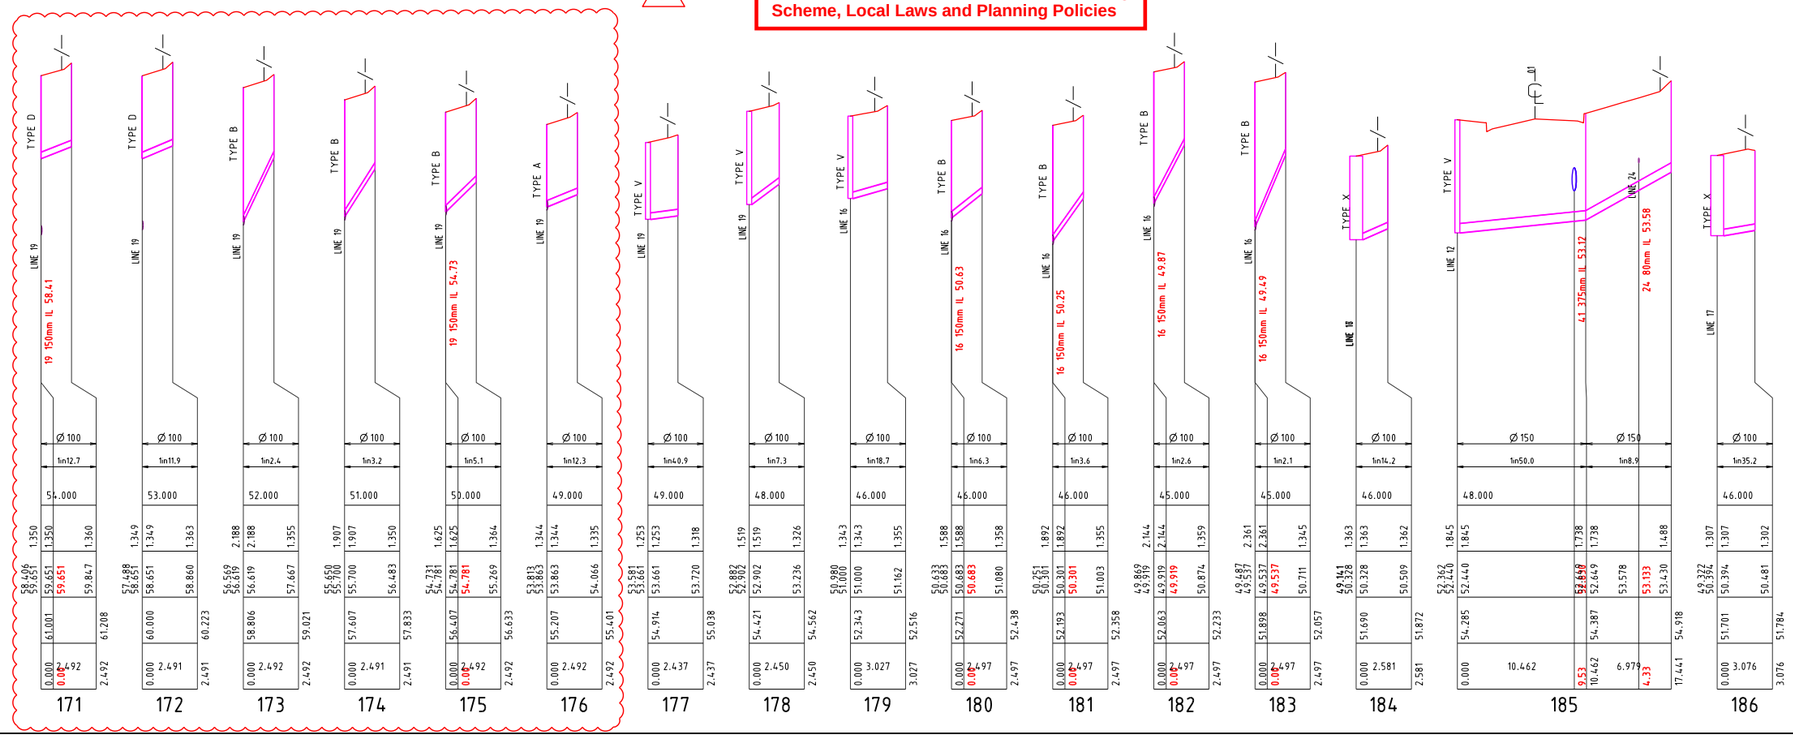

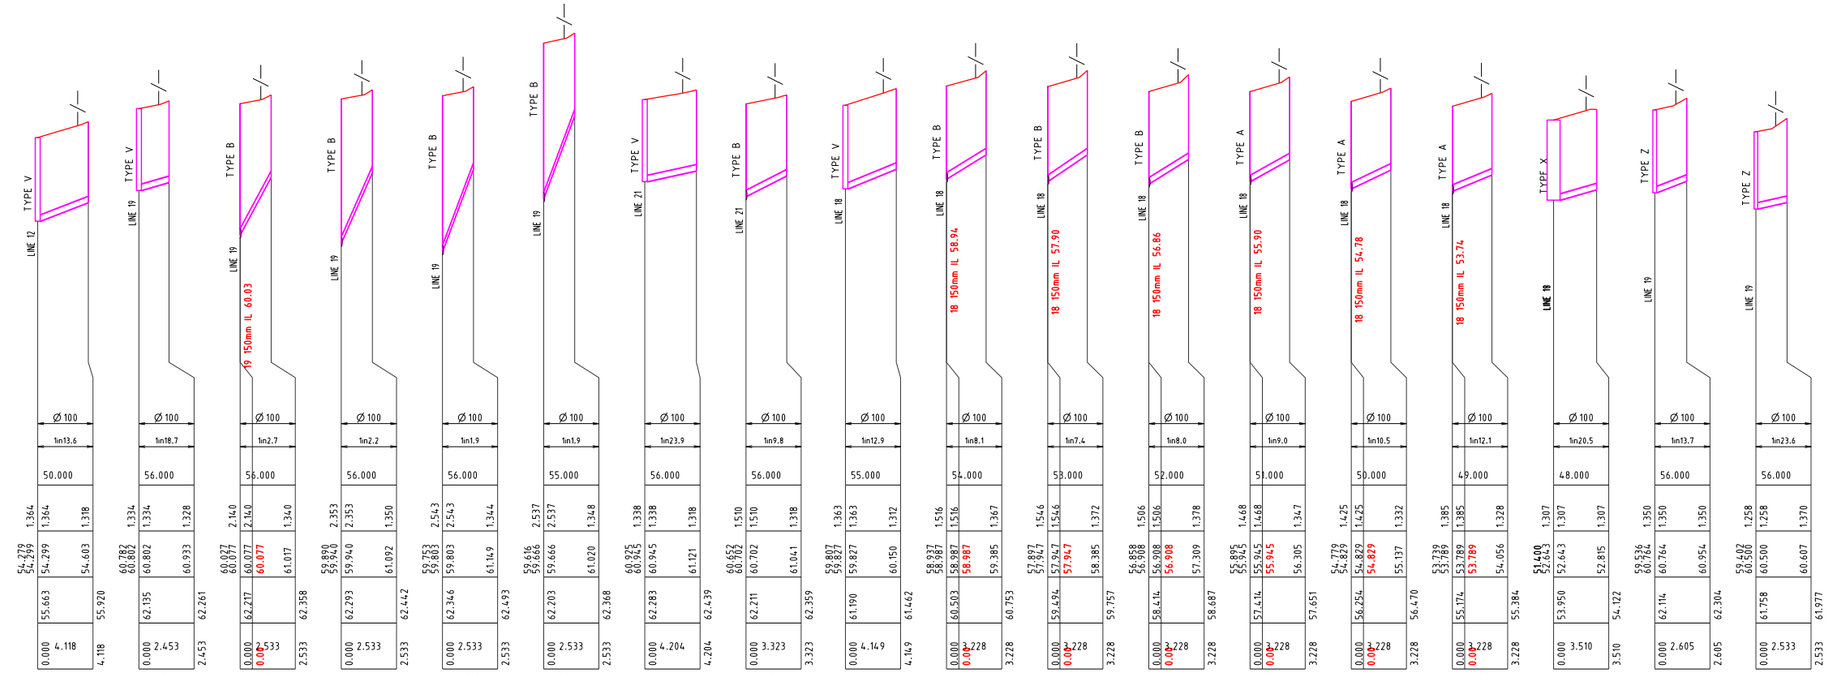

PROJECT NAME

COURTNEY DR UPPER COOMERA

STAGE 02

RP DESCRIPTION

LOT 188, 189, 190, 191 & 192 ON RP173728
COURTNEY DRIVE
LOCALITY OF UPPER COOMERA
LOCAL AUTHORITY - GOLD COAST CITY COUNCIL

CLIENT

HB Land

0 2.5 5 7.5 10 12.5m
Horiz. Scale 1:250 - A1 (1:500 - A3)

0 0.5 1.0 1.5 2.0 2.5m
Vert. Scale 1:50 - A1 (1:100 - A3)

REV	DATE	DESCRIPTION	INT
B	27-11-23	HOUSE CONNECTIONS AMENDED	BL
A	13-10-23	COUNCIL ISSUE	EP

COPYRIGHT IS VESTED IN MORTONS-URBAN SOLUTIONS AND WRITTEN CONSENT IS REQUIRED PRIOR TO REPRODUCTION. DO NOT SCALE FROM THIS DRAWING.

ASSOCIATED CONSULTANTS

BIOME WATER AND ENVIRONMENTAL CONSULTING

Robin Russell & ASSOCIATES PTY. LTD.

BENNETT + BENNETT

DRAWING TITLE

SEWER RETICULATION
HOUSE CONNECTION
PROFILES
SHEET 01

MORTONS urbansolutions
Urban & Regional Planning
Civil Engineering
Project Coordination
MUS Pty Ltd T/As:
Mortons-Urban Solutions
ABN: 39 116 375 065
mortons@urbansolutions.net.au
www.urbansolutions.net.au
Tel 07 5571 1099
Postal Address
PO Box 2484
Southport QLD 4215
Gold Coast Office
Suite 9, 19 Short St
Southport QLD 4215

DESIGNED	RB	DRAWN	EP
APPROVED		RPEQ	4706
		DATE	13-10-23

DRAWING NUMBER 41901-02-550

REV B


F:\Autocad Client\419 - HB Land\01 - Courtney Drive\Precinct-Stage 02\Engineering Drawings\Current\41901-02-550.dwg, SHEET 01, 21/06/2024 1:26:31 PM, 1:2


PLANS AND DOCUMENTS referred to in the DEVELOPMENT APPROVAL

Application No: MIN/2024/337

Dated: 16 July 2024

Development shall comply with the conditions of approval as detailed in the Decision Notice and Council's Planning Scheme, Local Laws and Planning Policies

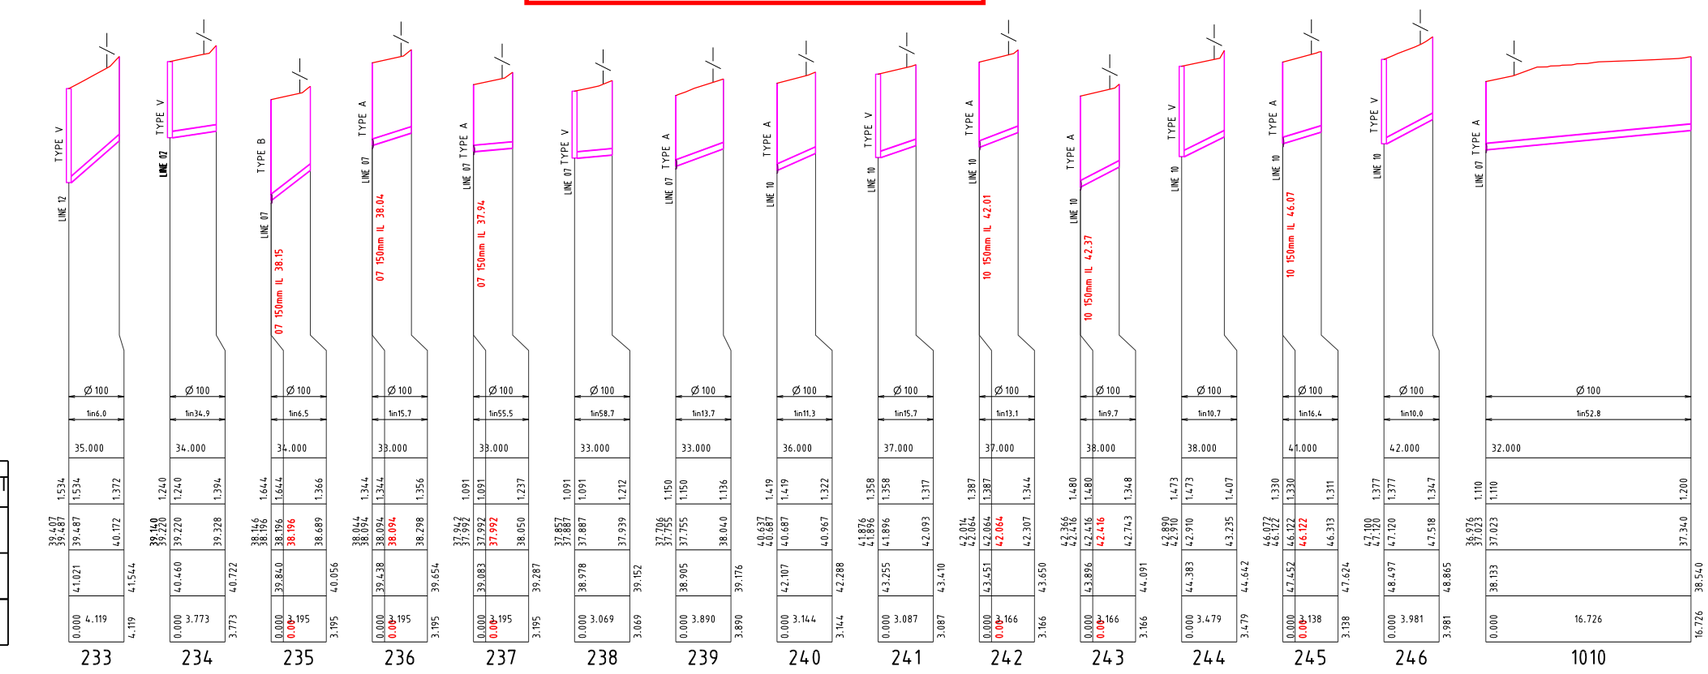

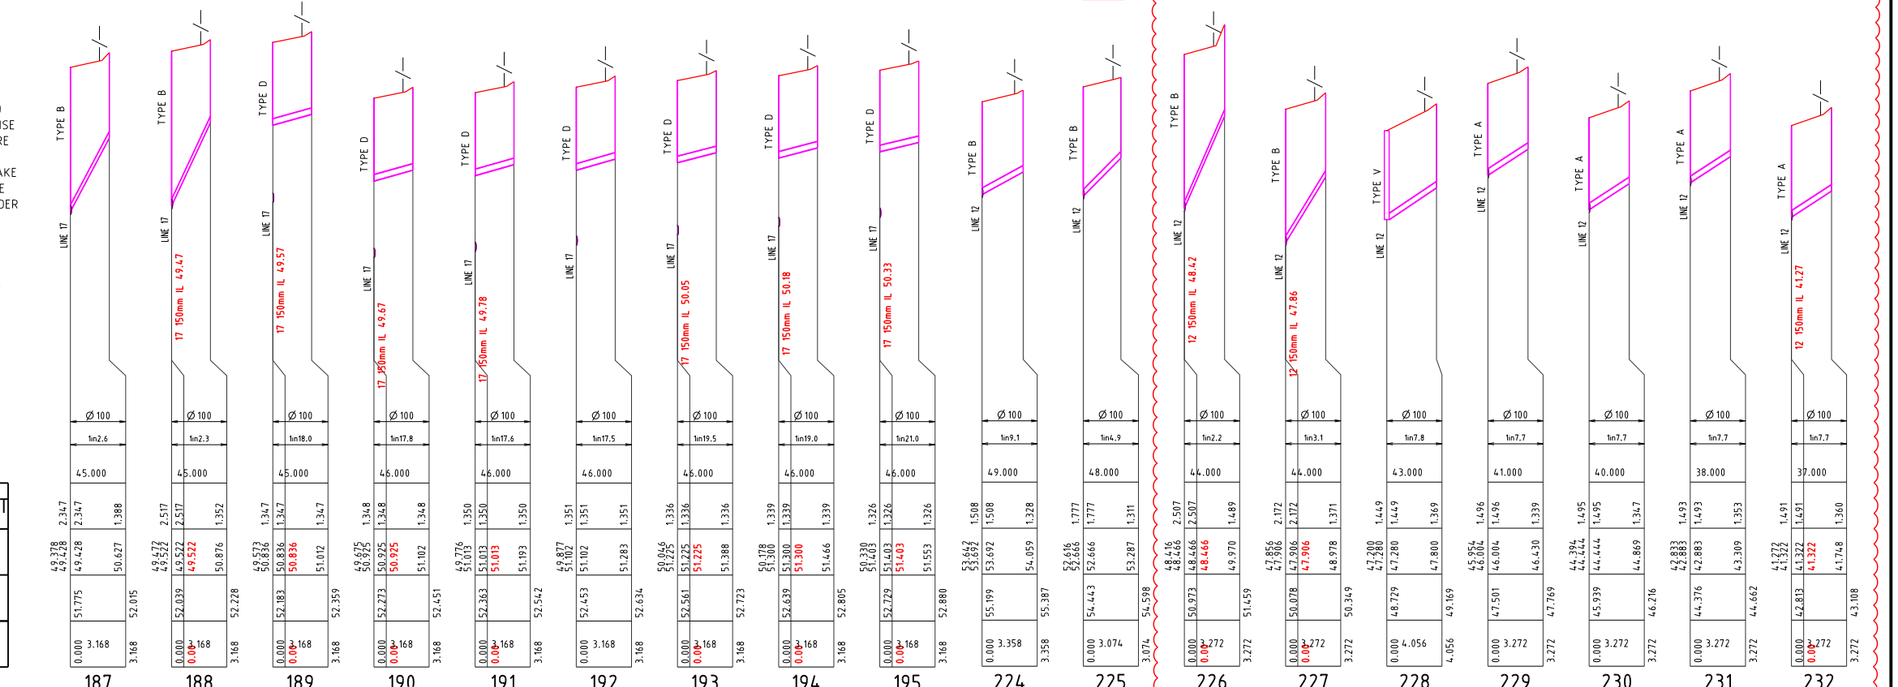

NOTES

1. WATER AND ELECTRICAL CROSSING LOCATIONS ARE INDICATIVE ONLY. REFER TO PLANS TO DETERMINE PRECISE CROSSING LOCATIONS. WHERE SERVICE INDICATES CLASH WITH SEWER, SEWER TO TAKE PRECEDENCE, SERVICE TO BE CONSTRUCTED OVER OR UNDER SEWER ACCORDING TO SUPERINTENDANTS INSTRUCTION.

2. ALL HOUSE CONNECTIONS TO BE 100Ø CLASS SN6 UNLESS NOTED OTHERWISE

PROJECT NAME

COURTNEY DR UPPER COOMERA

STAGE 02

RP DESCRIPTION

LOT 188, 189, 190, 191 & 192 ON RP173728
COURTNEY DRIVE
LOCALITY OF UPPER COOMERA
LOCAL AUTHORITY - GOLD COAST CITY COUNCIL

CLIENT

HB Land

0 2.5 5 7.5 10 12.5m
Horiz. Scale 1:250 - A1 (1:500 - A3)

0 0.5 1.0 1.5 2.0 2.5m
Vert. Scale 1:50 - A1 (1:100 - A3)

REV	DATE	DESCRIPTION	INT
B	27-11-23	HOUSE CONNECTIONS AMENDED	BL
A	13-10-23	COUNCIL ISSUE	EP

COPYRIGHT IS VESTED IN MORTONS-URBAN SOLUTIONS AND WRITTEN CONSENT IS REQUIRED PRIOR TO REPRODUCTION. DO NOT SCALE FROM THIS DRAWING.

ASSOCIATED CONSULTANTS

BIOME WATER AND ENVIRONMENTAL CONSULTING
Robin Russell & ASSOCIATES PTY. LTD.
BENNETT + BENNETT

DRAWING TITLE

SEWER RETICULATION
HOUSE CONNECTION
PROFILES
SHEET 02

MORTONS urbansolutions
Urban & Regional Planning
Civil Engineering
Project Coordination
MUS Pty Ltd T/As:
Mortons-Urban Solutions
ABN: 39 116 375 065
mortons@urbansolutions.net.au
www.urbansolutions.net.au
Tel 07 5571 1099
Postal Address
PO Box 2484
Southport QLD 4215
Gold Coast Office
Suite 9, 19 Short St
Southport QLD 4215

DESIGNED	RB	DRAWN	EP
APPROVED		RPEQ	4706
		DATE	13-10-23

DRAWING NUMBER 41901-02-551

REV B

F:\Autocad Client\419 - HB Land\01 - Courtney Drive\Precinct-Stage 02\Engineering Drawings\Current\41901-02-550.dwg, SHEET 02, 21/06/2024 1:26:32 PM, 1:2

PLANS AND DOCUMENTS referred to in the DEVELOPMENT APPROVAL

Application No: MIN/2024/337

Dated: 16 July 2024

Development shall comply with the conditions of approval as detailed in the Decision Notice and Council's Planning Scheme, Local Laws and Planning Policies


STORMWATER


1. ALL FIELD GULLIES SHALL CONTAIN A 150mm DIA STUB 600mm BELOW GRADE LEVEL FOR FUTURE ROOFWATER DRAINAGE.
2. MANHOLES TO BE IN ACCORDANCE WITH IPWEAQ STANDARD DRAWING No DS-010, DS-015, DS-018, DS-019, DS-020, DS-021 OR STRUCTURAL DRAWINGS (STRUCTURAL DRAWINGS TAKE PRECEDENCE).
3. OUTLET HEADWALLS TO BE IN ACCORDANCE WITH LOCAL COUNCIL STANDARD DRAWINGS.
4. ALL HEADWALLS WITH A FALL GREATER THAN 900mm HIGH REQUIRE INSTALLATION OF PEDESTRIAN SAFETY FENCES.
5. PIPE JOINT TYPES TO BE IN ACCORDANCE WITH LOCAL AUTHORITY REQUIREMENTS.
6. ALL ALLOTMENTS TO BE GRADED SUCH THAT FUTURE ROOFWATER DRAINAGE DISCHARGES TO KERB OR TO PIPED DRAINAGE SYSTEM.
7. ALL PIPE 300mm DIA & GREATER SHALL BE CONSTRUCTED USING SRC OR FRC PIPES. CONTRACTOR MAY ELECT TO USE PVC PIPES WITHIN ALLOTMENTS FOR PIPES SMALLER THAN 300mm DIA.
8. FOR SETOUT DETAILS REFER TO 640 SERIES DRAWINGS (PROFILES & PIT DETAILS).
9. GULLY PITS TO BE IN ACCORDANCE WITH IPWEAQ STANDARD DRAWING No DS-060, DS-061, DS-062, DS-063. WHERE PITS ARE CONSTRUCTED AS DRAINWAY PITS, TO BE IN ACCORDANCE WITH IPWEAQ STANDARD DRAWINGS No 05-068.
10. LOTS WHICH CAN DRAIN OVERLAND FLOW TO THE STREET SWALE / DRAINAGE WITHOUT FLOWING THROUGH ADJOINING PROPERTIES NEED TO PROVIDE FOR Q100 OVERLAND FLOW TO THE ROAD
11. LOT EARTHWORKS DURING BUILDING CONSTRUCTION MUST NOT CHANGE FLOW PATH DIRECTION UNLESS IT IS REPLACED WITH ANOTHER FLOW PATH DRAINING TO THE ROAD SWALE / DRAINAGE.
12. THE CONTRACTOR IS TO INCLUDE ROCK EXCAVATION AS PART OF THEIR STORMWATER RATE.
13. PIPE CLASS - PIPE CLASSES/TRENCH BEDDING SHOWN ON THE DRAWINGS ARE SUBJECT TO THE CONTRACTORS PREFERRED INSTALLATION METHOD. THE CONTRACTOR IS RESPONSIBLE FOR INSTALLING THE APPROPRIATE PIPE CLASSES & BEDDING, & CONSIDERING CONSTRUCTION LOADING.
14. KERB ADAPTORS ARE TO BE INSTALLED TO AUTHORITIES REQUIREMENTS.
15. ALL RCBC SLABS ARE TO BE CAST INSITU.

LEGEND

- EXISTING KERB (INVERT)
- EXISTING KERB (LIP & BACK)
- EXISTING PROPERTY LINE
- EXISTING RETAINING WALL
- EXISTING STORMWATER (SW)
- EXISTING ROOFWATER (RW)
- EXISTING SUBSOIL (SS)
- EXISTING CONTOURS (1.0)
- FUTURE KERB
- FUTURE PROPERTY LINE
- FUTURE RETAINING WALL
- FUTURE STORMWATER (SW)
- FUTURE ROOFWATER (RW)
- FUTURE SUBSOIL (SS)
- SITE BOUNDARY
- STAGE BOUNDARY
- CONTROL LINE / CENTER OF ROAD
- PROPOSED KERB (INVERT)
- PROPOSED KERB (LIP & BACK)
- PROPOSED PROPERTY LINE
- PROPOSED RETAINING WALL
- DESIGN CONTOURS (1.0)
- PROPOSED STORMWATER (SW)
- PROPOSED ROOFWATER (RW)
- PROPOSED SUBSOIL (SS)
- MANHOLE
- FIELD INLET
- KERB INLET (ON GRADE) PIT
- KERB INLET (SAG) PIT
- HEADWALL
- SCOUR PROTECTION

SHEET LAYOUT

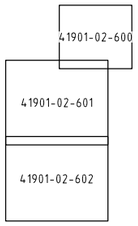

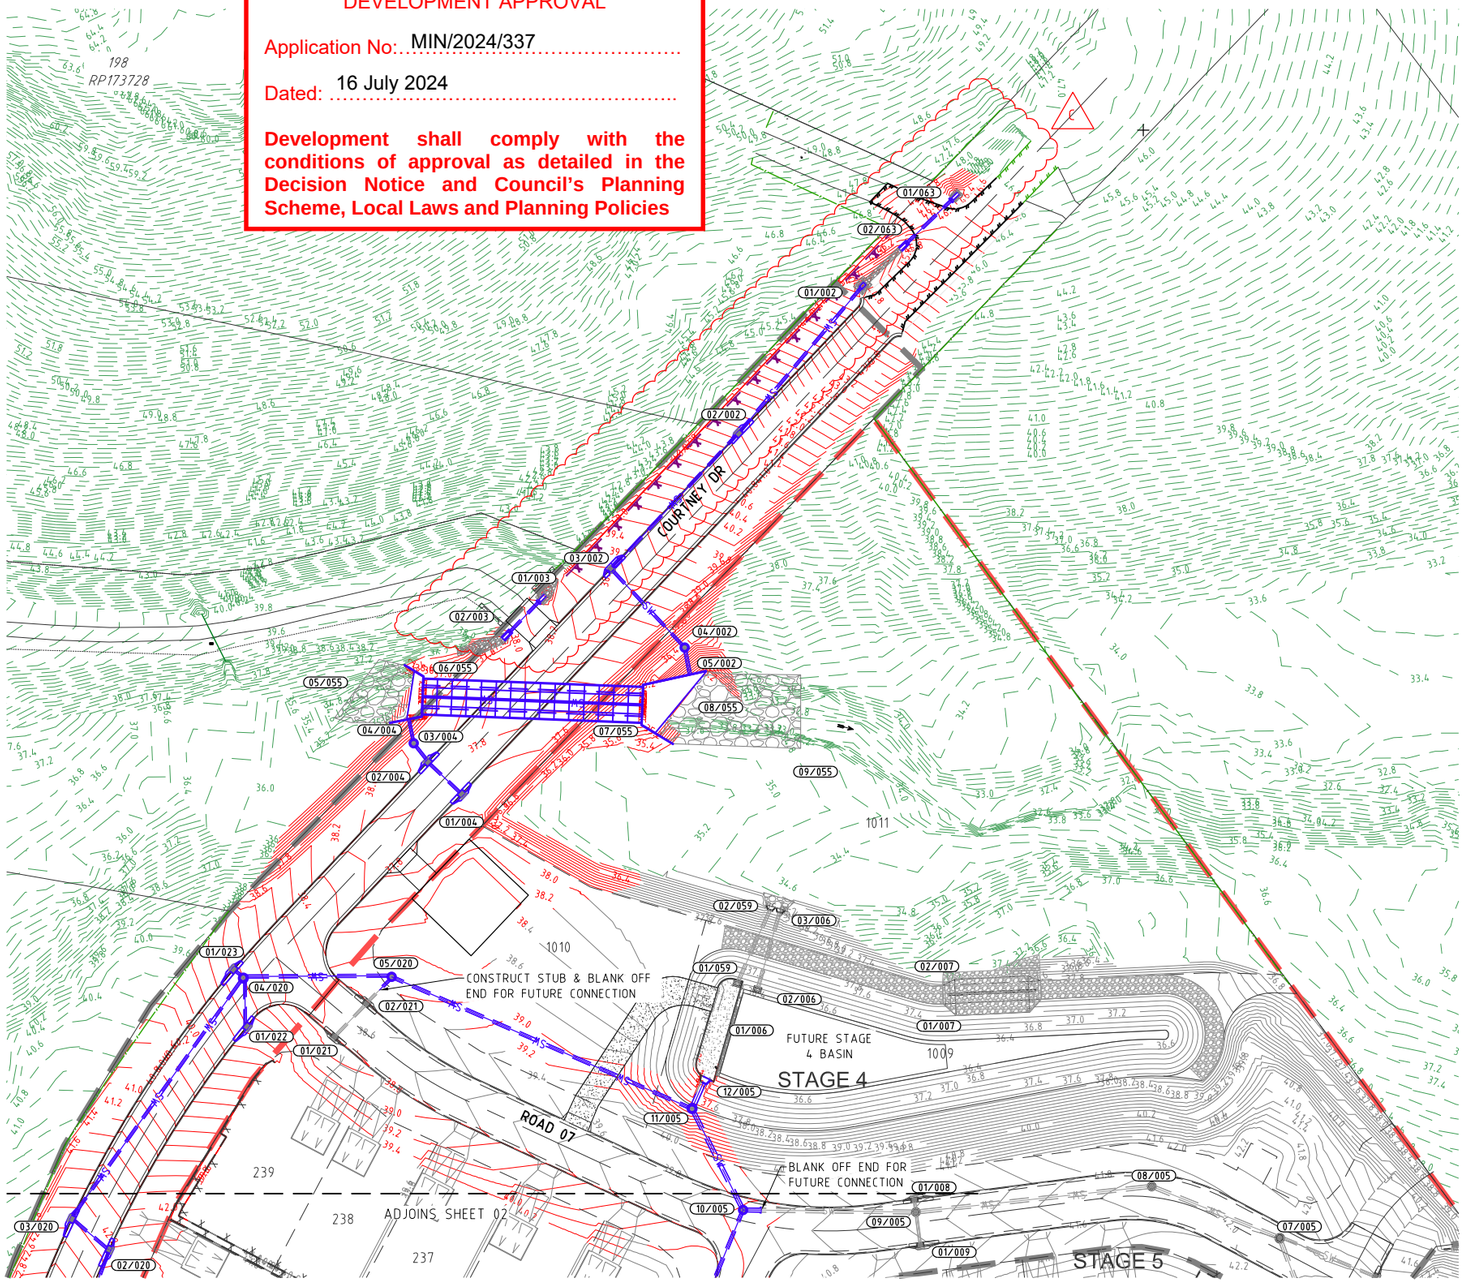

REFERENCE POINT LOCATION FOR DRAINAGE STRUCTURES

STRUCTURE TYPE	HORIZONTAL CONTROL (Reference Point Location)	VERTICAL CONTROL (Reference Level)
MANHOLE / GRATED PIT	CENTRE OF MANHOLE / PIT	FINISHED SURFACE LEVEL
GULLY PIT	LIP AT CENTRE OF PIT	FINISHED SURFACE LEVEL (LIP OF CHANNEL)
HEADWALL	INTERSECTION OF HEADWALL FACE & PIPE CENTRELINE	INVERT LEVEL

REFER TO DWG SERIES 640 FOR ALL DRAINAGE STRUCTURE SETOUT AND/OR CUSTOM DETAILS.

DIAL BEFORE YOU DIG www.1100.com.au

PROJECT NAME

COURTNEY DR UPPER COOMERA

STAGE 02

RP DESCRIPTION

LOT 188, 189, 190, 191 & 192 ON RP173728
COURTNEY DRIVE
LOCALITY OF UPPER COOMERA
LOCAL AUTHORITY - GOLD COAST CITY COUNCIL

CLIENT

HB Land

NORTH

0 5 10 15 20 25m
Scale 1:500 - A1 (1:1000 - A3)

REV	DATE	DESCRIPTION	INT
C	14-06-24	STORMWATER & CONTOURS AMENDED	RK
B	15-01-24	CONTOURS & STORMWATER AMENDED	BL
A	13-10-23	COUNCIL ISSUE	EP

COPYRIGHT IS VESTED IN MORTONS-URBAN SOLUTIONS AND WRITTEN CONSENT IS REQUIRED PRIOR TO REPRODUCTION. DO NOT SCALE FROM THIS DRAWING.

ASSOCIATED CONSULTANTS

BIOME WATER AND ENVIRONMENTAL CONSULTING
Robin Russell & ASSOCIATES PTY. LTD.
BENNETT+BENNETT

DRAWING TITLE

STORMWATER DRAINAGE PLAN SHEET 01

MORTONS urbansolutions
Urban & Regional Planning
Civil Engineering
Project Coordination

MUS Pty Ltd T/As
Mortons-Urban Solutions
ABN: 39 116 375 065

mortons@urbansolutions.net.au
www.urbansolutions.net.au
Tel 07 5571 1099

Postal Address
PO Box 2484
Southport QLD 4215

Gold Coast Office
Suite 9, 19 Short St
Southport QLD 4215

DESIGNED	RB	DRAWN	EP
APPROVED	RPEQ 4706	DATE	13-10-23

DRAWING NUMBER 41901-02-600 | REV C


F:\Autocad Client\419 - HB Land\01 - Courtney Drive\Precinct-Stage 02\Engineering Drawings\Current\41901-02-600.dwg, PLAN SHEET 01, 21/06/2024 1:26:52 PM, 1:2

PLANS AND DOCUMENTS referred to in the DEVELOPMENT APPROVAL

Application No: MIN/2024/337

Dated: 16 July 2024

Development shall comply with the conditions of approval as detailed in the Decision Notice and Council's Planning Scheme, Local Laws and Planning Policies

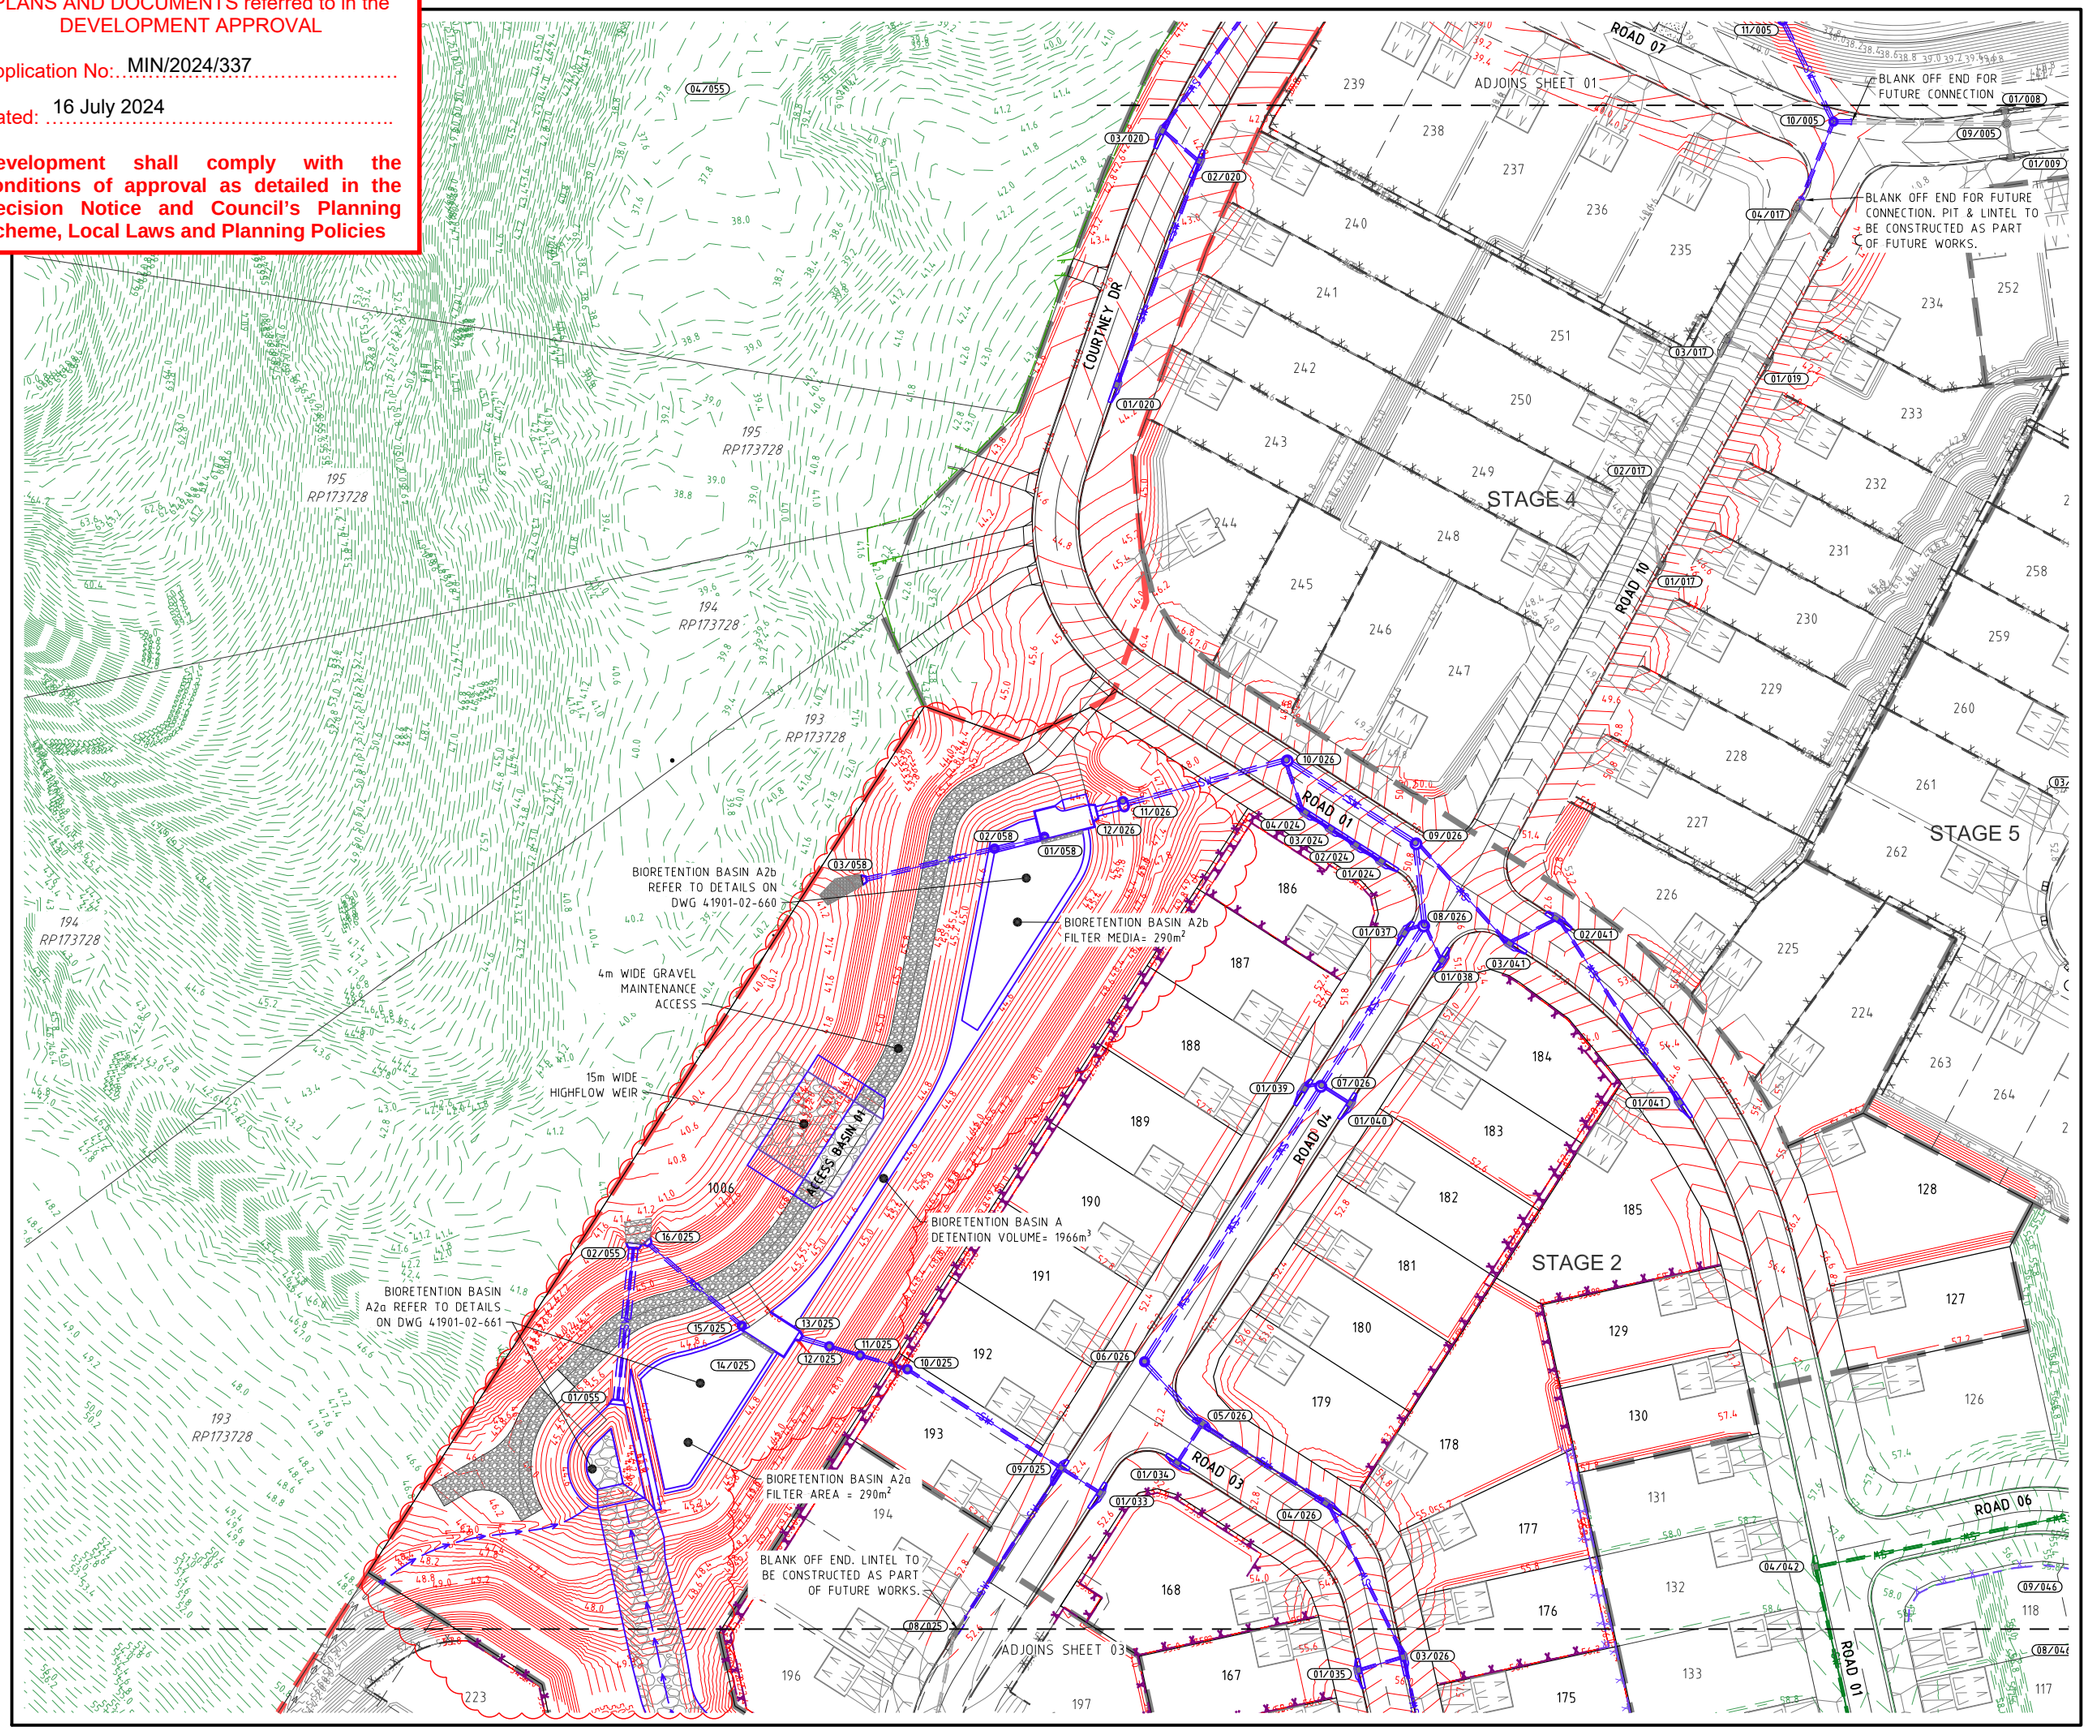

PROJECT NAME

COURTNEY DR UPPER COOMERA

STAGE 02

RP DESCRIPTION

LOT 188, 189, 190, 191 & 192 ON RP173728
COURTNEY DRIVE
LOCALITY OF UPPER COOMERA
LOCAL AUTHORITY - GOLD COAST CITY COUNCIL

CLIENT

HB Land

NORTH

0 5 10 15 20 25m

Scale 1:500 - A1 (1:1000 - A3)

REV	DATE	DESCRIPTION	INT
B	29-11-23	BASIN STORMWATER AMENDED	BL
A	13-10-23	COUNCIL ISSUE	EP

COPYRIGHT IS VESTED IN MORTONS-URBAN SOLUTIONS AND WRITTEN CONSENT IS REQUIRED PRIOR TO REPRODUCTION. DO NOT SCALE FROM THIS DRAWING.

ASSOCIATED CONSULTANTS

BIOME WATER AND ENVIRONMENTAL CONSULTING

Robin Russell & ASSOCIATES PTY. LTD.

BENNETT+BENNETT

DRAWING TITLE

STORMWATER DRAINAGE PLAN SHEET 02

MORTONS urbansolutions
Urban & Regional Planning
Civil Engineering
Project Coordination

MUS Pty Ltd T/As:
Mortons-Urban Solutions
ABN: 39 116 375 065

Postal Address
PO Box 2484
Southport QLD 4215

mortons@urbansolutions.net.au
www.urbansolutions.net.au
Tel 07 5571 1099

Gold Coast Office
Suite 9, 19 Short St
Southport QLD 4215

DESIGNED	RB	DRAWN	EP
APPROVED	RPEQ 4706	DATE	13-10-23

DRAWING NUMBER	REV
41901-02-601	B

F:\Autocad Client\419 - HB Land\01 - Courtney Drive\Precinct-Stage 02\Engineering Drawings\Current\41901-02-600.dwg, PLAN SHEET 02, 21/06/2024 1:27:59 PM, 1:2

BLANK OFF END. LINTEL TO BE CONSTRUCTED AS PART OF FUTURE WORKS.

ADJOINS SHEET 02

LOCALISED EARTHWORKS IN THIS AREA TO MAINTAIN CHANNEL PROFILE THROUGH ROAD 02. STORMWATER CULVERT TO BE INSTALLED AS PART OF STAGE 3 WORKS.

ROAD 01

ROAD 02

ROAD 03

ROAD 04

STAGE 1

STAGE 2

STAGE 3

PLANS AND DOCUMENTS referred to in the DEVELOPMENT APPROVAL

Application No: MIN/2024/337

Dated: 16 July 2024

Development shall comply with the conditions of approval as detailed in the Decision Notice and Council's Planning Scheme, Local Laws and Planning Policies

F:\Autocad Client\419 - HB Land\01 - Courtney Drive\Precinct-Stage 02\Engineering Drawings\Current\41901-02-600.dwg, PLAN SHEET 03, 21/06/2024 12:27:33 PM, 1:2

PROJECT NAME

COURTNEY DR UPPER COOMERA

STAGE 02

RP DESCRIPTION

LOT 188, 189, 190, 191 & 192 ON RP173728
COURTNEY DRIVE
LOCALITY OF UPPER COOMERA
LOCAL AUTHORITY - GOLD COAST CITY COUNCIL

CLIENT

HB Land

NORTH

0 5 10 15 20 25m

Scale 1:500 - A1 (1:1000 - A3)

REV	DATE	DESCRIPTION	INT
A	13-10-23	COUNCIL ISSUE	EP

COPYRIGHT IS VESTED IN MORTONS-URBAN SOLUTIONS AND WRITTEN CONSENT IS REQUIRED PRIOR TO REPRODUCTION. DO NOT SCALE FROM THIS DRAWING.

ASSOCIATED CONSULTANTS

BIOME WATER AND ENVIRONMENTAL CONSULTING

Robin Russell & ASSOCIATES PTY. LTD.

BENNETT + BENNETT

DRAWING TITLE

STORMWATER DRAINAGE PLAN SHEET 03

MORTONS urbansolutions
Urban & Regional Planning
Civil Engineering
Project Coordination

MUS Pty Ltd T/As:
Mortons-Urban Solutions
ABN: 39 116 375 065
mortons@urbansolutions.net.au
www.urbansolutions.net.au
Tel 07 5571 1099

Postal Address
PO Box 2484
Southport QLD 4215


Gold Coast Office
Suite 9, 19 Short St
Southport QLD 4215


DESIGNED	RB	DRAWN	EP
APPROVED		RPEQ	4706
		DATE	13-10-23

DRAWING NUMBER	REV
41901-02-602	A

STRUCTURE NAME

STRUCTURE DESCRIPTION

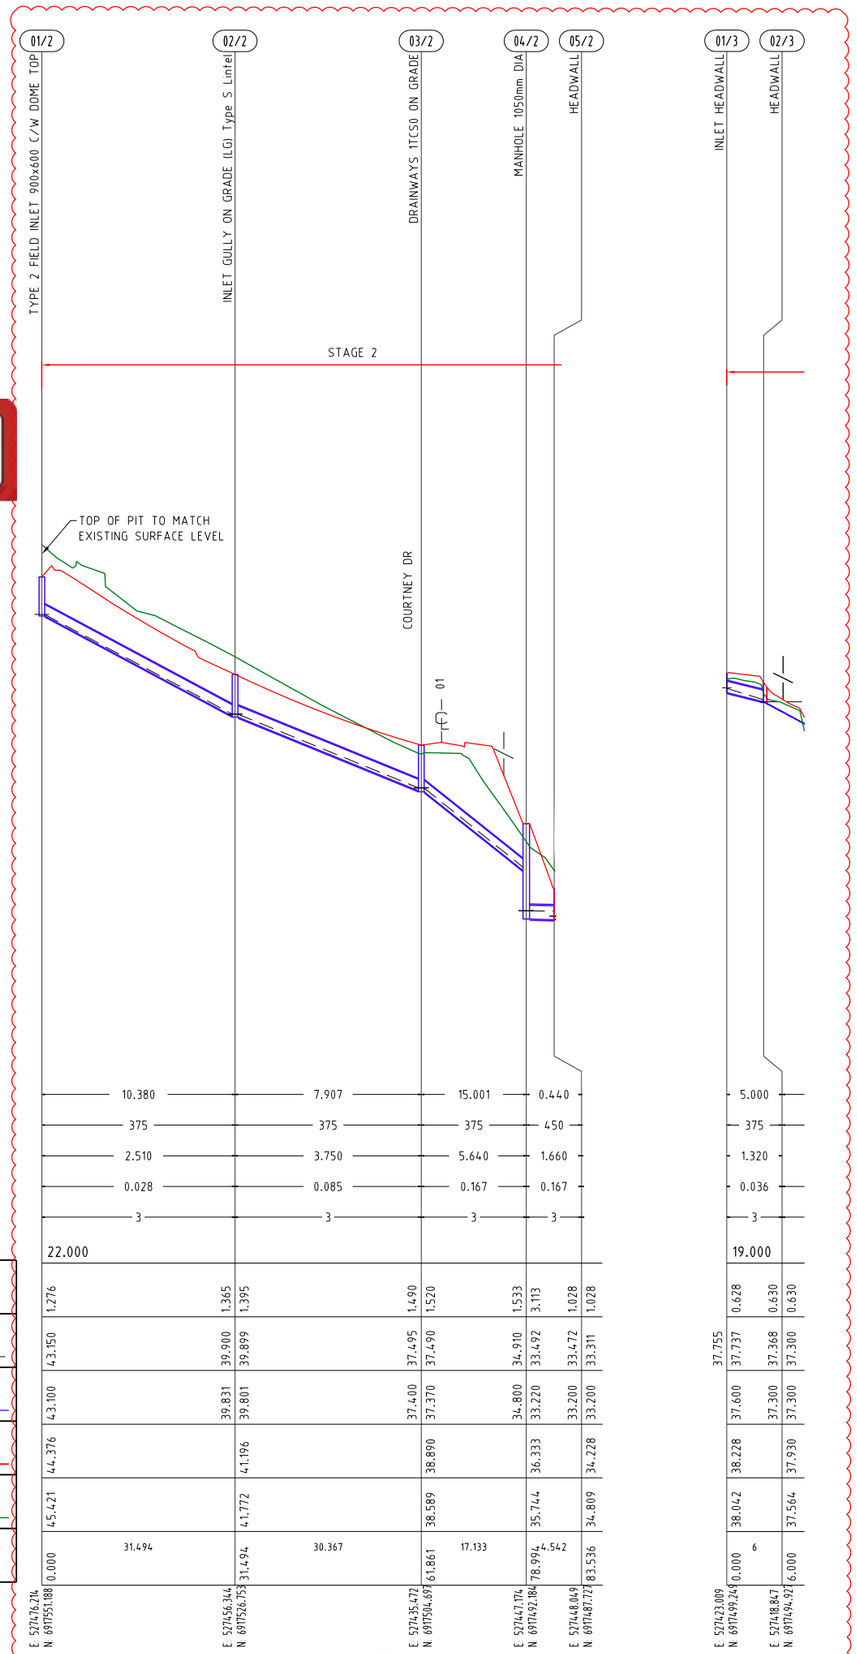

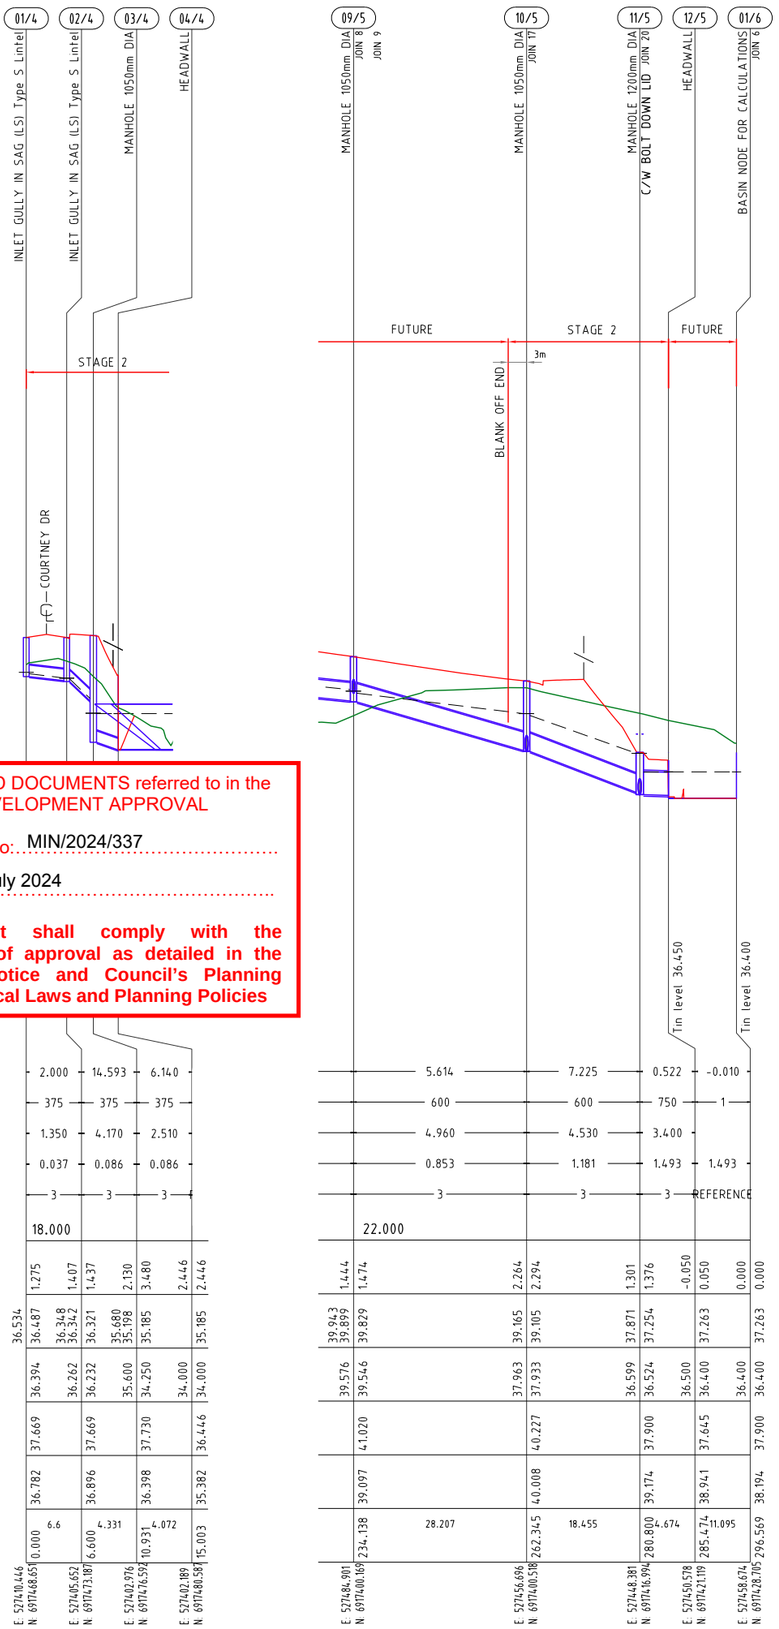

PLANS AND DOCUMENTS referred to in the DEVELOPMENT APPROVAL

Application No: MIN/2024/337

Dated: 16 July 2024

Development shall comply with the conditions of approval as detailed in the Decision Notice and Council's Planning Scheme, Local Laws and Planning Policies

DIAL BEFORE YOU DIG www.1100.com.au

NOTES

1. WHERE STRUCTURE DEPTHS ARE 0m TO 3m REFER TO IPWEA STANDARD DRAWINGS FOR STRUCTURE DETAILS.
   WHERE STRUCTURE DEPTHS ARE 3m TO 5m REFER TO TMR STANDARD DRAWINGS FOR STRUCTURE DETAILS.
   WHERE STRUCTURE DEPTHS EXCEED 5m STRUCTURES ARE NON-STANDARD AND STRUCTURAL DESIGN IS REQUIRED.
2. STRUCTURAL DESIGN IS NOT PROVIDED AS PART OF THE TENDER DOCUMENTS, THE CONTRACTOR SHALL INCLUDE IN THEIR PRICE THE STRUCTURAL DESIGN AND CERTIFICATION OF THESE STRUCTURES.

PIPE GRADE (%)
PIPE DIAMETER (mm)
VELOCITY (m/s)
PIPE FLOW (m3/s)
PIPE CLASS
DATUM R.L.
DEPTH TO INVERT
HYDRAULIC GRADE LINE
PIPE INVERT LEVELS
DESIGN SURFACE LEVELS
EXISTING SURFACE LEVELS
CHAINAGE

DRAINAGE LINE

PROJECT NAME

COURTNEY DR UPPER COOMERA

STAGE 02

RP DESCRIPTION

LOT 188, 189, 190, 191 & 192 ON RP173728
COURTNEY DRIVE
LOCALITY OF UPPER COOMERA
LOCAL AUTHORITY - GOLD COAST CITY COUNCIL

CLIENT

HB Land

0 5 10 15 20 25m
Horiz. Scale 1:500 - A1 (1:1000 - A3)

0 1 2 3 4 5m
Vert. Scale 1:100 - A1 (1:200 - A3)

REV	DATE	DESCRIPTION	INT
D	18-06-24	LINE 2 & 3 AMENDED	RK
C	15-01-24	LONG SECTIONS AMENDED	BL
B	29-11-23	LONG SECTIONS UPDATED	BL
A	13-10-23	COUNCIL ISSUE	EP

COPYRIGHT IS VESTED IN MORTONS-URBAN SOLUTIONS AND WRITTEN CONSENT IS REQUIRED PRIOR TO REPRODUCTION. DO NOT SCALE FROM THIS DRAWING.

ASSOCIATED CONSULTANTS

BIOME WATER AND ENVIRONMENTAL CONSULTING
Robin Russell & ASSOCIATES PTY. LTD.
BENNETT + BENNETT

DRAWING TITLE

STORMWATER PROFILES SHEET 01

MORTONS urbansolutions
Urban & Regional Planning
Civil Engineering
Project Coordination
MUS Pty Ltd T/As
Mortons-Urban Solutions
ABN 39 116 375 065
mortons@urbansolutions.net.au
www.urbansolutions.net.au
Tel 07 5571 1099
Postal Address
PO Box 2484
Southport QLD 4215
Gold Coast Office
Suite 9, 19 Short St
Southport QLD 4215

DESIGNED	RB	DRAWN	EP
APPROVED	RPEQ 4706	DATE	13-10-23

DRAWING NUMBER 41901-02-620 REV D

F:\Autocad Client\419 - HB Land\01 - Courtney Drive\Precinct-Stage 02\Engineering Drawings\Current\41901-02-620.dwg, SHEET 01, 21/06/2024 1:27:44 PM, 1:2


STRUCTURE NAME

STRUCTURE DESCRIPTION



NOTES

1. WHERE STRUCTURE DEPTHS ARE 0m TO 3m REFER TO IPWEA STANDARD DRAWINGS FOR STRUCTURE DETAILS. WHERE STRUCTURE DEPTHS ARE 3m TO 5m REFER TO TMR STANDARD DRAWINGS FOR STRUCTURE DETAILS. WHERE STRUCTURE DEPTHS EXCEED 5m STRUCTURES ARE NON-STANDARD AND STRUCTURAL DESIGN IS REQUIRED.
2. STRUCTURAL DESIGN IS NOT PROVIDED AS PART OF THE TENDER DOCUMENTS, THE CONTRACTOR SHALL INCLUDE IN THEIR PRICE THE STRUCTURAL DESIGN AND CERTIFICATION OF THESE STRUCTURES.

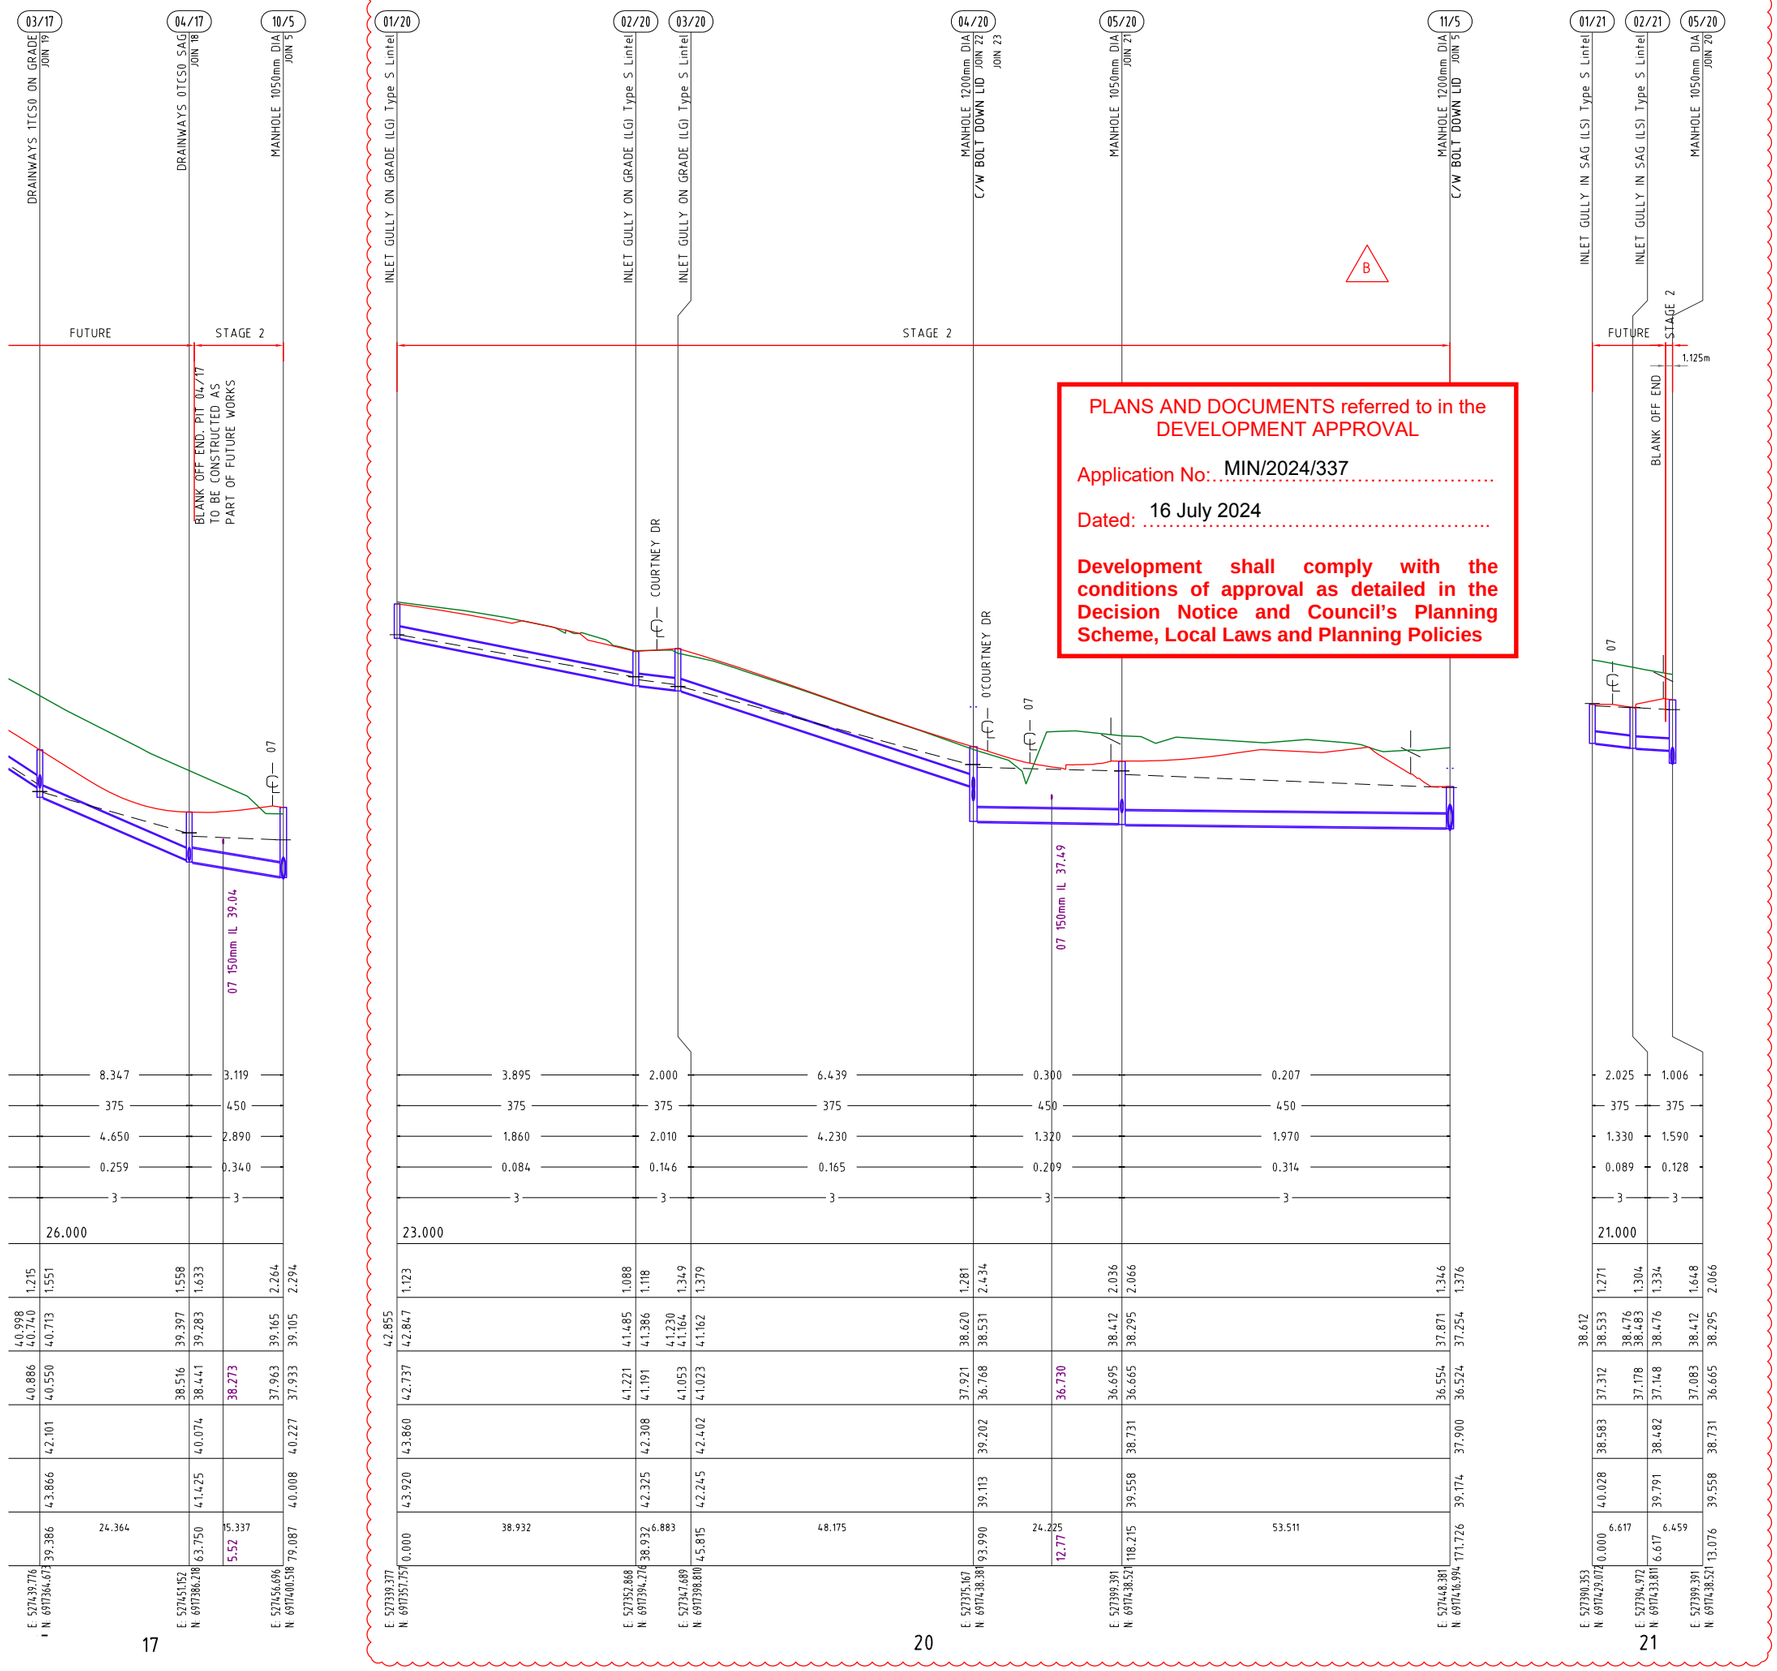

DRAINAGE LINE

PLANS AND DOCUMENTS referred to in the DEVELOPMENT APPROVAL

Application No: MIN/2024/337

Dated: 16 July 2024

Development shall comply with the conditions of approval as detailed in the Decision Notice and Council's Planning Scheme, Local Laws and Planning Policies

PROJECT NAME

COURTNEY DR UPPER COOMERA

STAGE 02

RP DESCRIPTION

LOT 188, 189, 190, 191 & 192 ON RP173728
COURTNEY DRIVE
LOCALITY OF UPPER COOMERA
LOCAL AUTHORITY - GOLD COAST CITY COUNCIL

CLIENT

HB Land

0 5 10 15 20 25m
Horiz. Scale 1:500 - A1 (1:1000 - A3)

0 1 2 3 4 5m
Vert. Scale 1:100 - A1 (1:200 - A3)

REV	DATE	DESCRIPTION	INT
B	15-01-24	LONG SECTIONS AMENDED	BL
A	13-10-23	COUNCIL ISSUE	EP

COPYRIGHT IS VESTED IN MORTONS-URBAN SOLUTIONS AND WRITTEN CONSENT IS REQUIRED PRIOR TO REPRODUCTION. DO NOT SCALE FROM THIS DRAWING.

ASSOCIATED CONSULTANTS

BIOME WATER AND ENVIRONMENTAL CONSULTING
Robin Russell & ASSOCIATES PTY. LTD.
BENNETT + BENNETT

DRAWING TITLE

STORMWATER PROFILES SHEET 02

MORTONS urbansolutions
Urban & Regional Planning
Civil Engineering
Project Coordination
MUS Pty Ltd T/As:
Mortons-Urban Solutions
ABN: 39 116 375 065
mortons@urbansolutions.net.au
www.urbansolutions.net.au
Tel 07 5571 1099
Postal Address
PO Box 2484
Southport QLD 4215
Gold Coast Office
Suite 9, 19 Short St
Southport QLD 4215

DESIGNED	RB	DRAWN	EP
APPROVED		RPEQ	4706
DATE	13-10-23		

DRAWING NUMBER 41901-02-621

REV B

F:\Autocad Client\419 - HB Land\01 - Courtney Drive\Precinct-Stage 02\Engineering Drawings\Current\41901-02-620.dwg, SHEET 02, 21/06/2024 1:27:46 PM, 12

F:\Autocad Client\419 - HB Land\01 - Courtney Drive\Precinct-Stage 02\Engineering Drawings\Current\41901-02-620.dwg, SHEET 03, 21/06/2024 1:27:47 PM, 1:2

STRUCTURE NAME

STRUCTURE DESCRIPTION

DIAL BEFORE YOU DIG www.1100.com.au



NOTES

1. WHERE STRUCTURE DEPTHS ARE 0m TO 3m REFER TO IPWEA STANDARD DRAWINGS FOR STRUCTURE DETAILS. WHERE STRUCTURE DEPTHS ARE 3m TO 5m REFER TO TMR STANDARD DRAWINGS FOR STRUCTURE DETAILS. WHERE STRUCTURE DEPTHS EXCEED 5m STRUCTURES ARE NON-STANDARD AND STRUCTURAL DESIGN IS REQUIRED.
2. STRUCTURAL DESIGN IS NOT PROVIDED AS PART OF THE TENDER DOCUMENTS, THE CONTRACTOR SHALL INCLUDE IN THEIR PRICE THE STRUCTURAL DESIGN AND CERTIFICATION OF THESE STRUCTURES.

PLANS AND DOCUMENTS referred to in the DEVELOPMENT APPROVAL

Application No: MIN/2024/337

Dated: 16 July 2024

Development shall comply with the conditions of approval as detailed in the Decision Notice and Council's Planning Scheme, Local Laws and Planning Policies

DRAINAGE LINE 22

DATUM R.L. 21.000

Structure	Description	Depth to invert	Hydraulic grade line	Pipe invert levels	Design surface levels	Existing surface levels	Chainage	Coordinates
01/22	INLET GULLY ON GRADE (LG) Type S Lintel	1.375	38.676 / 38.624	38.043	39.418	39.338	0.000	E: 527375.390 N: 6917430.730
04/20	MANHOLE 1200mm DIA C/W BOLT DOWN LID JOIN 20	1.732 / 2.434	38.620 / 38.531	37.470 / 36.768	39.202	39.113	7.654	E: 527375.167 N: 6917438.381

Pipe	Pipe grade (%)	Pipe diameter (mm)	Velocity (m/s)	Pipe flow (m3/s)	Pipe class	Length
01/22 – 04/20	7.486	375	2.470	0.041	3	7.654

DRAINAGE LINE 23

DATUM R.L. 21.000

Structure	Description	Depth to invert	Hydraulic grade line	Pipe invert levels	Design surface levels	Existing surface levels	Chainage	Coordinates
01/23	INLET GULLY ON GRADE (LG) Type S Lintel	1.363	38.622 / 38.620	37.885	39.248	39.135	0.000	E: 527373.988 N: 6917439.388
04/20	MANHOLE 1200mm DIA C/W BOLT DOWN LID JOIN 20	1.395 / 2.434	38.620 / 38.531	37.807 / 36.768	39.202	39.113	1.550	E: 527375.167 N: 6917438.381

Pipe	Pipe grade (%)	Pipe diameter (mm)	Velocity (m/s)	Pipe flow (m3/s)	Pipe class	Length
01/23 – 04/20	4.999	375	1.760	0.015	3	1.55

DRAINAGE LINE 24

DATUM R.L. 33.000

Structure	Description	Depth to invert	Hydraulic grade line	Pipe invert levels	Design surface levels	Existing surface levels	Chainage	Coordinates
01/24	INLET GULLY ON GRADE (LG) Type S Lintel	1.147	49.316	49.293	50.440	55.159	0.000	E: 527383.227 N: 6917280.341
02/24	INLET GULLY ON GRADE (LG) Type S Lintel	1.117 / 1.147	48.954 / 48.927	48.931 / 48.901	50.048	54.611	4.900	E: 527379.103 N: 6917282.987
03/24	INLET GULLY ON GRADE (LG) Type S Lintel	1.143 / 1.173	48.538 / 48.512	48.513 / 48.483	49.656	54.063	9.800	E: 527374.978 N: 6917285.633
04/24	INLET GULLY ON GRADE (LG) Type S Lintel	1.108 / 1.138	48.186 / 48.160	48.157 / 48.127	49.264	53.515	14.700	E: 527370.854 N: 6917288.279
10/26	MANHOLE 1500mm DIA JOIN 26	1.123 / 2.380	47.640 46.693 / 46.630	47.606 / 46.350	48.730	52.828	23.545	E: 527367.468 N: 6917296.450

Pipe	Pipe grade (%)	Pipe diameter (mm)	Velocity (m/s)	Pipe flow (m3/s)	Pipe class	Length
01/24 – 02/24	7.388	375	1.620	0.004	3	4.9
02/24 – 03/24	7.922	375	1.820	0.006	3	4.9
03/24 – 04/24	6.655	375	1.830	0.007	3	4.9
04/24 – 10/26	5.882	375	1.840	0.009	3	8.845

DRAINAGE LINE 25

DATUM R.L. 33.000

Structure	Description	Depth to invert	Hydraulic grade line	Pipe invert levels	Design surface levels	Existing surface levels	Chainage	Coordinates
08/25	INLET GULLY ON GRADE (LG) Type S Lintel	1.274 / 1.304	52.151 / 52.141	51.274 / 51.244	52.548	46.065	164.479	E: 527313.920 N: 6917153.853
09/25	DRAINWAYS 1TCS0 ON GRADE JOIN 33	1.752 / 1.782	51.546 / 51.205	50.605 / 50.575 / 50.519	52.357	44.051	196.416 (2.65)	E: 527331.164 N: 6917180.734
10/25	MANHOLE 1050mm DIA	3.182 / 4.687	50.108 48.584 / 48.500	49.818 / 48.313	53.000	42.396	226.712	E: 527305.664 N: 6917197.092
11/25	MANHOLE 1050mm DIA	0.971 / 2.298	47.267 46.226 / 46.224	47.106 / 45.780	48.077	42.215	234.760	E: 527297.943 N: 6917199.362
12/25	MANHOLE 1050mm DIA	1.006 / 1.326	45.455	44.994 / 44.674	46.000	41.992	239.998	E: 527292.917 N: 6917200.839
13/25	HEADWALL	-0.100 / -0.100	45.449	44.650 / 44.650	45.600	41.827	244.853	E: 527288.260 N: 6917202.208
14/25	BASIN NODE FOR CALCULATIONS JOIN 1 JOIN 26	0.996 / 0.996	45.449	44.500 / 44.500	45.300	45.620	286.501	E: 527261.241 N: 6917170.514
15/25	1050mm DIA MANHOLE C/W ROOF SLAB AND 900x600 DOME TOP	-1.500 / 1.700	45.449 43.130 / 42.981	46.000 / 42.800	45.300	41.613	324.399	E: 527278.645 N: 6917204.180

Pipe	Pipe grade (%)	Pipe diameter (mm)	Velocity (m/s)	Pipe flow (m3/s)	Pipe class	Length
08/25 – 09/25	2.000	375	2.680	0.270	3	31.937
09/25 – 10/25	2.500	375	3.280	0.340	3	30.296
10/25 – 11/25	14.999	375	5.360	0.340	3	8.049
11/25 – 12/25	14.999	375	4.610	0.342	3	5.238
12/25 – 13/25	0.500	600	2.580	0.359	3	4.855
13/25 – 14/25	0.360	1		0.359	REFERENCE	41.648
14/25 – 15/25	-3.958	1		0.285	REFERENCE	37.898

33.00


PROJECT NAME

COURTNEY DR UPPER COOMERA

STAGE 02

RP DESCRIPTION

LOT 188, 189, 190, 191 & 192 ON RP173728
COURTNEY DRIVE
LOCALITY OF UPPER COOMERA
LOCAL AUTHORITY - GOLD COAST CITY COUNCIL

CLIENT

HB Land

0 5 10 15 20 25m — Horiz. Scale 1:500 - A1 (1:1000 - A3)

0 1 2 3 4 5m — Vert. Scale 1:100 - A1 (1:200 - A3)

REV	DATE	DESCRIPTION	INT
B	15-01-24	LONG SECTIONS AMENDED	BL
A	13-10-23	COUNCIL ISSUE	EP

COPYRIGHT IS VESTED IN MORTONS-URBAN SOLUTIONS AND WRITTEN CONSENT IS REQUIRED PRIOR TO REPRODUCTION. DO NOT SCALE FROM THIS DRAWING.

ASSOCIATED CONSULTANTS

BIOME WATER AND ENVIRONMENTAL CONSULTING

Robin Russell & ASSOCIATES PTY. LTD.

BENNETT+BENNETT

DRAWING TITLE

STORMWATER PROFILES SHEET 03

MORTONS urbansolutions
Urban & Regional Planning
Civil Engineering
Project Coordination
MUS Pty Ltd T/As: Mortons-Urban Solutions
ABN: 39 116 375 065
mortons@urbansolutions.net.au
www.urbansolutions.net.au
Tel 07 5571 1099
Postal Address PO Box 2484 Southport QLD 4215
Gold Coast Office Suite 9, 19 Short St Southport QLD 4215

DESIGNED RB	DRAWN EP
APPROVED	RPEQ 4706 — DATE 13-10-23

DRAWING NUMBER 41901-02-622 — REV B


STRUCTURE NAME

STRUCTURE DESCRIPTION



NOTES

1. WHERE STRUCTURE DEPTHS ARE 0m TO 3m REFER TO IPWEA STANDARD DRAWINGS FOR STRUCTURE DETAILS. WHERE STRUCTURE DEPTHS ARE 3m TO 5m REFER TO TMR STANDARD DRAWINGS FOR STRUCTURE DETAILS. WHERE STRUCTURE DEPTHS EXCEED 5m STRUCTURES ARE NON-STANDARD AND STRUCTURAL DESIGN IS REQUIRED.
2. STRUCTURAL DESIGN IS NOT PROVIDED AS PART OF THE TENDER DOCUMENTS, THE CONTRACTOR SHALL INCLUDE IN THEIR PRICE THE STRUCTURAL DESIGN AND CERTIFICATION OF THESE STRUCTURES.

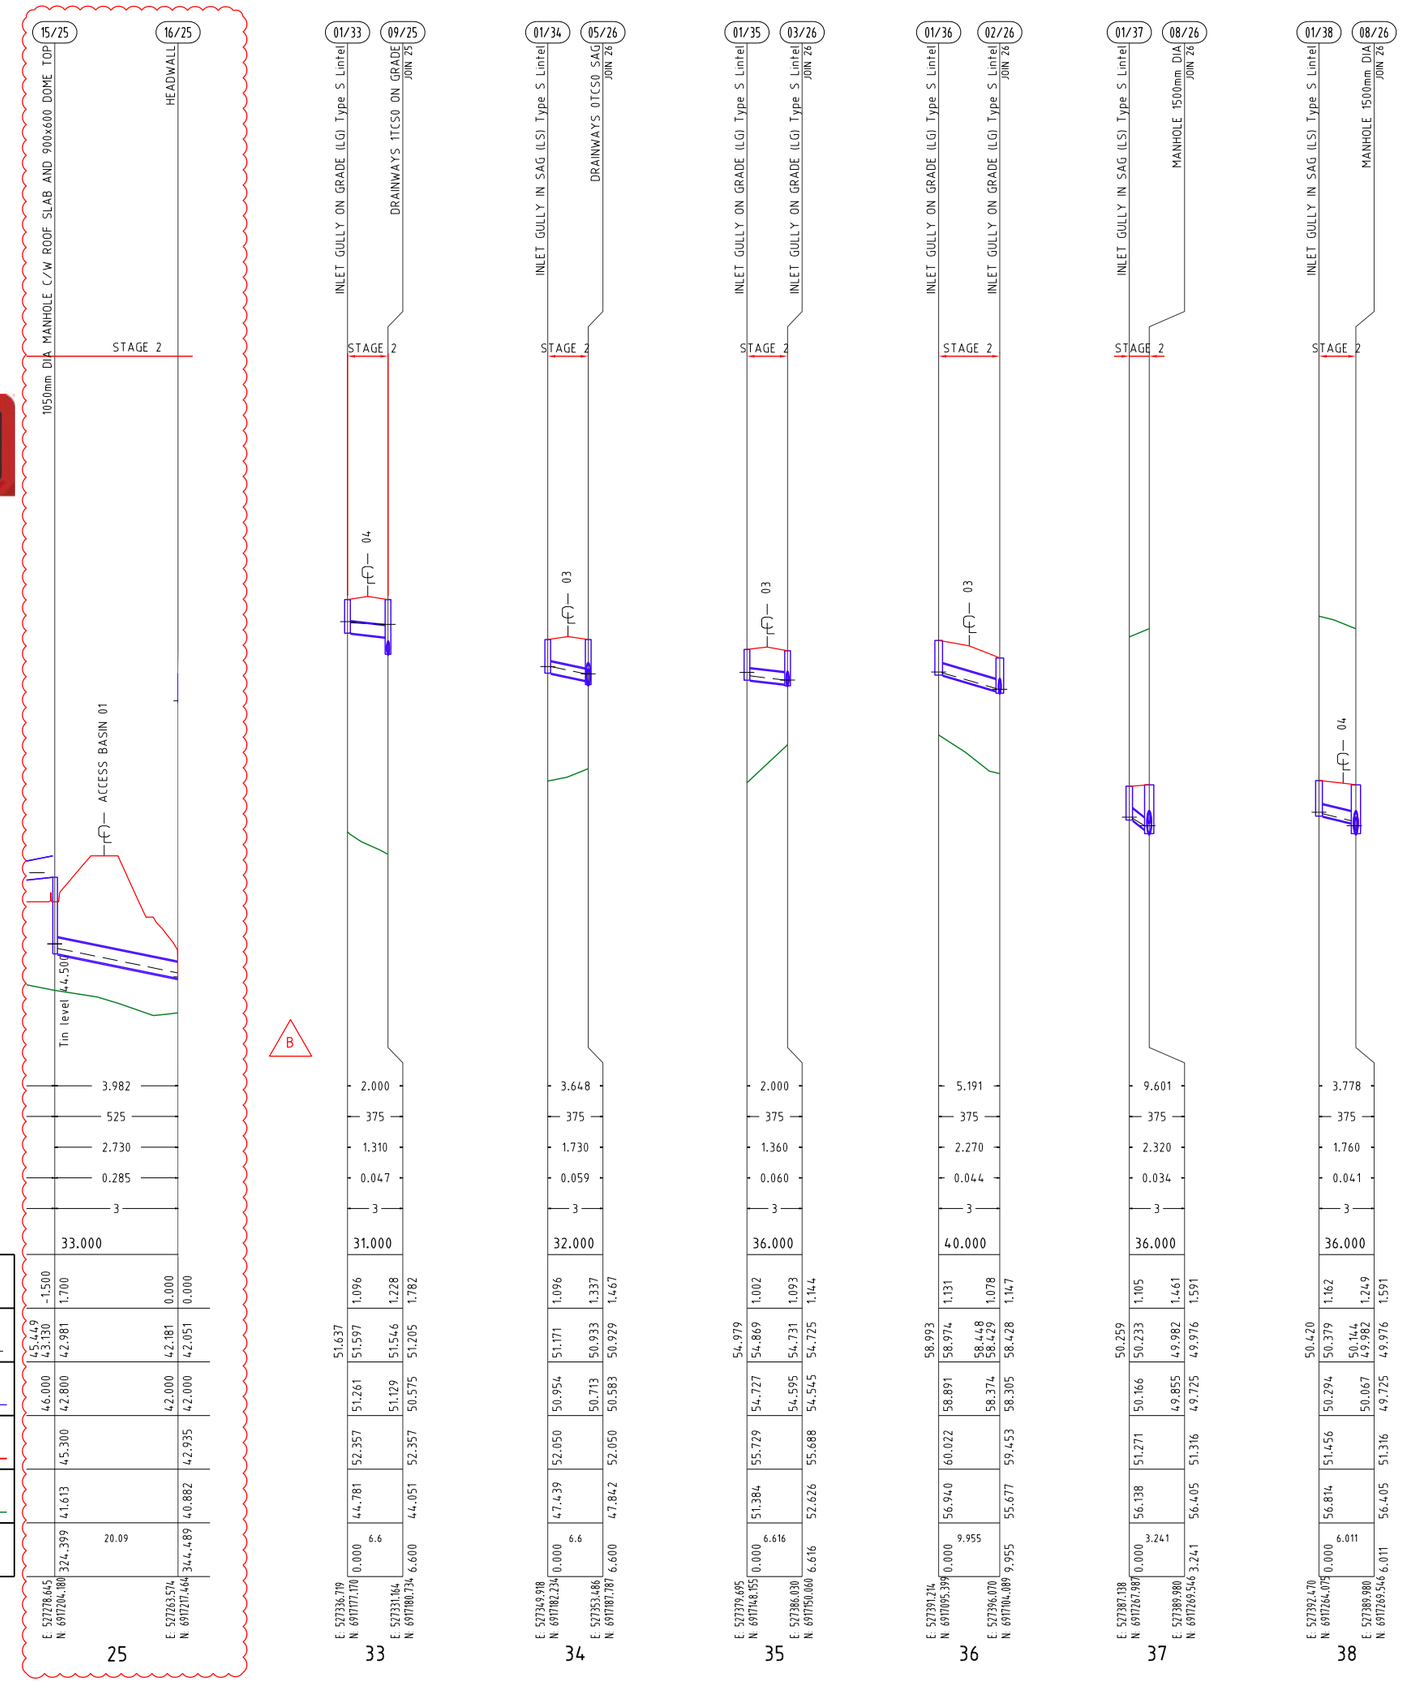

PLANS AND DOCUMENTS referred to in the DEVELOPMENT APPROVAL

Application No: MIN/2024/337

Dated: 16 July 2024

Development shall comply with the conditions of approval as detailed in the Decision Notice and Council's Planning Scheme, Local Laws and Planning Policies

0 5 10 15 20 25m
Horiz. Scale 1:500 - A1 (1:1000 - A3)

0 1 2 3 4 5m
Vert. Scale 1:100 - A1 (1:200 - A3)

REV	DATE	DESCRIPTION	INT
B	29-11-23	LONG SECTIONS UPDATED	BL
A	13-10-23	COUNCIL ISSUE	EP

COPYRIGHT IS VESTED IN MORTONS-URBAN SOLUTIONS AND WRITTEN CONSENT IS REQUIRED PRIOR TO REPRODUCTION. DO NOT SCALE FROM THIS DRAWING.

PROJECT NAME

COURTNEY DR UPPER COOMERA

STAGE 02

RP DESCRIPTION

LOT 188, 189, 190, 191 & 192 ON RP173728
COURTNEY DRIVE
LOCALITY OF UPPER COOMERA
LOCAL AUTHORITY - GOLD COAST CITY COUNCIL

CLIENT

HB Land

ASSOCIATED CONSULTANTS

BIOME WATER AND ENVIRONMENTAL CONSULTING

Robin Russell & ASSOCIATES PTY. LTD.

BENNETT+BENNETT

DRAWING TITLE

STORMWATER PROFILES SHEET 04

MORTONS urbansolutions
Urban & Regional Planning
Civil Engineering
Project Coordination

MUS Pty Ltd T/As:
Mortons-Urban Solutions
ABN: 39 116 375 065

mortons@urbansolutions.net.au
www.urbansolutions.net.au
Tel 07 5571 1099

Postal Address
PO Box 2484
Southport QLD 4215

Gold Coast Office
Suite 9, 19 Short St
Southport QLD 4215

DESIGNED RB	DRAWN EP
APPROVED RPEQ 4706	DATE 13-10-23

DRAWING NUMBER 41901-02-623

REV B

F:\Autocad Client\419 - HB Land\01 - Courtney Drive\Precinct-Stage 02\Engineering Drawings\Current\41901-02-620.dwg, SHEET 04, 21/06/2024 1:27:49 PM, 1:2

STRUCTURE NAME

STRUCTURE DESCRIPTION

	01/26	02/26	03/26	04/26	05/26	06/26	07/26	08/26	09/26	10/26
	INLET GULLY ON GRADE (LG) Type S Lintel	INLET GULLY ON GRADE (LG) Type S Lintel JOIN 36	INLET GULLY ON GRADE (LG) Type S Lintel JOIN 35	INLET GULLY ON GRADE (LG) Type S Lintel	DRAINWAYS OTCSD SAG JOIN 34	MANHOLE 1200mm DIA	MANHOLE 1500mm DIA JOIN 39 JOIN 40	MANHOLE 1500mm DIA JOIN 37 JOIN 38	MANHOLE 1500mm DIA JOIN 41	MANHOLE 1500mm DIA JOIN 24
PIPE GRADE (%)	6.126	7.842	7.400	6.586	0.721	0.667	1.000	5.071	6.250	5
PIPE DIAMETER (mm)	375	375	375	450	675	675	675	675	675	
VELOCITY (m/s)	3.010	4.500	4.890	3.470	2.190	2.170	2.930	5.040	6.160	5
PIPE FLOW (m3/s)	0.054	0.139	0.248	0.306	0.394	0.395	0.526	0.598	0.784	0
PIPE CLASS	3	3	3	3	3	3	3	3	3	
DATUM R.L.	34.000									34.000
DEPTH TO INVERT	1.131	1.073	1.147	1.073	1.144	1.072	1.375	1.437	1.467	1.789	1.819	1.806	1.836	1.561	1.591	1.688	1.718	1.281	2.380
HYDRAULIC GRADE LINE	60.237	58.458 58.429	58.428	54.734 54.731	54.725	52.656 52.365	52.363	50.933	50.929	50.824	50.801	50.416	50.412	50.085 49.982	49.976	49.285	49.278	47.696 46.693	46.630
PIPE INVERT LEVELS	60.153	58.380	58.305	54.615	54.545	53.011	52.491	52.188	50.613	50.583	50.482	50.452	50.096	50.066	49.861	49.755	49.725	49.615	49.041	49.011	47.449	46.350
DESIGN SURFACE LEVELS	61.285	59.453	55.688	53.563	52.050	52.271	51.902	51.316	50.729	48.730
EXISTING SURFACE LEVELS	61.110	55.677	52.626	51.421	47.842	45.875	54.677	56.405	55.560	52.828
CHAINAGE	0.000	28.949	76.003	103.757	127.664	141.672	195.156	226.210	239.699	264.695
		28.949	47.054	27.754	20.50	23.906	14.008	53.485	31.054	20.20	2.69	13.489	24.996	2
	E. 527402.246 N. 6917075.806	E. 527396.070 N. 6917104.089	E. 527386.030 N. 6917150.060	E. 527373.608 N. 6917174.878	E. 527353.486 N. 6917187.787	E. 527344.333 N. 6917198.390	E. 527373.212 N. 6917243.408	E. 527389.980 N. 6917269.544	E. 527388.508 N. 6917282.354	E. 527367.468 N. 6917296.450

STAGE 2

19 150mm IL 52.15

17 150mm IL 49.29

24 80mm IL 50.54

03 03 04 01 01

DRAINAGE LINE

26 26

NOTES

1. WHERE STRUCTURE DEPTHS ARE 0m TO 3m REFER TO IPWEA STANDARD DRAWINGS FOR STRUCTURE DETAILS. WHERE STRUCTURE DEPTHS ARE 3m TO 5m REFER TO TMR STANDARD DRAWINGS FOR STRUCTURE DETAILS. WHERE STRUCTURE DEPTHS EXCEED 5m STRUCTURES ARE NON-STANDARD AND STRUCTURAL DESIGN IS REQUIRED.
2. STRUCTURAL DESIGN IS NOT PROVIDED AS PART OF THE TENDER DOCUMENTS, THE CONTRACTOR SHALL INCLUDE IN THEIR PRICE THE STRUCTURAL DESIGN AND CERTIFICATION OF THESE STRUCTURES.

DIAL BEFORE YOU DIG www.1100.com.au

PLANS AND DOCUMENTS referred to in the DEVELOPMENT APPROVAL

Application No: MIN/2024/337

Dated: 16 July 2024

Development shall comply with the conditions of approval as detailed in the Decision Notice and Council's Planning Scheme, Local Laws and Planning Policies

PROJECT NAME

COURTNEY DR UPPER COOMERA

STAGE 02

RP DESCRIPTION

LOT 188, 189, 190, 191 & 192 ON RP173728
COURTNEY DRIVE
LOCALITY OF UPPER COOMERA
LOCAL AUTHORITY - GOLD COAST CITY COUNCIL

CLIENT

HB Land

0 5 10 15 20 25m
Horiz. Scale 1:500 - A1 (1:1000 - A3)

0 1 2 3 4 5m
Vert. Scale 1:100 - A1 (1:200 - A3)

REV	DATE	DESCRIPTION	INT
B	17-01-24	PROFILES REVISED	EP
A	13-10-23	COUNCIL ISSUE	EP

COPYRIGHT IS VESTED IN MORTONS-URBAN SOLUTIONS AND WRITTEN CONSENT IS REQUIRED PRIOR TO REPRODUCTION. DO NOT SCALE FROM THIS DRAWING.

ASSOCIATED CONSULTANTS

BIOME WATER AND ENVIRONMENTAL CONSULTING
Robin Russell & ASSOCIATES PTY. LTD.
BENNETT + BENNETT

DRAWING TITLE

STORMWATER PROFILES SHEET 05

MORTONS urbansolutions
Urban & Regional Planning
Civil Engineering
Project Coordination
MUS Pty Ltd T/As:
Mortons-Urban Solutions
ABN: 39 116 375 065
mortons@urbansolutions.net.au
www.urbansolutions.net.au
Tel 07 5571 1099
Postal Address
PO Box 2484
Southport QLD 4215
Gold Coast Office
Suite 9, 19 Short St
Southport QLD 4215

DESIGNED	RB	DRAWN	EP
APPROVED		RPEQ	4706
		DATE	13-10-23

DRAWING NUMBER 41901-02-624

REV A

F:\Autocad Client\419 - HB Land\01 - Courtney Drive\Precinct-Stage 02\Engineering Drawings\Current\41901-02-620.dwg, SHEET 05, 21/06/2024 1:27:51 PM, 1:2


PLANS AND DOCUMENTS referred to in the DEVELOPMENT APPROVAL

Application No: MIN/2024/337

Dated: 16 July 2024

Development shall comply with the conditions of approval as detailed in the Decision Notice and Council's Planning Scheme, Local Laws and Planning Policies

STRUCTURE NAME	10/26	11/26	12/26	14/25	01/39	07/26	01/40	07/26	01/41	02/41	03/41	09/26
STRUCTURE DESCRIPTION	MANHOLE 1500mm DIA JOIN 24	1200 DIA MANHOLE EXTENDED 600mm	HEADWALL	BASIN NODE FOR CALCULATIONS JOIN 25	INLET GULLY ON GRADE (LG) Type S Lintel	MANHOLE 1500mm DIA JOIN 26	INLET GULLY ON GRADE (LG) Type S Lintel	MANHOLE 1500mm DIA JOIN 26	INLET GULLY ON GRADE (LG) Type S Lintel	INLET GULLY ON GRADE (LG) Type S Lintel	INLET GULLY ON GRADE (LG) Type S Lintel	MANHOLE 1500mm DIA JOIN 26

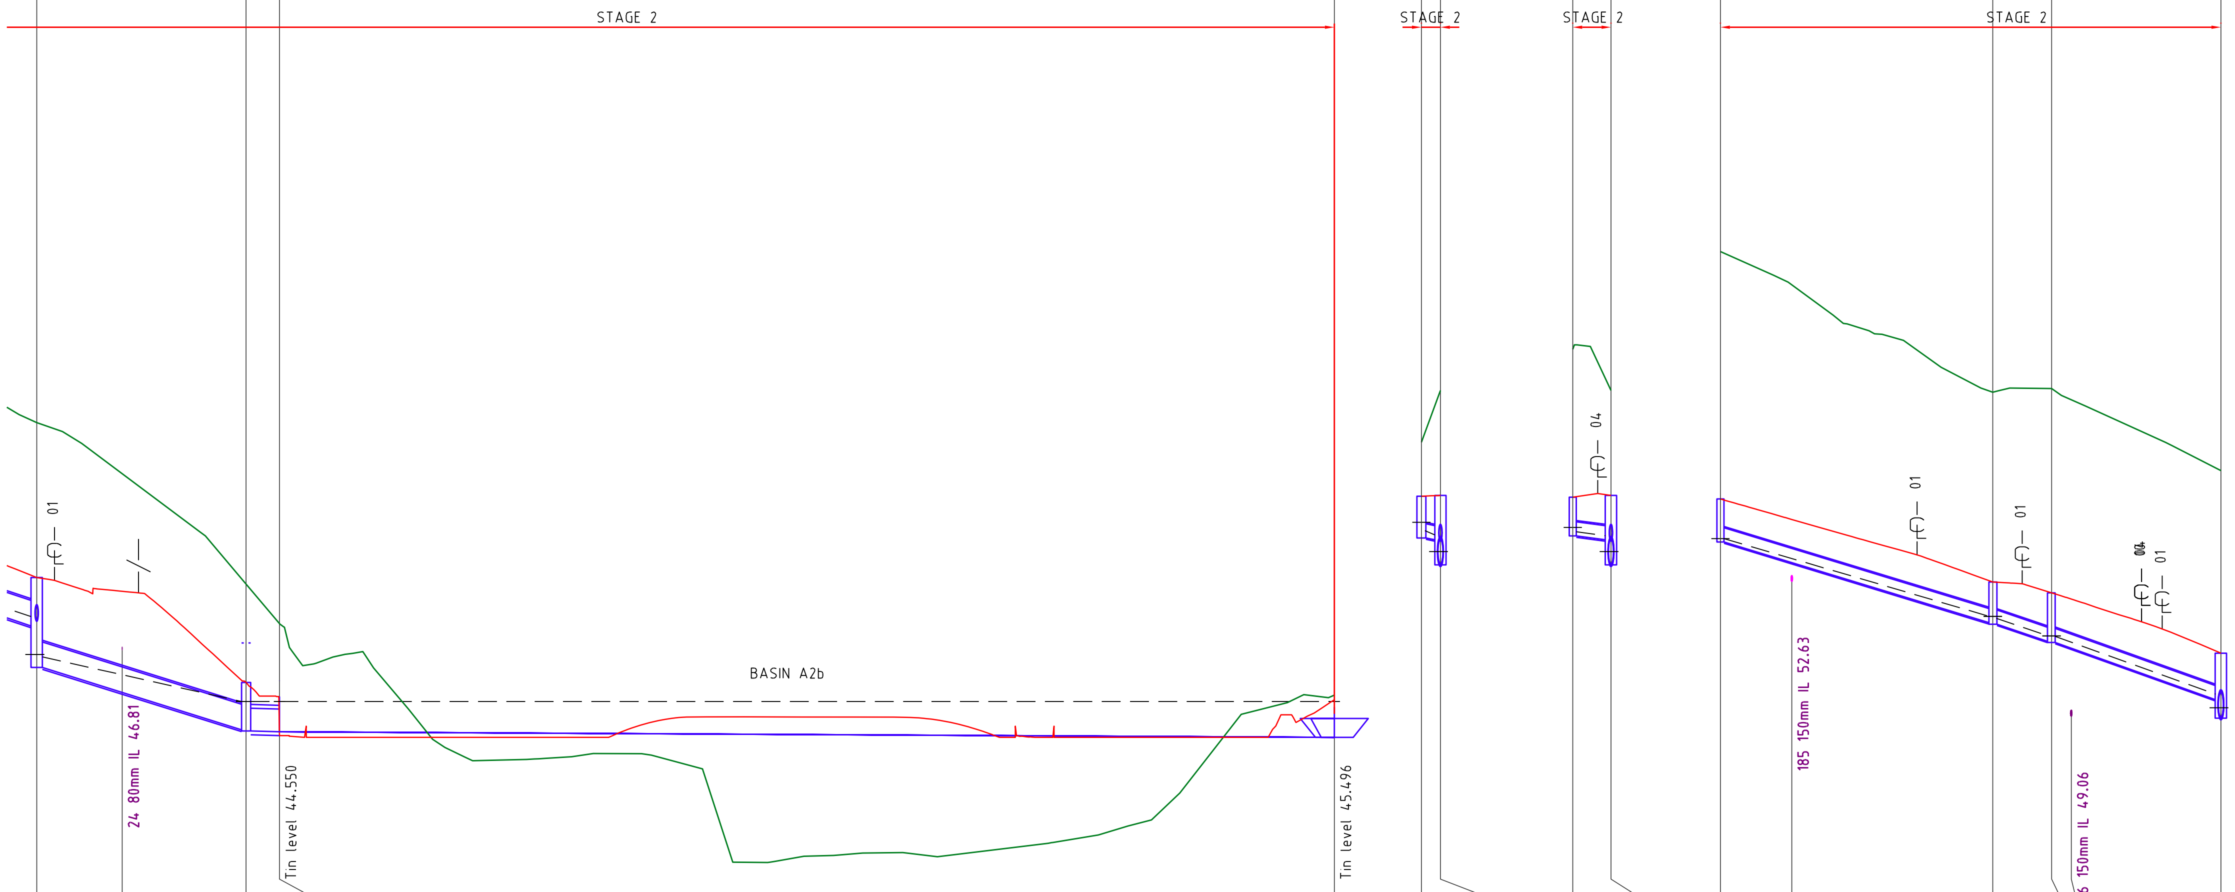

NOTES

1. WHERE STRUCTURE DEPTHS ARE 0m TO 3m REFER TO IPWEA STANDARD DRAWINGS FOR STRUCTURE DETAILS. WHERE STRUCTURE DEPTHS ARE 3m TO 5m REFER TO TMR STANDARD DRAWINGS FOR STRUCTURE DETAILS. WHERE STRUCTURE DEPTHS EXCEED 5m STRUCTURES ARE NON-STANDARD AND STRUCTURAL DESIGN IS REQUIRED.
2. STRUCTURAL DESIGN IS NOT PROVIDED AS PART OF THE TENDER DOCUMENTS, THE CONTRACTOR SHALL INCLUDE IN THEIR PRICE THE STRUCTURAL DESIGN AND CERTIFICATION OF THESE STRUCTURES.

DIAL BEFORE YOU DIG www.1100.com.au

DRAINAGE LINE 26

	10/26 → 11/26	11/26 → 12/26	12/26 → 14/25
PIPE GRADE (%)	5.949	0.500	0.108
PIPE DIAMETER (mm)	675	1500x600	1
VELOCITY (m/s)	5.300	2.410	
PIPE FLOW (m3/s)	0.793	0.793	0.793
PIPE CLASS	3	RCBC	REFERENCE

DATUM R.L. 34.000

	10/26	24 (80mm)	11/26	12/26	14/25
DEPTH TO INVERT	1.281 / 2.380		1.251 / 1.281	-0.100 / -0.100	0.996 / 0.996
HYDRAULIC GRADE LINE	47.696 46.693 / 46.630		45.451	45.449	45.449
PIPE INVERT LEVELS	47.449 / 46.350	45.689	44.702 / 44.672	44.650 / 44.650	44.500 / 44.500
DESIGN SURFACE LEVELS	48.730		45.953	45.580	45.300
EXISTING SURFACE LEVELS	52.828		48.556	47.509	45.620
CHAINAGE	264.695	11.31 (27.698)	292.393 (4.42)	296.814 (139.526)	436.340
COORDINATES	E: 527367.468 N: 6917296.450		E: 527340.749 N: 6917289.153	E: 527336.477 N: 6917288.018	E: 527261.241 N: 6917170.514

DRAINAGE LINE 39

	01/39 → 07/26
PIPE GRADE (%)	1.915
PIPE DIAMETER (mm)	375
VELOCITY (m/s)	1.150
PIPE FLOW (m3/s)	0.079
PIPE CLASS	3

DATUM R.L. 35.000

	01/39	07/26
DEPTH TO INVERT	1.105	1.173 / 1.836
HYDRAULIC GRADE LINE	51.193 / 50.970	50.856 50.416 / 50.412
PIPE INVERT LEVELS	50.776	50.728 / 50.066
DESIGN SURFACE LEVELS	51.882	51.902
EXISTING SURFACE LEVELS	53.308	54.677
CHAINAGE	0.000 (2.518)	2.518
COORDINATES	E: 527370.836 N: 6917242.574	E: 527373.212 N: 6917243.408

DRAINAGE LINE 40

	01/40 → 07/26
PIPE GRADE (%)	2.000
PIPE DIAMETER (mm)	375
VELOCITY (m/s)	1.290
PIPE FLOW (m3/s)	0.057
PIPE CLASS	3

DATUM R.L. 35.000

	01/40	07/26
DEPTH TO INVERT	1.026	1.173 / 1.836
HYDRAULIC GRADE LINE	51.055 / 50.942	50.835 50.416 / 50.412
PIPE INVERT LEVELS	50.829	50.728 / 50.066
DESIGN SURFACE LEVELS	51.855	51.902
EXISTING SURFACE LEVELS	55.765	54.677
CHAINAGE	0.000 (5.05)	5.050
COORDINATES	E: 527377.463 N: 6917240.681	E: 527373.212 N: 6917243.408

DRAINAGE LINE 41

	01/41 → 02/41	02/41 → 03/41	03/41 → 09/26
PIPE GRADE (%)	5.928	5.837	6.748
PIPE DIAMETER (mm)	375	375	375
VELOCITY (m/s)	2.470	3.230	4.300
PIPE FLOW (m3/s)	0.067	0.150	0.193
PIPE CLASS	3	3	3

DATUM R.L. 38.000

	01/41	185 (150mm)	02/41	03/41	16 (150mm)	09/26
DEPTH TO INVERT	1.137		1.075 / 1.116	1.283 / 1.313		1.229 / 1.718
HYDRAULIC GRADE LINE	53.759		51.703 / 51.649	51.185 / 51.174		49.647 49.285 / 49.278
PIPE INVERT LEVELS	53.671	53.125	51.536 / 51.495	51.041 / 51.011	50.858	49.500 / 49.011
DESIGN SURFACE LEVELS	54.809		52.611	52.324		50.729
EXISTING SURFACE LEVELS	61.352		57.634	57.732		55.560
CHAINAGE	0.000 (36.022)	9.45	36.022 (7.776)	43.798 (22.393)	2.61	66.190
COORDINATES	E: 527432.013 N: 6917240.881		E: 527411.167 N: 6917270.259	E: 527404.143 N: 6917266.923		E: 527388.508 N: 6917282.954

PROJECT NAME

COURTNEY DR UPPER COOMERA

STAGE 02

RP DESCRIPTION

LOT 188, 189, 190, 191 & 192 ON RP173728
COURTNEY DRIVE
LOCALITY OF UPPER COOMERA
LOCAL AUTHORITY - GOLD COAST CITY COUNCIL

CLIENT

HB Land

0 5 10 15 20 25m
Horiz. Scale 1:500 - A1 (1:1000 - A3)
0 1 2 3 4 5m
Vert. Scale 1:100 - A1 (1:200 - A3)

REV	DATE	DESCRIPTION	INT
A	13-10-23	COUNCIL ISSUE	EP

COPYRIGHT IS VESTED IN MORTONS-URBAN SOLUTIONS AND WRITTEN CONSENT IS REQUIRED PRIOR TO REPRODUCTION. DO NOT SCALE FROM THIS DRAWING.

ASSOCIATED CONSULTANTS

BIOME WATER AND ENVIRONMENTAL CONSULTING
Robin Russell & ASSOCIATES PTY. LTD.
BENNETT+BENNETT

DRAWING TITLE

STORMWATER PROFILES SHEET 06

MORTONS urbansolutions
Urban & Regional Planning
Civil Engineering
Project Coordination
MUS Pty Ltd T/As: Mortons-Urban Solutions
ABN: 39 116 375 065
Postal Address PO Box 2484 Southport QLD 4215
mortons@urbansolutions.net.au
www.urbansolutions.net.au
Tel 07 5571 1099
Gold Coast Office Suite 9, 19 Short St Southport QLD 4215

DESIGNED RB | DRAWN EP
APPROVED [signature] RPEQ 4706 | DATE 13-10-23

DRAWING NUMBER 41901-02-625 | REV A

F:\Autocad Client\419 - HB Land\01 - Courtney Drive\Precinct-Stage 02\Engineering Drawings\Current\41901-02-620.dwg, SHEET 06, 21/06/2024 1:27:52 PM, 1:2


STRUCTURE NAME

STRUCTURE DESCRIPTION



NOTES

1. WHERE STRUCTURE DEPTHS ARE 0m TO 3m REFER TO IPWEA STANDARD DRAWINGS FOR STRUCTURE DETAILS. WHERE STRUCTURE DEPTHS ARE 3m TO 5m REFER TO TMR STANDARD DRAWINGS FOR STRUCTURE DETAILS. WHERE STRUCTURE DEPTHS EXCEED 5m STRUCTURES ARE NON-STANDARD AND STRUCTURAL DESIGN IS REQUIRED.
2. STRUCTURAL DESIGN IS NOT PROVIDED AS PART OF THE TENDER DOCUMENTS, THE CONTRACTOR SHALL INCLUDE IN THEIR PRICE THE STRUCTURAL DESIGN AND CERTIFICATION OF THESE STRUCTURES.

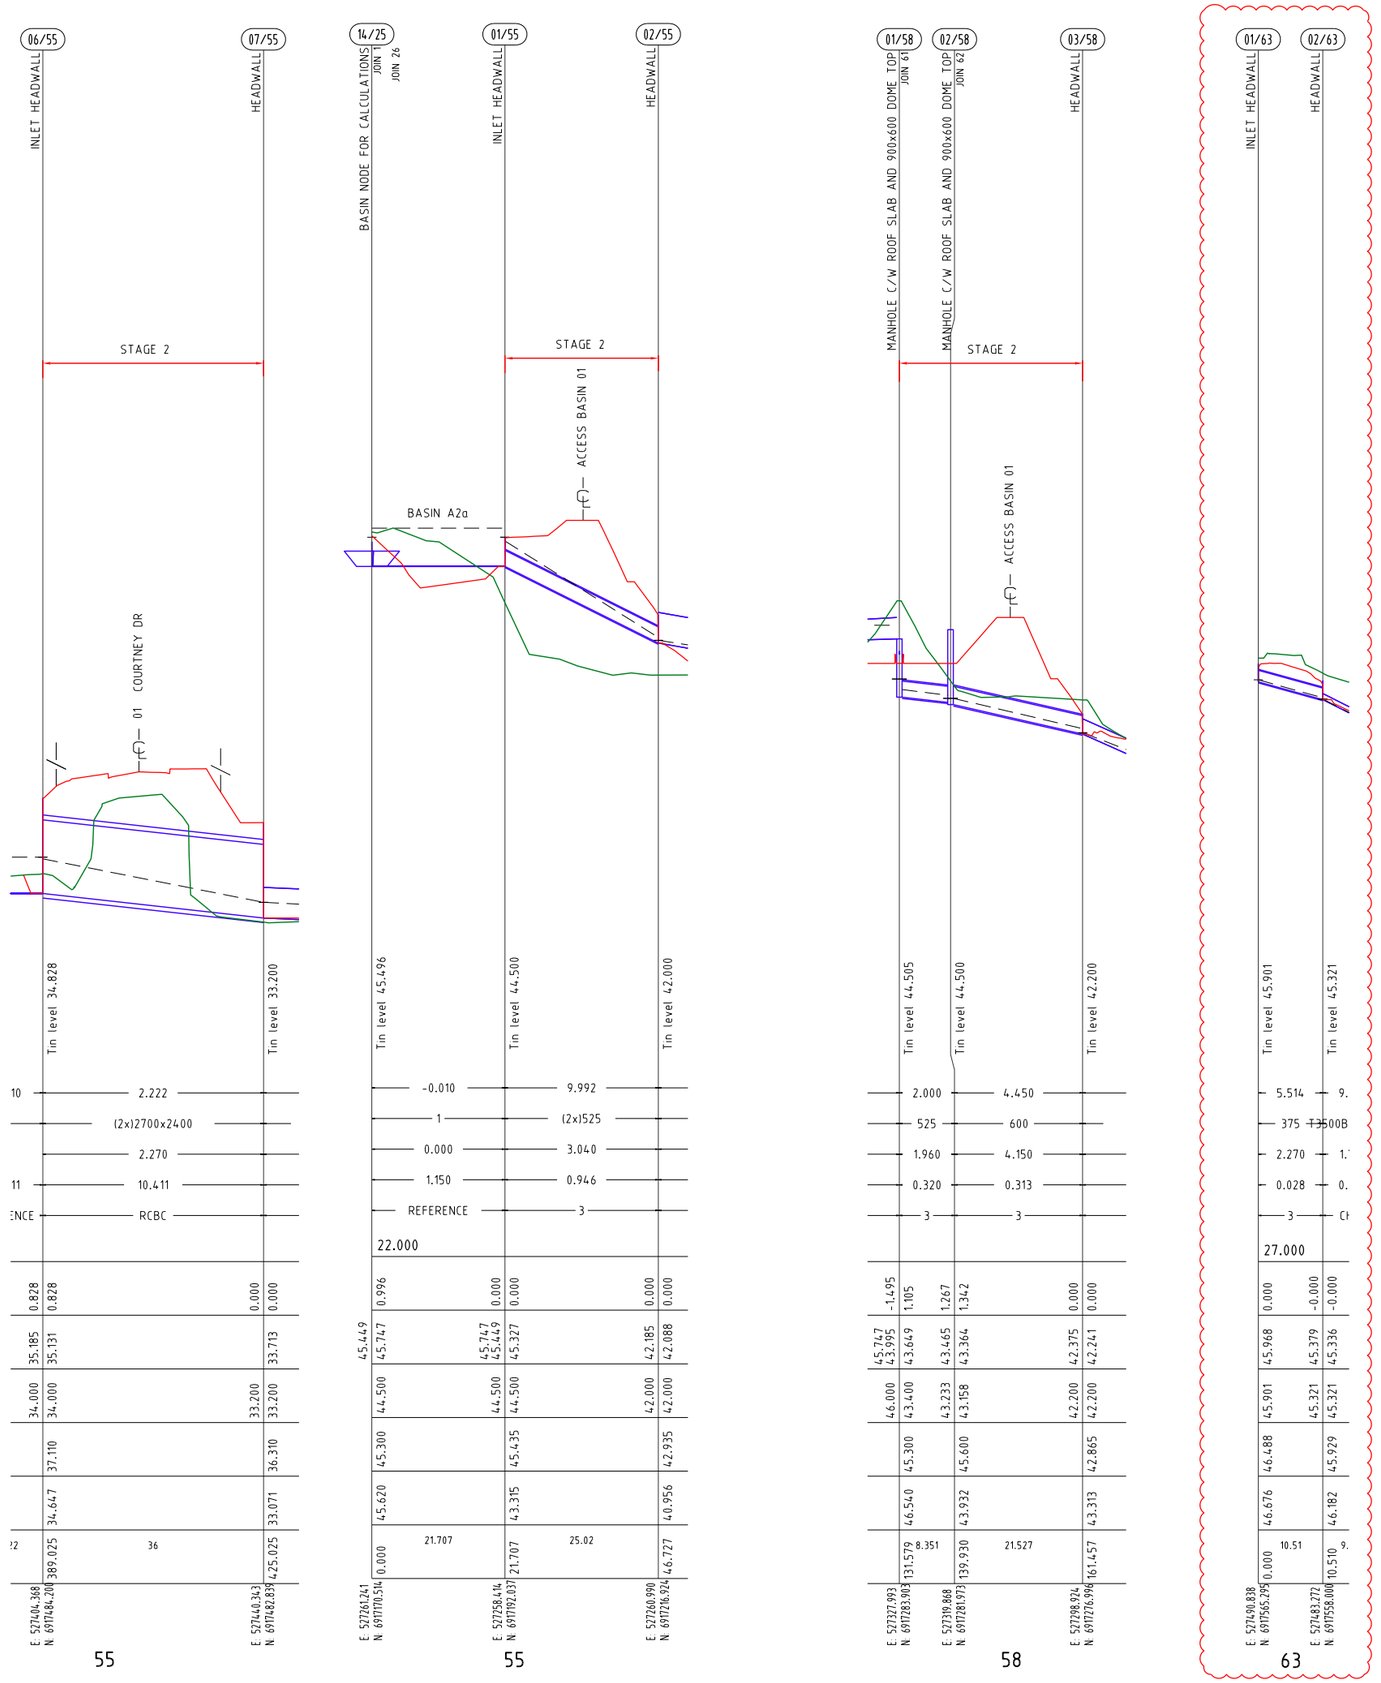

	06/55	07/55	14/25	01/55	02/55	01/58	02/58	03/58	01/63	02/63
PIPE GRADE (%)	10	2.222	-0.010	9.992	2.000	4.450	5.514	9.
PIPE DIAMETER (mm)		(2x)2700x2400	1	(2x)525	525	600	375	T3500B
VELOCITY (m/s)		2.270	0.000	3.040	1.960	4.150	2.270	1.
PIPE FLOW (m3/s)	11	10.411	1.150	0.946	0.320	0.313	0.028	0.
PIPE CLASS	ENCE	RCBC	REFERENCE	3	3	3	3	CH
DATUM R.L.			22.000				27.000	
DEPTH TO INVERT	0.828	0.828 / 0.000	0.996	0.000 / 0.000	0.000 / 0.000	-1.495 / 1.105	1.267 / 1.342	0.000 / 0.000	0.000	-0.000 / -0.000
HYDRAULIC GRADE LINE	35.185	35.131 / 33.713	45.747	45.747 / 45.449	45.327 / 42.185	43.995 / 43.649	43.465 / 43.364	42.375 / 42.241	45.968	45.379 / 45.336
PIPE INVERT LEVELS	34.000	34.000 / 33.200	44.500	44.500 / 44.500	42.000 / 42.000	46.000 / 43.400	43.233 / 43.158	42.200 / 42.200	45.901	45.321 / 45.321
DESIGN SURFACE LEVELS		37.110 / 36.310	45.300	45.435	42.935	45.300	45.600	42.865	46.488	45.929
EXISTING SURFACE LEVELS		34.647 / 33.071	45.620	43.315	40.956	46.540	43.932	43.313	46.676	46.182
CHAINAGE	22	36	0.000 / 21.707	21.707 / 25.02	46.727	131.579 / 8.351	139.930	21.527 / 161.457	0.000 / 10.51	10.510 / 9.
	E 527404.368 N 6917484.201	E 527440.343 N 6917482.833	E 527261.241 N 6917170.514	E 527258.414 N 6917192.037	E 527260.990 N 6917216.924	E 527327.993 N 6917283.903	E 527319.868 N 6917281.973	E 527298.924 N 6917276.994	E 527490.838 N 6917565.295	E 527483.272 N 6917558.004
	55		55			58			63	

DRAINAGE LINE

D

PLANS AND DOCUMENTS referred to in the DEVELOPMENT APPROVAL

Application No: MIN/2024/337

Dated: 16 July 2024

Development shall comply with the conditions of approval as detailed in the Decision Notice and Council's Planning Scheme, Local Laws and Planning Policies

PROJECT NAME

COURTNEY DR UPPER COOMERA

STAGE 02

RP DESCRIPTION

LOT 188, 189, 190, 191 & 192 ON RP173728
COURTNEY DRIVE
LOCALITY OF UPPER COOMERA
CAL AUTHORITY - GOLD COAST CITY COUNCIL

CLIENT

HB Land

0 5 10 15 20 25m
Horiz. Scale 1:500 - A1 (1:1000 - A3)

0 1 2 3 4 5m
Vert. Scale 1:100 - A1 (1:200 - A3)

REV	DATE	DESCRIPTION	INT
D	18-06-24	LINE 63 AMENDED	RK
C	15-01-24	LONG SECTIONS AMENDED, LINE 63 ADDED	BL
B	29-11-23	LONG SECTIONS UPDATED	BL
A	13-10-23	COUNCIL ISSUE	EP

COPYRIGHT IS VESTED IN MORTONS-URBAN SOLUTIONS AND WRITTEN CONSENT IS REQUIRED PRIOR TO REPRODUCTION. DO NOT SCALE FROM THIS DRAWING.

ASSOCIATED CONSULTANTS

BIOME WATER AND ENVIRONMENTAL CONSULTING
Robin Russell & ASSOCIATES PTY. LTD.
BENNETT+BENNETT

DRAWING TITLE

STORMWATER PROFILES SHEET 07

MORTONS urbansolutions
Urban & Regional Planning
Civil Engineering
Project Coordination

MUS Pty Ltd T/As:
Mortons-Urban Solutions
ABN: 39 116 375 065
mortons@urbansolutions.net.au
www.urbansolutions.net.au
Tel 07 5571 1099

Postal Address
PO Box 2484
Southport QLD 4215


Gold Coast Office
Suite 9, 19 Short St
Southport QLD 4215

DESIGNED	RB	DRAWN	EP
APPROVED	RPEQ 4706	DATE	13-10-23

DRAWING NUMBER: 41901-02-626

REV: C

F:\Autocad Client\419 - HB Land\01 - Courtney Drive\Precinct-Stage 02\Engineering Drawings\Current\41901-02-626.dwg, SHEET 07, 21/06/2024 1:27:54 PM, 1:2

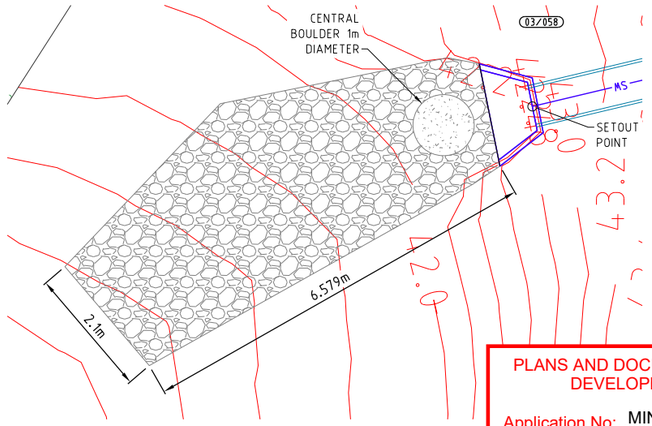

SCOUR PROTECTION DESIGN	
HW 03/058	SIZE 600mm
VELOCITY = 4.15m/s	
LENGTH = 6.579m	d50 300mm
SCOUR PROTECTION TYPE = RENO MATTRESS 300mm THICK	


CALCULATIONS UNDERTAKEN USING PROPRIETARY PRODUCT DATA

PLANS AND DOCUMENTS referred to in the DEVELOPMENT APPROVAL

Application No: MIN/2024/337

Dated: 16 July 2024


Development shall comply with the conditions of approval as detailed in the Decision Notice and Council's Planning Scheme, Local Laws and Planning Policies

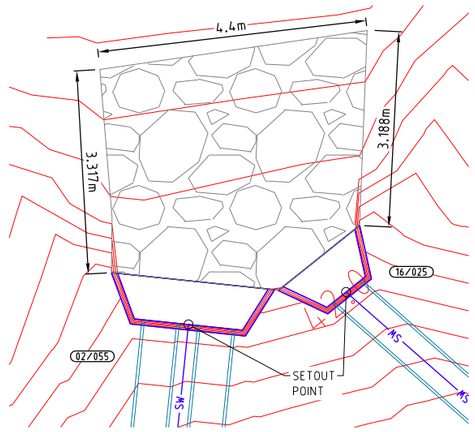


SCOUR PROTECTION DESIGN	
HW 02/055	SIZE 525mm
VELOCITY = 3.04m/s	
LENGTH = 3.317m	d50 300mm
SCOUR PROTECTION TYPE = RENO MATTRESS 170mm THICK	

SCOUR PROTECTION DESIGN	
HW 16/025	SIZE 600mm
VELOCITY = 2.73m/s	
LENGTH = 3.188m	d50 300mm
SCOUR PROTECTION TYPE = RENO MATTRESS 170mm THICK	


CALCULATIONS UNDERTAKEN USING PROPRIETARY PRODUCT DATA

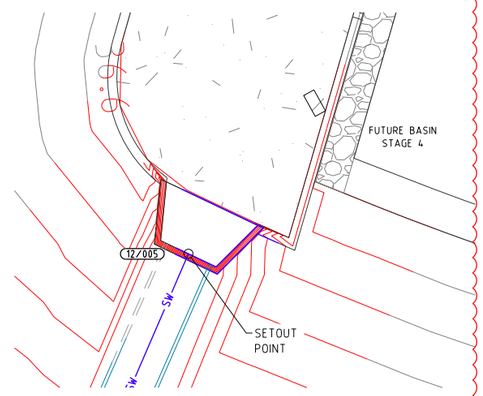

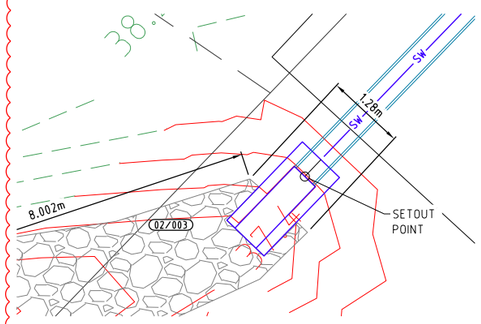


SCOUR PROTECTION DESIGN	
HW 02/003	SIZE 375mm
VELOCITY = 1.32m/s	
LENGTH = 8.002m	d50 150mm
SCOUR PROTECTION 270mm THICK OF LOOSE ROCK ON GEOFABRIC	

CALCULATIONS UNDERTAKEN USING PROPRIETARY PRODUCT DATA

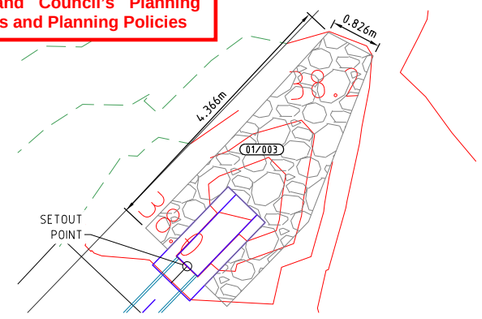


SCOUR PROTECTION DESIGN	
HW 01/003	SIZE 375mm
VELOCITY = 1.32m/s	
LENGTH = 4.366m	d50 150mm
SCOUR PROTECTION 270mm THICK OF LOOSE ROCK ON GEOFABRIC	

CALCULATIONS UNDERTAKEN USING PROPRIETARY PRODUCT DATA

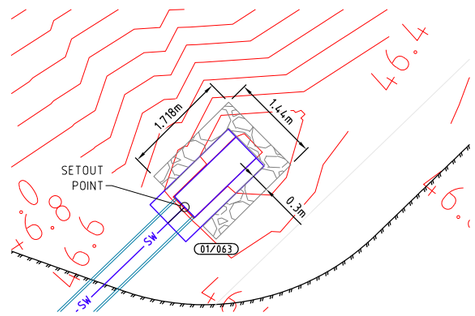

SCOUR PROTECTION DESIGN	
HW 01/063	SIZE 375mm
VELOCITY = 2.27m/s	
LENGTH = 1.718m	d50 150mm
SCOUR PROTECTION 270mm THICK OF LOOSE ROCK ON GEOFABRIC	


CALCULATIONS UNDERTAKEN USING PROPRIETARY PRODUCT DATA

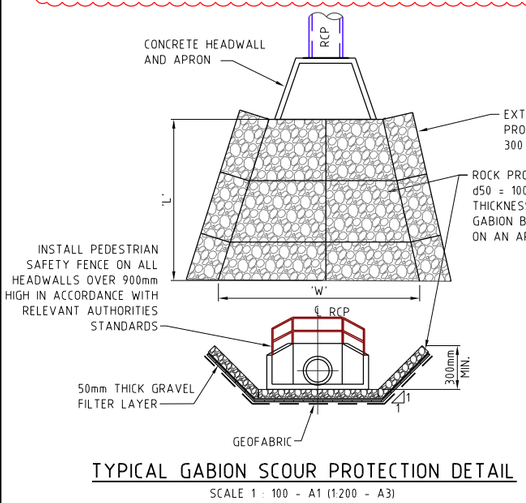

TYPICAL GABION SCOUR PROTECTION DETAIL

SCALE 1 : 100 - A1 (1:200 - A3)


C

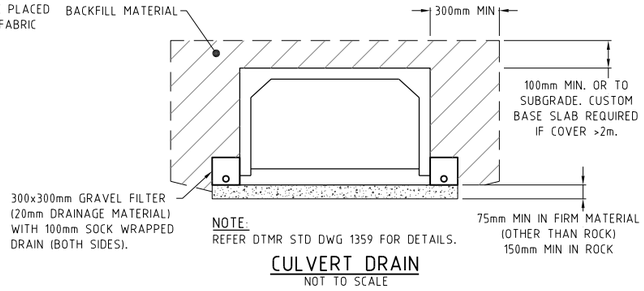

NOTE:
REFER DTMR STD DWG 1359 FOR DETAILS.

CULVERT DRAIN

NOT TO SCALE

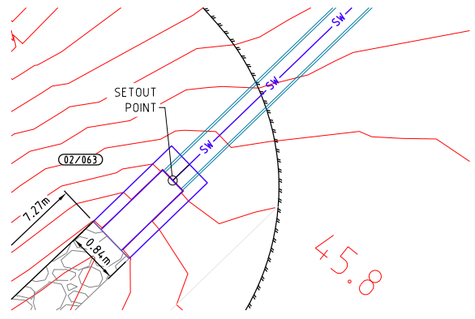

SCOUR PROTECTION DESIGN	
HW 02/063	SIZE 375mm
VELOCITY = 2.27m/s	
LENGTH = 7.27m	d50 150mm
SCOUR PROTECTION 270mm THICK OF LOOSE ROCK ON GEOFABRIC	

CALCULATIONS UNDERTAKEN USING PROPRIETARY PRODUCT DATA

PROJECT NAME

COURTNEY DR UPPER COOMERA

STAGE 02

RP DESCRIPTION

LOT 188, 189, 190, 191 & 192 ON RP173728
COURTNEY DRIVE
LOCALITY OF UPPER COOMERA
LOCAL AUTHORITY - GOLD COAST CITY COUNCIL

CLIENT

HB Land

NORTH

0 0.5 1.0 1.5 2.0 2.5m
Scale 1:50 - A1 (1:100 - A3)

0 1 2 3 4 5m
Scale 1:100 - A1 (1:200 - A3)

REV	DATE	DESCRIPTION	INT
C	19-06-24	PIPES AND TABLES UPDATED	RK
B	29-11-23	PIPE COORDINATES AMENDED, HW'S ADDED	BL
A	13-10-23	COUNCIL ISSUE	EP

COPYRIGHT IS VESTED IN MORTONS-URBAN SOLUTIONS AND WRITTEN CONSENT IS REQUIRED PRIOR TO REPRODUCTION. DO NOT SCALE FROM THIS DRAWING.

ASSOCIATED CONSULTANTS

BIOME WATER AND ENVIRONMENTAL CONSULTING

Robin Russell & ASSOCIATES PTY. LTD.

BENNETT+BENNETT

DRAWING TITLE

STORMWATER OUTLETS AND TYPICAL DETAILS SHEET 01

MORTONS urbansolutions
Urban & Regional Planning
Civil Engineering
Project Coordination

MUS Pty Ltd T/As:
Mortons-Urban Solutions
ABN: 39 116 375 065
mortons@urbansolutions.net.au
www.urbansolutions.net.au
Tel 07 5571 1099

Postal Address
PO Box 2484
Southport QLD 4215

Gold Coast Office
Suite 9, 19 Short St
Southport QLD 4215

DESIGNED RB	DRAWN EP	
APPROVED	RPEQ 4706	DATE 13-10-23

DRAWING NUMBER 41901-02-640

REV C

F:\Autocad Client\419 - HB Land\01 - Courtney Drive\Precinct-Stage 02\Engineering Drawings\Current\41901-02-640.dwg, OUTLETS & TYPICAL DETAILS SHEET 01, 21/06/2024 1:29:48 PM, 1:2


PLANS AND DOCUMENTS referred to in the DEVELOPMENT APPROVAL

Application No: MIN/2024/337

Dated: 16 July 2024

Development shall comply with the conditions of approval as detailed in the Decision Notice and Council's Planning Scheme, Local Laws and Planning Policies

NOTE
RCBC TO BE INSTALLED IN ACCORDANCE WITH DTMR REQUIREMENTS. HEADWALLS ARE NON STANDARD, CONTRACTOR TO ARRANGE STRUCTURAL DESIGN, CERTIFICATION & FINAL CONSTRUCTION.

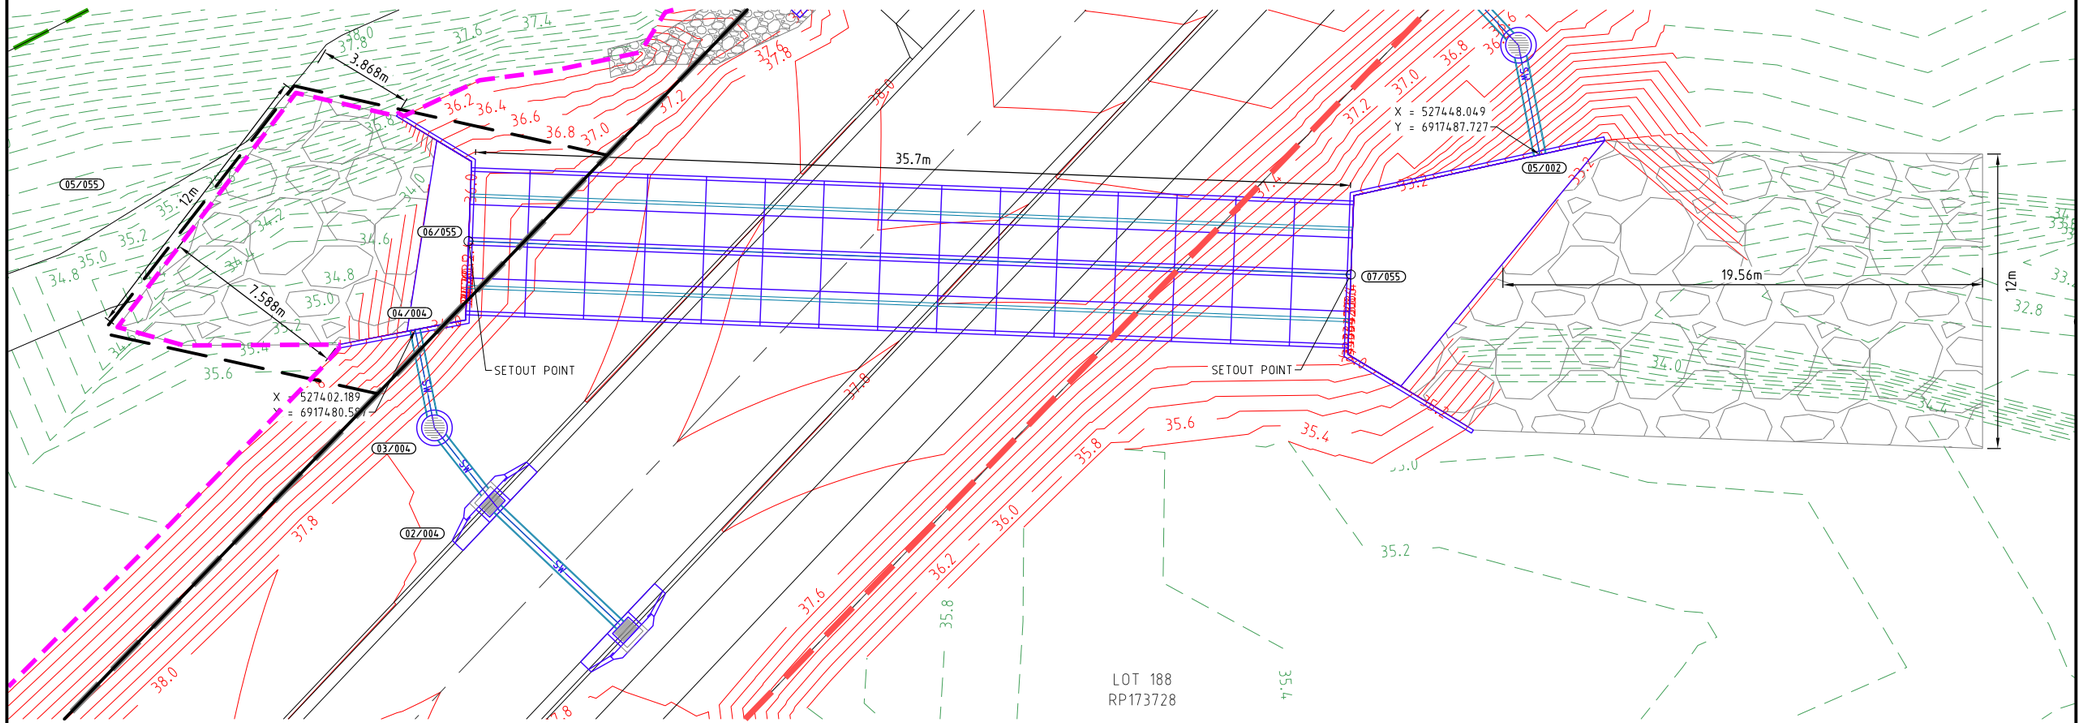

SCOUR PROTECTION DESIGN	
HW 06/055	SIZE 2.7m x 2.4m RCBC (x2)
VELOCITY = 2.27m/s	
LENGTH = 12m x 4m	d50 = 500mm
SCOUR PROTECTION TYPE = LOOSE ROCK 500mm THICK	

CALCULATIONS UNDERTAKEN USING PROPRIETARY PRODUCT DATA

SCOUR PROTECTION DESIGN	
HW 07/055	SIZE 2.7m x 2.4m RCBC (x2)
VELOCITY = 2.27m/s	
LENGTH = 18m x 12m	d50 = 500mm
SCOUR PROTECTION TYPE = LOOSE ROCK 900mm THICK	

CALCULATIONS UNDERTAKEN USING PROPRIETARY PRODUCT DATA

PROJECT NAME

COURTNEY DR UPPER COOMERA

STAGE 02

RP DESCRIPTION

LOT 188, 189, 190, 191 & 192 ON RP173728
COURTNEY DRIVE
LOCALITY OF UPPER COOMERA
LOCAL AUTHORITY - GOLD COAST CITY COUNCIL

CLIENT

HB Land

NORTH

0 1.25 1.5 3.75 5 6.25m

Scale 1:125 - A1 (1:250 - A3)

REV	DATE	DESCRIPTION	INT
B	15-01-24	STORMWATER CULVERT AMENDED	BL
A	13-10-23	COUNCIL ISSUE	EP

COPYRIGHT IS VESTED IN MORTONS-URBAN SOLUTIONS AND WRITTEN CONSENT IS REQUIRED PRIOR TO REPRODUCTION. DO NOT SCALE FROM THIS DRAWING.

ASSOCIATED CONSULTANTS

BIOME WATER AND ENVIRONMENTAL CONSULTING

Robin Russell & ASSOCIATES PTY. LTD.

BENNETT + BENNETT

DRAWING TITLE

STORMWATER
RCBC
OUTLET
SHEET 01

MORTONS urbansolutions
Urban & Regional Planning
Civil Engineering
Project Coordination

MUS Pty Ltd T/As:
Mortons-Urban Solutions
ABN: 39 116 375 065
mortons@urbansolutions.net.au
www.urbansolutions.net.au
Tel 07 5571 1099

Postal Address
PO Box 2484
Southport QLD 4215

Gold Coast Office
Suite 9, 19 Short St
Southport QLD 4215

DESIGNED	RB	DRAWN	EP
APPROVED		RPEQ 4706	DATE 13-10-23

DRAWING NUMBER 41901-02-641 REV B


F:\Autocad Client\419 - HB Land\01 - Courtney Drive\Precinct-Stage 02\Engineering Drawings\Current\41901-02-641.dwg, RCBC OUTLET, 21/06/2024 1:30:28 PM, 1:2

PLANS AND DOCUMENTS referred to in the DEVELOPMENT APPROVAL

Application No: MIN/2024/337

Dated: 16 July 2024

Development shall comply with the conditions of approval as detailed in the Decision Notice and Council's Planning Scheme, Local Laws and Planning Policies

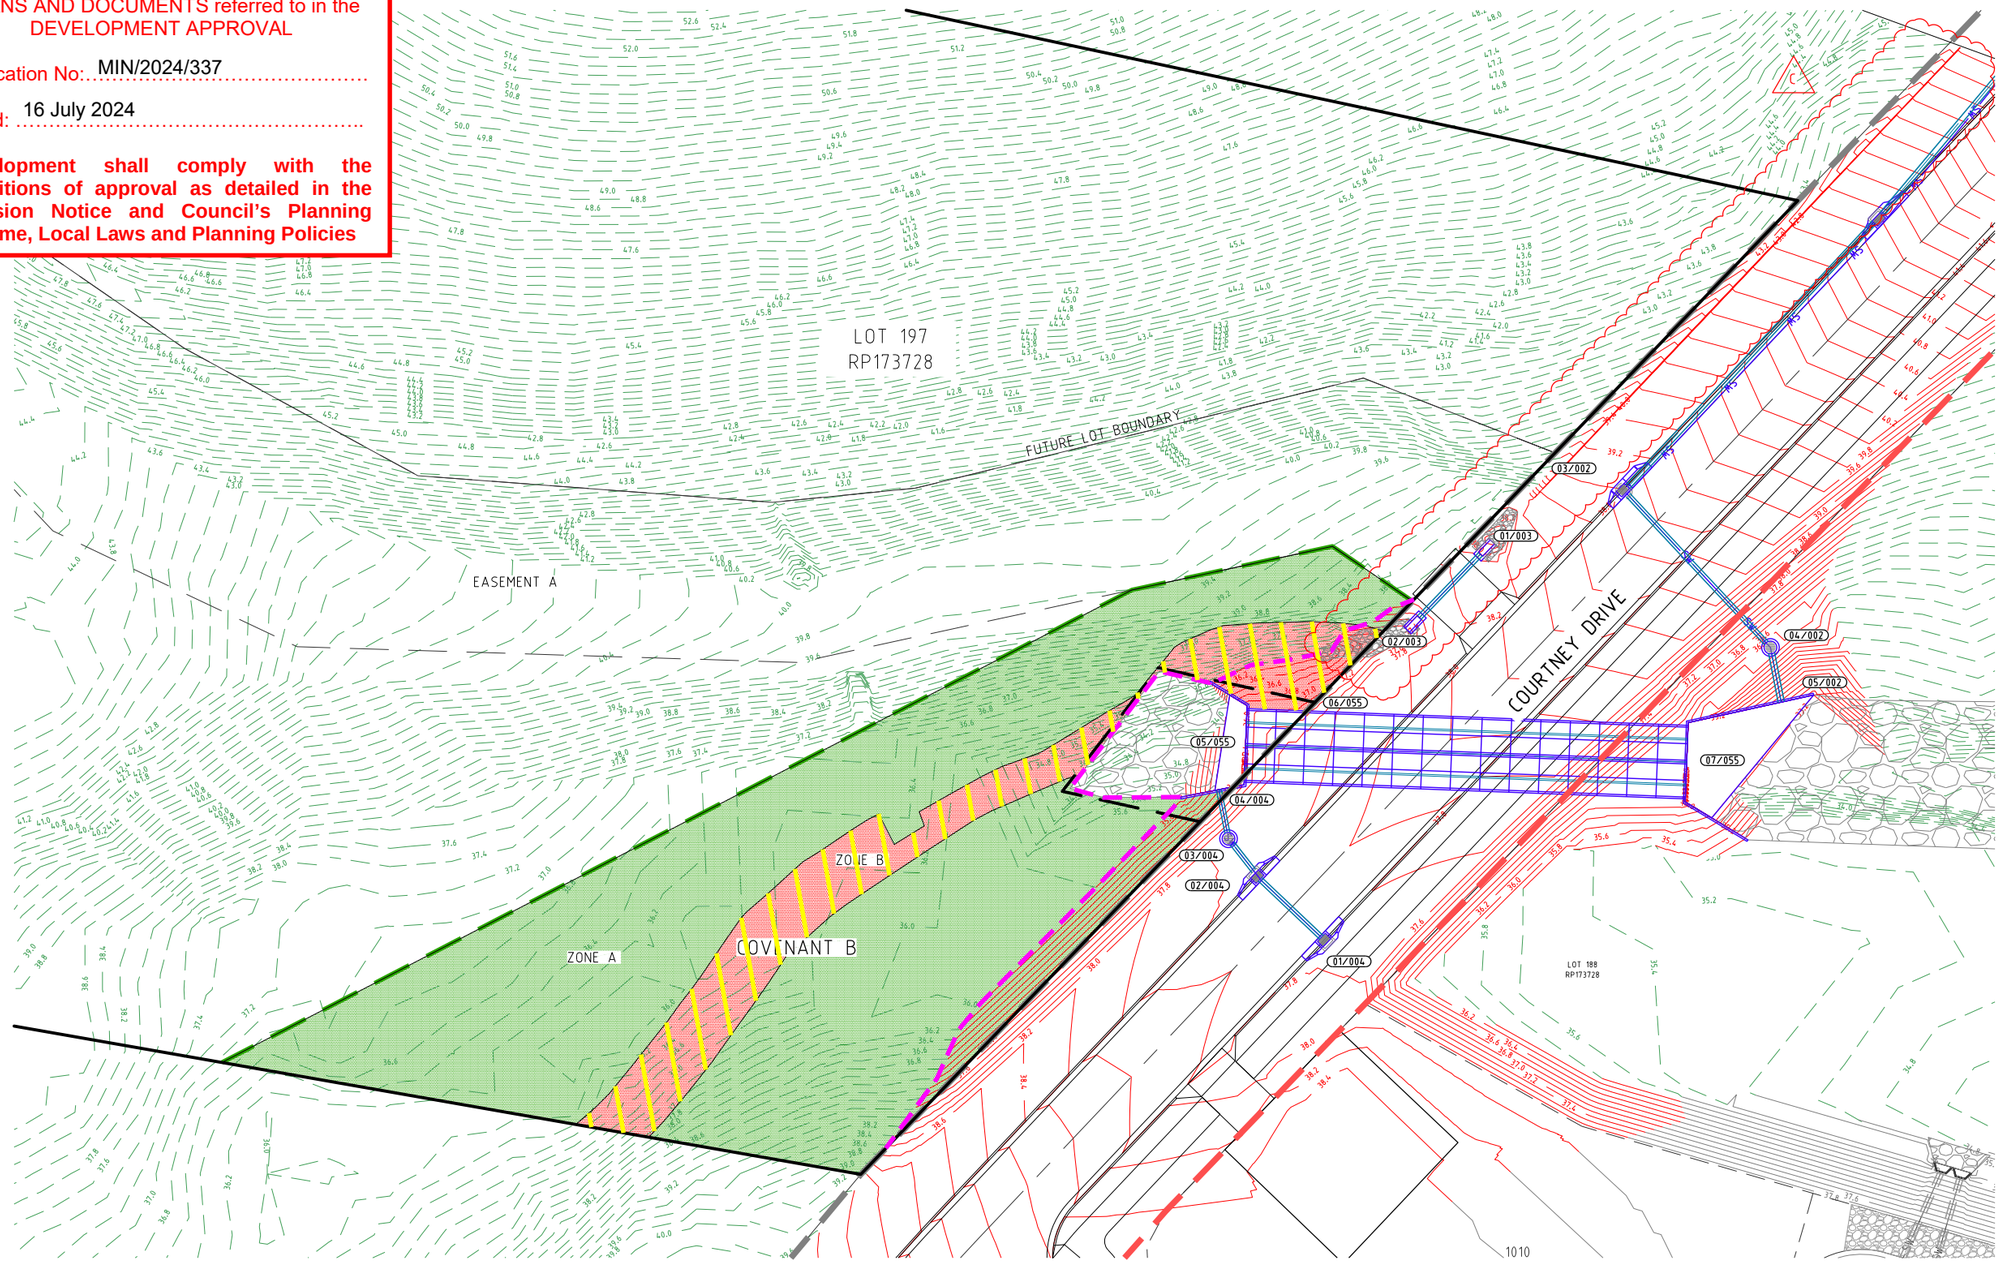

LEGEND

- EXISTING KERB (INVERT)
- EXISTING KERB (LIP & BACK)
- EXISTING PROPERTY LINE
- EXISTING CONTOURS (1.0)
- FUTURE KERB
- FUTURE PROPERTY LINE
- SITE BOUNDARY
- STAGE BOUNDARY
- CONTROL LINE / CENTER OF ROAD
- PROPOSED KERB (INVERT)
- PROPOSED KERB (LIP & BACK)
- PROPOSED PROPERTY LINE
- DESIGN CONTOURS (1.0)
- PROPOSED STORMWATER (SW)
- PROPOSED ROOFWATER (RW)
- PROPOSED SUBSOIL (SS)
- LOT 197 BOUNDARY
- COVENANT BOUNDARY
- MANHOLE
- FIELD INLET
- KERB INLET (ON GRADE) PIT
- KERB INLET (SAG) PIT
- HEADWALL
- SCOUR PROTECTION
- ZONE A - REHABILITATION AND REVEGETATION IN ACCORDANCE WITH THE APPROVED COVENANT AND MANAGEMENT AND REHABILITATION PLAN PREPARED BY WOLTER CONSULTING GROUP (EMP/2019/40)
- ZONE B - REHABILITATION AND REVEGETATION IN ACCORDANCE WITH THE APPROVED COVENANT AND MANAGEMENT AND REHABILITATION PLAN PREPARED BY WOLTER CONSULTING GROUP (EMP/2019/40) REQUIRING JUTE MATTING INSTALLATION
- PROPOSED DRAINAGE EASEMENT IN FAVOUR OF CITY OF GOLD COAST
- EXTENT OF WORKS BY HB QLD Pty Ltd

NOTES:

HB QLD Pty Ltd WORKS TO INCLUDE:

-EARTHWORKS;
-INSTALLATION OF STORMWATER BOX CULVERTS AND HEADWALL;
-PLACEMENT OF ROCK SCOUR ON GEOFABRIC;
-STABILISATION OF DISTURBED AREAS INCLUDING JUTE MATTING (IF REQUIRED);
-REHABILITATION AND REVEGETATION WITHIN ZONE A AND B AS PER APPROVED COVENANT MANAGEMENT AND REHABILITATION PLAN BY WOLTER CONSULTING GROUP (EMP/2019/40)

PROJECT NAME

COURTNEY DR UPPER COOMERA

STAGE 02

RP DESCRIPTION

LOT 188, 189, 190, 191 & 192 ON RP173728
COURTNEY DRIVE
LOCALITY OF UPPER COOMERA
LOCAL AUTHORITY - GOLD COAST CITY COUNCIL

CLIENT

HB Land

NORTH

0 2.5 5 7.5 10 12.5m

Scale 1:250 - A1 (1:500 - A3)

REV	DATE	DESCRIPTION	INT
C	14-06-24	STORMWATER & CONTOURS AMENDED	RK
B	15-01-24	STORMWATER CULVERT AMENDED	BL
A	23-02-24	COUNCIL ISSUE	BL

COPYRIGHT IS VESTED IN MORTONS-URBAN SOLUTIONS AND WRITTEN CONSENT IS REQUIRED PRIOR TO REPRODUCTION. DO NOT SCALE FROM THIS DRAWING.

ASSOCIATED CONSULTANTS

BIOME WATER AND ENVIRONMENTAL CONSULTING
Robin Russell & ASSOCIATES PTY. LTD.
BENNETT+BENNETT

DRAWING TITLE

POST CONSTRUCTION STABILISATION PLAN LOT 197 ON RP173728

MORTONS urbansolutions
Urban & Regional Planning
Civil Engineering
Project Coordination

MUS Pty Ltd T/As:
Mortons-Urban Solutions
ABN: 39 116 375 065

Postal Address
PO Box 2484
Southport QLD 4215

mortons@urbansolutions.net.au
www.urbansolutions.net.au
Tel 07 5571 1099

Gold Coast Office
Suite 9, 19 Short St
Southport QLD 4215

DESIGNED	RB	DRAWN	BL
APPROVED	RPEQ 4706	DATE	13-10-23

DRAWING NUMBER 41901-02-642

REV C


F:\Autocad Client\419 - HB Land\01 - Courtney Drive\Precinct-Stage 02\Engineering Drawings\Current\41901-02-641.dwg, STABILISATION PLAN, 21/06/2024 1:38:32 PM, 1:2


LEGEND


- EXISTING KERB (INVERT)
- EXISTING KERB (LIP & BACK)
- EXISTING FOOTPATH
- EXISTING PROPERTY LINE
- EXISTING STORMWATER
- EXISTING ROOFWATER
- EXISTING STORMWATER PIPES
- EXISTING ROOFWATER PIPES
- FUTURE KERB (INVERT)
- FUTURE KERB (LIP & BACK)
- FUTURE FOOTPATH
- FUTURE PROPERTY LINE
- FUTURE STORMWATER
- FUTURE ROOFWATER
- FUTURE STORMWATER PIPES
- FUTURE ROOFWATER PIPES
- CONTROL LINE / CENTER OF ROAD
- PROPOSED KERB (INVERT)
- PROPOSED KERB (LIP & BACK)
- PROPOSED FOOTPATH
- PROPOSED PROPERTY LINE
- PROPOSED STORMWATER
- PROPOSED ROOFWATER
- PROPOSED STORMWATER PIPES
- PROPOSED ROOFWATER PIPES
- MANHOLE
- FIELD INLET
- KERB INLET (ON GRADE) PIT
- KERB INLET (SAG) PIT
- HEADWALL
- SCOUR PROTECTION
- 10/001 DRAINAGE PIT & LINE NO.
- CONCRETE


NOTE


THE STORMWATER PIT IMAGE ARE DIAGRAMATIC ONLY & THE CONTRACTOR MUST ENSURE THEY MATCH NEATLY INTO THE WORKS

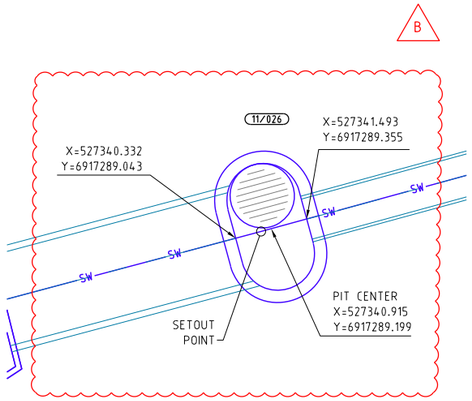


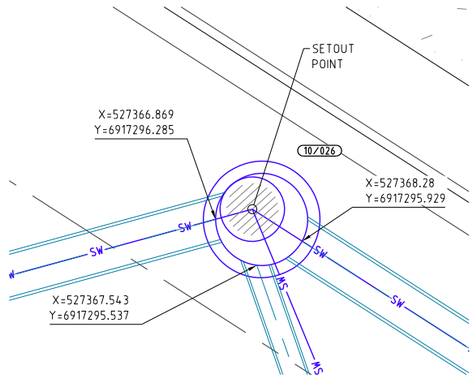


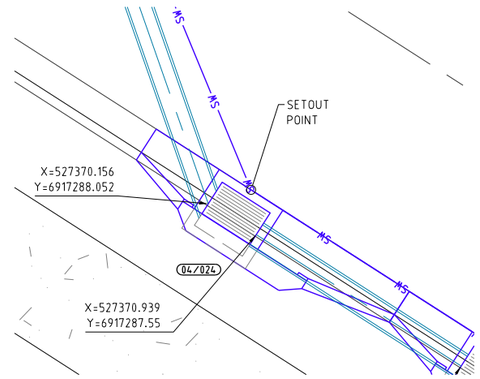


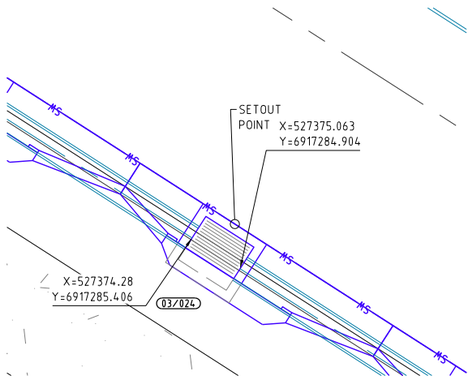


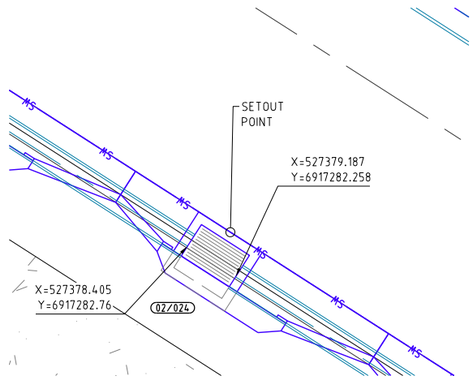


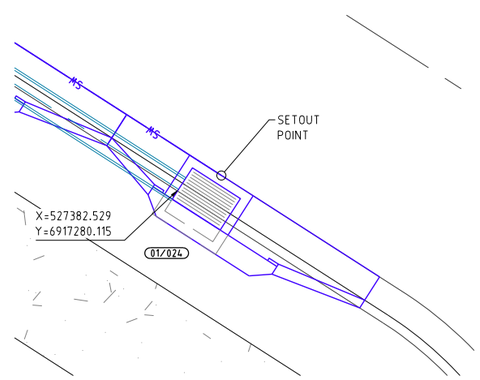


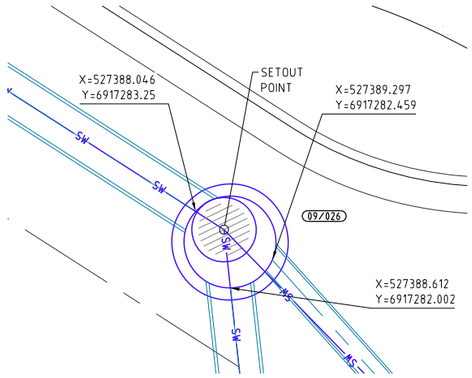


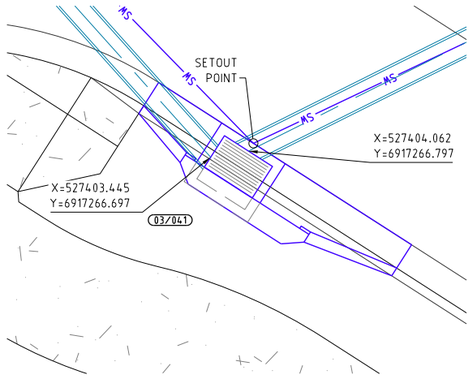


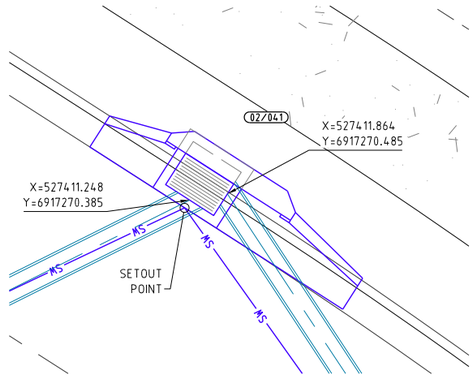


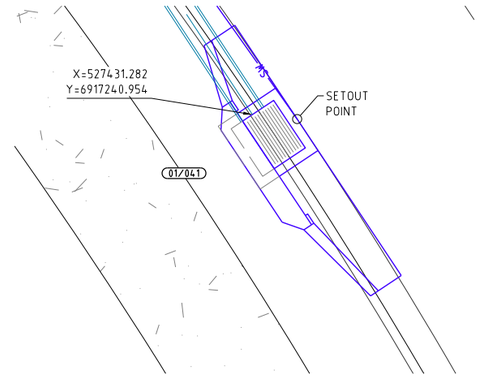

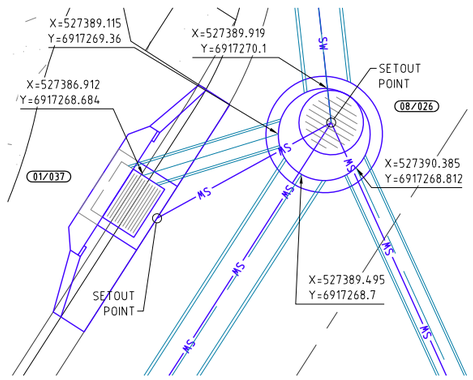

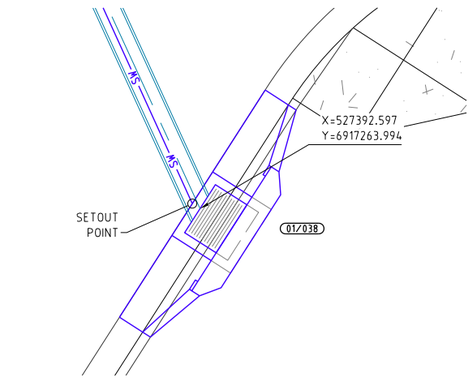

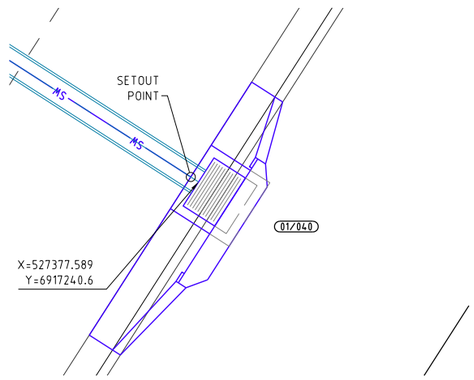

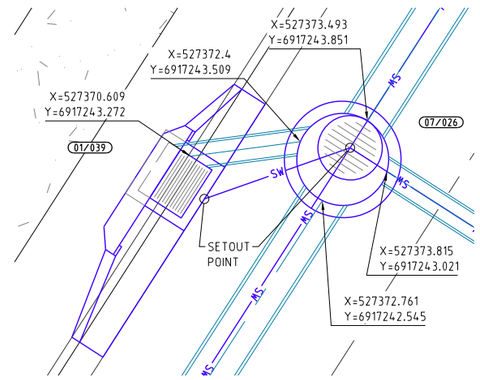

PROJECT NAME

COURTNEY DR UPPER COOMERA

STAGE 02

RP DESCRIPTION

LOT 188, 189, 190, 191 & 192 ON RP173728
COURTNEY DRIVE
LOCALITY OF UPPER COOMERA
LOCAL AUTHORITY - GOLD COAST CITY COUNCIL

CLIENT

HB Land

NORTH

0 0.5 1.0 1.5 2.0 2.5m
Scale 1:50 - A1 (1:100 - A3)

PLANS AND DOCUMENTS referred to in the DEVELOPMENT APPROVAL

Application No: MIN/2024/337

Dated: 16 July 2024

Development shall comply with the conditions of approval as detailed in the Decision Notice and Council's Planning Scheme, Local Laws and Planning Policies

REV	DATE	DESCRIPTION	INT
B	29-11-23	COORDINATES REVISED	BL
A	13-10-23	COUNCIL ISSUE	EP

COPYRIGHT IS VESTED IN MORTONS-URBAN SOLUTIONS AND WRITTEN CONSENT IS REQUIRED PRIOR TO REPRODUCTION.
DO NOT SCALE FROM THIS DRAWING.

ASSOCIATED CONSULTANTS

BIOME WATER AND ENVIRONMENTAL CONSULTING
Robin Russell & ASSOCIATES PTY. LTD.
BENNETT + BENNETT

DRAWING TITLE

STORMWATER
PIT DETAILS
SHEET 01

MORTONS urbansolutions
Urban & Regional Planning
Civil Engineering
Project Coordination

MUS Pty Ltd T/As:
Mortons-Urban Solutions
ABN: 39 116 375 065
mortons@urbansolutions.net.au
www.urbansolutions.net.au
Tel 07 5571 1099


Postal Address
PO Box 2484
Southport QLD 4215


Gold Coast Office
Suite 9, 19 Short St
Southport QLD 4215


DESIGNED	RB	DRAWN	EP
APPROVED		RPEQ 4706	DATE 13-10-23


DRAWING NUMBER: 41901-02-650
REV: B


F:\Autocad Client\419 - HB Land\01 - Courtney Drive\Precinct-Stage 02\Engineering Drawings\Current\41901-02-650.dwg, PIT DETAILS SHEET 01, 21/06/2024 1:28:58 PM, 1:2

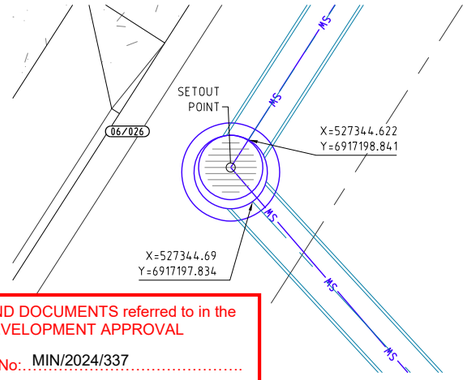


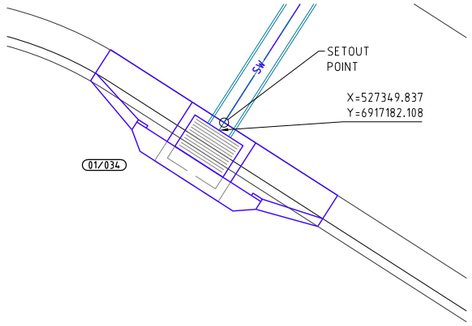


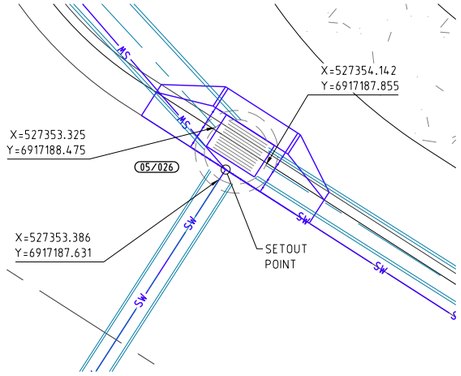


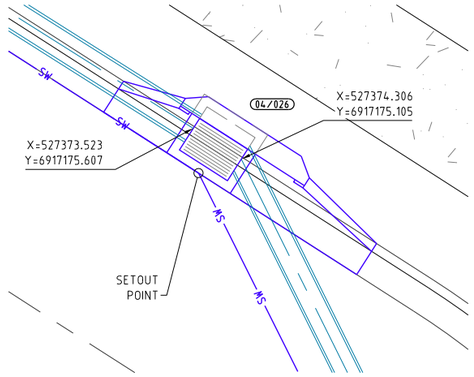


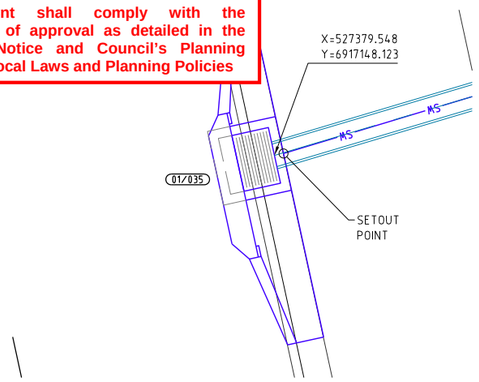


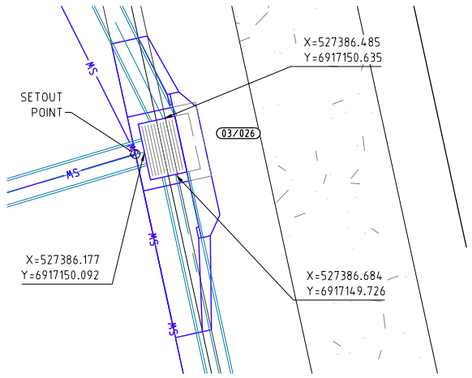


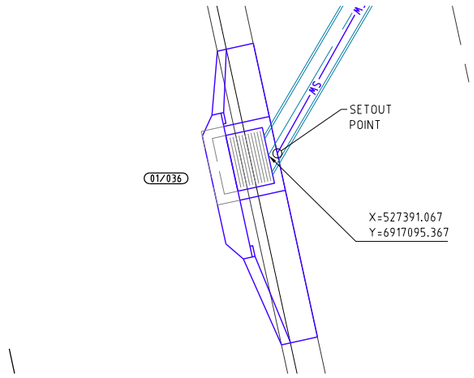


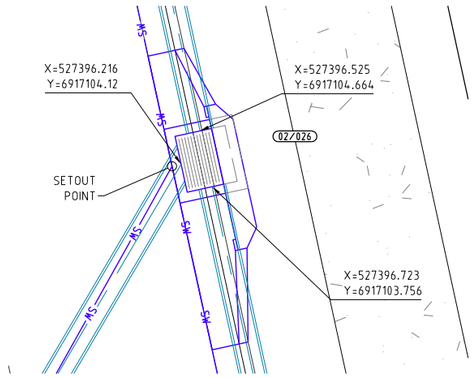


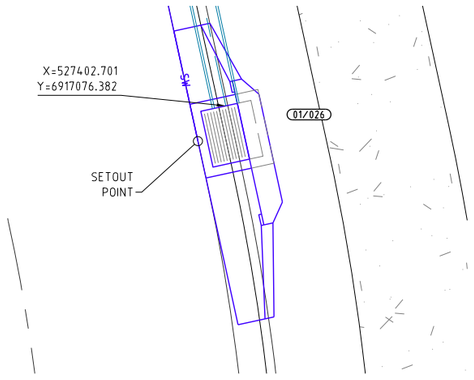


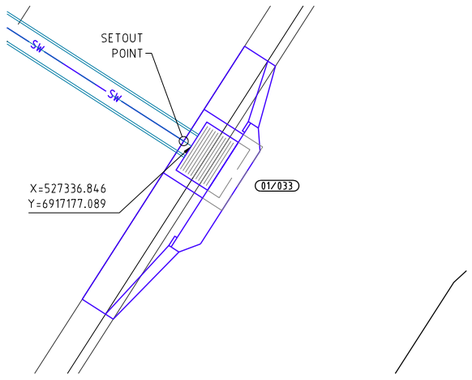


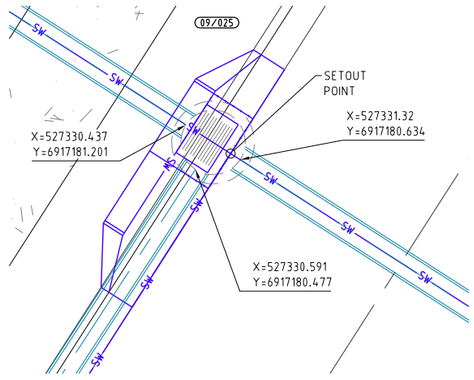


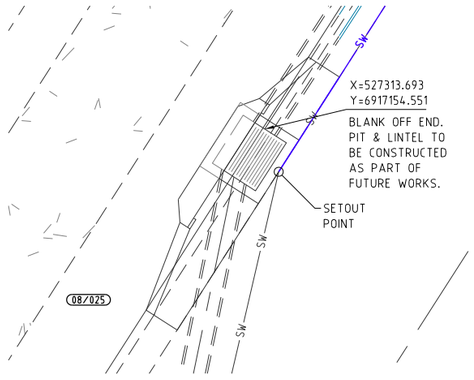

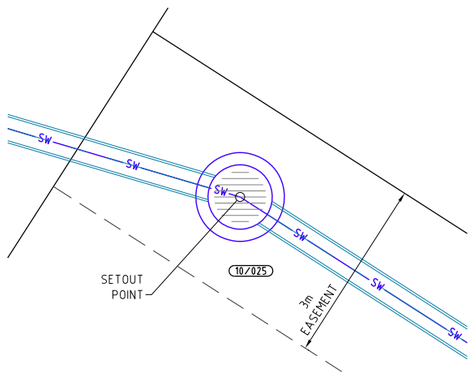

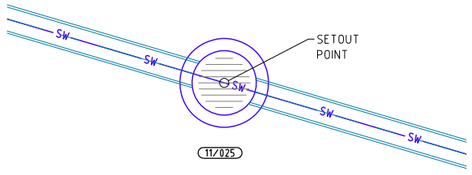

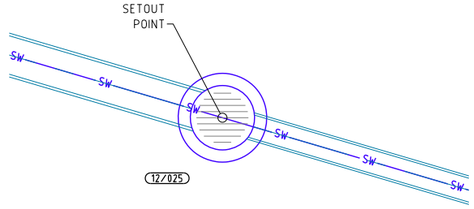

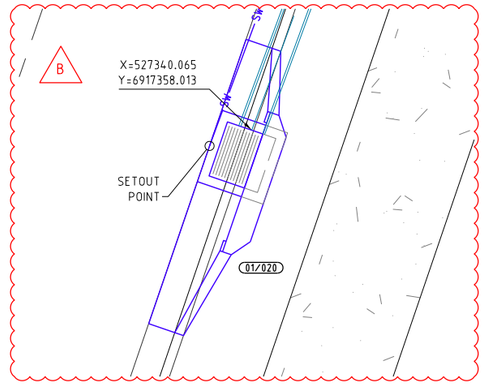

PLANS AND DOCUMENTS referred to in the DEVELOPMENT APPROVAL

Application No: MIN/2024/337

Dated: 16 July 2024

Development shall comply with the conditions of approval as detailed in the Decision Notice and Council's Planning Scheme, Local Laws and Planning Policies

PROJECT NAME

COURTNEY DR UPPER COOMERA

STAGE 02

RP DESCRIPTION

LOT 188, 189, 190, 191 & 192 ON RP173728
COURTNEY DRIVE
LOCALITY OF UPPER COOMERA
LOCAL AUTHORITY - GOLD COAST CITY COUNCIL

CLIENT

HB Land

NORTH

0 0.5 1.0 1.5 2.0 2.5m

Scale 1:50 - A1 (1:100 - A3)

REV	DATE	DESCRIPTION	INT
B	15-01-24	PIT DETAILS AMENDED	BL
A	13-10-23	COUNCIL ISSUE	EP

COPYRIGHT IS VESTED IN MORTONS-URBAN SOLUTIONS AND WRITTEN CONSENT IS REQUIRED PRIOR TO REPRODUCTION. DO NOT SCALE FROM THIS DRAWING.

ASSOCIATED CONSULTANTS

BIOME WATER AND ENVIRONMENTAL CONSULTING

Robin Russell & ASSOCIATES PTY. LTD.

BENNETT + BENNETT

DRAWING TITLE

STORMWATER
PIT DETAILS
SHEET 02

MORTONS urbansolutions
Urban & Regional Planning
Civil Engineering
Project Coordination

MUS Pty Ltd T/As
Mortons-Urban Solutions
ABN: 39 116 375 065
mortons@urbansolutions.net.au
www.urbansolutions.net.au
Tel 07 5571 1099


Postal Address
PO Box 2484
Southport QLD 4215


Gold Coast Office
Suite 9, 19 Short St
Southport QLD 4215


DESIGNED	RB	DRAWN	EP
APPROVED	RPEQ 4706	DATE	13-10-23


DRAWING NUMBER	REV
41901-02-651	B


F:\Autocad Client\419 - HB Land\01 - Courtney Drive\Precinct-Stage 02\Engineering Drawings\Current\41901-02-650.dwg, PIT DETAILS SHEET 02, 21/06/2024 1:31:20 PM, 1:2

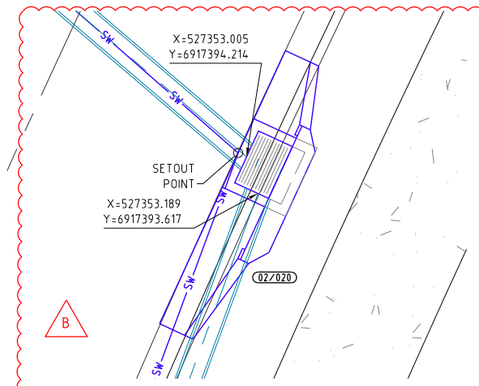


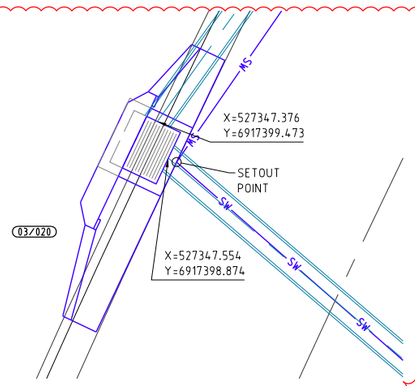


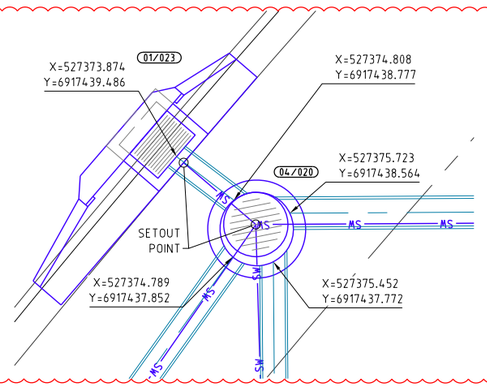


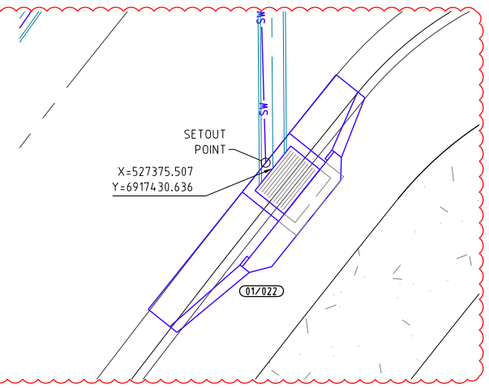


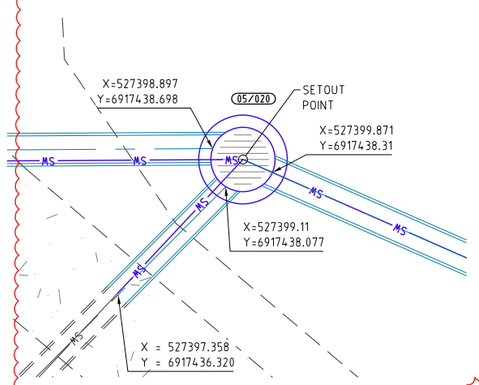


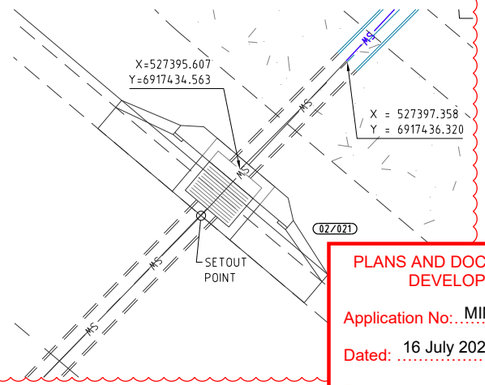


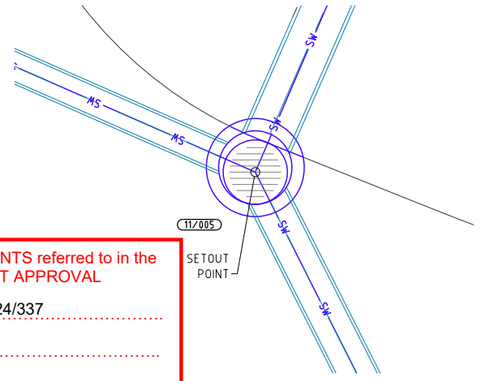


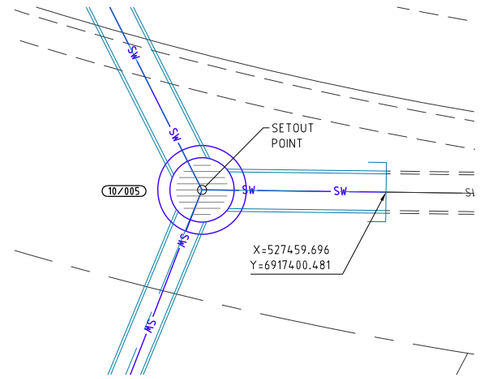


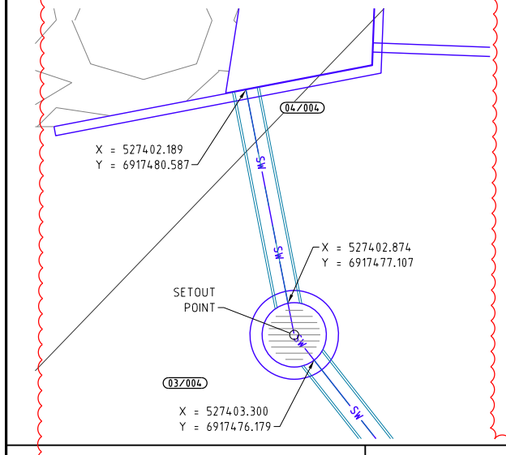


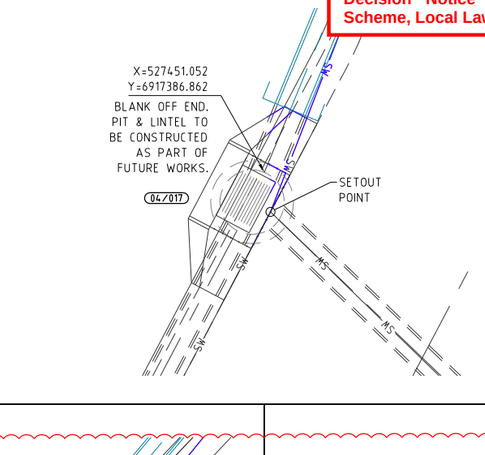


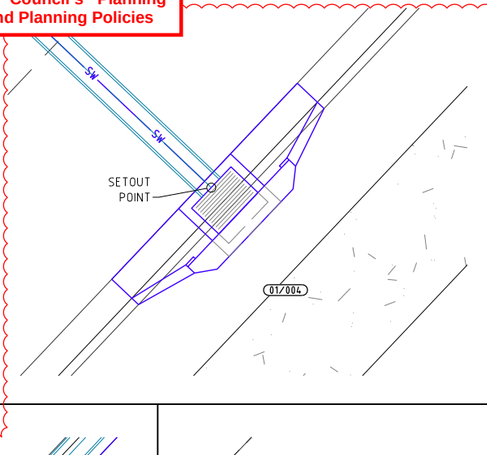


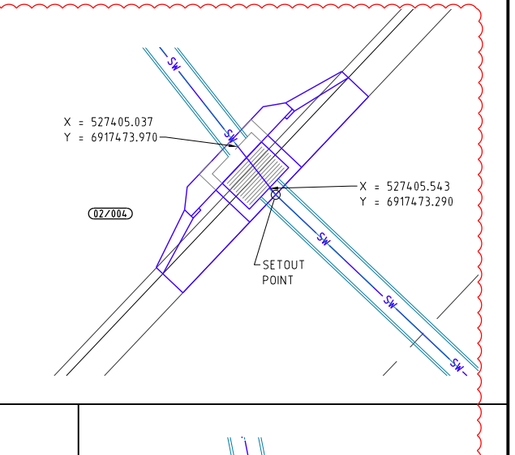


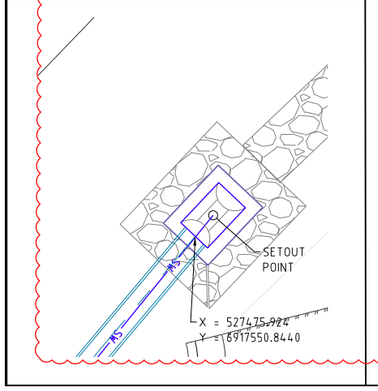

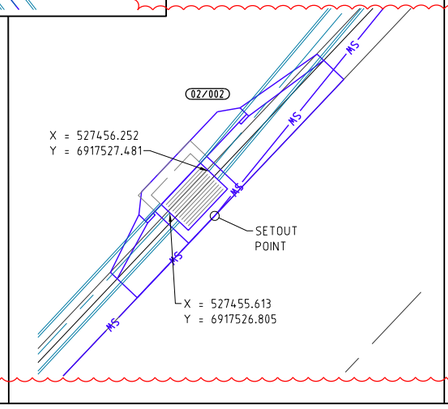

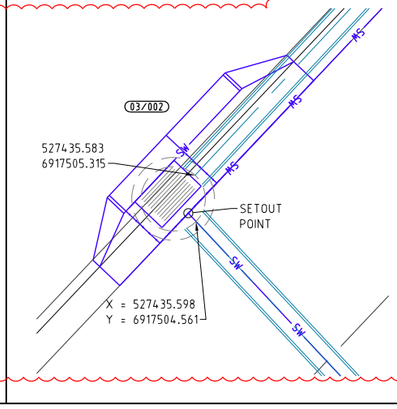

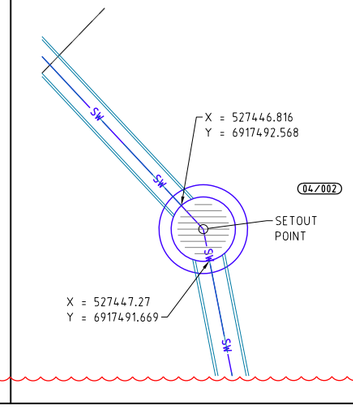

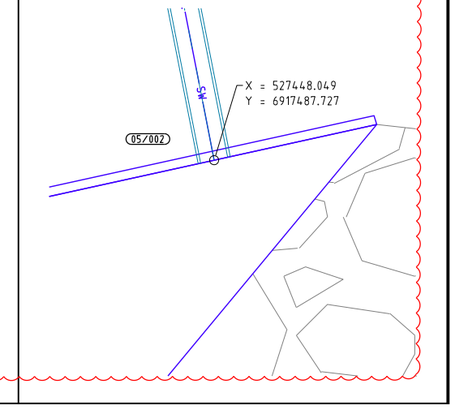

PLANS AND DOCUMENTS referred to in the DEVELOPMENT APPROVAL

Application No: MIN/2024/337

Dated: 16 July 2024

Development shall comply with the conditions of approval as detailed in the Decision Notice and Council's Planning Scheme, Local Laws and Planning Policies

PROJECT NAME

COURTNEY DR UPPER COOMERA

STAGE 02

RP DESCRIPTION

LOT 188, 189, 190, 191 & 192 ON RP173728
COURTNEY DRIVE
LOCALITY OF UPPER COOMERA
LOCAL AUTHORITY - GOLD COAST CITY COUNCIL

CLIENT

HB Land

NORTH

0 0.5 1.0 1.5 2.0 2.5m

Scale 1:50 - A1 (1:100 - A3)

REV	DATE	DESCRIPTION	INT
B	15-01-24	PIT DETAILS AMENDED	BL
A	13-10-23	COUNCIL ISSUE	EP

COPYRIGHT IS VESTED IN MORTONS-URBAN SOLUTIONS AND WRITTEN CONSENT IS REQUIRED PRIOR TO REPRODUCTION.
DO NOT SCALE FROM THIS DRAWING.

ASSOCIATED CONSULTANTS

BIOME WATER AND ENVIRONMENTAL CONSULTING

Robin Russell & ASSOCIATES PTY. LTD.

BENNETT+BENNETT

DRAWING TITLE

STORMWATER
PIT DETAILS
SHEET 02

MORTONS urbansolutions
Urban & Regional Planning
Civil Engineering
Project Coordination

MUS Pty Ltd T/As:
Mortons-Urban Solutions
ABN: 39 116 375 065
mortons@urbansolutions.net.au
www.urbansolutions.net.au
Tel 07 5571 1099

Postal Address
PO Box 2484
Southport QLD 4215

Gold Coast Office
Suite 9, 19 Short St
Southport QLD 4215

DESIGNED	RB	DRAWN	EP
APPROVED	RPEQ 4706	DATE	13-10-23

DRAWING NUMBER 41901-02-652

REV B

F:\Autocad Client\419 - HB Land\01 - Courtney Drive\Precinct-Stage 02\Engineering Drawings\Current\41901-02-650.dwg, PIT DETAILS SHEET 03, 21/06/2024 1:31:44 PM, 1:2


BASIN CONSTRUCTION

1. PRIOR TO COMMENCING CONSTRUCTION OF THE DETENTION BASIN THE DIVERSION OF SURFACE WATER FROM THE PROPOSED WORKS AREA, USING MEASURES SUCH AS OPEN DRAINS/SUMPS, ARE REQUIRED TO AID IN SITE DEWATERING.
2. FOR THE ENTIRE EMBANKMENT AREA STRIPPING OF VEGETATION & ANY HIGHLY ORGANIC TOP SOILS & ANY SOFT CLAYS TO DEPTHS OF APPROXIMATELY 0.3m IS REQUIRED.
3. THE STRIPPED SURFACE IS TO BE INSPECTED & TESTED BY A GEOTECHNICAL ENGINEER.
4. SUBJECT TO GEOTECHNICAL ENGINEER'S INSPECTION EXCAVATION OF A CUTOFF KEY ALONG THE EMBANKMENT CENTERLINE AT LEAST 0.5m - 1.0m INTO THE FOUNDATION MATERIALS SHALL BE REQUIRED.
5. THE CLAY FILLING FOR THE BASIN WALLS SHALL BE PLACED IN HORIZONTAL LAYERS OF 200mm THICKNESS & COMPACTED TO A DENSITY RATIO WITHIN THE RANGE 98% - 102% STANDARD COMPACTION (AS 1289.5.1.1). PLACEMENT MOISTURE CONTENTS SHOULD BE WITHIN THE RANGE OMC -1% TO OMC +2% (WHERE OMC = OPTIMUM MOISTURE CONTENT FOR STANDARD COMPACTION).
6. IF THE CIVIL CONTRACTOR IS CONSTRUCTING THE BIO BASIN FILTER MEDIA AFTER THE CONSTRUCTION OF THE BASIN INLET & OUTLET STRUCTURES, THE CIVIL CONTRACTOR IS TO CONFIRM THE LEVELS OF THE INLET & OUTLET STRUCTURES PRIOR TO COMMENCING BASIN CONSTRUCTION.

WALL DETAILS CONTAINED WITH THIS SET ARE INDICATIVE ONLY.
ALL RETAINING WALLS AND FOOTINGS ARE SUBJECT TO DETAILED DESIGN AND CERTIFICATION BY AN APPROPRIATELY QUALIFIED R.P.E.Q CERTIFIED ENGINEER.

LEGEND

- EXISTING PROPERTY LINE
- EXISTING CONTOURS
- EXISTING STORMWATER
- FUTURE PROPERTY LINE
- FUTURE STORMWATER
- SITE BOUNDARY
- STAGE BOUNDARY
- PROPERTY LINE
- PROPOSED KERB
- DESIGN CONTOURS
- PROPOSED STORMWATER
- MANHOLE
- FIELD INLET
- KERB INLET (ON GRADE) PIT
- KERB INLET (SAG) PIT
- HEADWALL
- SCOUR PROTECTION
- TURF
- 10/001 STORMWATER PIT & LINE NO.

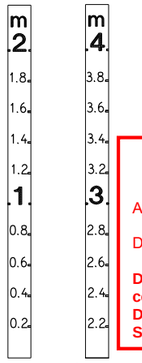

G9-22-1 G9-22-2

FLOOD DEPTH INDICATORS
NOT TO SCALE



WARNING SIGN
NOT TO SCALE

PLANS AND DOCUMENTS referred to in the DEVELOPMENT APPROVAL

Application No: MIN/2024/337

Dated: 16 July 2024

Development shall comply with the conditions of approval as detailed in the Decision Notice and Council's Planning Scheme, Local Laws and Planning Policies

BIO FILTRATION BASIN NOTES

- BIO FILTRATION BASIN TO BE EXCAVTED TO LEVEL BELOW FILTRATION MEDIA
- UNSUITABLE MATERIAL TO BE REMOVED OFF SITE AND BASIN TRIMMED TO FINAL PROFILE PRIOR TO PLACEMENT OF FILTER MEDIA AT 80% COMPLETION OF HOUSING

193 RP173728

COURTNEY DRIVE

4m WIDE CONCRETE MAINTANCE ACCESS 1:4 GRADE MAX

INSTALL PARK GATE IN ACCORDANCE WITH GCCC STD DWG 05-016

DEEP WATER WARNING SIGN

BASIN A2b
FILTER AREA 290m²

Ø 225 UNPERFORATED PVC HEADER PIPE GRADED AT 1:100 MIN

MINIMUM 4m WIDE GRAVEL MAINTENANCE ACCESS 20mm GRAVEL 200mm THICK

PROVIDE UNDERDRAIN CLEANOUT POINTS AS PER STD DWG WSUD-003 TYPICAL

Ø 100 SUBSOIL DRAINS SLOTTED PVC SPACED AT 2.5m CENTRES

DEPTH INDICATOR (2m)

ACCESS RAMP 01

15m WIDE HIGH-FLOW WEIR. WEIR TO BE CONSTRUCTED COMPLETE WITH CONCRETE STRIP IN ACCORDANCE WITH IPWEA DWG DS-076. ROCK GROUTED d50 = 200mm.

4m WIDE CONCRETE MAINTANCE ACCESS 1:4 GRADE MAX

ADJOIN SHEET 02

186 187 188 189 190 191 1006

10/026 11/026 12/026 01/058 02/058 03/058 04/024 03/024 02/055 16/025 15/025 01/039 07

A2 662 A3 662 A4 663 A 664 A5 663

DIAL BEFORE YOU DIG
www.1100.com.au

NORTH

0 2 4 6 8 10m
Scale 1:200 - A1 (1:400 - A3)

BASIN PLAN A2a

SCALE 1:200 - A1 (1:400 - A3)

PROJECT NAME

COURTNEY DR UPPER COOMERA

STAGE 02

RP DESCRIPTION

LOT 188, 189, 190, 191 & 192 ON RP173728
COURTNEY DRIVE
LOCALITY OF UPPER COOMERA
LOCAL AUTHORITY - GOLD COAST CITY COUNCIL

CLIENT

HB Land

REV	DATE	DESCRIPTION	INT
B	29-11-23	STORMWATER AMENDED	BL
A	13-10-23	COUNCIL ISSUE	EP

COPYRIGHT IS VESTED IN MORTONS-URBAN SOLUTIONS AND WRITTEN CONSENT IS REQUIRED PRIOR TO REPRODUCTION. DO NOT SCALE FROM THIS DRAWING.

ASSOCIATED CONSULTANTS

BIOME WATER AND ENVIRONMENTAL CONSULTING
Robin Russell & ASSOCIATES PTY. LTD.
BENNETT+BENNETT

DRAWING TITLE

STORMWATER
BASIN
PLAN AND DETAILS
SHEET 01

MORTONS urbansolutions
Urban & Regional Planning
Civil Engineering
Project Coordination

MUS Pty Ltd T/As:
Mortons-Urban Solutions
ABN: 39 116 375 065
mortons@urbansolutions.net.au
www.urbansolutions.net.au
Tel 07 5571 1099

Postal Address
PO Box 2484
Southport QLD 4215

Gold Coast Office
Suite 9, 19 Short St
Southport QLD 4215

DESIGNED	RB	DRAWN	EP
APPROVED	RPEQ 4706	DATE	13-10-23


DRAWING NUMBER: 41901-02-660
REV: B

F:\Autocad Client\419 - HB Land\01 - Courtney Drive\Precinct-Stage 02\Engineering Drawings\Current\41901-02-660.dwg, PLAN SHEET 01, 21/06/2024 1:32:16 PM, 1:2

LEGEND

- EXISTING PROPERTY LINE
- EXISTING CONTOURS
- EXISTING STORMWATER
- FUTURE PROPERTY LINE
- FUTURE STORMWATER
- SITE BOUNDARY
- STAGE BOUNDARY
- PROPERTY LINE
- PROPOSED KERB
- DESIGN CONTOURS
- PROPOSED STORMWATER
- MANHOLE
- FIELD INLET
- KERB INLET (ON GRADE) PIT
- KERB INLET (SAG) PIT
- HEADWALL
- SCOUR PROTECTION
- 10/001 STORMWATER PIT & LINE NO.

DIAL BEFORE YOU DIG www.1100.com.au

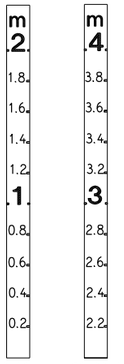

G9-22-1 G9-22-2


FLOOD DEPTH INDICATORS
NOT TO SCALE



WARNING SIGN
NOT TO SCALE


BIO FILTRATION BASIN NOTES

- BIO FILTRATION BASIN TO BE EXCAVTED TO LEVEL BELOW FILTRATION MEDIA
- UNSUITABLE MATERIAL TO BE REMOVED OFF SITE AND BASIN TRIMMED TO FINAL PROFILE PRIOR TO PLACEMENT OF FILTER MEDIA AT 80% COMPLETION OF HOUSING

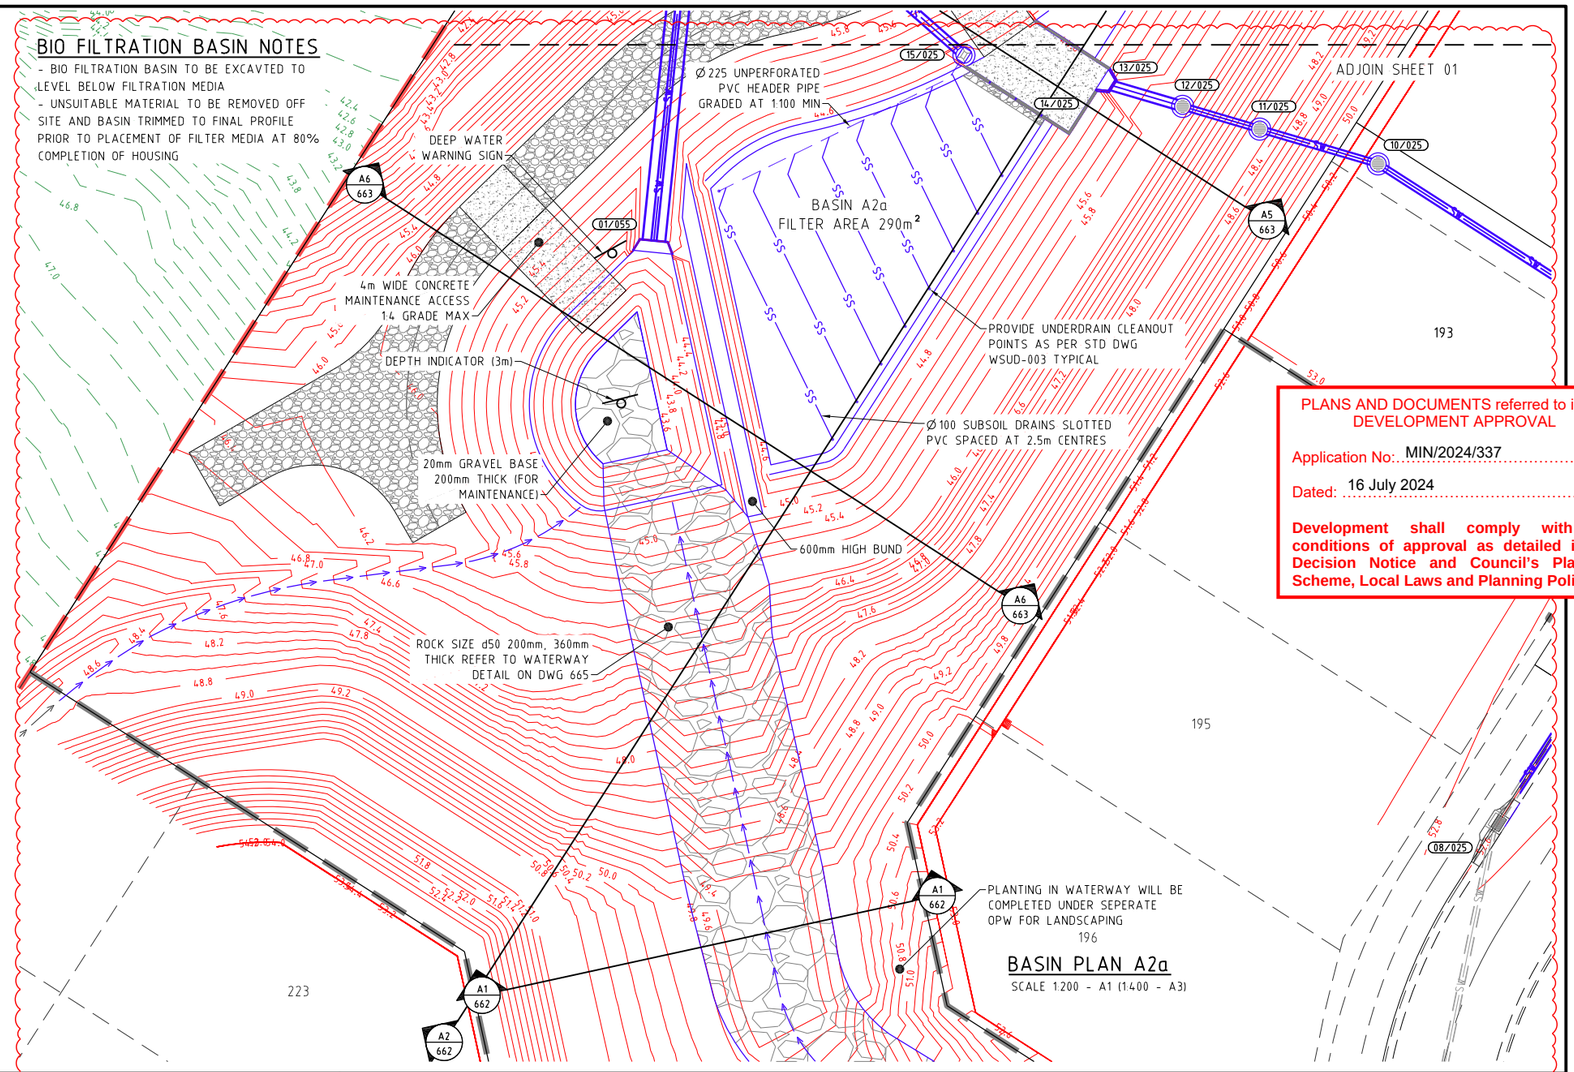


BASIN PLAN A2a

SCALE 1:200 - A1 (1:400 - A3)

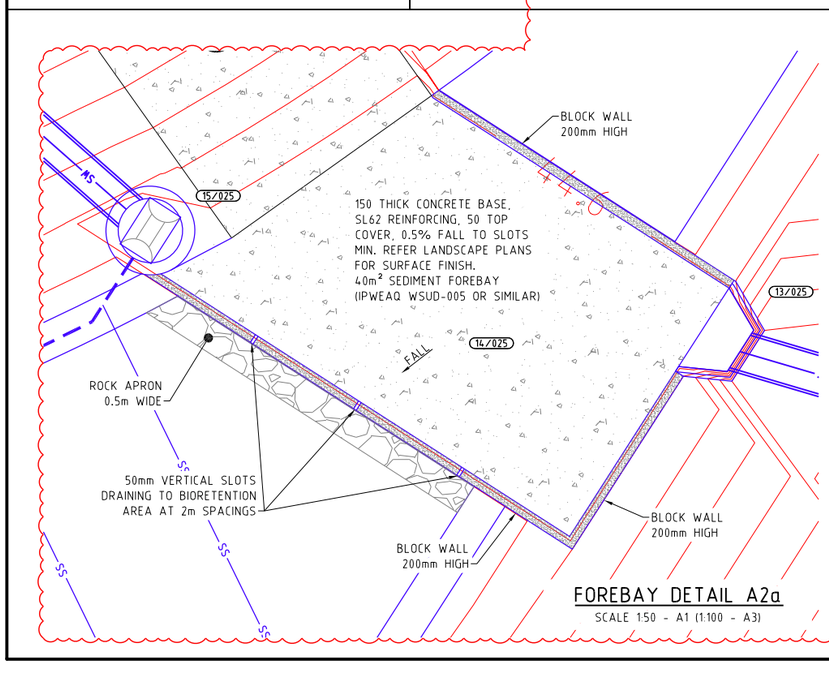

FOREBAY DETAIL A2a

SCALE 1:50 - A1 (1:100 - A3)

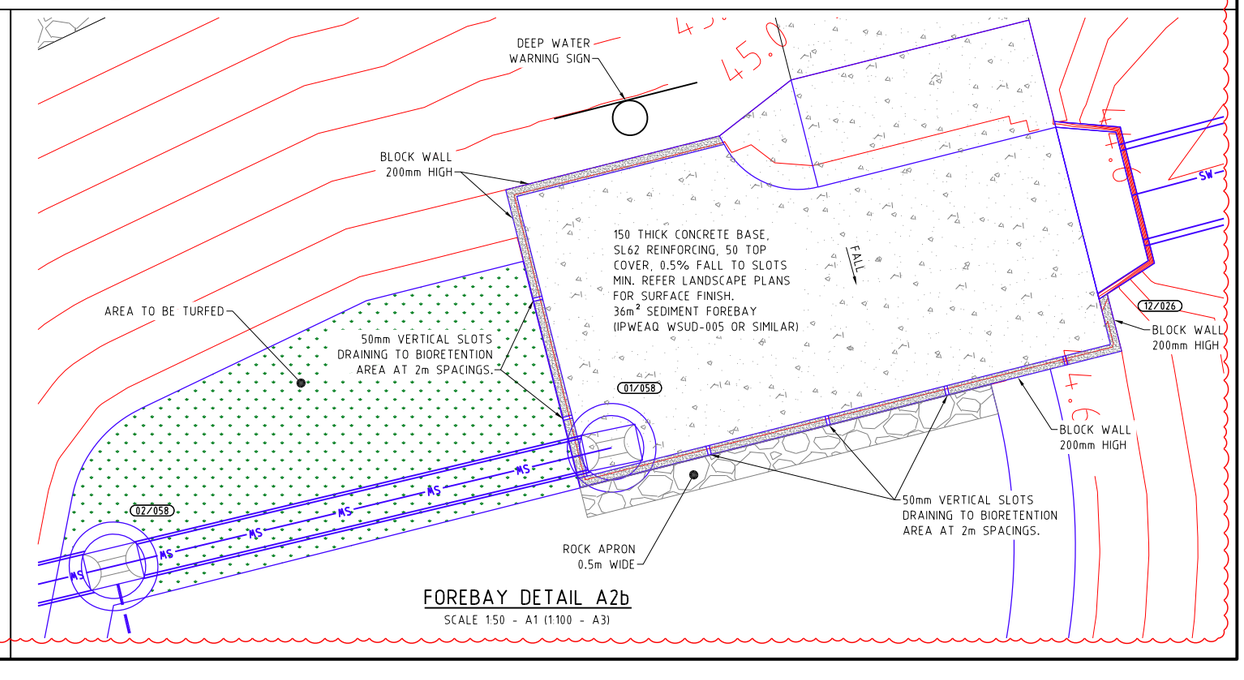

FOREBAY DETAIL A2b

SCALE 1:50 - A1 (1:100 - A3)

PROJECT NAME

COURTNEY DR UPPER COOMERA

STAGE 02

RP DESCRIPTION

LOT 188, 189, 190, 191 & 192 ON RP173728
COURTNEY DRIVE
LOCALITY OF UPPER COOMERA
LOCAL AUTHORITY - GOLD COAST CITY COUNCIL

CLIENT

HB Land

PLANS AND DOCUMENTS referred to in the DEVELOPMENT APPROVAL

Application No: MIN/2024/337

Dated: 16 July 2024

Development shall comply with the conditions of approval as detailed in the Decision Notice and Council's Planning Scheme, Local Laws and Planning Policies

NORTH

0 0.5 1.0 1.5 2.0 2.5m
Scale 1:50 - A1 (1:100 - A3)
0 2 4 6 8 10m
Scale 1:200 - A1 (1:400 - A3)

REV	DATE	DESCRIPTION	INT
B	29-11-23	STORMEATER AMENDED	BL
A	13-10-23	COUNCIL ISSUE	EP

COPYRIGHT IS VESTED IN MORTONS-URBAN SOLUTIONS AND WRITTEN CONSENT IS REQUIRED PRIOR TO REPRODUCTION. DO NOT SCALE FROM THIS DRAWING.

ASSOCIATED CONSULTANTS

BIOME WATER AND ENVIRONMENTAL CONSULTING
Robin Russell & ASSOCIATES PTY. LTD.
BENNETT+BENNETT

DRAWING TITLE

STORMWATER BASIN PLAN AND DETAILS SHEET 02

MORTONS urbansolutions
Urban & Regional Planning
Civil Engineering
Project Coordination

MUS Pty Ltd T/As:
Mortons-Urban Solutions
ABN: 39 116 375 065
mortons@urbansolutions.net.au
www.urbansolutions.net.au
Tel 07 5571 1099

Postal Address
PO Box 2484
Southport QLD 4215


Gold Coast Office
Suite 9, 19 Short St
Southport QLD 4215

DESIGNED	RB	DRAWN	EP
APPROVED	RPEQ 4706	DATE	13-10-23

DRAWING NUMBER 41901-02-661


REV B

F:\Autocad Client\419 - HB Land\01 - Courtney Drive\Precinct-Stage 02\Engineering Drawings\Current\41901-02-660.dwg, PLAN SHEET 02, 21/06/2024 1:33:03 PM, 1:2

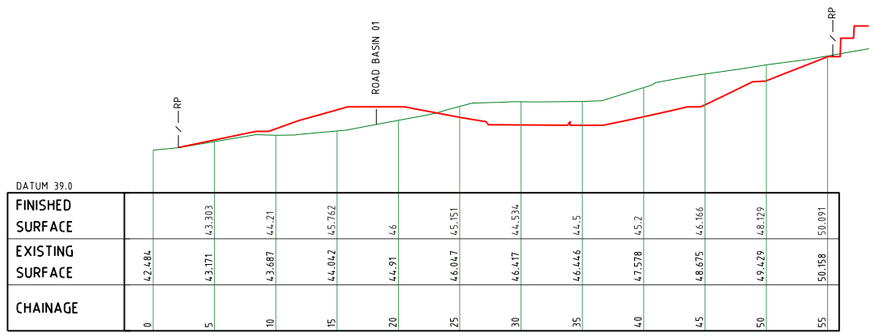


LONGITUDINAL SECTION A3


Horizontal scale 1:250
Vertical scale 1:250

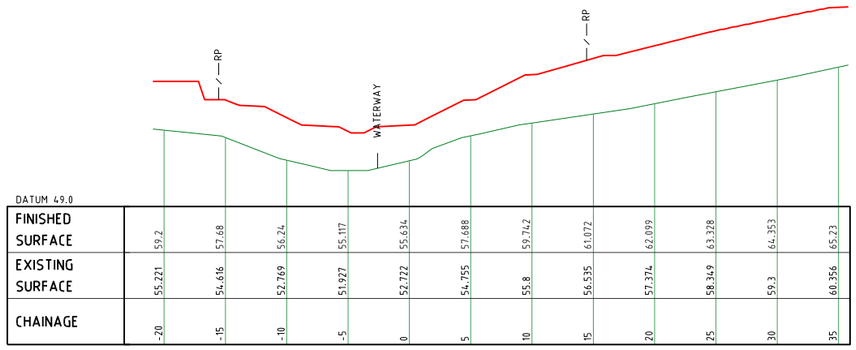

LONGITUDINAL SECTION A1

Horizontal scale 1:250
Vertical scale 1:250

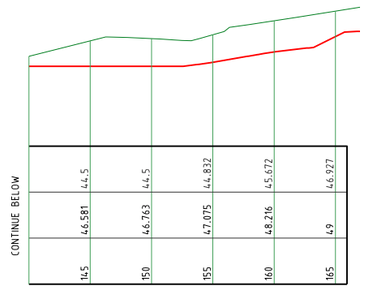

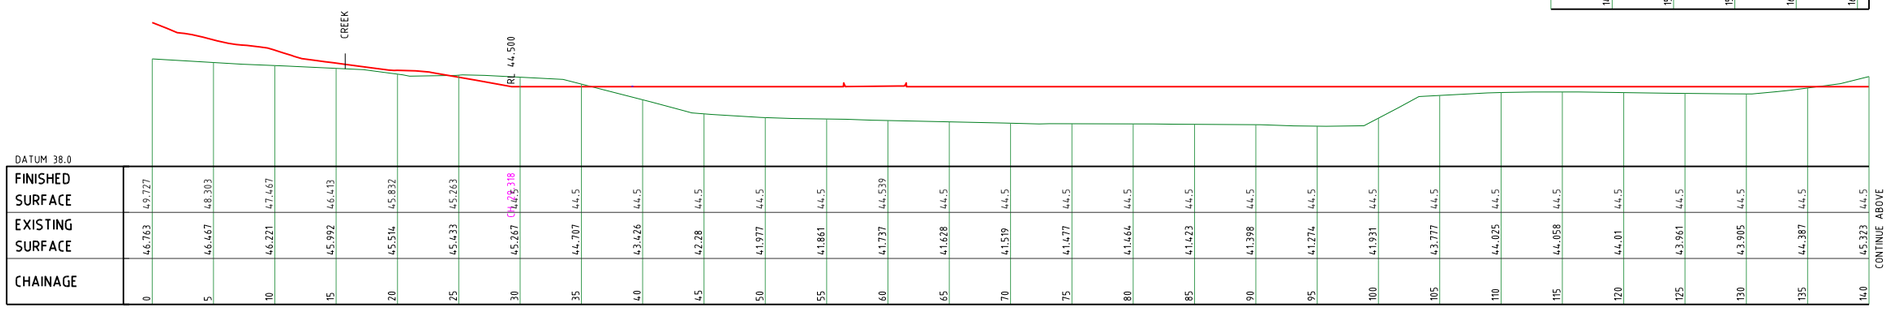

LONGITUDINAL SECTION A2

Horizontal scale 1:250
Vertical scale 1:250

PLANS AND DOCUMENTS referred to in the DEVELOPMENT APPROVAL

Application No: MIN/2024/337

Dated: 16 July 2024

Development shall comply with the conditions of approval as detailed in the Decision Notice and Council's Planning Scheme, Local Laws and Planning Policies

PROJECT NAME

COURTNEY DR UPPER COOMERA

STAGE 02

RP DESCRIPTION

LOT 188, 189, 190, 191 & 192 ON RP173728
COURTNEY DRIVE
LOCALITY OF UPPER COOMERA
LOCAL AUTHORITY - GOLD COAST CITY COUNCIL

CLIENT

HB Land

0 10 20 30 40 50m
Scale 1:1000 - A1 (1:2000 - A3)

REV	DATE	DESCRIPTION	INT
A	13-10-23	COUNCIL ISSUE	EP

COPYRIGHT IS VESTED IN MORTONS-URBAN SOLUTIONS AND WRITTEN CONSENT IS REQUIRED PRIOR TO REPRODUCTION.
DO NOT SCALE FROM THIS DRAWING.

ASSOCIATED CONSULTANTS

BIOME WATER AND ENVIRONMENTAL CONSULTING
Robin Russell & ASSOCIATES PTY. LTD.
BENNETT + BENNETT

DRAWING TITLE

STORMWATER BASIN SECTIONS SHEET 01


MORTONS urbansolutions
Urban & Regional Planning
Civil Engineering
Project Coordination
MUS Pty Ltd T/As:
Mortons-Urban Solutions
ABN: 39 116 375 065
mortons@urbansolutions.net.au
www.urbansolutions.net.au
Tel 07 5571 1099
Postal Address
PO Box 2484
Southport QLD 4215
Gold Coast Office
Suite 9, 19 Short St
Southport QLD 4215

DESIGNED	RB	DRAWN	EP
APPROVED		RPEQ 4706	DATE 13-10-23

DRAWING NUMBER 41901-02-662


REV A

F:\Autocad Client\419 - HB Land\01 - Courtney Drive\Precinct-Stage 02\Engineering Drawings\Current\41901-02-660.dwg, SECTIONS SHEET 01, 21/06/2024 1:33:21 PM, 1:2

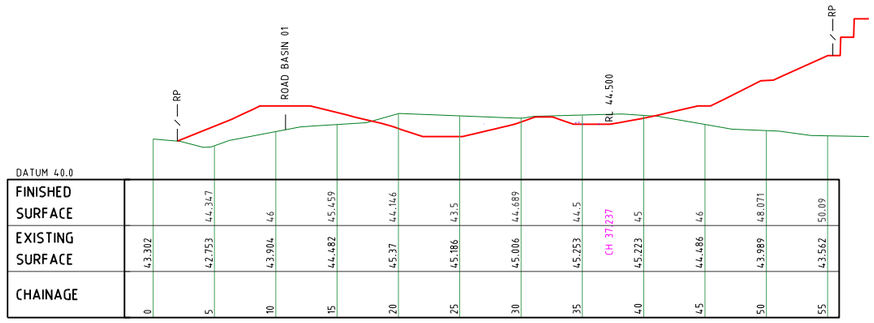


LONGITUDINAL SECTION A6

Horizontal scale 1:250
Vertical scale 1:250

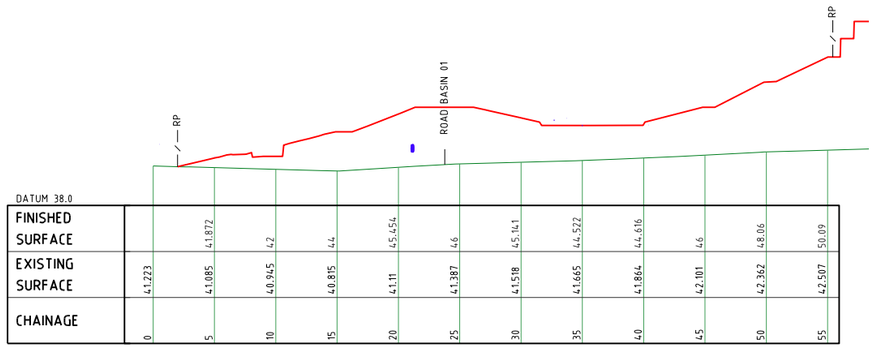

LONGITUDINAL SECTION A5

Horizontal scale 1:250
Vertical scale 1:250

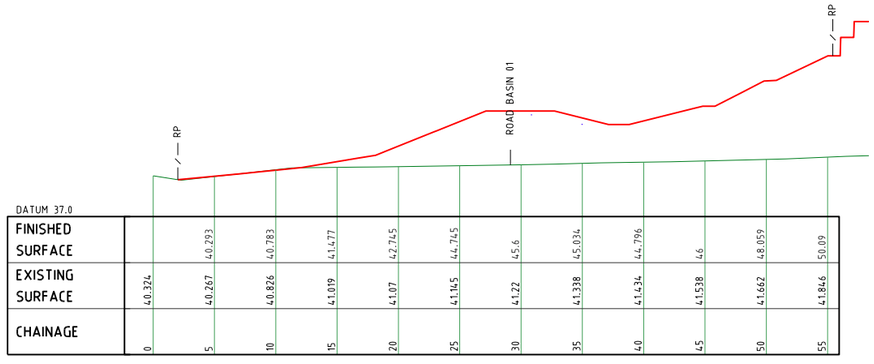

LONGITUDINAL SECTION A4

Horizontal scale 1:250
Vertical scale 1:250

PLANS AND DOCUMENTS referred to in the DEVELOPMENT APPROVAL

Application No: MIN/2024/337

Dated: 16 July 2024

Development shall comply with the conditions of approval as detailed in the Decision Notice and Council's Planning Scheme, Local Laws and Planning Policies

PROJECT NAME

COURTNEY DR UPPER COOMERA

STAGE 02

RP DESCRIPTION

LOT 188, 189, 190, 191 & 192 ON RP173728
COURTNEY DRIVE
LOCALITY OF UPPER COOMERA
LOCAL AUTHORITY - GOLD COAST CITY COUNCIL

CLIENT

HB Land

0 10 20 30 40 50m
Scale 1:1000 - A1 (1:2000 - A3)

REV	DATE	DESCRIPTION	INT
A	13-10-23	COUNCIL ISSUE	EP

COPYRIGHT IS VESTED IN MORTONS-URBAN SOLUTIONS AND WRITTEN CONSENT IS REQUIRED PRIOR TO REPRODUCTION.
DO NOT SCALE FROM THIS DRAWING.

ASSOCIATED CONSULTANTS

BIOME WATER AND ENVIRONMENTAL CONSULTING
Robin Russell & ASSOCIATES PTY. LTD.
BENNETT + BENNETT

DRAWING TITLE

STORMWATER
BASIN
SECTIONS
SHEET 02

MORTONS urbansolutions
Urban & Regional Planning
Civil Engineering
Project Coordination
MUS Pty Ltd T/As:
Mortons-Urban Solutions
ABN: 39 116 375 065
mortons@urbansolutions.net.au
www.urbansolutions.net.au
Tel 07 5571 1099
Postal Address
PO Box 2484
Southport QLD 4215
Gold Coast Office
Suite 9, 19 Short St
Southport QLD 4215

DESIGNED	RB	DRAWN	EP
APPROVED	RPEQ 4706	DATE	13-10-23

DRAWING NUMBER	REV
41901-02-663	A


F:\Autocad Client\419 - HB Land\01 - Courtney Drive\Precinct-Stage 02\Engineering Drawings\Current\41901-02-660.dwg, SECTIONS SHEET 02, 21/06/2024 1:33:23 PM, 1:2

PLANS AND DOCUMENTS referred to in the DEVELOPMENT APPROVAL


Application No: MIN/2024/337

Dated: 16 July 2024


Development shall comply with the conditions of approval as detailed in the Decision Notice and Council's Planning Scheme, Local Laws and Planning Policies

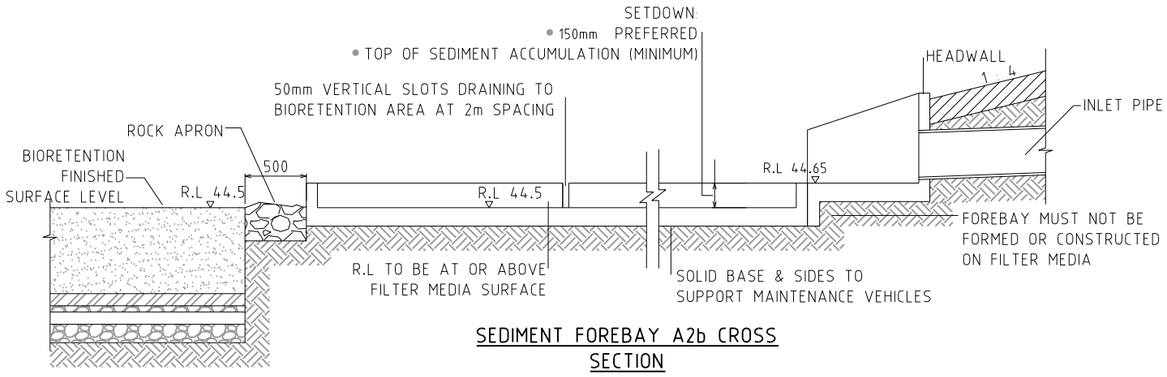


SEDIMENT FOREBAY A2b CROSS SECTION

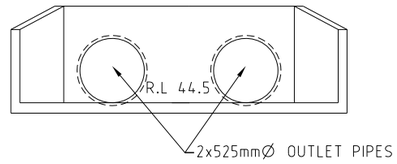


HEADWALL 01/055
(2x525mm OUTLET PIPES)

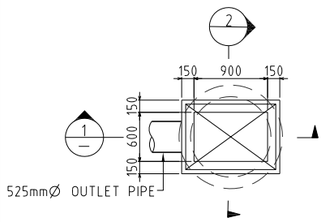


OVERFLOW STRUCTURE 01/058

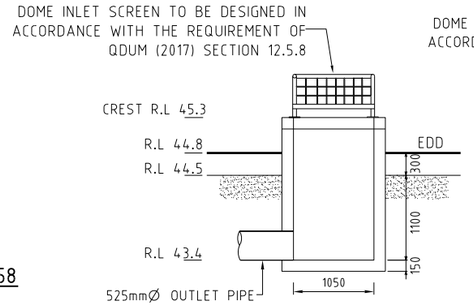


SECTION 1-1

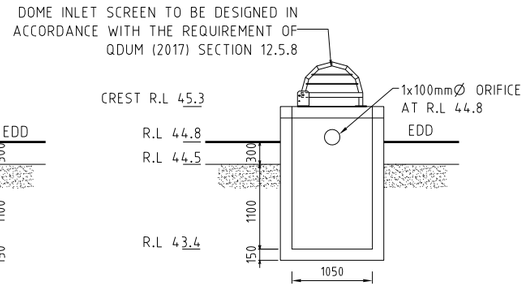


SECTION 2-2

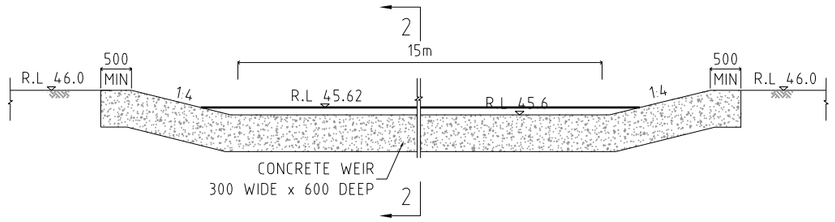


WEIR DETAIL SECTION 1-1

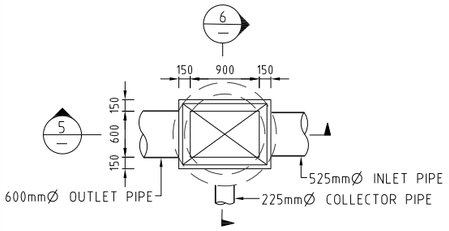


OVERFLOW STRUCTURE 02/058

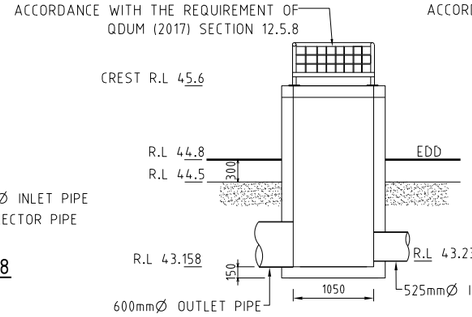


SECTION 5-5

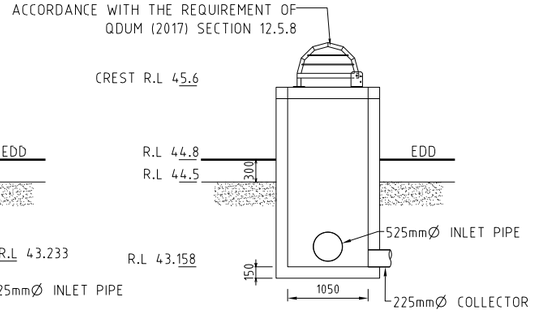


SECTION 6-6

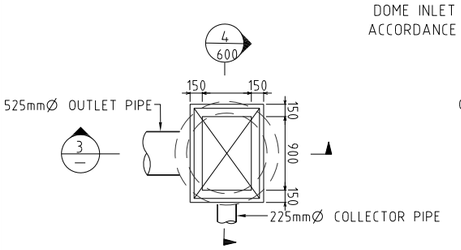


OVERFLOW STRUCTURE 15-025

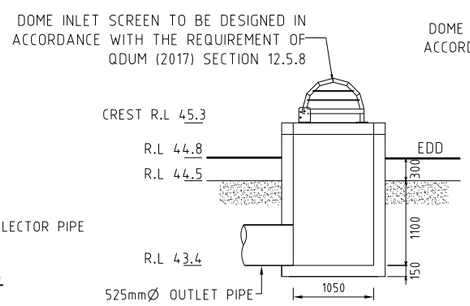

SECTION 3-3

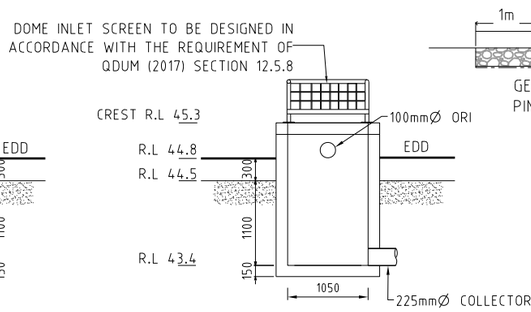

SECTION 4-4

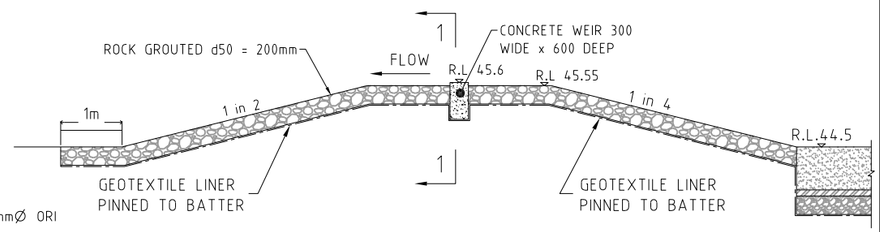

WEIR CROSS SECTION 2-2

PROJECT NAME

COURTNEY DR UPPER COOMERA

STAGE 02

RP DESCRIPTION

LOT 188, 189, 190, 191 & 192 ON RP173728
COURTNEY DRIVE
LOCALITY OF UPPER COOMERA
LOCAL AUTHORITY - GOLD COAST CITY COUNCIL

CLIENT

HB Land

NTS

REV	DATE	DESCRIPTION	INT
B	29-11-23	DETAILS AMENDED	BL
A	13-10-23	COUNCIL ISSUE	EP

COPYRIGHT IS VESTED IN MORTONS-URBAN SOLUTIONS AND WRITTEN CONSENT IS REQUIRED PRIOR TO REPRODUCTION. DO NOT SCALE FROM THIS DRAWING.

ASSOCIATED CONSULTANTS

BIOME WATER AND ENVIRONMENTAL CONSULTING

Robin Russell & ASSOCIATES PTY. LTD.

BENNETT + BENNETT

DRAWING TITLE

STORMWATER
BASIN
DETAILS & SECTIONS
SHEET 01

MORTONS urbansolutions
Urban & Regional Planning
Civil Engineering
Project Coordination

MUS Pty Ltd T/As:
Mortons-Urban Solutions
ABN: 39 116 375 065
mortons@urbansolutions.net.au
www.urbansolutions.net.au
Tel 07 5571 1099

Postal Address
PO Box 2484
Southport QLD 4215

Gold Coast Office
Suite 9, 19 Short St
Southport QLD 4215

DESIGNED RB	DRAWN EP
APPROVED	RPEQ 4706 DATE 13-10-23

DRAWING NUMBER 41901-02-664

REV B


F:\Autocad Client\419 - HB Land\01 - Courtney Drive\Precinct-Stage 02\Engineering Drawings\Current\41901-02-664.dwg, DETAILS SHEET 01, 21/06/2024 1:23:27 PM, 1:2


PLANS AND DOCUMENTS referred to in the DEVELOPMENT APPROVAL

Application No: MIN/2024/337

Dated: 16 July 2024

Development shall comply with the conditions of approval as detailed in the Decision Notice and Council's Planning Scheme, Local Laws and Planning Policies

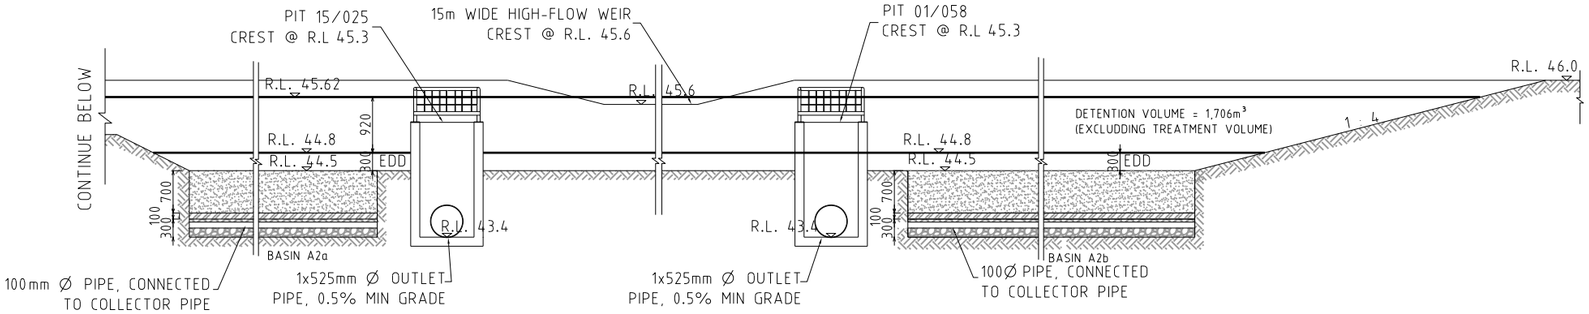


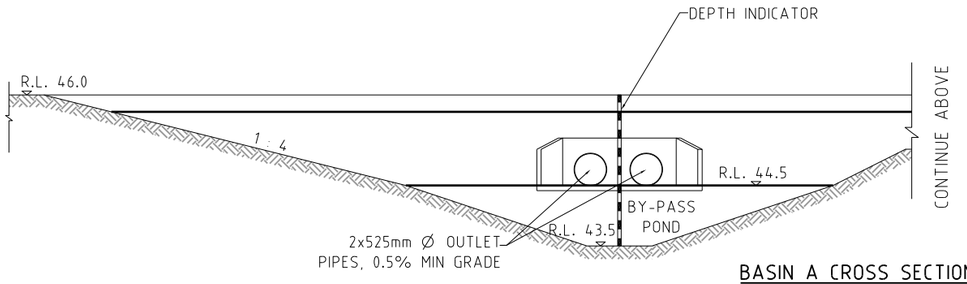

BASIN A CROSS SECTION A-A


SCALE 1:50

NOTES:
1. STRUCTURAL STABILITY AND PERMEABILITY OF WATER RETENTION BUNDS TO BE DESIGNED BY GEOTECHNICAL ENGINEER.
2. CONSTRUCTION TIMING OF BIO-RETENTION MEDIA DETAILED IN CONTRACT. PLANTING OF MEDIA TO OCCUR AFTER 80% DWELLING COMPLETION

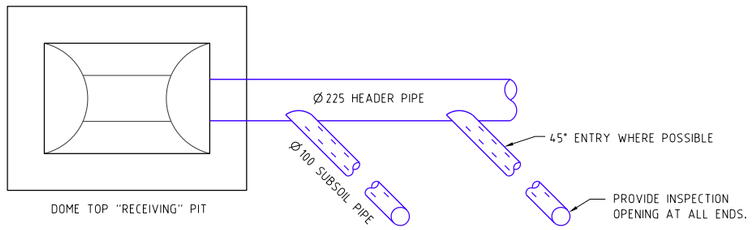


TYPICAL HEADER & SUBSOIL DETAILS

N.T.S.

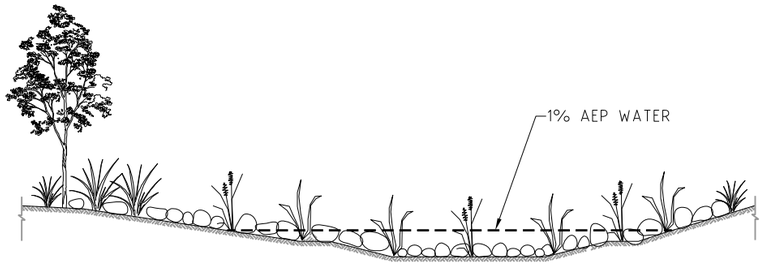


WATERWAY SECTION A1-661

N.T.S.

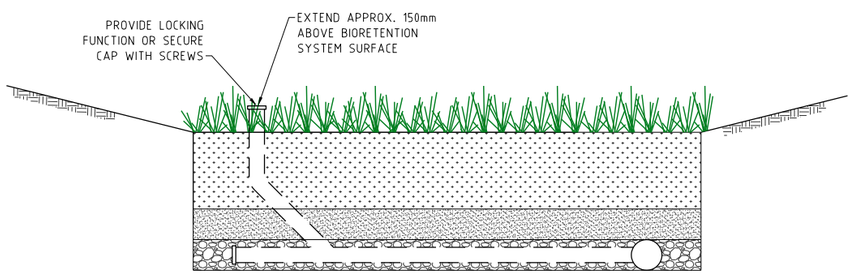


BIORETENTION FILTER TYPICAL SECTION

N.T.S.

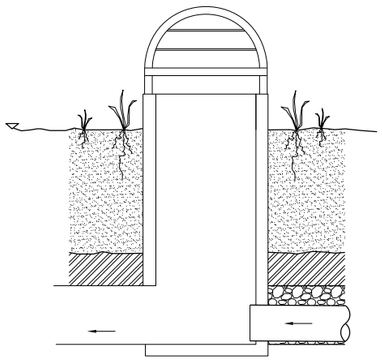

TYPPICAL HEADER PIPE CONNECTION DETAIL

N.T.S.

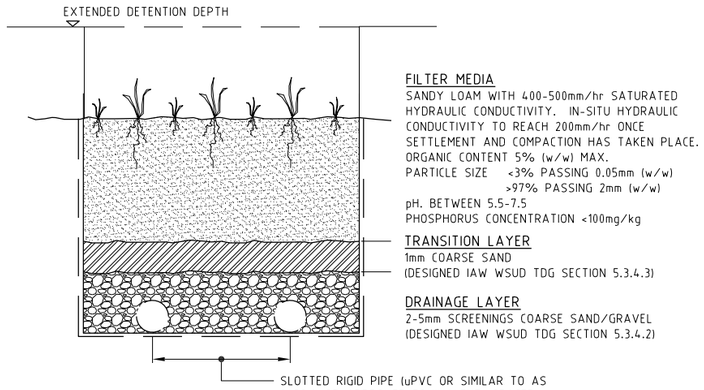

BIO-RETENTION MEDIA CROSS SECTION

N.T.S.

* LAYER THICKNESSES AND MATERIAL SPECIFICATIONS ARE INDICATIVE ONLY, REFER TO APPROVED STORMWATER MANAGEMENT PLAN.

PROJECT NAME

COURTNEY DR UPPER COOMERA

STAGE 02

RP DESCRIPTION

LOT 188, 189, 190, 191 & 192 ON RP173728
COURTNEY DRIVE
LOCALITY OF UPPER COOMERA
LOCAL AUTHORITY - GOLD COAST CITY COUNCIL

CLIENT

HB Land

REV	DATE	DESCRIPTION	INT
B	29-11-23	DETAILS AMENDED	BL
A	13-10-23	COUNCIL ISSUE	EP

COPYRIGHT IS VESTED IN MORTONS-URBAN SOLUTIONS AND WRITTEN CONSENT IS REQUIRED PRIOR TO REPRODUCTION. DO NOT SCALE FROM THIS DRAWING.

ASSOCIATED CONSULTANTS

BIOME WATER AND ENVIRONMENTAL CONSULTING

Robin Russell & ASSOCIATES PTY. LTD.

BENNETT+BENNETT

DRAWING TITLE

STORMWATER
BASIN
DETAILS & SECTIONS
SHEET 02

MORTONS urbansolutions
Urban & Regional Planning
Civil Engineering
Project Coordination

MUS Pty Ltd T/As:
Mortons-Urban Solutions
ABN: 39 116 375 065
mortons@urbansolutions.net.au
www.urbansolutions.net.au
Tel 07 5571 1099

Postal Address
PO Box 2484
Southport QLD 4215

Gold Coast Office
Suite 9, 19 Short St
Southport QLD 4215

DESIGNED	RB	DRAWN	EP
APPROVED		RPEQ 4706	DATE 13-10-23

DRAWING NUMBER 41901-02-665


REV B

F:\Autocad Client\419 - HB Land\01 - Courtney Drive\Precinct-Stage 02\Engineering Drawings\Current\41901-02-664.dwg, DETAILS SHEET 02, 21/06/2024 1:33:28 PM, 1:2

LEGEND

- EXISTING STORMWATER
- EXISTING ROOFWATER
- EXISTING SUBSOIL
- EXISTING KERB (INVERT)
- EXISTING CONTOURS
- EXISTING PROPERTY LINE
- FUTURE STORMWATER
- FUTURE ROOFWATER
- FUTURE SUBSOIL
- FUTURE KERB (INVERT)
- FUTURE PROPERTY LINE
- FUTURE CONTOURS
- SITE BOUNDARY
- STAGE BOUNDARY
- PROPOSED KERB (INVERT)
- PROPOSED PROPERTY LINE
- DESIGN CONTOURS
- CATCHMENT BOUNDARY (MINOR)
- CATCHMENT BOUNDARY (MAJOR)
- OVERLAND FLOW
- PROPOSED STORMWATER
- PROPOSED ROOFWATER
- PROPOSED SUBSOIL
- MANHOLE
- KERB INLET (ON GRADE) PIT
- KERB INLET (SAG) PIT
- HEADWALL
- SCOUR PROTECTION
- 01/015 0.2552ha CATCHMENT NUMBER & AREA

SHEET LAYOUT

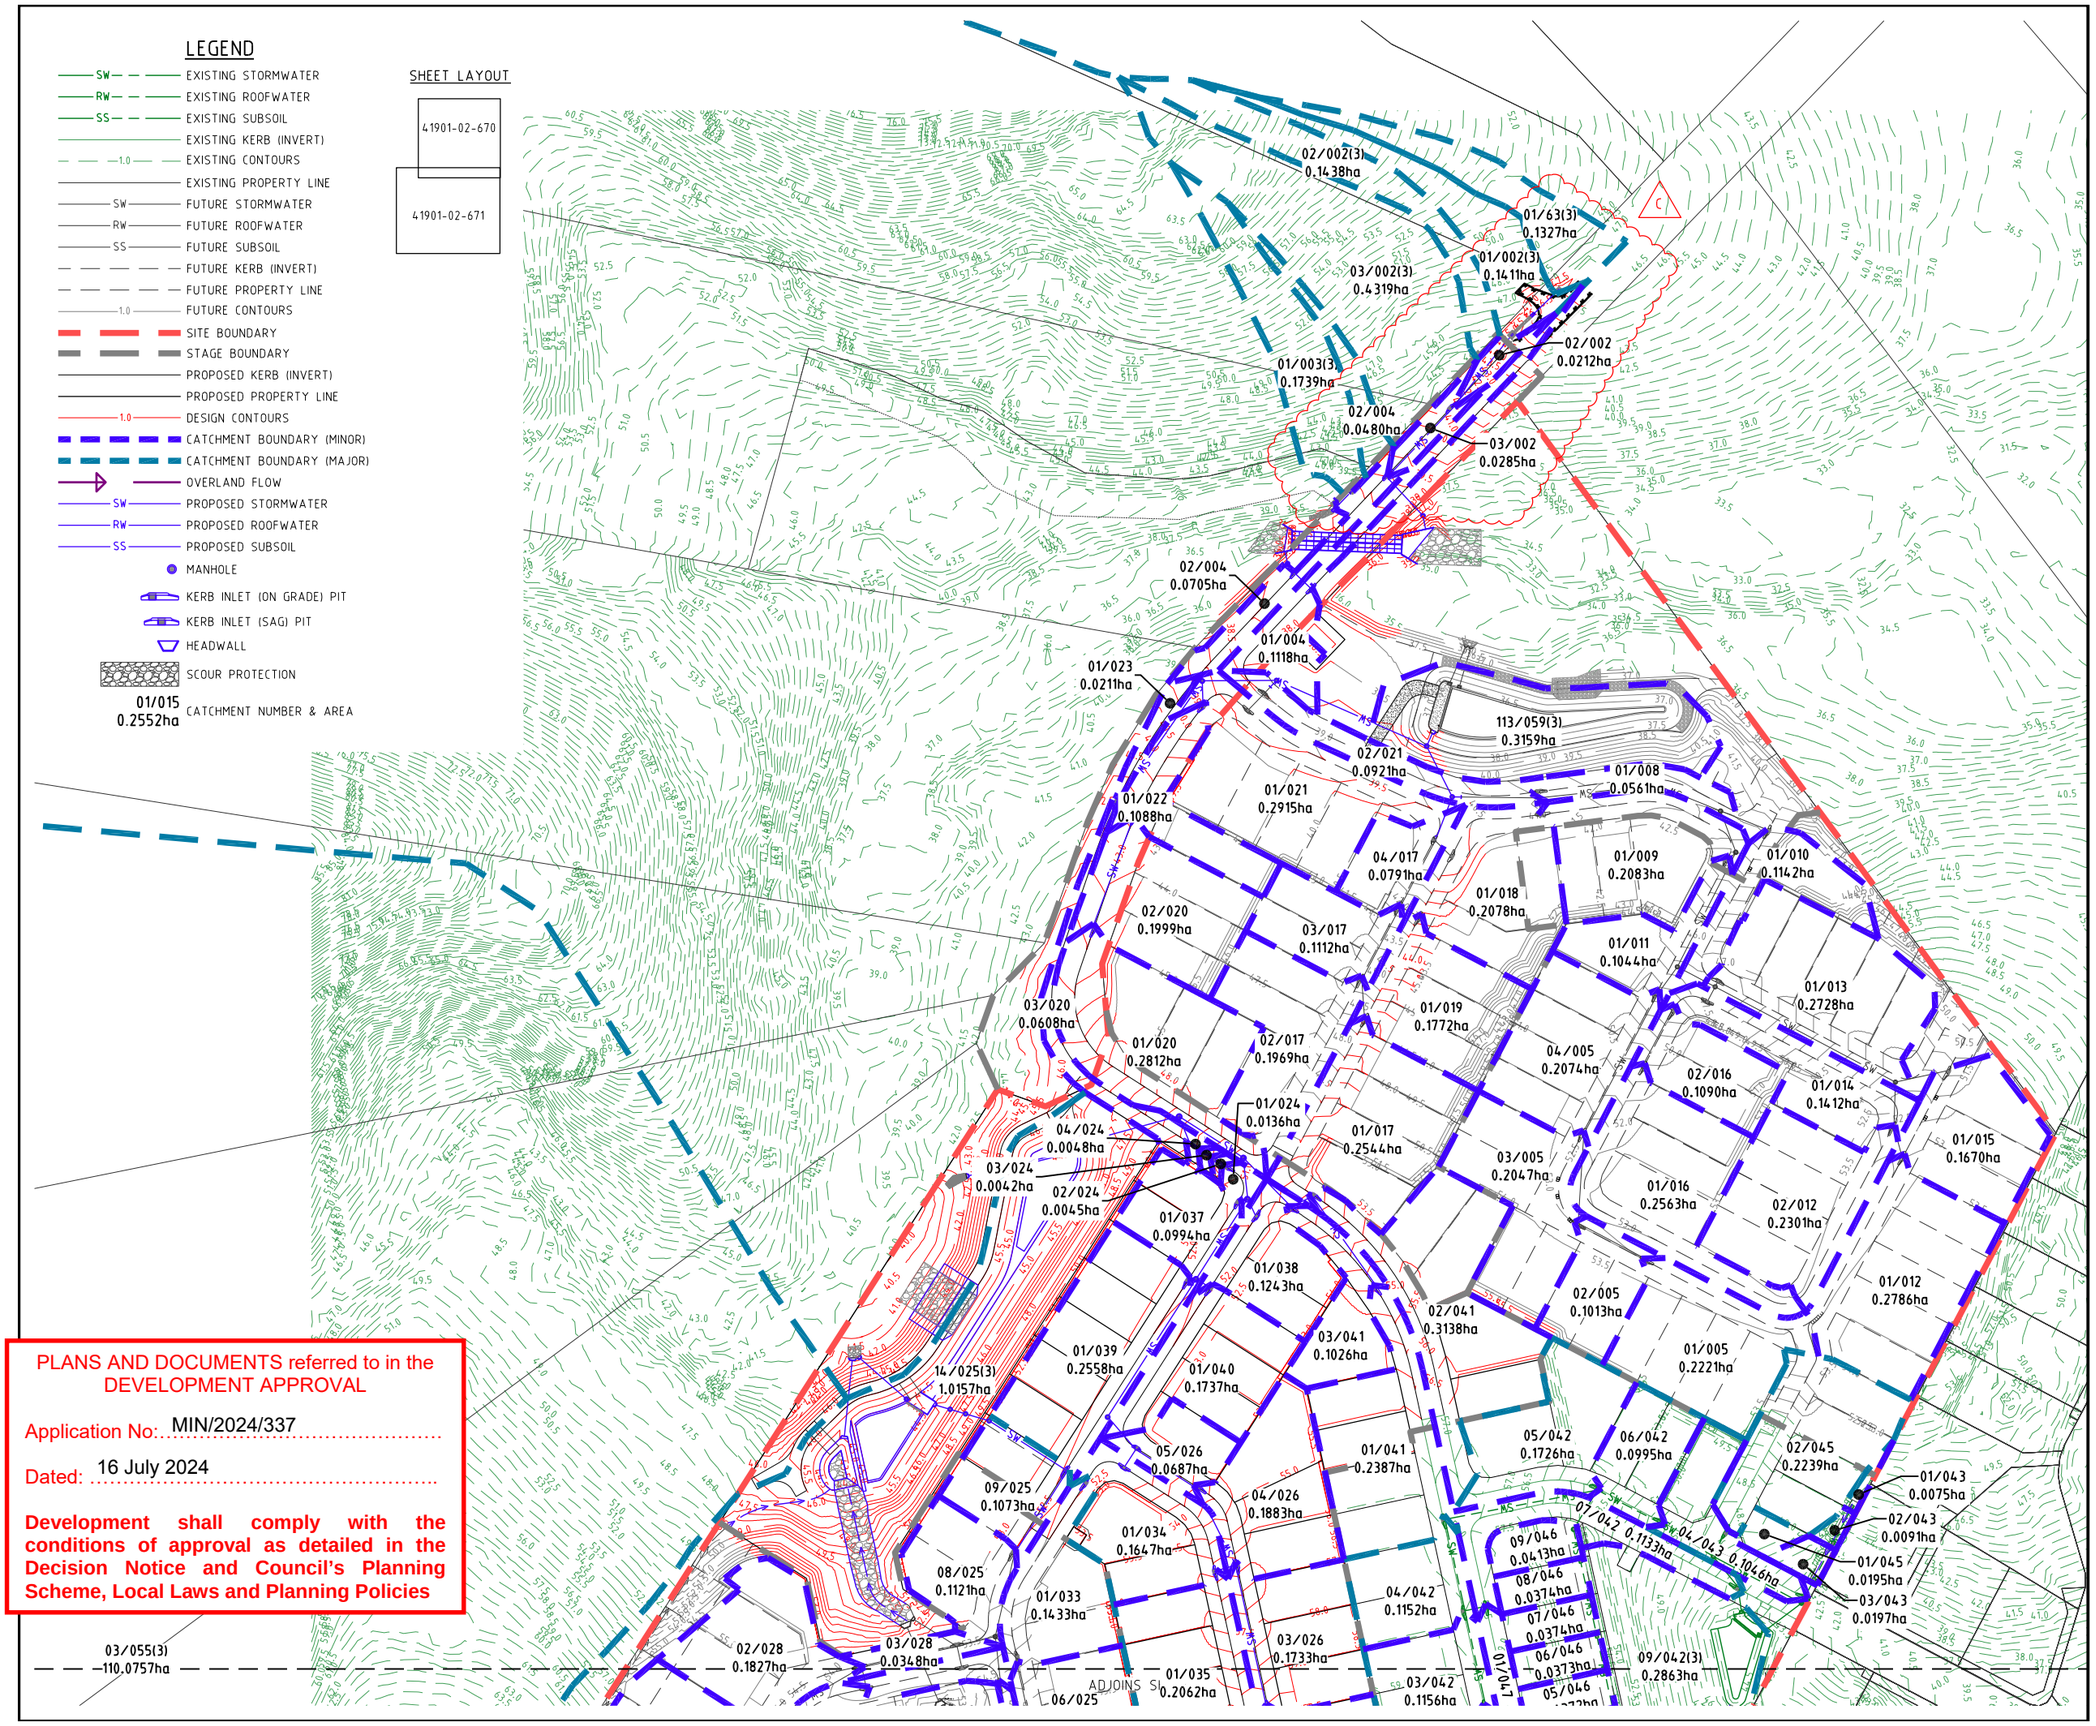

PLANS AND DOCUMENTS referred to in the DEVELOPMENT APPROVAL

Application No: MIN/2024/337

Dated: 16 July 2024

Development shall comply with the conditions of approval as detailed in the Decision Notice and Council's Planning Scheme, Local Laws and Planning Policies

PROJECT NAME

COURTNEY DR UPPER COOMERA

STAGE 02

RP DESCRIPTION

LOT 188, 189, 190, 191 & 192 ON RP173728
COURTNEY DRIVE
LOCALITY OF UPPER COOMERA
LOCAL AUTHORITY - GOLD COAST CITY COUNCIL

CLIENT

HB Land

NORTH

0 10 20 30 40 50m

Scale 1:1000 - A1 (1:2000 - A3)

REV	DATE	DESCRIPTION	INT
C	14-06-24	CONTOURS AMENDED & CATCHMENT PLAN ADJUSTED	RK
B	15-01-24	CATCHMENT NUMBER & AREAS AMENDED	BL
A	13-10-23	COUNCIL ISSUE	EP

COPYRIGHT IS VESTED IN MORTONS-URBAN SOLUTIONS AND WRITTEN CONSENT IS REQUIRED PRIOR TO REPRODUCTION. DO NOT SCALE FROM THIS DRAWING.

ASSOCIATED CONSULTANTS

BIOME WATER AND ENVIRONMENTAL CONSULTING
Robin Russell & ASSOCIATES PTY. LTD.
BENNETT+BENNETT

DRAWING TITLE

STORMWATER
CATCHMENT PLAN
SHEET 01

MORTONS urbansolutions
Urban & Regional Planning
Civil Engineering
Project Coordination

MUS Pty Ltd T/As:
Mortons-Urban Solutions
ABN: 39 116 375 065

mortons@urbansolutions.net.au
www.urbansolutions.net.au
Tel 07 5571 1099

Postal Address
PO Box 2484
Southport QLD 4215

Gold Coast Office
Suite 9, 19 Short St
Southport QLD 4215

DESIGNED	RB	DRAWN	EP
APPROVED	RPEQ 4706	DATE	13-10-23

DRAWING NUMBER 41901-02-670 REV C


F:\Autocad Client\419 - HB Land\01 - Courtney Drive\Precinct-Stage 02\Engineering Drawings\Current\41901-02-670.dwg, PLAN SHEET 01, 21/06/2024 1:33:35 PM, 1:2

PLANS AND DOCUMENTS referred to in the DEVELOPMENT APPROVAL

Application No: MIN/2024/337

Dated: 16 July 2024

Development shall comply with the conditions of approval as detailed in the Decision Notice and Council's Planning Scheme, Local Laws and Planning Policies

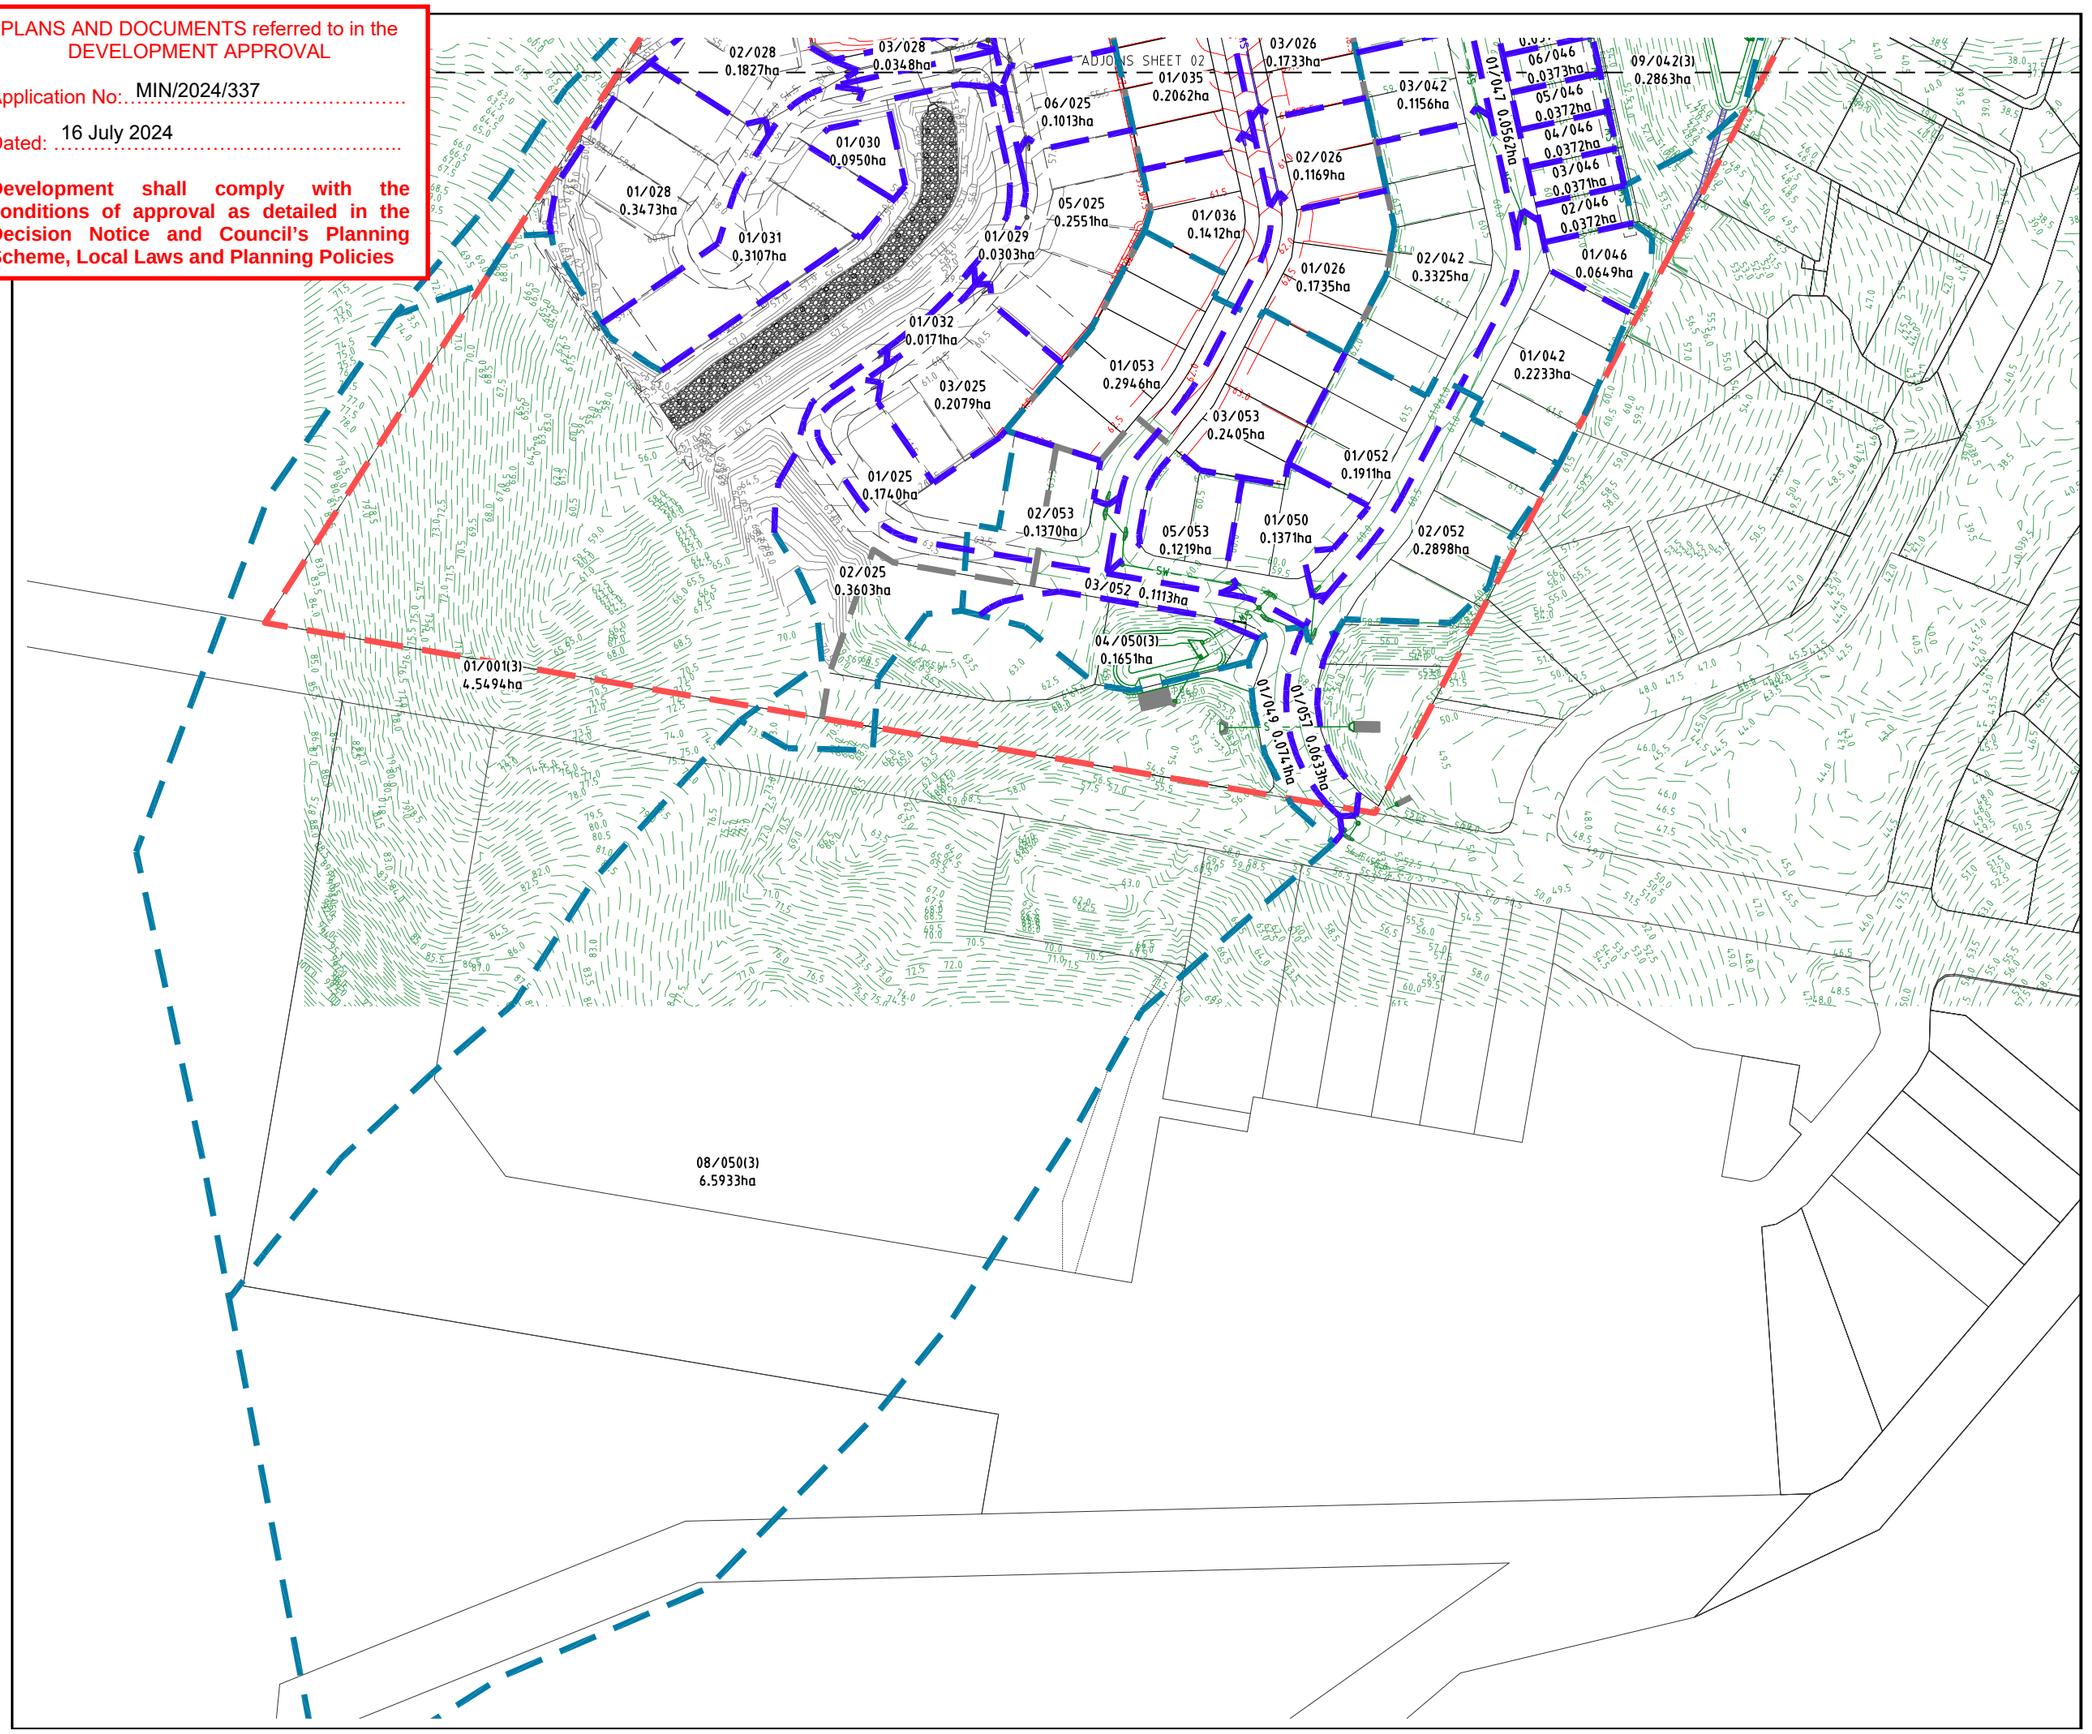

PROJECT NAME

COURTNEY DR UPPER COOMERA

STAGE 02

RP DESCRIPTION

LOT 188, 189, 190, 191 & 192 ON RP173728
COURTNEY DRIVE
LOCALITY OF UPPER COOMERA
LOCAL AUTHORITY - GOLD COAST CITY COUNCIL

CLIENT

HB Land

NORTH

0 10 20 30 40 50m

Scale 1:1000 - A1 (1:2000 - A3)

REV	DATE	DESCRIPTION	
A	13-10-23	COUNCIL ISSUE	EP

COPYRIGHT IS VESTED IN MORTONS-URBAN SOLUTIONS AND WRITTEN CONSENT IS REQUIRED PRIOR TO REPRODUCTION. DO NOT SCALE FROM THIS DRAWING.

ASSOCIATED CONSULTANTS

BIOME WATER AND ENVIRONMENTAL CONSULTING

Robin Russell & ASSOCIATES PTY. LTD.

BENNETT + BENNETT

DRAWING TITLE

STORMWATER CATCHMENT PLAN SHEET 02

MORTONS urbansolutions
Urban & Regional Planning
Civil Engineering
Project Coordination

MUS Pty Ltd T/As:
Mortons-Urban Solutions
ABN: 39 116 375 065
mortons@urbansolutions.net.au
www.urbansolutions.net.au
Tel 07 5571 1099

Postal Address
PO Box 2484
Southport QLD 4215

Gold Coast Office
Suite 9, 19 Short St
Southport QLD 4215

DESIGNED	RB	DRAWN	EP
APPROVED		RPEQ 4706	DATE 13-10-23

DRAWING NUMBER	REV
41901-02-671	A

F:\Autocad Client\419 - HB Land\01 - Courtney Drive\Precinct-Stage 02\Engineering Drawings\Current\41901-02-670.dwg, PLAN SHEET 02, 21/06/2024 1:33:41 PM, 1:2

PLANS AND DOCUMENTS referred to in the DEVELOPMENT APPROVAL

Application No: MIN/2024/337

Dated: 16 July 2024

Development shall comply with the conditions of approval as detailed in the Decision Notice and Council's Planning Scheme, Local Laws and Planning Policies

CALCULATION TABLES-MINOR 2YR ARI

* REFER TO IFD TABLE FOR MAXIMUM INTENSITY DURING STORM

				CATCHMENT AREA A.2 HA	CATCHMENT AREA A.3 HA	RAINFALL VOLUME* CRITICAL STORM	RAINFALL VOLUME* INTENSITY MM/HR	RAINFALL Coef. 10 YR	RAINFALL Coef. CURRENT Storm	CATCHMENT FLOW A.1 HA	CATCHMENT FLOW A.2 HA	CATCHMENT FLOW A.3 HA	CRITICAL ARI MIN.	GRADE %	APPROACH FLOW L/S	APPROACH FLOW FLOW WIDTH	APPROACH FLOW DxV	FLOW AT PIT CAPTURED L/S	FLOW AT PIT BYPASS L/S	FLOW AT PIT BYPASS DxV	NODE	GRADE %	PIT GRATE RL.	PIT RL	HGL PIPE U/S RL.	HGL D/S RL.	GRADE %	PIPE FLOW M3/S	HEADLOSSES COEFFICIENT Ku	HEADLOSSES COEFFICIENT Kw	HEADLOSS Ku	HEADLOSS Kw	CAPACITY RATIO	VELOCITY M/S	NODE
					0.141			0.877				0.029	60	1.0	29	1.32	0.01	14	15	0.01	02/2	1.000	44.376	43.16	43.16	39.90	10.35	0.04	1.6	0.0	0.0	0.0	0.06	3.28	01/2
			…1		0.144	90	61.3	0.877	0.830	0.007		0.030	60	9.7	51	1.15	0.00	48	3	0.00	03/2	9.683	41.196	39.90	39.90	37.50	7.92	0.09	2.5	0.0	0.0	0.0	0.14	3.91	02/2
			…9		0.432	90	61.3		0.830	0.009		0.090	60	5.8	101	1.57	0.02	80	20	0.02	02/4	5.792	38.890	37.50	37.49	34.91	15.06	0.17	2.3	0.0	0.0	0.0	0.19	5.66	03/2
													25	1.0	0			0				1.000	36.333	33.50	33.49	33.47	0.44	0.17	2.1	0.0	0.0	0.0	0.69	1.67	04/2
													25	1.0	0			0				1.000	34.228	33.31	33.31	33.29	0.07	0.19	0.0	0.0	0.0	0.0	0	0.92	05/2
													25	1.0	0			0				1.000	34.000	33.29											08/55
					0.174							0.036	60	1.0	36			36				1.000	38.228	37.76	37.74	37.37	6.15	0.04	0.5	0.0	0.0	0.0	0.07	1.32	01/3
													25	1.0	0			0				1.000	37.930	37.30	37.30	37.30	0.00	0.04	0.0	0.0	0.0	0.0			02/3
					20.019							4.638	90	1.0	4638			4638				1.000	36.200	35.19											05/55
			…2			90	61.3	0.877	0.830	0.037			60	0.2	37	1.07	0.00	37	0	0.00	O 01/4	0.174	37.669	36.52	36.49	36.35	2.12	0.04	7.0	0.0	0.0	0.0	0.11	1.46	01/4
			…1		0.048	90	61.3	0.877	0.830	0.023		0.010	60	0.2	50	1.07	0.00	50	0	0.00	O 02/4	0.174	37.669	36.34	36.32	35.68	14.80	0.09	4.2	0.0	0.0	0.0	0.1	4.17	02/4
													25	1.0	0			0				1.000	37.730	35.20	35.19	35.19	0.00	0.08	2.1	0.0	0.1	0.0	0.15	2.51	03/4
													25	1.0	0			0				1.000	36.446	35.19	35.19	35.19	0.00	0.08	0.0	0.0	0.0	0.0			04/4
					20.019							4.638	90	1.0	4638			4638				1.000	36.200	35.19											05/55
			…2			90	61.3	0.877	0.830	0.073			60	1.0	73	1.07	0.00	72	0	0.00	02/5	1.000	53.037	52.15	52.09	51.77	1.30	0.07	9.7	0.0	0.1	0.0	0.28	1.42	01/5
02/5	03/5	INLET GULLY ON GRADE (LG) Type S Lintel	0.101			90	61.3	0.877	0.830	0.033			60	1.0	33	0.00	0.00	33	0	0.00	03/5	1.000	52.886	51.77	51.76	51.33	1.49	0.11	1.9	0.0	0.0	0.0	0.38	2.08	02/5
03/5	04/5	INLET GULLY ON GRADE (LG) Type S Lintel	0.205			90	61.3	0.877	0.830	0.067			60	1.0	67	0.00	0.00	67	0	0.00	04/5	1.000	52.252	51.26	51.26	47.23	7.82	0.17	2.0	0.0	0.0	0.0	0.27	4.6	03/5
04/5	05/5	INLET GULLY ON GRADE (LG) Type S Lintel	0.207			90	61.3	0.877	0.830	0.068			60	1.0	68	0.00	0.00	68	0	0.00	01/11	1.000	48.247	47.23	47.20	46.08	10.21	0.36	1.3	0.0	0.0	0.0	0.3	5.4	04/5
05/5	06/5	MANHOLE 1050mm DIA											25	1.0	0			0				1.000	47.204	45.83	45.81	42.11	8.82	0.70	1.0	0.0	0.0	0.0	0.64	6.53	05/5
06/5	07/5	MANHOLE 1200mm DIA											25	1.0	0			0				1.000	42.982	42.05	41.92	41.34	4.04	0.73	2.0	0.0	0.1	0.0	0.46	2.79	06/5
07/5	08/5	MANHOLE 1200mm DIA											25	1.0	0			0				1.000	41.996	41.34	41.17	40.93	1.08	0.79	0.7	0.0	0.2	0.0	1.02	2.85	07/5
08/5	09/5	MANHOLE 1050mm DIA											25	1.0	0			0				1.000	41.853	40.76	40.75	39.94	2.08	0.78	0.4	0.0	0.0	0.0	0.69	4.06	08/5
09/5	10/5	MANHOLE 1050mm DIA											25	1.0	0			0				1.000	41.020	39.91	39.83	39.21	2.20	0.86	0.2	0.0	0.1	0.0	0.45	4.91	09/5
10/5	11/5	MANHOLE 1050mm DIA											25	1.0	0			0				1.000	40.227	39.21	39.19	37.90	7.00	1.19	1.1	0.0	0.4	0.0	0.55	4.2	10/5
11/5	12/5	MANHOLE 1200mm DIA											25	1.0	0			0				1.000	37.900	37.90	37.27	37.26	0.21	1.49	1.1	0.0	0.6	0.0	1.43	3.41	11/5
12/5	01/6	HEADWALL											25	1.0	0			0				1.000	37.645	37.26	37.26	37.26	0.00	1.49	0.0	0.0	0.0	0.0			12/5
01/6	02/6	BASIN NODE FOR CALCULATIONS											60	1.0	66			66				1.000	37.900	37.26											01/6
01/17	02/17	INLET GULLY ON GRADE (LG) Type S Lintel	0.254			90	61.3	0.877	0.830	0.084			60	1.0	107	1.25	0.01	94	10	0.01	01/19	1.000	46.789	45.77	45.74	44.42	10.58	0.09	9.1	0.0	0.0	0.0	0.13	3.48	01/17
02/17	03/17	INLET GULLY ON GRADE (LG) Type S Lintel	0.197			90	61.3	0.877	0.830	0.065			60	1.0	65	0.00	0.00	65	0	0.00	03/17	1.000	45.463	44.42	44.41	41.00	12.70	0.16	2.0	0.0	0.0	0.0	0.19	5.41	02/17
03/17	04/17	DRAINWAYS 1TCS0 ON GRADE	0.111			90	61.3	0.877	0.830	0.037			60	1.0	37	0.00	0.00	37	0	0.00	04/17	1.000	42.101	40.75	40.71	39.44	5.21	0.26	1.4	0.0	0.0	0.0	0.39	4.64	03/17
04/17	10/5	DRAINWAYS 0TCS0 SAG	0.079			90	61.3	0.877	0.830	0.026			60	1.0	28	1.12	0.00	27	1	0.00	01/21	1.000	40.074	39.44	39.33	39.21	0.78	0.34	0.7	0.0	0.1	0.0	0.53	2.98	04/17
01/20	02/20	INLET GULLY ON GRADE (LG) Type S Lintel	0.281			90	61.3	0.877	0.830	0.093			60	2.5	93	1.29	0.01	84	8	0.01	02/20	2.490	43.860	42.86	42.85	41.49	3.50	0.08	7.0	0.0	0.0	0.0	0.19	1.86	01/20
02/20	03/20	INLET GULLY ON GRADE (LG) Type S Lintel	0.200			90	61.3	0.877	0.830	0.066			60	5.5	73	1.23	0.01	64	7	0.01	01/22	5.500	42.308	41.49	41.39	41.23	2.27	0.15	2.0	0.0	0.1	0.0	0.45	2.01	02/20
03/20	04/20	INLET GULLY ON GRADE (LG) Type S Lintel	0.061			90	61.3	0.877	0.830	0.020			60	5.4	20	0.00	0.00	20	0	0.00	01/23	5.434	42.402	41.16	41.16	38.64	5.24	0.17	2.0	0.0	0.0	0.0	0.29	4.17	03/20
04/20	05/20	MANHOLE 1200mm DIA											25	1.0	0			0				1.000	39.202	38.64	38.55	38.42	0.50	0.21	2.0	0.0	0.1	0.0	1.04	1.33	04/20
05/20	11/5	MANHOLE 1050mm DIA											25	1.0	0			0				1.000	38.731	38.43	38.30	37.90	0.75	0.32	1.0	0.0	0.2	0.0	1.87	1.99	05/20
11/5	12/5	MANHOLE 1200mm DIA											25	1.0	0			0				1.000	37.900	37.90											11/5
01/21	02/21	INLET GULLY IN SAG (LS) Type S Lintel	0.291			90	61.3	0.877	0.830	0.096			60	0.6	97	1.47	0.01	85	9	0.01	02/21	0.561	38.583	38.61	38.55	38.49	0.82	0.10	9.7	0.0	0.1	0.0	0.3	1.33	01/21
02/21	05/20	INLET GULLY IN SAG (LS) Type S Lintel	0.092			90	61.3	0.877	0.830	0.030			60	0.7	38	1.19	0.00	51	2	0.00	01/4	0.698	38.482	38.49	38.47	38.42	0.71	0.15	1.6	0.0	0.1	0.0	0.64	1.55	02/21
05/20	11/5	MANHOLE 1050mm DIA											25	1.0	0			0				1.000	38.731	38.43											05/20
01/22	04/20	INLET GULLY ON GRADE (LG) Type S Lintel	0.109			90	61.3	0.877	0.830	0.036			60	7.0	42	1.07	0.00	41	0	0.00	01/21	7.036	39.418	38.69	38.64	38.64	0.03	0.04	9.7	0.0	0.1	0.0	0.07	2.37	01/22
04/20	05/20	MANHOLE 1200mm DIA											25	1.0	0			0				1.000	39.202	38.64											04/20
01/23	04/20	INLET GULLY ON GRADE (LG) Type S Lintel	0.021			90	61.3	0.877	0.830	0.007			60	6.0	7	0.00	0.00	7	0	0.00	02/4	6.030	39.248	38.64	38.64	38.64	-0.06	0.02	4.7	0.0	0.0	0.0	0.04	1.8	01/23
04/20	05/20	MANHOLE 1200mm DIA											25	1.0	0			0				1.000	39.202	38.64											04/20
01/24	02/24	INLET GULLY ON GRADE (LG) Type S Lintel	0.014			90	61.3	0.877	0.830	0.004			60	8.0	5	1.07	0.00	5	0	0.00	02/24	8.000	50.440	49.32	49.32	48.95	7.39	0.00	7.0	0.0	0.0	0.0	0.01	1.62	01/24
02/24	03/24	INLET GULLY ON GRADE (LG) Type S Lintel	0.005			90	61.3	0.877	0.830	0.001			25	8.0	1	0.00	0.00	1	0	0.00	03/24	8.000	50.048	48.93	48.93	48.54	7.94	0.01	1.3	0.0	0.0	0.0	0.01	1.82	02/24
03/24	04/24	INLET GULLY ON GRADE (LG) Type S Lintel	0.004			90	61.3	0.877	0.830	0.001			25	8.0	1	0.00	0.00	1	0	0.00	04/24	8.000	49.656	48.51	48.51	48.19	6.65	0.01	1.0	0.0	0.0	0.0	0.01	1.83	03/24
04/24	10/26	INLET GULLY ON GRADE (LG) Type S Lintel	0.005			90	61.3	0.877	0.830	0.002			60	8.0	2	0.00	0.00	2	0	0.00	03/20	8.000	49.264	48.16	48.16	47.64	5.88	0.01	1.3	0.0	0.0	0.0	0.02	1.84	04/24
10/26	11/26	MANHOLE 1500mm DIA											25	1.0	0			0				1.000	48.730	46.69											10/26
01/25	02/25	INLET GULLY ON GRADE (LG) Type S Lintel	0.174			90	61.3	0.877	0.830	0.057			60	1.5	57	0.00	0.00	57	0	0.00	03/25	1.497	60.599	59.72	59.67	59.46	2.04	0.06	9.7	0.0	0.0	0.0	0.18	1.28	01/25
02/25	03/25	INLET GULLY ON GRADE (LG) Type S Lintel	0.360			90	61.3	0.877	0.830	0.119			60	2.0	119	1.52	0.01	99	18	0.01	01/32	1.951	60.461	59.46	59.46	58.34	2.82	0.16	4.2	0.0	0.0	0.0	0.41	2.67	02/25
03/25	04/25	INLET GULLY ON GRADE (LG) Type S Lintel	0.208			90	61.3	0.877	0.830	0.069			60	3.7	69	1.20	0.00	61	5	0.00	05/25	3.667	59.255	58.34	58.32	57.26	4.14	0.24	1.4	0.0	0.0	0.0	0.52	3.67	03/25
04/25	05/25	MANHOLE 1050mm DIA											25	1.0	0			0				1.000	58.171	57.21	57.21	55.50	6.91	0.24	0.4	0.0	0.0	0.0	0.4	4.95	04/25
05/25	06/25	INLET GULLY ON GRADE (LG) Type S Lintel	0.255			90	61.3	0.877	0.830	0.084			60	8.4	88	1.36	0.01	70	17	0.01	06/25	8.412	56.410	55.49	55.48	53.44	7.57	0.31	1.4	0.0	0.0	0.0	0.45	4.83	05/25
06/25	07/25	INLET GULLY ON GRADE (LG) Type S Lintel	0.101			90	61.3	0.877	0.830	0.033			60	8.6	49	1.11	0.00	46	1	0.00	01/33	8.590	54.091	53.44	53.37	52.78	6.28	0.35	1.0	0.0	0.2	0.0	0.55	3.2	06/25
07/25	08/25	MANHOLE 1200mm DIA											25	1.0	0			0				1.000	53.534	52.78	52.69	52.15	1.93	0.27	1.3	0.0	0.1	0.0	0.71	3.09	07/25
08/25	09/25	INLET GULLY ON GRADE (LG) Type S Lintel	0.112			90	61.3	0.877	0.830	0.037			60	0.6	37	0.00	0.00	37	0	0.00	09/25	0.600	52.548	52.15	52.14	51.55	1.86	0.27	0.7	0.0	0.1	0.0	0.84	2.68	08/25
09/25	10/25	DRAINWAYS 1TCS0 ON GRADE	0.107			90	61.3	0.877	0.830	0.035			60	0.6	35	0.00	0.00	35	0	0.00	01/39	0.600	52.357	51.55	51.21	50.11	3.62	0.34	1.5	0.0	0.3	0.0	0.94	3.28	09/25
10/25	11/25	MANHOLE 1050mm DIA											25	1.0	0			0				1.000	53.000	48.58	48.50	47.27	15.32	0.34	1.6	0.0	0.1	0.0	0.38	5.36	10/25
11/25	12/25	MANHOLE 1050mm DIA											25	1.0	0			0				1.000	48.077	46.23	46.22	45.46	14.70	0.34	1.6	0.0	0.1	0.0	0.38	4.61	11/25
12/25	13/25	MANHOLE 1050mm DIA											25	1.0	0			0				1.000	46.000	45.46	45.46	45.45	0.12	0.36	0.0	0.0	0.0	0.0	0.63	2.58	12/25
13/25	14/25	HEADWALL											25	1.0	0			0				1.000	45.600	45.45	45.45	45.45	0.00	0.36	0.0	0.0	0.0	0.0			13/25
14/25	15/25	BASIN NODE FOR CALCULATIONS			1.016							0.211	60	1.0	211			211				1.000	45.300	45.45	45.45	45.45	0.00	0.29	0.0	0.0	0.0	0.0			14/25
15/25	16/25	MANHOLE C/W ROOF SLAB AND 900x600 DOME TOP											60	1.0	285	0.00	0.00	285	0	0.00	03/55	1.000	45.300	43.13	42.98	42.18	3.98	0.29	9.7	0.0	0.1	0.0	0.26	2.73	15/25
16/25	03/55	HEADWALL											25	1.0	0			0				1.000	42.935	42.05	42.05	39.99	3.00	0.28	0.0	0.0	0.0	0.0	0.01	0.4	16/25
03/55	04/55	100% CAPTURE FOR FUTURE EXTENSION			110.076							9.110	90	1.0	9110			9110				1.000	41.083	39.99											03/55
01/26	02/26	INLET GULLY ON GRADE (LG) Type S Lintel	0.174			90	61.3	0.877	0.830	0.057			60	4.0	57	1.15	0.00	54	3	0.00	02/26	3.953	61.285	60.24	60.24	58.46	6.15	0.05	7.0	0.0	0.0	0.0	0.1	3.01	01/26
02/26	03/26	INLET GULLY ON GRADE (LG) Type S Lintel	0.117			90	61.3	0.877	0.830	0.039			60	7.9	41	1.07	0.00	41	0	0.00	03/26	7.944	59.453	58.43	58.43	54.73	7.85	0.14	1.5	0.0	0.0	0.0	0.22	4.5	02/26
03/26	04/26	INLET GULLY ON GRADE (LG) Type S Lintel	0.173			90	61.3	0.877	0.830	0.057			60	8.0	57	1.19	0.00	51	5	0.00	04/26	8.000	55.688	54.73	54.72	52.66	7.45	0.25	1.3	0.0	0.0	0.0	0.4	4.89	03/26
04/26	05/26	INLET GULLY ON GRADE (LG) Type S Lintel	0.188			90	61.3	0.877	0.830	0.062			60	8.0	67	1.27	0.01	58	9	0.01	05/26	8.000	53.563	52.37	52.36	50.93	5.98	0.31	0.9	0.0	0.0	0.0	0.32	3.47	04/26
05/26	06/26	DRAINWAYS 0TCS0 SAG	0.069			90	61.3	0.877	0.830	0.023			60	0.7	31	0.00	0.00	31	0	0.00	01/40	0.659	52.050	50.93	50.93	50.82	0.75	0.39	0.4	0.0	0.0	0.0	0.42	2.19	05/26
06/26	07/26	MANHOLE 1200mm DIA											25	1.0	0			0				1.000	52.271	50.82	50.80	50.42	0.72	0.40	1.7	0.0	0.0	0.0	0.44	2.17	06/26
07/26	08/26	MANHOLE 1500mm DIA											25	1.0	0			0				1.000	51.902	50.42	50.41	50.08	1.05	0.53	0.4	0.0	0.0	0.0	0.48	2.93	07/26
08/26	09/26	MANHOLE 1500mm DIA											25	1.0	0			0				1.000	51.316	49.98	49.98	49.29	5.12	0.60	0.6	0.0	0.0	0.0	0.24	5.04	08/26
09/26	10/26	MANHOLE 1500mm DIA											25	1.0	0			0				1.000	50.729	49.29	49.28	47.70	6.33	0.78	0.7	0.0	0.0	0.0	0.29	6.16	09/26
10/26	11/26	MANHOLE 1500mm DIA											25	1.0	0			0				1.000	48.730	46.69	46.63	45.45	4.26	0.79	2.1	0.0	0.1	0.0	0.3	5.3	10/26
11/26	12/26	1200 DIA MANHOLE EXTENDED 600mm											25	1.0	0			0				1.000	45.953	45.45	45.45	45.45	0.05	0.79	0.0	0.0	0.0	0.0	0.35	2.41	11/26
12/26	14/25	HEADWALL											25	1.0	0			0				1.000	45.580	45.45	45.45	45.45	0.00	0.79	0.0	0.0	0.0	0.0			12/26
14/25	15/25	BASIN NODE FOR CALCULATIONS			1.016							0.211	60	1.0	211			211				1.000	45.300	45.45											14/25
01/33	09/25	INLET GULLY ON GRADE (LG) Type S Lintel	0.143			90	61.3	0.877	0.830	0.047			60	0.6	48	1.07	0.00	48	0	0.00	01/34	0.600	52.357	51.64	51.60	51.55	0.77	0.05	9.7	0.0	0.1	0.0	0.14	1.31	01/33
09/25	10/25	DRAINWAYS 1TCS0 ON GRADE	0.107			90	61.3	0.877	0.830	0.035			60	0.6	35	0.00	0.00	35	0	0.00	01/39	0.600	52.357	51.55											09/25
01/34	05/26	INLET GULLY IN SAG (LS) Type S Lintel	0.165			90	61.3	0.877	0.830	0.054			60	0.7	61	1.15	0.00	59	0	0.00	05/26	0.659	52.050	51.17	51.17	50.93	3.61	0.06	9.7	0.0	0.0	0.0	0.13	1.73	01/34
05/26	06/26	DRAINWAYS 0TCS0 SAG	0.069			90	61.3	0.877	0.830	0.023			60	0.7	31	0.00	0.00	31	0	0.00	01/40	0.659	52.050	50.93											05/26
01/35	03/26	INLET GULLY ON GRADE (LG) Type S Lintel	0.206			90	61.3	0.877	0.830	0.068			60	8.0	69	1.24	0.01	59	7	0.01	01/34	8.000	55.729	54.98	54.87	54.73	2.09	0.06	9.7	0.0	0.1	0.0	0.19	1.36	01/35
03/26	04/26	INLET GULLY ON GRADE (LG) Type S Lintel	0.173			90	61.3	0.877	0.830	0.057			60	8.0	57	1.19	0.00	51	5	0.00	04/26	8.000	55.688	54.73											03/26
01/36	02/26	INLET GULLY ON GRADE (LG) Type S Lintel	0.141			90	61.3	0.877	0.830	0.047			60	7.1	47	1.09	0.00	44	2	0.00	01/35	7.090	60.022	58.99	58.97	58.45	5.28	0.04	9.7	0.0	0.0	0.0	0.09	2.27	01/36
02/26	03/26	INLET GULLY ON GRADE (LG) Type S Lintel	0.117			90	61.3	0.877	0.830	0.039			60	7.9	41	1.07	0.00	41	0	0.00	03/26	7.944	59.453	58.43											02/26
01/37	08/26	INLET GULLY IN SAG (LS) Type S Lintel	0.099			90	61.3	0.877	0.830	0.033			60	1.0	34	1.07	0.00	34	0	0.00	01/24	1.039	51.271	50.26	50.23	49.98	7.74	0.03	9.7	0.0	0.0	0.0	0.05	2.32	01/37
08/26	09/26	MANHOLE 1500mm DIA											25	1.0	0			0				1.000	51.316	49.98											08/26
01/38	08/26	INLET GULLY IN SAG (LS) Type S Lintel	0.124			90	61.3	0.877	0.830	0.041			60	0.9	41	1.07	0.00	41	0	0.00	01/37	0.907	51.456	50.42	50.38	50.14	3.91	0.04	9.7	0.0	0.0	0.0	0.09	1.76	01/38
08/26	09/26	MANHOLE 1500mm DIA											25	1.0	0			0				1.000	51.316	49.98											08/26
01/39	07/26	INLET GULLY ON GRADE (LG) Type S Lintel	0.256			90	61.3	0.877	0.830	0.084			60	1.2	84	1.22	0.00	79	2	0.00	01/37	1.226	51.882	51.19	50.97	50.86	4.53	0.08	9.2	0.0	0.2	0.0	0.25	1.15	01/39
07/26	08/26	MANHOLE 1500mm DIA											25	1.0	0			0				1.000	51.902	50.42											07/26
01/40	07/26	INLET GULLY ON GRADE (LG) Type S Lintel	0.174			90	61.3	0.877	0.830	0.057			60	1.4	57	0.00	0.00	57	0	0.00	01/38	1.358	51.855	51.06	50.94	50.83	2.12	0.06	9.7	0.0	0.1	0.0	0.18	1.29	01/40
07/26	08/26	MANHOLE 1500mm DIA											25	1.0	0			0				1.000	51.902	50.42											07/26
01/41	02/41	INLET GULLY ON GRADE (LG) Type S Lintel	0.239			90	61.3	0.877	0.830	0.079			60	5.6	79	1.31	0.01	67	11	0.01	03/41	5.609	54.809	53.76	53.76	51.70	5.71	0.07	7.0	0.0	0.0	0.0	0.12	2.47	01/41
02/41	03/41	INLET GULLY ON GRADE (LG) Type S Lintel	0.314			90	61.3	0.877	0.830	0.103			60	6.6	103	1.45	0.02	78	24	0.02	01/17	6.586	52.611	51.70	51.65	51.19	5.97	0.15	2.9	0.0	0.1	0.0	0.27	3.23	02/41
03/41	09/26	INLET GULLY ON GRADE (LG) Type S Lintel	0.103			90	61.3	0.877	0.830	0.034			60	7.0	44	1.07	0.00	43	0	0.00	01/38	7.008	52.324	51.19	51.17	49.65	6.82	0.19	1.8	0.0	0.0	0.0	0.33	4.3	03/41
01/55	02/55	INLET HEADWALL											25	1.0	0			0				1.000	45.435	45.45	45.33	42.19	12.56	0.95	0.5	0.0	0.1	0.0	0.27	3.04	01/55

C

INTENSITY - FREQUENCY - DURATION (IFD) TABLE

DURATION MINUTES	ARI INTENSITY (YEAR) TREAT	1	2	5	10	20	50	100
5	62.5	125	158	193	212	239	275	301
6	58.5	117	148	181	199	225	258	284
10	48	96	122	149	164	186	214	235
20	35.2	70.4	89.3	110	122	138	159	175
30	28.7	57.4	72.9	90.1	99.8	113	131	144
60	19.45	38.9	49.5	61.7	68.6	78.1	90.6	100
120	12.6	25.2	32.2	40.5	45.3	51.8	60.3	66.8
180	9.6	19.2	24.7	31.2	35	40.2	46.9	52.1
360	6.05	12.1	15.6	20	22.5	26	30.5	34
720	3.89	7.78	10.1	13	14.8	17.1	20.3	22.7
1440	2.595	5.19	6.73	8.8	10.1	11.7	13.9	15.6
2880	1.74	3.48	4.53	5.98	6.87	8.04	9.59	10.8
4320	1.325	2.65	3.46	4.61	5.3	6.23	7.45	8.42

DERIVED FROM BUREAU OF METEOROLOGY


NOTES:

1. THESE CALCULATIONS ARE BASED ON IISAX2 DYNAMIC DRAINAGE ANALYSIS USING 12D SOFTWARE ANALYSIS.
2. INDIVIDUAL TIMES OF CONCENTRATION ARE GENERATED FOR EACH NODE & CATCHMENT TYPE USING TEMPORAL PATTERNS DETERMINED FROM THE RELEVANT AUTHORITY.
3. "TREAT" IN THE IFD TABLE REFERS TO 0.5x1 YEAR ARI, USED TO DETERMINE WATER QUALITY TREATMENT FLOWS.
4. CATCHMENT 1 REFERS TO TYPICAL URBANISED CATCHMENTS WITH LOTS <1000m2. THE IMPERVIOUS PORTION OF THE CATCHMENT TIME OF CONCENTRATION (TC) IS TYPICALLY 5 MINUTES & THE PERVIOUS PORTION OF THE CATCHMENT TYPICALLY HAS AN 8 MINUTE TC.
5. CATCHMENT 2 IS TYPICALLY USED TO MODEL LOTS >1000m2, WITH INDIVIDUAL PERCENTAGES OF IMPERVIOUS SURFACE & TC'S.
6. CATCHMENT 3 IS TYPICALLY USED TO MODEL OPEN SPACE & RURAL CATCHMENTS WITH INDIVIDUAL PERCENTAGES OF IMPERVIOUS SURFACE & TC'S.

FLOW CAPACITY m3/s 7.5m RD (KERB AND CHANNEL)

	KR	LANE	1/2 RD	1 WAY	2 WAY
MAX. WIDTH	**1.0**	**2.5**	**3.75**	**11.175**	**14.8**
MAX. AREA m2	**0.021**	**0.101**	**0.219**	**1.421**	**2.104**
Rd Grade %					
0.5	0.032	0.092	0.209	1.938	3.070
1	0.046	0.130	0.296	2.054	2.950
2	0.064	0.184	0.418	2.150	2.920
3	0.079	0.225	0.512	1.886	2.780
4	0.091	0.260	0.591	1.711	2.650
5	0.102	0.291	0.661	1.600	2.510
6	0.112	0.318	0.724	1.505	2.390
7	0.120	0.344	0.782	1.407	2.300
8	0.129	0.368	0.836	1.345	2.230
9	0.137	0.390	0.887	1.285	2.170
10	0.144	0.411	0.935	1.220	2.110
11	0.151	0.431	0.981	1.180	2.110
12	0.158	0.450	1.024	1.154	2.110
13	0.164	0.469	1.066	1.133	2.090
14	0.170	0.486	1.106	1.105	2.060
15	0.176	0.503	1.101	1.101	2.060
16	0.182	0.520	1.093	1.093	2.030

NOTES:
FLOW CONSTRAINED TO 0.4 DxV
FLOW CONSTRAINED TO 250mm DEEP MAX.
CAPACITY COMPOUND CROSS SECTION (ARR 1987 , 4.38) (n varies)

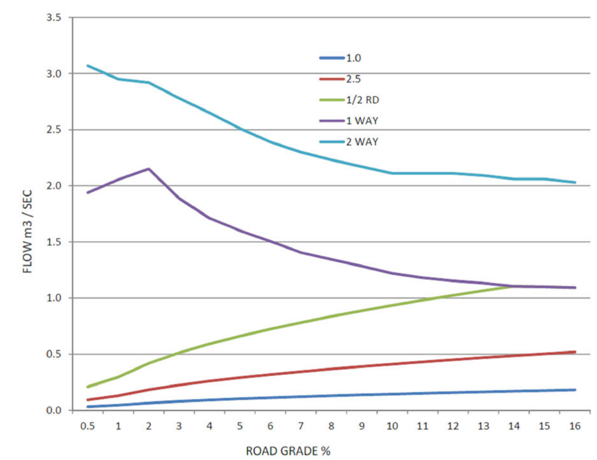

PROJECT NAME

COURTNEY DR UPPER COOMERA

STAGE 02

RP DESCRIPTION

LOT 188, 189, 190, 191 & 192 ON RP173728
COURTNEY DRIVE
LOCALITY OF UPPER COOMERA
LOCAL AUTHORITY - GOLD COAST CITY COUNCIL

CLIENT

HB Land

REV	DATE	DESCRIPTION	INT
C	19-06-24	CALC TABLE AMENDED	RK
B	17-01-24	CALC TABLE AMENDED	EP
A	13-10-23	COUNCIL ISSUE	EP

COPYRIGHT IS VESTED IN MORTONS-URBAN SOLUTIONS AND WRITTEN CONSENT IS REQUIRED PRIOR TO REPRODUCTION. DO NOT SCALE FROM THIS DRAWING.

ASSOCIATED CONSULTANTS

BIOME WATER AND ENVIRONMENTAL CONSULTING
Robin Russell & ASSOCIATES PTY. LTD.
BENNETT+BENNETT

DRAWING TITLE

STORMWATER
CALCULATION TABLES
MINOR
STORM EVENT
SHEET 01

MORTONS urbansolutions
Urban & Regional Planning
Civil Engineering
Project Coordination
MUS Pty Ltd T/As:
Mortons-Urban Solutions
ABN: 39 116 375 065
mortons@urbansolutions.net.au
www.urbansolutions.net.au
Tel 07 5571 1099
Postal Address
PO Box 2484
Southport QLD 4215
Gold Coast Office
Suite 9, 19 Short St
Southport QLD 4215

DESIGNED RB	DRAWN EP
APPROVED W.K. Morton RPEQ 4706	DATE 13-10-23
DRAWING NUMBER 41901-02-680	REV C

F:\Autocad Client\419 - HB Land\01 - Courtney Drive\Precinct-Stage 02\Engineering Drawings\Current\41901-02-680.dwg, MINOR CALC TABLE SHET 01, 21/06/2024 1:33:46 PM, 1:2

CALCULATION TABLES-MINOR 2YR ARI

0.5 ARI (Q2) MINOR FLOW - 12D DYNAMIC DRAINAGE RESULTS — * REFER TO IFD TABLE FOR MAXIMUM INTENSITY DURING STORM

NOTE: NEGATIVE FLOW VALUES INDICATE REVERSE FLOWS

NODE				CATCHMENT AREA			RAINFALL VOLUME*		RAINFALL Coef.		CATCHMENT FLOW					APPROACH FLOW				FLOW AT PIT						PIT			HGL			PIPE		HEADLOSSES							
FROM:	TO:	NODE TYPE	A.1	A.2	A.3	CRITICAL	INTENSITY		CURRENT	A.1	A.2	A.3	CRITICAL	GRADE		FLOW			CAPTURED		BYPASS		GRADE	GRATE	P/T	PIPE		GRADE	FLOW	COEFFICIENT		HEADLOSS		CAPACITY	VELOCITY	NODE
			HA	HA	HA	STORM	MM/HR	10 YR	Storm	HA	HA	HA	ARI MIN.	%	L/S	WIDTH	DxV	L/S	L/S	DxV	NODE	%	RL	RL	U/S RL	D/S RL	%	M3/S	Ku	Kw	Ku	Kw	RATIO	M/S	
02/55	03/55	HEADWALL											25	1.0	0			0				1.000	42.935	42.09	42.09	39.99	3.01	0.95	0.0	0.0	0.0	0.0	0.01	0.41	02/55
03/55	04/55	100% CAPTURE FOR FUTURE EXTENSION			110.076							9.110	90	1.0	9110			9110				1.000	41.083	39.99	39.99	37.63	1.90	9.70	0.0	0.0	0.0	0.0	0.08	1.88	03/55
04/55	05/55	100% CAPTURE FOR FUTURE EXTENSION											25	1.0	0			0				1.000	39.250	37.60	37.60	35.19	1.78	9.70	0.0	0.0	0.0	0.0	0.07	0.83	04/55
05/55	06/55	BASIN NODE FOR CALCULATIONS			20.019							4.638	90	1.0	4638			4638				1.000	36.200	35.19	35.19	35.19	0.00	10.41	0.0	0.0	0.0	0.0			05/55
06/55	07/55	INLET HEADWALL											25	1.0	0			0				1.000	37.110	35.19	35.13	33.71	3.94	10.41	0.4	0.0	0.1	0.0	0.07	2.27	06/55
07/55	08/55	HEADWALL											25	1.0	0			0				1.000	36.310	33.71	33.71	33.34	1.06	10.42	0.0	0.0	0.0	0.0	0.32	1.76	07/55
08/55	09/55	100% CAPTURE FOR FUTURE EXTENSION											25	1.0	0			0				1.000	34.000	33.29	33.29	33.24	0.26	11.44	0.0	0.0	0.0	0.0	0.18	2.45	08/55
09/55		REFERENCE											25	1.0	0			0				1.000	34.000	33.24											09/55
01/58	02/58	MANHOLE C/W ROOF SLAB AND 900x600 DOME TOP											60	1.0	285	0.00	0.00	285	0	0.00	03/55	1.000	45.300	44.00	43.65	43.47	2.20	0.32	5.5	0.0	0.3	0.0	0.4	1.96	01/58
02/58	03/58	MANHOLE C/W ROOF SLAB AND 900x600 DOME TOP											25	1.0	0	0.00	0.00	0	0	0.00	03/55	1.000	45.600	43.36	43.36	42.38	4.59	0.31	0.0	0.0	0.0	0.0	0.19	4.15	02/58
03/58	03/55	HEADWALL											25	1.0	0			0				1.000	42.865	42.24	42.24	39.99	7.56	0.31	0.0	0.0	0.0	0.0	0.01	0.46	03/58
03/55	04/55	100% CAPTURE FOR FUTURE EXTENSION			110.076							9.110	90	1.0	9110			9110				1.000	41.083	39.99											03/55
01/63	02/63	INLET HEADWALL			0.133							0.028	60	1.0	28			28				1.000	46.488	45.97	45.97	45.38	5.60	0.03	0.0	0.0	0.0	0.0	0.35	2.27	01/63
02/63	01/2	HEADWALL											25	1.0	0			0				1.000	45.929	45.34	45.34	44.39	9.64	0.03	0.0	0.0	0.0	0.0	0.01	1.75	02/63
01/2	02/2	TYPE 2 FIELD INLET 900x600 C/W DOME TOP			0.141			0.877				0.029	60	1.0	29	1.32	0.01	14	15	0.01	02/2	1.000	44.376	43.16											01/2

B

PLANS AND DOCUMENTS referred to in the DEVELOPMENT APPROVAL

Application No: MIN/2024/337

Dated: 16 July 2024

Development shall comply with the conditions of approval as detailed in the Decision Notice and Council's Planning Scheme, Local Laws and Planning Policies

PROJECT NAME

COURTNEY DR UPPER COOMERA

STAGE 02

RP DESCRIPTION

LOT 188, 189, 190, 191 & 192 ON RP173728
COURTNEY DRIVE
LOCALITY OF UPPER COOMERA
LOCAL AUTHORITY - GOLD COAST CITY COUNCIL

CLIENT

HB Land

REV	DATE	DESCRIPTION	INT
B	19-06-24	CALC TABLE AMENDED	RK
A	19-01-24	COUNCIL ISSUE	EP

COPYRIGHT IS VESTED IN MORTONS-URBAN SOLUTIONS AND WRITTEN CONSENT IS REQUIRED PRIOR TO REPRODUCTION.
DO NOT SCALE FROM THIS DRAWING.

ASSOCIATED CONSULTANTS

BIOME WATER AND ENVIRONMENTAL CONSULTING
Robin Russell & ASSOCIATES PTY. LTD.
BENNETT+BENNETT

DRAWING TITLE

STORMWATER
CALCULATION TABLES
MINOR
STORM EVENT
SHEET 02

MORTONS urbansolutions
Urban & Regional Planning
Civil Engineering
Project Coordination
MUS Pty Ltd T/As:
Mortons-Urban Solutions
ABN: 39 116 375 065
mortons@urbansolutions.net.au
www.urbansolutions.net.au
Tel 07 5571 1099
Postal Address
PO Box 2484
Southport QLD 4215
Gold Coast Office
Suite 9, 19 Short St
Southport QLD 4215

DESIGNED RB | DRAWN EP
APPROVED RPEQ 4706 | DATE 13-10-23

DRAWING NUMBER 41901-02-680A | REV B

F:\Autocad Client\419 - HB Land\01 - Courtney Drive\Precinct-Stage 02\Engineering Drawings\Current\41901-02-680.dwg, MINOR CALC TABLE SHEET 02, 21/06/2024 1:34:22 PM, 1:2

CALCULATION TABLES-MAJOR 100YR ARI

0.01 ARI (Q100) Major FLOW - 12D DYNAMIC DRAINAGE RESULTS						* REFER TO IFD TABLE FOR MAXIMUM INTENSITY DURING STORM																													
NOTE:	NEGATIVE FLOW VALUES INDICATE REVERSE FLOWS			CATCHMENT AREA		RAINFALL VOLUME*		RAINFALL Coef.		CATCHMENT FLOW					APPROACH FLOW				FLOW AT PIT				PIT		HGL			PIPE	HEADLOSSES						
NODE			A.1	A.2	A.3	CRITICAL	INTENSITY		CURRENT	A.1	A.2	A.3	CRITICAL	GRADE		FLOW		CAPTURED		BYPASS		GRADE	GRATE	PIT	PIPE		GRADE	FLOW	COEFFICIENT		HEADLOSS		CAPACITY	VELOCITY	NODE
FROM:	TO:	NODE TYPE	HA	HA	HA	STORM	MM/HR	10 YR	Storm	HA	HA	HA	ARI MIN.	%	L/S	WIDTH	DxV	L/S	L/S	DxV	NODE	%	RL.	RL	U/S RL.	D/S RL.	%	M3/S	Ku	Kw	Ku	Kw	RATIO	M/S	
01/2	02/2	TYPE 2 FIELD INLET 900x600 C/W DOME TOP			0.141			0.877				0.063	25	1.0	63	1.58	0.03	18	45	0.03	02/2	1.000	44.376	43.18	43.18	39.94	10.31	0.08	1.3	0.0	0.0	0.0	0.11	3.59	01/2
02/2	03/2	INLET GULLY ON GRADE (LG) Type S Lintel	0.021		0.144	120	133.6	0.877	0.916	0.012		0.064	25	9.7	118	1.61	0.03	79	38	0.02	03/2	9.683	41.196	39.94	39.93	37.55	7.84	0.16	2.3	0.0	0.0	0.0	0.24	4.07	02/2
03/2	04/2	DRAINWAYS 1TCS0 ON GRADE	0.029		0.432	120	133.6		0.916	0.016		0.193	25	5.8	244	2.89	0.06	132	111	0.06	02/4	5.792	38.890	37.55	37.54	34.95	15.11	0.29	1.8	0.0	0.0	0.0	0.32	6.23	03/2
04/2	05/2	MANHOLE 1050mm DIA											25	1.0	0			0				1.000	36.333	33.90	33.61	33.58	0.57	0.30	2.0	0.0	0.3	0.0	1.2	1.93	04/2
05/2	08/55	HEADWALL											25	1.0	0			0				1.000	34.228	33.56	33.56	33.56	0.00	0.57	0.0	0.0	0.0	0.0	0.01	0.96	05/2
08/55	09/55	100% CAPTURE FOR FUTURE EXTENSION											25	1.0	0			0				1.000	34.000	33.56											08/55
01/3	02/3	INLET HEADWALL			0.174							0.078	25	1.0	78			78				1.000	38.228	37.90	37.88	37.40	8.00	0.08	0.5	0.0	0.0	0.0	0.15	1.4	01/3
02/3	05/55	HEADWALL											25	1.0	0			0				1.000	37.930	37.30	37.30	37.30	0.00	0.08	0.0	0.0	0.0	0.0			02/3
05/55	06/55	BASIN NODE FOR CALCULATIONS			20.019							9.478	25	1.0	9478			9478				1.000	36.200	36.34											05/55
01/4	02/4	INLET GULLY IN SAG (LS) Type S Lintel	0.112			120	133.6	0.877	0.916	0.062			60	0.2	554	4.38	0.14	174	376	0.16	O 01/4	0.174	37.669	37.47	37.25	37.10	2.36	0.17	4.0	0.0	0.3	0.0	0.54	1.9	01/4
02/4	03/4	INLET GULLY IN SAG (LS) Type S Lintel	0.071		0.048	120	133.6	0.877	0.916	0.039		0.021	25	0.2	162	2.92	0.03	103	57	0.04	O 02/4	0.174	37.669	37.10	36.89	36.71	4.09	0.27	1.4	0.0	0.3	0.0	0.31	4.85	02/4
03/4	04/4	MANHOLE 1050mm DIA											25	1.0	0			0				1.000	37.730	36.71	36.50	36.34	3.86	0.27	1.5	0.0	0.2	0.0	0.47	2.57	03/4
04/4	05/55	HEADWALL											25	1.0	0			0				1.000	36.446	36.34	36.34	36.34	0.00	0.27	0.0	0.0	0.0	0.0			04/4
05/55	06/55	BASIN NODE FOR CALCULATIONS			20.019							9.478	25	1.0	9478			9478				1.000	36.200	36.34											05/55
01/5	02/5	INLET GULLY ON GRADE (LG) Type S Lintel	0.222			120	133.6	0.877	0.916	0.124			25	1.0	124	2.47	0.01	98	24	0.02	02/5	1.000	53.037	52.29	52.20	51.87	1.29	0.10	8.8	0.0	0.1	0.0	0.38	1.4	01/5
02/5	03/5	INLET GULLY ON GRADE (LG) Type S Lintel	0.101			120	133.6	0.877	0.916	0.056			25	1.0	80	1.36	0.01	71	8	0.01	03/5	1.000	52.886	51.87	51.83	51.38	1.54	0.17	2.0	0.0	0.0	0.0	0.62	2.15	02/5
03/5	04/5	INLET GULLY ON GRADE (LG) Type S Lintel	0.205			120	133.6	0.877	0.916	0.114			25	1.0	118	1.45	0.02	95	23	0.02	04/5	1.000	52.252	51.29	51.29	47.91	6.57	0.26	1.9	0.0	0.0	0.0	0.41	4.6	03/5
04/5	05/5	INLET GULLY ON GRADE (LG) Type S Lintel	0.207			120	133.6	0.877	0.916	0.115			25	1.0	137	1.50	0.02	106	31	0.02	01/11	1.000	48.247	47.91	47.74	47.06	6.17	0.56	1.1	0.0	0.3	0.0	0.48	5.54	04/5
05/5	06/5	MANHOLE 1050mm DIA											25	1.0	0			0				1.000	47.204	47.06	46.95	43.17	9.01	0.89	1.0	0.0	0.2	0.0	0.81	6.52	05/5
06/5	07/5	MANHOLE 1200mm DIA											25	1.0	0			0				1.000	42.982	43.17	42.73	42.05	4.70	0.97	1.5	0.0	0.4	0.0	0.61	3.42	06/5
07/5	08/5	MANHOLE 1200mm DIA											25	1.0	0			0				1.000	41.996	42.05	41.74	41.32	1.85	0.98	0.9	0.0	0.3	0.0	1.27	3.45	07/5
08/5	09/5	MANHOLE 1050mm DIA											25	1.0	0			0				1.000	41.853	41.32	41.30	40.62	1.75	0.94	0.4	0.0	0.1	0.0	0.83	4.05	08/5
09/5	10/5	MANHOLE 1050mm DIA											25	1.0	0			0				1.000	41.020	40.62	40.45	39.99	1.65	1.04	0.2	0.0	0.2	0.0	0.55	4.8	09/5
10/5	11/5	MANHOLE 1050mm DIA											25	1.0	0			0				1.000	40.227	39.99	39.72	38.29	7.69	1.41	1.1	0.0	0.5	0.0	0.65	4.97	10/5
11/5	12/5	MANHOLE 1200mm DIA											25	1.0	0			0				1.000	37.900	38.30	37.61	37.54	1.52	1.74	1.0	0.0	0.8	0.0	1.67	3.94	11/5
12/5	01/6	HEADWALL											25	1.0	0			0				1.000	37.645	37.54	37.54	37.54	0.00	1.74	0.0	0.0	0.0	0.0			[illegible]
01/6	02/6	BASIN NODE FOR CALCULATIONS											25	1.0	141			141				1.000	37.900	37.54	37.54	37.54	0.00	0.68	0.0	0.0	0.0	0.0			[illegible]
01/17	02/17	INLET GULLY ON GRADE (LG) Type S Lintel	0.254			120	133.6	0.877	0.916	0.142			25	1.0	213	1.74	0.05	142	69	0.05	01/19	1.000	46.789	45.81	45.76	44.44	10.62	0.14	6.7	0.0	0.0	0.0	0.19	3.66	[illegible]
02/17	03/17	INLET GULLY ON GRADE (LG) Type S Lintel	0.197			120	133.6	0.877	0.916	0.110			25	1.0	110	1.36	0.02	90	20	0.02	03/17	1.000	45.463	44.44	44.44	41.89	9.47	0.23	1.9	0.0	0.0	0.0	0.28	5.7	[illegible]
03/17	04/17	DRAINWAYS 1TCS0 ON GRADE	0.111			120	133.6	0.877	0.916	0.062			25	1.0	81	1.25	0.01	72	8	0.00	04/17	1.000	42.101	41.89	41.71	40.23	6.07	0.42	1.3	0.0	0.5	0.0	0.64	4.68	[illegible]
04/17	10/5	DRAINWAYS 0TCS0 SAG	0.079			120	133.6	0.877	0.916	0.044			25	1.0	180	3.48	0.13	-168	315	0.12	01/21	1.000	40.074	40.23	40.15	39.99	1.03	0.41	1.0	0.0	0.2	0.0	0.63	2.97	[illegible]
10/5	11/5	MANHOLE 1050mm DIA											25	1.0	0			0				1.000	40.227	39.99											[illegible]
01/20	02/20	INLET GULLY ON GRADE (LG) Type S Lintel	0.281			120	133.6	0.877	0.916	0.156			25	2.5	156	1.80	0.03	110	46	0.03	02/20	2.490	43.860	42.87	42.86	41.69	3.02	0.11	7.0	0.0	0.0	0.0	0.24	1.86	[illegible]
02/20	03/20	INLET GULLY ON GRADE (LG) Type S Lintel	0.200			120	133.6	0.877	0.916	0.111			25	5.5	156	1.76	0.04	101	54	0.04	01/22	5.500	42.308	41.69	41.46	41.27	2.66	0.21	2.0	0.0	0.2	0.0	0.65	2.23	[illegible]
03/20	04/20	INLET GULLY ON GRADE (LG) Type S Lintel	0.061			120	133.6	0.877	0.916	0.034			25	5.4	34	0.00	0.00	34	0	0.00	01/23	5.434	42.402	41.22	41.19	39.18	4.18	0.24	1.9	0.0	0.0	0.0	0.42	4.23	[illegible]
04/20	05/20	MANHOLE 1200mm DIA											25	1.0	0			0				1.000	39.202	39.18	38.91	38.68	0.92	0.33	1.5	0.0	0.3	0.0	1.62	2.07	[illegible]
05/20	11/5	MANHOLE 1050mm DIA											25	1.0	0			0				1.000	38.731	38.68	38.64	38.29	0.65	0.34	1.0	0.0	0.1	0.0	1.99	2.11	[illegible]
11/5	12/5	MANHOLE 1200mm DIA											25	1.0	0			0				1.000	37.900	38.30											[illegible]
01/21	02/21	INLET GULLY IN SAG (LS) Type S Lintel	0.291			120	133.6	0.877	0.916	0.162			60	0.6	490	3.90	0.15	96	395	0.15	02/21	0.561	38.583	38.77	38.72	38.69	0.47	0.09	9.7	0.0	0.1	0.0	0.28	1.35	[illegible]
02/21	05/20	INLET GULLY IN SAG (LS) Type S Lintel	0.092			120	133.6	0.877	0.916	0.051			60	0.7	438	4.57	0.18	-113	506	0.19	01/4	0.698	38.482	38.69	38.69	38.68	0.03	0.13	3.9	0.0	0.1	0.0	0.59	1.46	[illegible]
05/20	11/5	MANHOLE 1050mm DIA											25	1.0	0			0				1.000	38.731	38.68											[illegible]
01/22	04/20	INLET GULLY ON GRADE (LG) Type S Lintel	0.109			120	133.6	0.877	0.916	0.061			25	7.0	114	1.67	0.03	77	36	0.02	01/21	7.036	39.418	39.26	39.19	39.18	0.12	0.08	9.7	0.0	0.1	0.0	0.12	2.41	[illegible]
04/20	05/20	MANHOLE 1200mm DIA											25	1.0	0			0				1.000	39.202	39.18											[illegible]
01/23	04/20	INLET GULLY ON GRADE (LG) Type S Lintel	0.021			120	133.6	0.877	0.916	0.012			25	6.0	12	0.00	0.00	12	0	0.00	02/4	6.030	39.248	39.18	39.18	39.18	0.06	-0.04	6.7	0.0	0.0	0.0	-0.07	1.37	[illegible]
04/20	05/20	MANHOLE 1200mm DIA											25	1.0	0			0				1.000	39.202	39.18											[illegible]
01/24	02/24	INLET GULLY ON GRADE (LG) Type S Lintel	0.014			120	133.6	0.877	0.916	0.008			25	8.0	86	1.43	0.02	64	22	0.02	02/24	8.000	50.440	49.43	49.38	49.01	7.57	0.06	7.0	0.0	0.0	0.0	0.1	2.51	[illegible]
02/24	03/24	INLET GULLY ON GRADE (LG) Type S Lintel	0.005			120	133.6	0.877	0.916	0.003			25	8.0	24	0.00	0.00	24	0	0.00	03/24	8.000	50.048	49.01	49.00	48.61	8.10	0.09	1.4	0.0	0.0	0.0	0.14	3.61	02/24
03/24	04/24	INLET GULLY ON GRADE (LG) Type S Lintel	0.004			120	133.6	0.877	0.916	0.002			25	8.0	2	0.00	0.00	2	0	0.00	04/24	8.000	49.656	48.59	48.59	48.26	6.73	0.09	0.4	0.0	0.0	0.0	0.15	3.74	03/24
04/24	10/26	INLET GULLY ON GRADE (LG) Type S Lintel	0.005			120	133.6	0.877	0.916	0.003			25	8.0	3	0.00	0.00	3	0	0.00	03/20	8.000	49.264	48.24	48.24	47.71	5.95	0.09	0.7	0.0	0.0	0.0	0.17	3.57	04/24
10/26	11/26	MANHOLE 1500mm DIA											25	1.0	0			0				1.000	48.730	47.39											10/26
01/25	02/25	INLET GULLY ON GRADE (LG) Type S Lintel	0.174			120	133.6	0.877	0.916	0.097			25	1.5	97	1.45	0.01	82	14	0.01	03/25	1.497	60.599	59.86	59.74	59.54	2.03	0.08	9.6	0.0	0.1	0.0	0.25	1.28	01/25
02/25	03/25	INLET GULLY ON GRADE (LG) Type S Lintel	0.360			120	133.6	0.877	0.916	0.200			25	2.0	200	2.21	0.05	127	72	0.05	01/32	1.951	60.461	59.54	59.46	58.63	2.08	0.21	2.6	0.0	0.1	0.0	0.54	2.62	02/25
03/25	04/25	INLET GULLY ON GRADE (LG) Type S Lintel	0.208			120	133.6	0.877	0.916	0.116			25	3.7	128	1.67	0.03	89	38	0.03	05/25	3.667	59.255	58.64	58.51	57.32	4.64	0.36	1.2	0.0	0.1	0.0	0.78	3.74	03/25
04/25	05/25	MANHOLE 1050mm DIA											25	1.0	0			0				1.000	58.171	57.27	57.24	56.04	4.88	0.36	0.4	0.0	0.0	0.0	0.6	4.97	04/25
05/25	06/25	INLET GULLY ON GRADE (LG) Type S Lintel	0.255			120	133.6	0.877	0.916	0.142			25	8.4	177	1.85	0.05	102	75	0.04	06/25	8.412	56.410	56.04	55.80	54.22	5.86	0.46	0.9	0.0	0.4	0.0	0.67	4.78	05/25
06/25	07/25	INLET GULLY ON GRADE (LG) Type S Lintel	0.101			120	133.6	0.877	0.916	0.056			25	8.6	130	3.21	0.11	-112	240	0.11	01/33	8.590	54.091	54.22	54.19	53.51	7.14	0.41	0.9	0.0	0.2	0.0	0.63	3.67	06/25
07/25	08/25	MANHOLE 1200mm DIA											25	1.0	0			0				1.000	53.534	53.52	53.51	52.75	2.71	0.27	1.7	0.0	0.2	0.0	0.71	3.07	07/25
08/25	09/25	INLET GULLY ON GRADE (LG) Type S Lintel	0.112			120	133.6	0.877	0.916	0.062			25	0.6	143	4.60	0.09	-104	243	0.11	09/25	0.600	52.548	52.75	52.61	52.40	0.64	0.27	1.8	0.0	0.2	0.0	0.84	2.68	08/25
09/25	10/25	DRAINWAYS 1TCS0 ON GRADE	0.107			120	133.6	0.877	0.916	0.060			25	0.6	295	3.33	0.04	194	87	0.05	01/39	0.600	52.357	52.50	51.67	50.19	4.87	0.43	1.5	0.0	0.7	0.0	1.2	3.92	09/25
10/25	11/25	MANHOLE 1050mm DIA											25	1.0	0			0				1.000	53.000	48.84	48.58	47.29	16.00	0.43	1.5	0.0	0.3	0.0	0.49	5.39	10/25
11/25	12/25	MANHOLE 1050mm DIA											25	1.0	0			0				1.000	48.077	47.11	46.62	45.76	16.48	0.43	1.5	0.0	0.5	0.0	0.49	4.75	11/25
12/25	13/25	MANHOLE 1050mm DIA											25	1.0	0			0				1.000	46.000	45.76	45.76	45.75	0.29	0.43	0.2	0.0	0.0	0.0	0.76	2.59	12/25
13/25	14/25	HEADWALL											25	1.0	0			0				1.000	45.600	45.75	45.75	45.75	0.00	0.43	0.0	0.0	0.0	0.0			13/25
14/25	15/25	BASIN NODE FOR CALCULATIONS			1.016							0.455	25	1.0	455			455				1.000	45.300	45.75	45.75	45.75	0.00	0.73	0.0	0.0	0.0	0.0			14/25
15/25	16/25	MANHOLE C/W ROOF SLAB AND 900x600 DOME TOP											60	1.0	728	0.00	0.00	728	0	0.00	03/55	1.000	45.300	43.98	43.21	42.31	4.49	0.73	2.9	0.0	0.8	0.0	0.65	3.95	15/25
16/25	03/55	HEADWALL											25	1.0	0			0				1.000	42.935	42.09	42.09	40.28	2.62	0.73	0.0	0.0	0.0	0.0	0.03	0.57	16/25
03/55	04/55	100% CAPTURE FOR FUTURE EXTENSION			110.076							24.596	90	1.0	24596			24596				1.000	41.083	40.28											03/55
01/26	02/26	INLET GULLY ON GRADE (LG) Type S Lintel	0.174			120	133.6	0.877	0.916	0.097			25	4.0	97	1.48	0.02	73	23	0.02	02/26	3.953	61.285	60.26	60.25	58.47	6.16	0.07	7.0	0.0	0.0	0.0	0.13	3.17	01/26
02/26	03/26	INLET GULLY ON GRADE (LG) Type S Lintel	0.117			120	133.6	0.877	0.916	0.065			25	7.9	88	1.44	0.02	65	22	0.02	03/26	7.944	59.453	58.45	58.45	54.79	7.77	0.20	1.6	0.0	0.0	0.0	0.31	4.52	02/26
03/26	04/26	INLET GULLY ON GRADE (LG) Type S Lintel	0.173			120	133.6	0.877	0.916	0.096			25	8.0	117	1.61	0.03	79	38	0.03	04/26	8.000	55.688	54.80	54.78	52.70	7.49	0.36	1.1	0.0	0.0	0.0	0.58	5.15	03/26
04/26	05/26	INLET GULLY ON GRADE (LG) Type S Lintel	0.188			120	133.6	0.877	0.916	0.105			25	8.0	141	1.75	0.04	89	51	0.03	05/26	8.000	53.563	52.48	52.40	51.52	3.68	0.45	0.9	0.0	0.1	0.0	0.47	3.47	04/26
05/26	06/26	DRAINWAYS 0TCS0 SAG	0.069			120	133.6	0.877	0.916	0.038			25	0.7	198	3.31	0.02	135	24	0.04	01/40	0.659	52.050	51.52	51.40	51.25	1.01	0.75	1.2	0.0	0.1	0.0	0.8	2.15	05/26
06/26	07/26	MANHOLE 1200mm DIA											25	1.0	0			0				1.000	52.271	51.25	51.08	50.61	0.88	0.75	1.7	0.0	0.2	0.0	0.84	2.26	06/26
07/26	08/26	MANHOLE 1500mm DIA											25	1.0	0			0				1.000	51.902	50.61	50.59	50.24	1.13	0.95	0.3	0.0	0.0	0.0	0.87	3.24	07/26
08/26	09/26	MANHOLE 1500mm DIA											25	1.0	0			0				1.000	51.316	50.15	50.13	49.43	5.16	1.08	0.6	0.0	0.0	0.0	0.44	5.18	08/26
09/26	10/26	MANHOLE 1500mm DIA											25	1.0	0			0				1.000	50.729	49.43	49.39	47.78	6.43	1.34	0.7	0.0	0.0	0.0	0.49	6.54	09/26
10/26	11/26	MANHOLE 1500mm DIA											25	1.0	0			0				1.000	48.730	47.39	47.38	45.75	5.89	1.43	1.8	0.0	0.3	0.0	0.54	5.31	10/26
11/26	12/26	1200 DIA MANHOLE EXTENDED 600mm											25	1.0	0			0				1.000	45.953	45.75	45.75	45.75	0.16	1.43	0.0	0.0	0.0	0.0	0.63	2.46	11/26
12/26	14/25	HEADWALL											25	1.0	0			0				1.000	45.580	45.75	45.75	45.75	0.00	1.43	0.0	0.0	0.0	0.0			12/26
14/25	15/25	BASIN NODE FOR CALCULATIONS			1.016							0.455	25	1.0	455			455				1.000	45.300	45.75											14/25
01/33	09/25	INLET GULLY ON GRADE (LG) Type S Lintel	0.143			120	133.6	0.877	0.916	0.080			25	0.6	316	3.29	0.10	143	229	0.08	01/34	0.600	52.357	52.49	52.46	52.40	0.89	0.12	9.7	0.0	0.1	0.0	0.36	1.32	01/33
09/25	10/25	DRAINWAYS 1TCS0 ON GRADE	0.107			120	133.6	0.877	0.916	0.060			25	0.6	295	3.33	0.04	194	87	0.05	01/39	0.600	52.357	52.50											09/25
01/34	05/26	INLET GULLY IN SAG (LS) Type S Lintel	0.165			120	133.6	0.877	0.916	0.092			25	0.7	358	6.49	0.04	184	116	0.04	05/26	0.659	52.050	51.96	51.78	51.52	3.86	0.18	5.5	0.0	0.2	0.0	0.42	1.73	01/34
05/26	06/26	DRAINWAYS 0TCS0 SAG	0.069			120	133.6	0.877	0.916	0.038			25	0.7	198	3.31	0.02	135	24	0.04	01/40	0.659	52.050	51.52											05/26
01/35	03/26	INLET GULLY ON GRADE (LG) Type S Lintel	0.206			120	133.6	0.877	0.916	0.115			25	8.0	133	1.66	0.03	85	45	0.02	01/34	8.000	55.729	55.14	54.94	54.79	2.12	0.09	9.4	0.0	0.2	0.0	0.26	1.36	01/35
03/26	04/26	INLET GULLY ON GRADE (LG) Type S Lintel	0.173			120	133.6	0.877	0.916	0.096			25	8.0	117	1.61	0.03	79	38	0.03	04/26	8.000	55.688	54.80											03/26
01/36	02/26	INLET GULLY ON GRADE (LG) Type S Lintel	0.141			120	133.6	0.877	0.916	0.079			25	7.1	79	1.39	0.02	60	18	0.01	01/35	7.090	60.022	59.03	58.99	58.46	5.29	0.06	9.7	0.0	0.0	0.0	0.12	2.27	01/36
02/26	03/26	INLET GULLY ON GRADE (LG) Type S Lintel	0.117			120	133.6	0.877	0.916	0.065			25	7.9	88	1.44	0.02	65	22	0.02	03/26	7.944	59.453	58.45											02/26
01/37	08/26	INLET GULLY IN SAG (LS) Type S Lintel	0.099			120	133.6	0.877	0.916	0.055			25	1.0	145	2.01	0.05	66	79	0.05	01/24	1.039	51.271	50.38	50.30	50.15	4.75	0.07	9.7	0.0	0.1	0.0	0.09	2.33	01/37
08/26	09/26	MANHOLE 1500mm DIA											25	1.0	0			0				1.000	51.316	50.15											08/26
01/38	08/26	INLET GULLY IN SAG (LS) Type S Lintel	0.124			120	133.6	0.877	0.916	0.069			25	0.9	110	1.91	0.03	61	49	0.03	01/37	0.907	51.456	50.48	50.40	50.16	3.89	0.06	9.7	0.0	0.1	0.0	0.14	1.77	01/38
08/26	09/26	MANHOLE 1500mm DIA											25	1.0	0			0				1.000	51.316	50.15											08/26
01/39	07/26	INLET GULLY ON GRADE (LG) Type S Lintel	0.256			120	133.6	0.877	0.916	0.142			25	1.2	203	2.41	0.04	138	61	0.04	01/37	1.226	51.882	51.31	50.96	50.90	2.30	0.14	7.1	0.0	0.4	0.0	0.44	1.59	01/39
07/26	08/26	MANHOLE 1500mm DIA											25	1.0	0			0				1.000	51.902	50.61											07/26
01/40	07/26	INLET GULLY ON GRADE (LG) Type S Lintel	0.174			120	133.6	0.877	0.916	0.097			25	1.4	103	1.62	0.01	86	17	0.01	01/38	1.358	51.855	51.23	50.97	50.86	2.26	0.09	9.6	0.0	0.3	0.0	0.27	1.3	01/40
07/26	08/26	MANHOLE 1500mm DIA											25	1.0	0			0				1.000	51.902	50.61											07/26
01/41	02/41	INLET GULLY ON GRADE (LG) Type S Lintel	0.239			120	133.6	0.877	0.916	0.133			25	5.6	143	1.71	0.03	95	47	0.03	03/41	5.609	54.809	53.78	53.78	51.76	5.58	0.10	7.0	0.0	0.0	0.0	0.17	2.49	01/41
02/41	03/41	INLET GULLY ON GRADE (LG) Type S Lintel	0.314			120	133.6	0.877	0.916	0.175			25	6.6	175	1.84	0.05	101	72	0.05	01/17	6.586	52.611	51.77	51.70	51.24	5.95	0.20	2.5	0.0	0.1	0.0	0.36	3.22	02/41
09/26	10/26	MANHOLE 1500mm DIA											25	1.0	0			0				1.000	50.729	49.43											09/26
01/55	02/55	INLET HEADWALL											25	1.0	0			0				1.000	45.435	45.75	45.57	42.21	13.43	1.15	0.5	0.0	0.2	0.0	0.32	3.58	01/55
02/55	03/55	HEADWALL											25	1.0	0			0				1.000	42.935	42.10	42.10	40.28	2.61	1.15	0.0	0.0	0.0	0.0	0.02	0.38	02/55
03/55	04/55	100% CAPTURE FOR FUTURE EXTENSION			110.076							24.596	90	1.0	24596			24596				1.000	41.083	40.28	40.28	37.92	1.90	25.98	0.0	0.0	0.0	0.0	0.22	2.55	03/55
04/55	05/55	100% CAPTURE FOR FUTURE EXTENSION											25	1.0	0			0				1.000	39.250	37.87	37.87	36.34	1.13	25.97	0.0	0.0	0.0	0.0	0.2	1.4	04/55
05/55	06/55	BASIN NODE FOR CALCULATIONS			20.019							9.478	25	1.0	9478			9478				1.000	36.200	36.34	36.34	36.34	0.00	27.97	0.0	0.0	0.0	0.0			05/55
06/55	07/55	INLET HEADWALL											25	1.0	0			0				1.000	37.110	36.34	36.24	34.04	6.11	27.97	0.4	0.0	0.1	0.0	0.2	3.25	06/55
07/55	08/55	HEADWALL											25	1.0	0			0				1.000	36.310	34.04	34.04	33.71	0.97	27.97	0.0	0.0	0.0	0.0	0.86	2.4	07/55
08/55	09/55	100% CAPTURE FOR FUTURE EXTENSION											25	1.0	0			0				1.000	34.000	33.56	33.56	33.51	0.26	28.79	0.0	0.0	0.0	0.0	0.46	3.3	08/55
09/55		REFERENCE											25	1.0	0			0				1.000	34.000	33.51											09/55
01/58	02/58	MANHOLE C/W ROOF SLAB AND 900x600 DOME TOP											60	1.0	728	0.00	0.00	728	0	0.00	03/55	1.000	45.300	45.02	43.95	43.64	3.69	0.75	2.2	0.0	1.1	0.0	0.95	3.7	01/58
02/58	03/58	MANHOLE C/W ROOF SLAB AND 900x600 DOME TOP											60	1.0	140	0.00	0.00	140	0	0.00	03/55	1.000	45.600	43.58	43.47	42.51	4.45	0.89	0.8	0.0	0.1	0.0	0.53	5.01	02/58
03/58	03/55	HEADWALL											25	1.0	0			0				1.000	42.865	42.28	42.28	40.28	6.70	0.89	0.0	0.0	0.0	0.0	0.02	0.72	03/58
03/55	04/55	100% CAPTURE FOR FUTURE EXTENSION			110.076							24.596	90	1.0	24596			24596				1.000	41.083	40.28											03/55
01/63	02/63	INLET HEADWALL			0.133							0.059	25	1.0	59			59				1.000	46.488	46.00	46.00	45.41	5.63	0.06	0.0	0.0	0.0	0.0	0.11	2.88	01/63
02/63	01/2	HEADWALL											25	1.0	0			0				1.000	45.929	45.34	45.34	44.40	9.64	0.06	0.0	0.0	0.0	0.0	0.02	2.3	02/63
01/2	02/2	TYPE 2 FIELD INLET 900x600 C/W DOME TOP			0.141			0.877				0.063	25	1.0	63	1.58	0.03	18	45	0.03	02/2	1.000	44.376	43.18											01/2

C

PLANS AND DOCUMENTS referred to in the DEVELOPMENT APPROVAL

Application No: MIN/2024/337

Dated: 16 July 2024

Development shall comply with the conditions of approval as detailed in the Decision Notice and Council's Planning Scheme, Local Laws and Planning Policies

PROJECT NAME

COURTNEY DR UPPER COOMERA

STAGE 02

RP DESCRIPTION

LOT 188, 189, 190, 191 & 192 ON RP173728
COURTNEY DRIVE
LOCALITY OF UPPER COOMERA
LOCAL AUTHORITY - GOLD COAST CITY COUNCIL

CLIENT

HB Land

REV	DATE	DESCRIPTION	INT
C	19-06-24	CALC TABLE AMENDED	RK
B	15-01-24	CALC TABLE AMENDED	BL
A	13-10-23	COUNCIL ISSUE	EP

COPYRIGHT IS VESTED IN MORTONS-URBAN SOLUTIONS AND WRITTEN CONSENT IS REQUIRED PRIOR TO REPRODUCTION. DO NOT SCALE FROM THIS DRAWING.

ASSOCIATED CONSULTANTS

BIOME WATER AND ENVIRONMENTAL CONSULTING
Robin Russell & ASSOCIATES PTY. LTD.
BENNETT + BENNETT

DRAWING TITLE

STORMWATER
CALCULATION TABLES
MAJOR
STORM EVENT
SHEET 01

MORTONS urbansolutions
Urban & Regional Planning
Civil Engineering
Project Coordination
MUS Pty Ltd T/As:
Mortons-Urban Solutions
ABN: 39 116 375 065
Postal Address
PO Box 2484
Southport QLD 4215
mortons@urbansolutions.net.au
www.urbansolutions.net.au
Tel 07 5571 1099
Gold Coast Office
Suite 9, 19 Short St
Southport QLD 4215

DESIGNED RB	DRAWN EP	
APPROVED [signature]	RPEQ 4706	DATE 13-10-23

DRAWING NUMBER 41901-02-681 REV C

F:\Autocad Client\419 - HB Land\01 - Courtney Drive\Precinct-Stage 02\Engineering Drawings\Current\41901-02-680.dwg, MAJOR CALC TABLE SHEET 01, 21/06/2024 1:34:39 PM, 1:2

SEQ CODE WATER NOTES

SEQ CODE NOTES COPIED DIRECTLY FROM DRAWING SEQ-WAT-1101-3.

VEGETATION PROTECTION

A. TREES LOCATED ALONG THE FOOTPATH SHALL BE, TRANSPLANTED PRIOR TO CONSTRUCTION, OR REPLACED IF DESTROYED.
B. WHEN WORKING WITHIN 4m OF TREES, RUBBER OR HARDWOOD GIRDLES SHALL BE CONSTRUCTED WITH 1.8m BATTENS CLOSELY SPACED & ARRANGED VERTICALLY FROM GROUND LEVEL. GIRDLES SHALL BE STRAPPED TO TREES PRIOR TO CONSTRUCTION & REMAIN UNTIL COMPLETION.
C. TREE ROOTS SHALL BE TUNNELLED UNDER, RATHER THAN SEVERED. IF ROOTS ARE SEVERED THE DAMAGED AREA SHALL BE TREATED WITH A SUITABLE FUNGICIDE. CONTACT RELEVANT COUNCIL ARBORIST FOR FURTHER ADVICE.
D. ANY TREE LOPPING REQUIRED SHOULD BE UNDERTAKEN BY AN APPROVED ARBORIST.

SOIL

A. TOPSOIL & SUBSOIL SHALL BE STOCKPILED SEPARATELY.
B. CARE SHALL BE TAKEN TO PREVENT SEDIMENT FROM ENTERING THE STORMWATER SYSTEM. THIS MAY INVOLVE PLACING APPROPRIATE SEDIMENT CONTROLS AROUND STOCKPILES.
C. IF ACID SULPHATE SOILS EXIST IN THE WORKS AREA. THE CONTRACTOR MUST PREPARE A RISK ASSESSMENT BASED ON THE QUEENSLAND ACID SULPHATE SOIL TECHNICAL MANUAL & MANAGE THE ACID SULPHATE SOILS AS PER THE MANUAL.

CREEK CROSSINGS

A. SILTATION CONTROL MEASURES SHALL BE PLACED DOWNSTREAM OF ANY EXCAVATION WORK.
B. APPROPRIATE SEDIMENT CONTROLS SHALL BE USED TO PREVENT SEDIMENT FROM ENTERING THE CREEK.
C. NO SOIL SHALL BE STOCKPILED WITHIN 5m OF THE CREEK.

REHABILITATION

A. PREDISTURBANCE SOIL PROFILES & COMPACTION LEVELS SHALL BE REINSTATED.
B. PREDISTURBANCE VEGETATION PATTERNS SHALL BE RESTORED.

GENERAL NOTES

1. ALL WORK & MATERIALS SHALL BE IN ACCORDANCE WITH CURRENT SOUTH EAST QUEENSLAND WATER SUPPLY CODE SPECIFICATIONS & STANDARDS.
2. UNLESS SPECIFIED OTHERWISE ALL MATERIALS & WORK SHALL COMPLY WITH THE RELEVANT AUSTRALIAN STANDARDS.
3. ADOPT LIP OF KERB OR SHOULDER OF ROAD AS PERMANENT LEVEL.
4. COVER ON MAINS FROM PERMANENT LEVEL TO BE AS SHOWN IN SEQ-WAT-1200-2.
5. CONDUITS TO BE INSTALLED IN ACCORDANCE WITH THE STANDARD DRAWINGS.
6. A WATER METER SUPPLIED AT THE DEVELOPER'S COST, IS TO BE INSTALLED AT THE SERVICE POINT OF EACH LOT IN ACCORDANCE WITH THE STANDARD DRAWING FOR THE SEQ-SP.
7. ALL MATERIALS USED IN THE WORKS SHALL COMPLY WITH THE SEQ-SP's ACCEPTED PRODUCTS & MATERIALS LIST OR BE APPROPRIATELY SHOWN, LISTED & DEFINED IN THE ENGINEERING SUBMISSION SO THAT THE ALTERNATIVE PRODUCT OR MATERIAL CAN BE ASSESSED & IF APPROPRIATE, APPROVED BY THE SEQ-SP.
8. ALL CONCRETE FOOTPATHS TO BE CLEAR OF WATER MAINS.
9. TEST/CHLORINATION POINTS TO BE INSTALLED IN ACCORDANCE WITH STANDARD DRAWING NO.SEQ-WAT-1410-1.
10. THE CONSTRUCTION OF THE WATER RETICULATION WORK SHOWN ON THIS DRAWING MUST BE SUPERVISED BY AN ENGINEER WHO HAS RPEQ REGISTRATION. WORKS NOT COMPLYING WITH THIS REQUIREMENT WILL NOT BE PERMITTED TO CONNECT TO THE RETICULATION SYSTEM.

ALL ENVIRONMENT PROTECTION MEASURES SHALL BE IMPLEMENTED PRIOR TO ANY CONSTRUCTION WORK, INCLUDING CLEARING, COMMENCING.


PROJECT SPECIFIC WATER NOTES

a. ALL PROPERTY CONNECTION ROAD CROSSINGS TO BE SLEEVED WITH DN100 uPVC CONDUIT.
b. ALL MATERIALS ARE TO BE SUPPLIED & CONSTRUCTED IN ACCORDANCE WITH SEQ CODE.
c. WATER METERS ARE TO BE SUPPLIED & INSTALLED AT ALL WATER SERVICE / CONNECTION POINTS IN ACCORDANCE WITH SEQ-WAT-1106-1. READYTAPS ARE CURRENTLY NOT ACCEPTED BY C.O.G.C. TAPPING BANDS TO BE INSTALLED WITH MIN. DISTANCE OF 600mm BETWEEN EACH TAPPING BAND IS REQUIRED.
d. THRUST BLOCKS TO BE LOCATED & INSTALLED BY CONTRACTOR IN ACCORDANCE WITH SEQ CODE.
e. TRENCH STOPS & BULKHEADS TO BE IN ACCORDANCE WITH WATER AUTHORITY REQUIREMENTS.
f. THE CONTRACTOR IS TO INCLUDE ROCK EXCAVATION AS PART OF THEIR WATER RATES UNLESS SCHEDULED OTHERWISE WITHIN THE CONTRACT.
g. FOOTPATHS SHOWN FOR INFORMATION PURPOSES ONLY.
h. ALL WATER CONSTRUCTION WORK UNDERTAKEN BY THE CONTRACTOR SHALL COMPLY WITH ALL APPLICABLE WORKPLACE HEALTH & SAFETY LEGISLATION.
i. MINIMUM WATERMAIN COVER TO BE IN ACCORDANCE WITH SECTION 7.4.2 TABLE 7.2 OF THE SEQ AMENDMENT TO WATER SUPPLY CODE OF AUSTRALIA.
j. CONTRACTOR TO PAY ALL FEES & CHARGES ASSOCIATED WITH CONNECTIONS.
k. END OF LINE ARRANGEMENTS (EG. CUL-DE-SAC HEADS) TO BE CONSTRUCTED IN ACCORDANCE WITH SEQ-WAT-1104-1.
l. TEMPORARY CONSTRUCTION HYDRANTS TO BE PROVIDED IN ACCORDANCE WITH SEQ-WAT-1303-1 AT ALL CONNECTIONS.
m. ALL LIVE CONNECTIONS ARE TO BE ORGANISED BY THE CIVIL CONTRACTOR & UNDERTAKEN BY COUNCIL AT THE DEVELOPERS EXPENSE.

B

LEGEND

- EXISTING 100Ø WATER MAIN
- EXISTING 150Ø WATER MAIN
- EXISTING 200Ø WATER MAIN
- EXISTING 225Ø WATER MAIN
- EXISTING 250Ø WATER MAIN
- EXISTING 300Ø WATER MAIN
- EXISTING FOOTPATH
- EXISTING KERB (INVERT)
- EXISTING PROPERTY LINE
- FUTURE 100Ø WATER MAIN
- FUTURE 150Ø WATER MAIN
- FUTURE 200Ø WATER MAIN
- FUTURE 225Ø WATER MAIN
- FUTURE 250Ø WATER MAIN
- FUTURE 300Ø WATER MAIN
- FUTURE KERB (INVERT)
- FUTURE PROPERTY LINE
- FUTURE FOOTPATH
- PROPOSED KERB (INVERT)
- PROPOSED PROPERTY LINE
- PROPOSED FOOTPATH
- SITE BOUNDARY
- STAGE BOUNDARY
- PROPOSED 100Ø WATER MAIN
- PROPOSED 150Ø WATER MAIN
- PROPOSED 200Ø WATER MAIN
- PROPOSED 225Ø WATER MAIN
- PROPOSED 250Ø WATER MAIN
- PROPOSED 300Ø WATER MAIN
- HYDRANT
- TEE
- REDUCER
- SLUICE VALVE
- ENDCAP
- SCOUR VALVE
- AIR VALVE
- METER LOCATION
- TRENCH STOP
- SERVICE CONDUIT
- DICL ROAD CROSSING

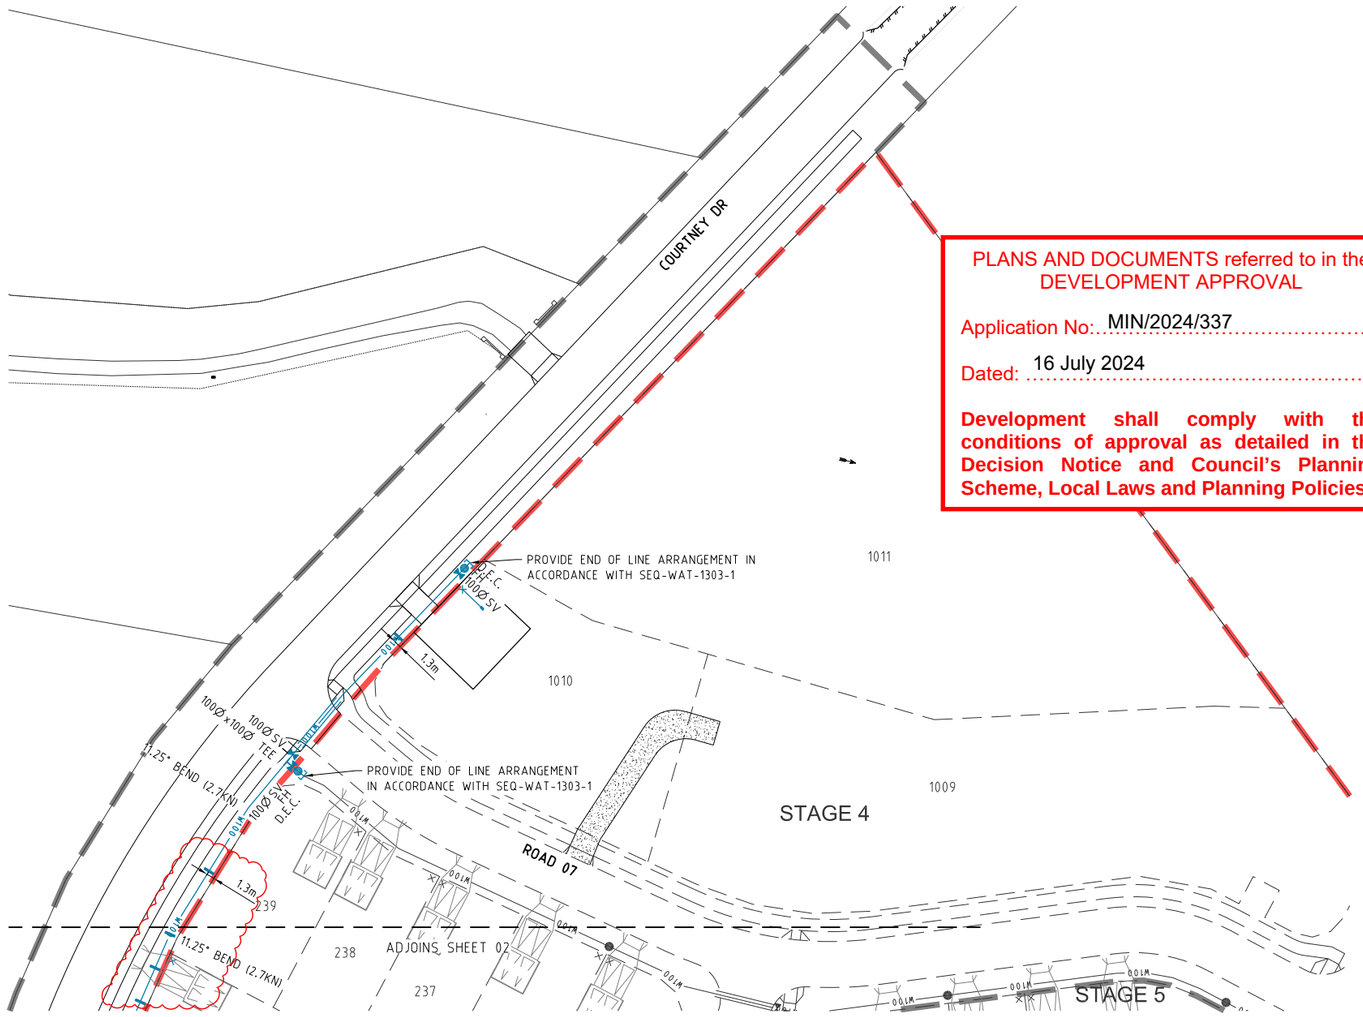


PLANS AND DOCUMENTS referred to in the DEVELOPMENT APPROVAL

Application No: MIN/2024/337

Dated: 16 July 2024

Development shall comply with the conditions of approval as detailed in the Decision Notice and Council's Planning Scheme, Local Laws and Planning Policies

SHEET LAYOUT

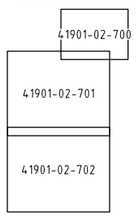

WATER PIPE SPECIFICATIONS

WATER MAIN LOCATION	PIPE MATERIAL SPECIFICATION
FOOTPATH VERGE	PVC-M SERIES 2 PN16
ROAD CROSSING	DICL PN35

DIAL BEFORE YOU DIG www.1100.com.au

PROJECT NAME

COURTNEY DR UPPER COOMERA

STAGE 02

RP DESCRIPTION

LOT 188, 189, 190, 191 & 192 ON RP173728
COURTNEY DRIVE
LOCALITY OF UPPER COOMERA
LOCAL AUTHORITY - GOLD COAST CITY COUNCIL

CLIENT

HB Land

NORTH

0 5 10 15 20 25m
Scale 1:500 - A1 (1:1000 - A3)

REV	DATE	DESCRIPTION	INT
B	29-11-23	TRENCHSTOPS ADDED & NOTE AMENDED	BL
A	13-10-23	COUNCIL ISSUE	EP

COPYRIGHT IS VESTED IN MORTONS-URBAN SOLUTIONS AND WRITTEN CONSENT IS REQUIRED PRIOR TO REPRODUCTION. DO NOT SCALE FROM THIS DRAWING.

ASSOCIATED CONSULTANTS

BIOME WATER AND ENVIRONMENTAL CONSULTING
Robin Russell & ASSOCIATES PTY. LTD.
BENNETT+BENNETT

DRAWING TITLE

WATER RETICULATION PLAN SHEET 01

MORTONS urbansolutions
Urban & Regional Planning
Civil Engineering
Project Coordination
MUS Pty Ltd T/As:
Mortons-Urban Solutions
ABN: 39 116 375 065
mortons@urbansolutions.net.au
www.urbansolutions.net.au
Tel 07 5571 1099
Postal Address
PO Box 2484
Southport QLD 4215
Gold Coast Office
Suite 9, 19 Short St
Southport QLD 4215

DESIGNED	RB	DRAWN	EP
APPROVED		RPEQ	4706
		DATE	13-10-23

DRAWING NUMBER 41901-02-700 REV B


F:\Autocad Client\419 - HB Land\01 - Courtney Drive\Precinct-Stage 02\Engineering Drawings\Current\41901-02-700.dwg, PLAN SHEET 01, 21/06/2024 1:35:33 PM, 1:2

PLANS AND DOCUMENTS referred to in the DEVELOPMENT APPROVAL

Application No: MIN/2024/337

Dated: 16 July 2024

Development shall comply with the conditions of approval as detailed in the Decision Notice and Council's Planning Scheme, Local Laws and Planning Policies

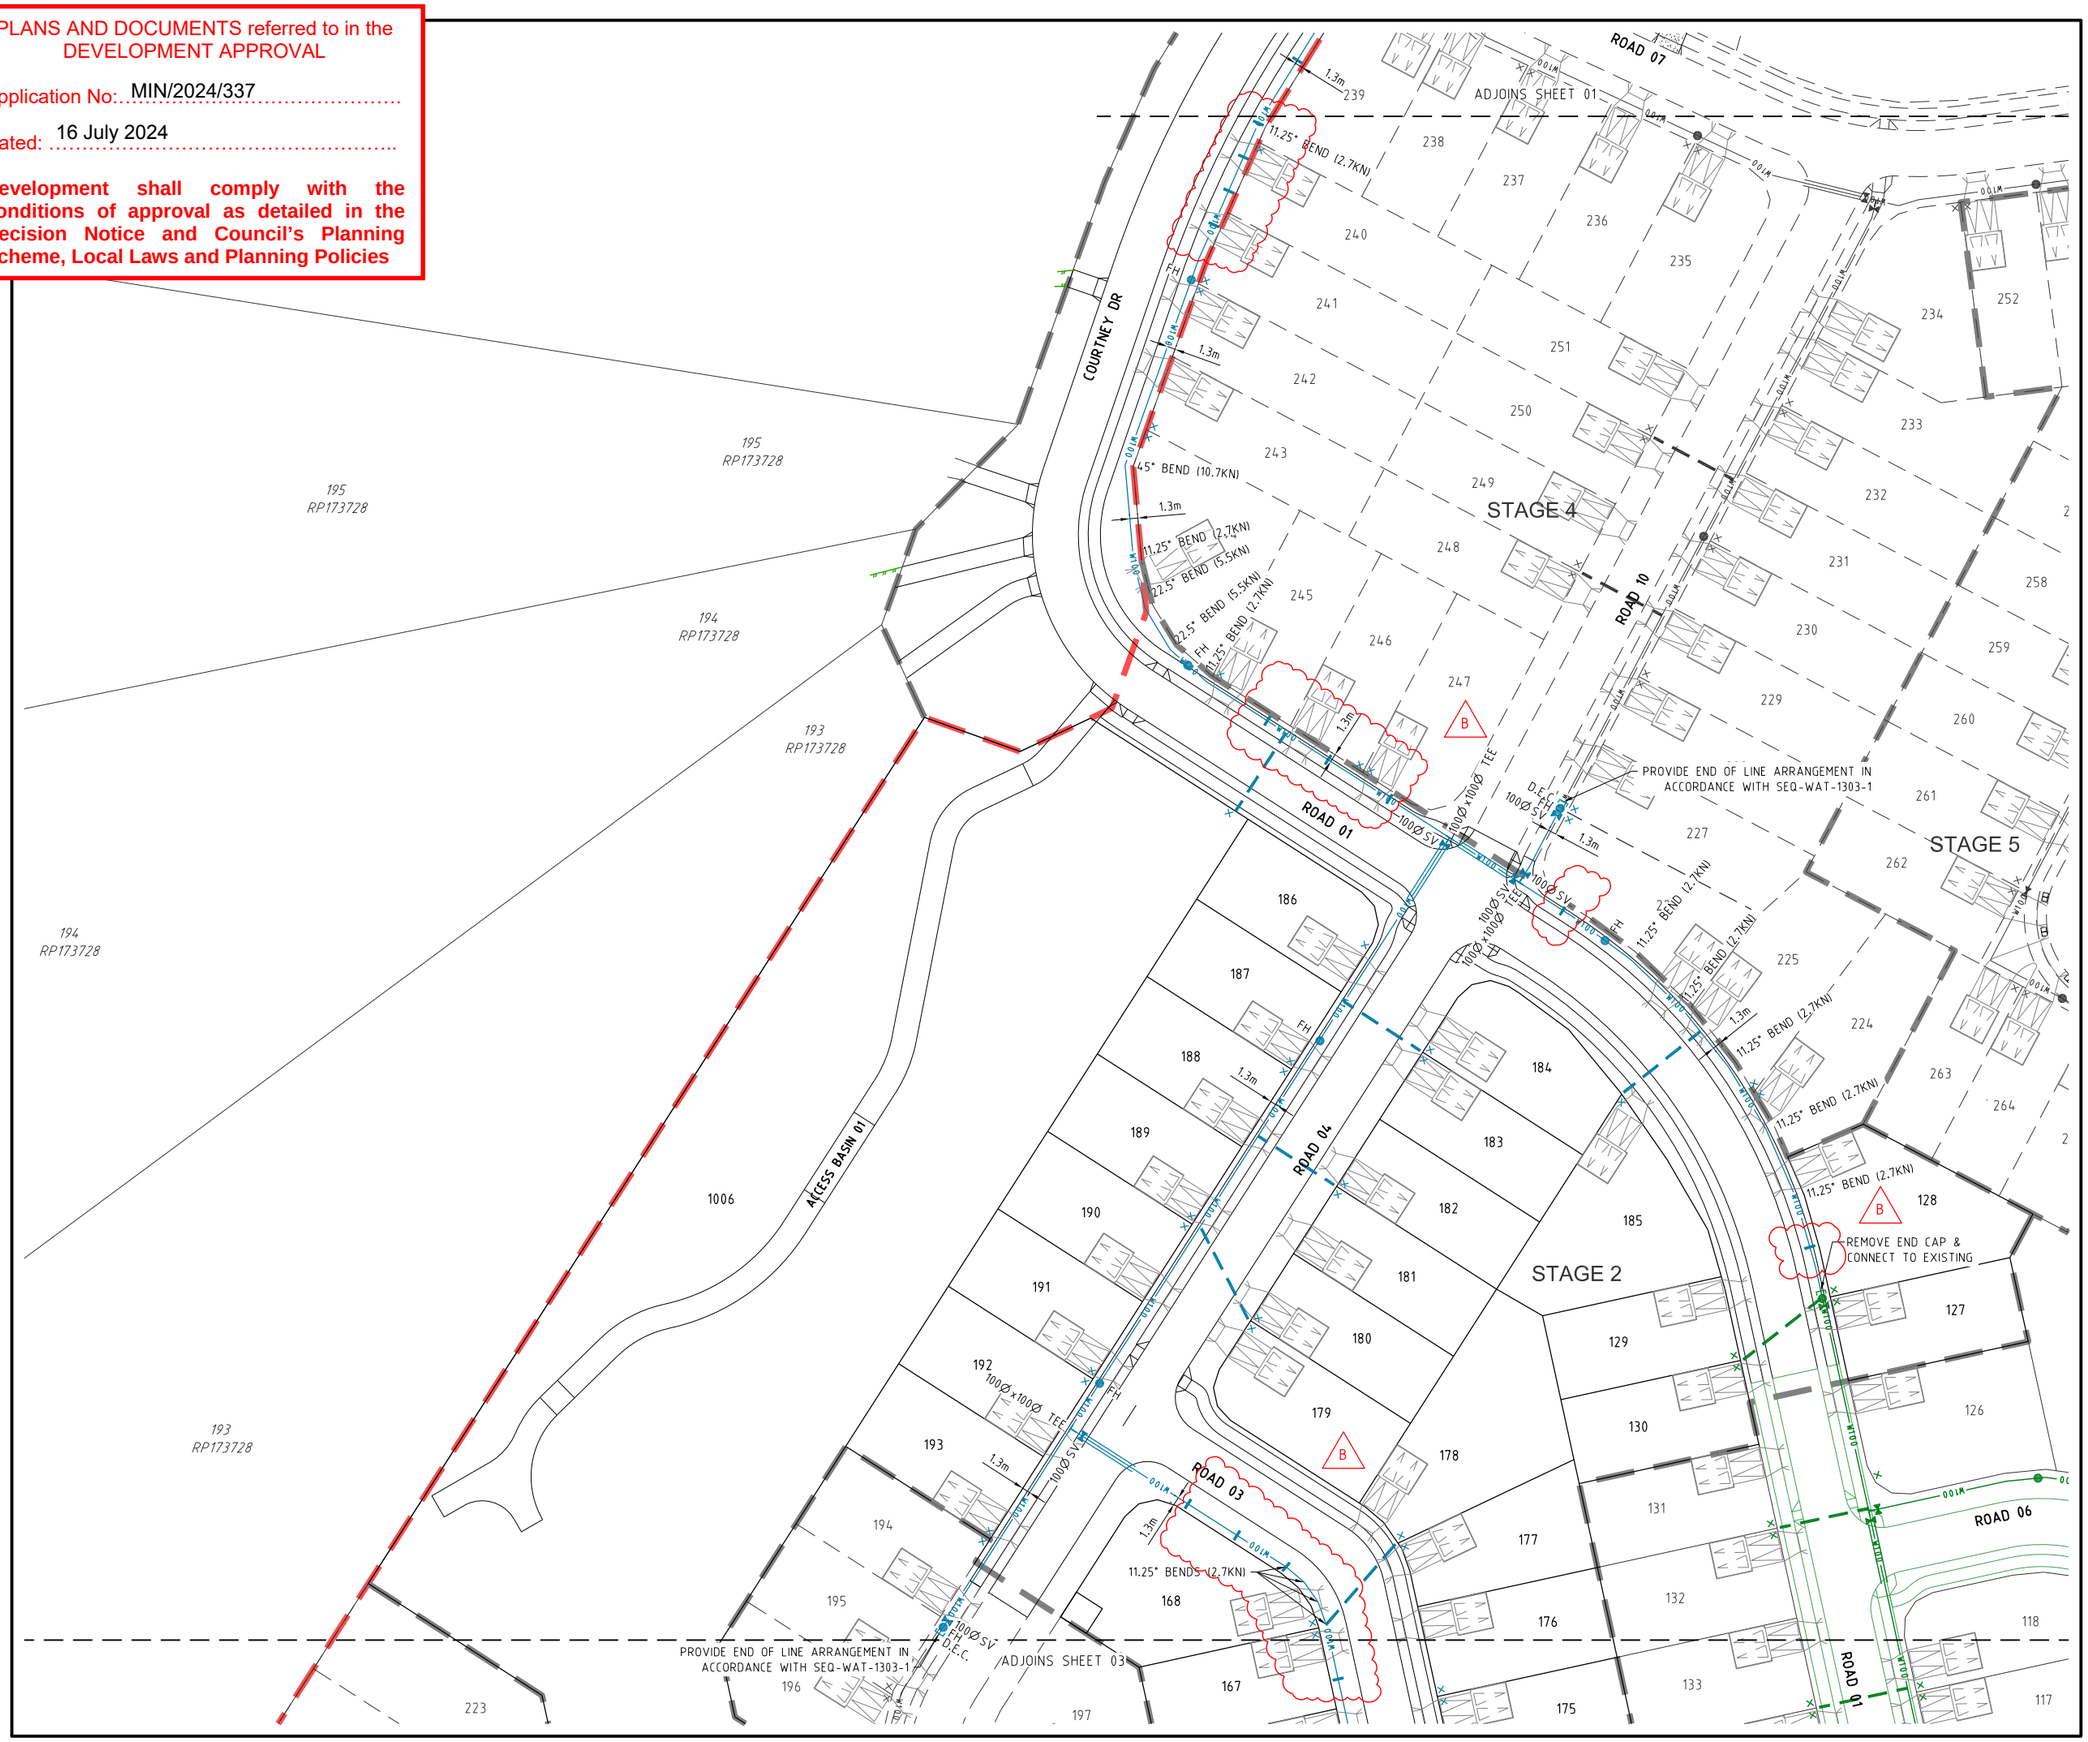

PROJECT NAME

COURTNEY DR UPPER COOMERA

STAGE 02

RP DESCRIPTION

LOT 188, 189, 190, 191 & 192 ON RP173728
COURTNEY DRIVE
LOCALITY OF UPPER COOMERA
LOCAL AUTHORITY - GOLD COAST CITY COUNCIL

CLIENT

HB Land

NORTH

0 5 10 15 20 25m
Scale 1:500 - A1 (1:1000 - A3)

REV	DATE	DESCRIPTION	INT
B	29-11-23	TRENCHSTOPS ADDED	BL
A	13-10-23	COUNCIL ISSUE	EP

COPYRIGHT IS VESTED IN MORTONS-URBAN SOLUTIONS AND WRITTEN CONSENT IS REQUIRED PRIOR TO REPRODUCTION. DO NOT SCALE FROM THIS DRAWING.

ASSOCIATED CONSULTANTS

BIOME WATER AND ENVIRONMENTAL CONSULTING
Robin Russell & ASSOCIATES PTY. LTD.
BENNETT + BENNETT

DRAWING TITLE

WATER RETICULATION PLAN SHEET 02

MORTONS urbansolutions
Urban & Regional Planning
Civil Engineering
Project Coordination

MUS Pty Ltd T/As
Mortons-Urban Solutions
ABN 39 116 375 065

Postal Address
PO Box 2484
Southport QLD 4215

mortons@urbansolutions.net.au
www.urbansolutions.net.au
Tel 07 5571 1099


Gold Coast Office
Suite 9, 19 Short St
Southport QLD 4215

DESIGNED	RB	DRAWN	EP
APPROVED	RPEQ 4706	DATE	13-10-23

DRAWING NUMBER: 41901-02-701

REV: B

F:\Autocad Client\419 - HB Land\01 - Courtney Drive\Precinct-Stage 02\Engineering Drawings\Current\41901-02-700.dwg, PLAN SHEET 02, 21/06/2024 1:35:35 PM, 1:2

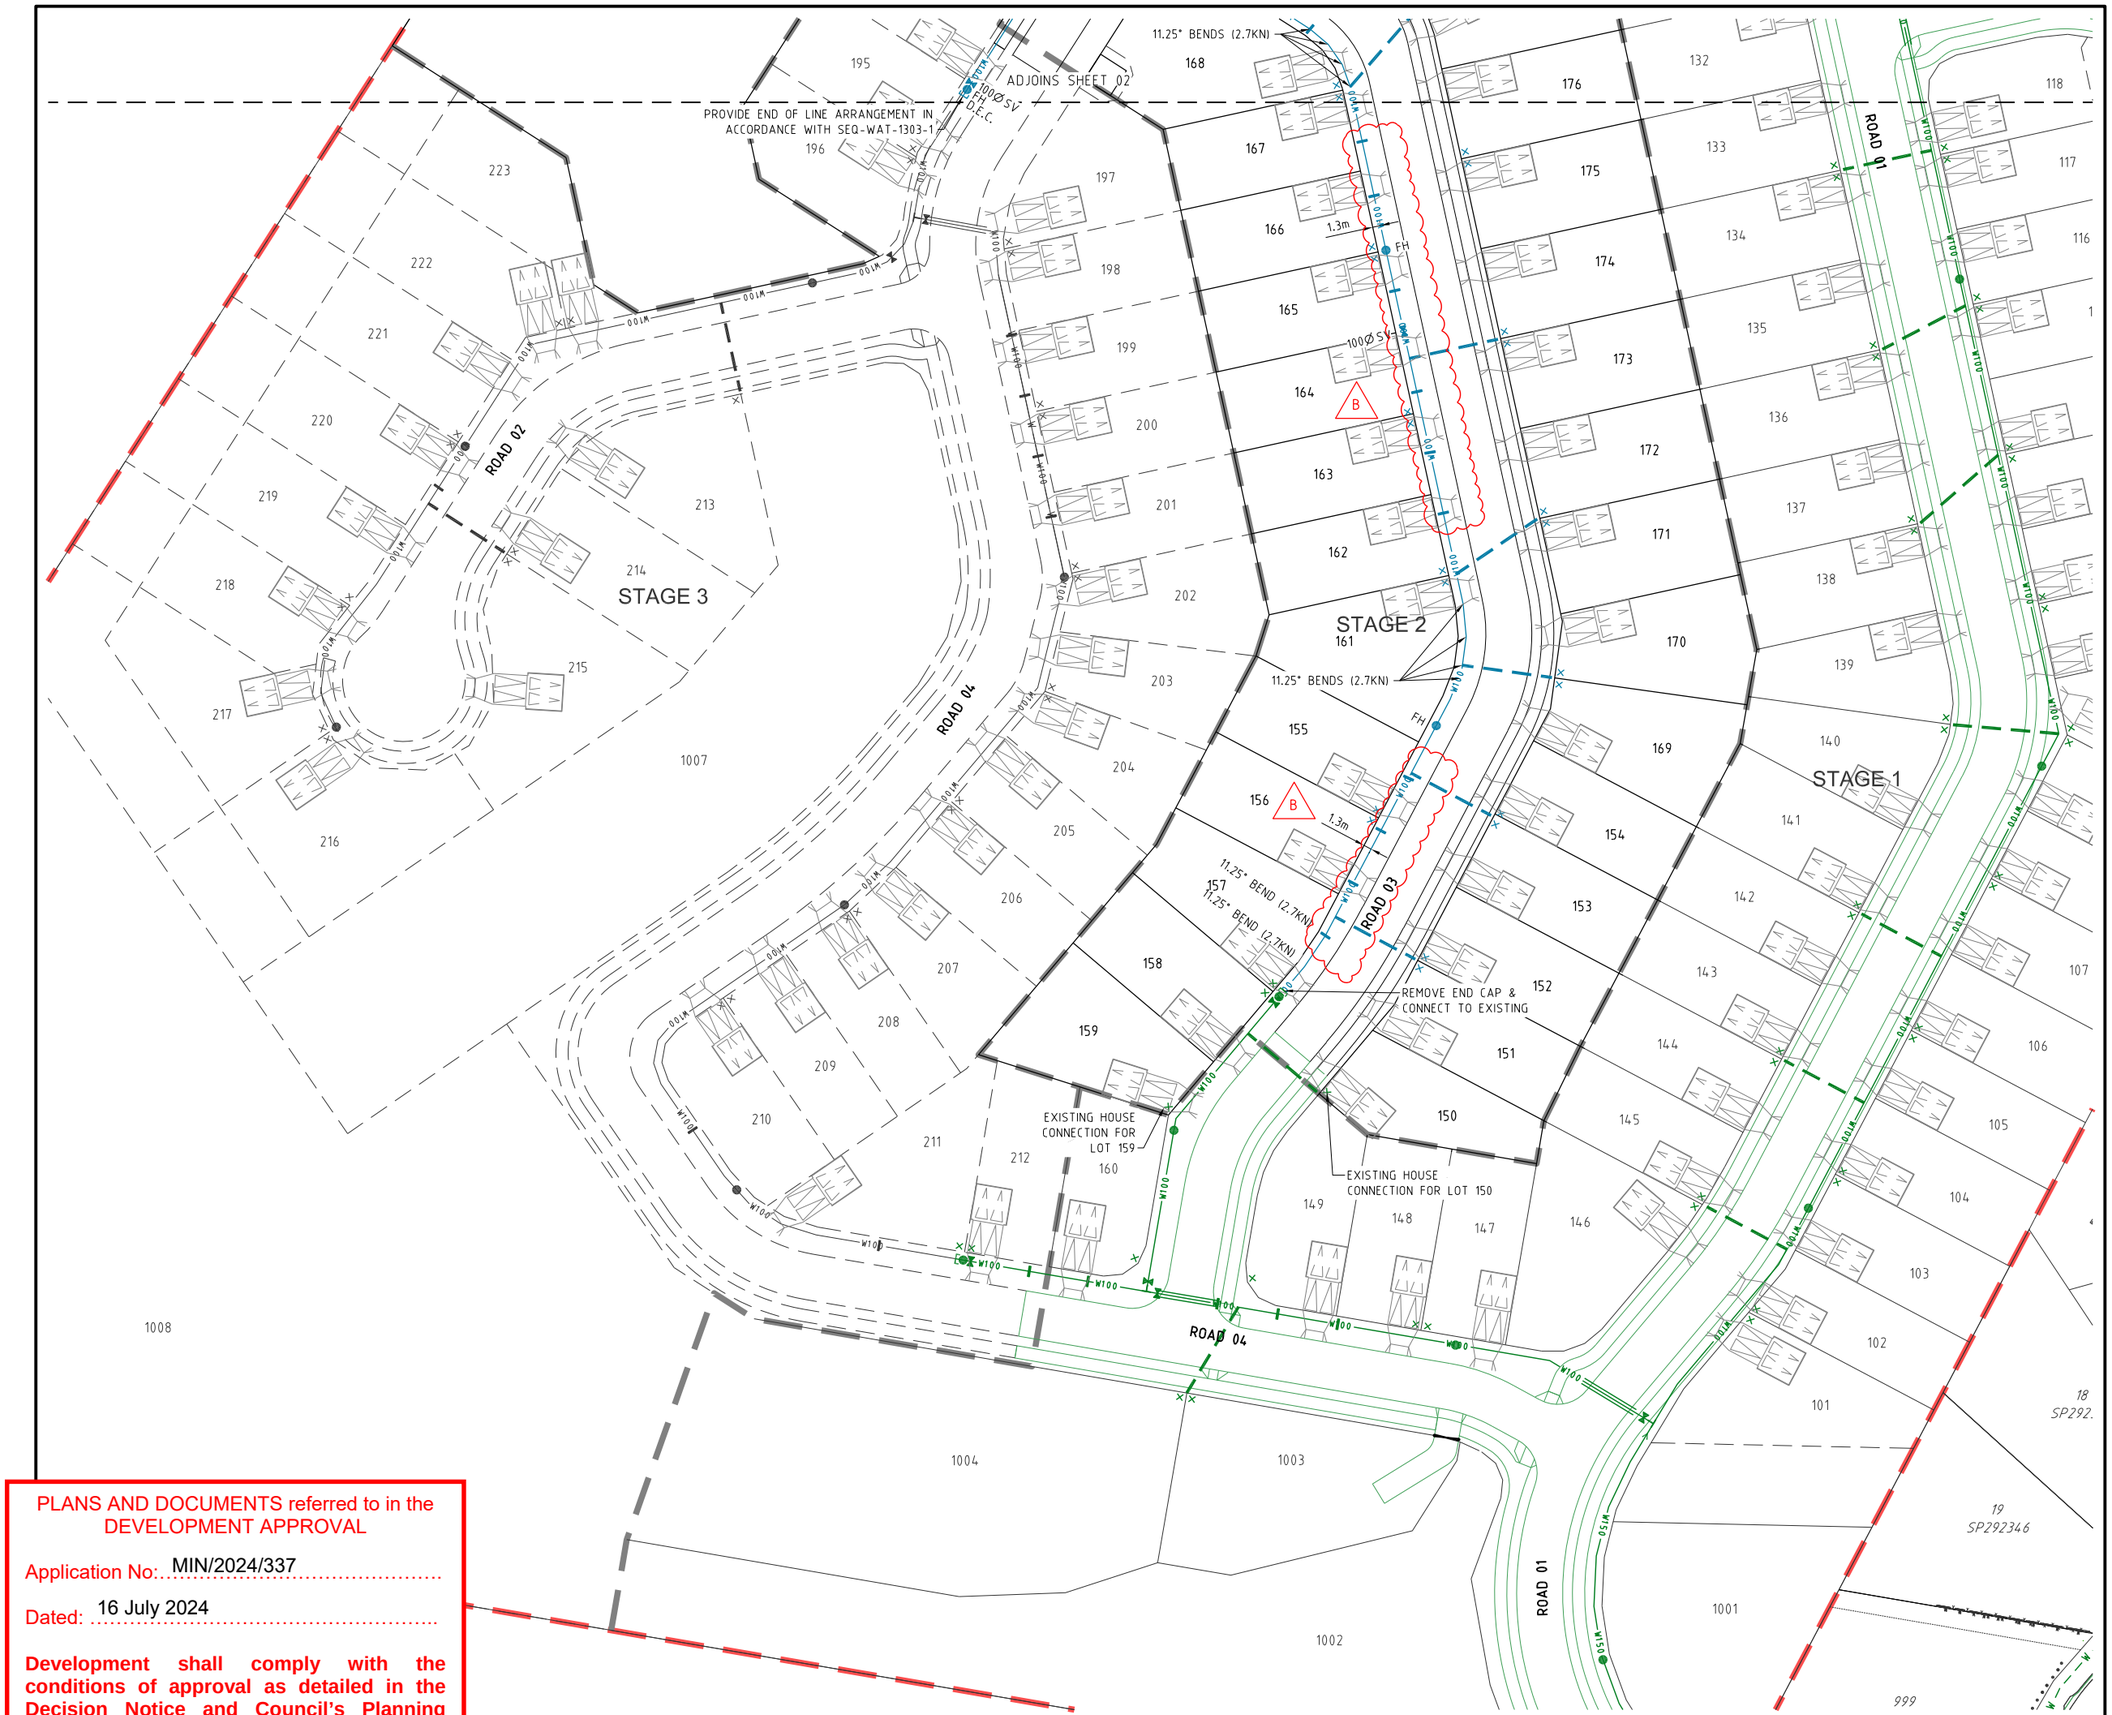

PLANS AND DOCUMENTS referred to in the DEVELOPMENT APPROVAL

Application No: MIN/2024/337

Dated: 16 July 2024

Development shall comply with the conditions of approval as detailed in the Decision Notice and Council's Planning Scheme, Local Laws and Planning Policies

F:\Autocad Client\419 - HB Land\01 - Courtney Drive\Precinct-Stage 02\Engineering Drawings\Current\41901-02-700.dwg, PLAN SHEET 03, 21/06/2024 1:35:37 PM, 1:2

PROJECT NAME

COURTNEY DR UPPER COOMERA

STAGE 02

RP DESCRIPTION

LOT 188, 189, 190, 191 & 192 ON RP173728
COURTNEY DRIVE
LOCALITY OF UPPER COOMERA
LOCAL AUTHORITY - GOLD COAST CITY COUNCIL

CLIENT

HB Land

NORTH

0 5 10 15 20 25m

Scale 1:500 - A1 (1:1000 - A3)

REV	DATE	DESCRIPTION	INT
B	29-11-23	TRENCHSTOPS ADDED	BL
A	13-10-23	COUNCIL ISSUE	EP

COPYRIGHT IS VESTED IN MORTONS-URBAN SOLUTIONS AND WRITTEN CONSENT IS REQUIRED PRIOR TO REPRODUCTION. DO NOT SCALE FROM THIS DRAWING.

ASSOCIATED CONSULTANTS

BIOME WATER AND ENVIRONMENTAL CONSULTING

Robin Russell & ASSOCIATES PTY. LTD.

BENNETT + BENNETT

DRAWING TITLE

WATER RETICULATION PLAN SHEET 03

MORTONS urbansolutions
Urban & Regional Planning
Civil Engineering
Project Coordination

MUS Pty Ltd T/As:
Mortons-Urban Solutions
ABN: 39 116 375 065
mortons@urbansolutions.net.au
www.urbansolutions.net.au
Tel 07 5571 1099

Postal Address
PO Box 2484
Southport QLD 4215

Gold Coast Office
Suite 9, 19 Short St
Southport QLD 4215

DESIGNED	RB	DRAWN	EP
APPROVED		RPEQ 4706	DATE 13-10-23

DRAWING NUMBER	REV
41901-02-702	B

THRUST BLOCK LENGTH

PIPE DN.	FITTING	MAX. THRUST IN KN	THRUST BLOCK HEIGHT	STIFF CLAY 50 KPa.	VERY STIFF CLAY SANDY LOAM 100KPa.	SAND & GRAVEL HARDCLAY 150KPa.	SAND & GRAVEL CEMENTED WITH CLAY 200KPa.	ROCK 240kPa
100	90° BEND	19.8	400	1000	●	●	●	●
	60° BEND	14.0		700	●	●	●	●
	45° BEND	10.7		●	●	●	●	●
	22.5° BEND	5.5		●	●	●	●	●
	11.25° BEND	2.7		●	●	●	●	●
	TEE OR CLOSED END	14.0		700	●	●	●	●
150	90° BEND	41.7	450	1860	930	●	●	●
	60° BEND	29.5		1320	660	●	●	●
	45° BEND	22.6		1000	●	●	●	●
	22.5° BEND	11.5		●	●	●	●	●
	11.25° BEND	5.8		●	●	●	●	●
	TEE OR CLOSED END	29.5		1300	660	●	●	●
200	90° BEND	71.7	550	*	1300	870	650	●
	60° BEND	50.7		1850	920	●	●	●
	45° BEND	38.8		1410	700	●	●	●
	22.5° BEND	19.8		720	●	●	●	●
	11.25° BEND	9.9		●	●	●	●	●
	TEE OR CLOSED END	50.7		1850	920	●	●	●
225	90° BEND	89.4	600	*	1500	1000	750	●
	60° BEND	63.2		2110	1060	700	●	●
	45° BEND	48.4		1620	810	●	●	●
	22.5° BEND	24.6		830	●	●	●	●
	11.25° BEND	12.4		●	●	●	●	●
	TEE OR CLOSED END	63.2		210	1060	700	●	●
250	90° BEND	109.0	650	*	1700	1120	840	700
	60° BEND	77.1		2400	1200	800	●	●
	45° BEND	59.0		1820	910	●	●	●
	22.5° BEND	30.1		930	●	●	●	●
	11.25° BEND	15.1		●	●	●	●	●
	TEE OR CLOSED END	77.1		2400	1200	800	●	●
300	90° BEND	158.6	700	*	2270	1510	1140	950
	60° BEND	112.2		*	1600	1070	800	670
	45° BEND	85.9		2453	1230	820	●	●
	22.5° BEND	43.8		1250	630	●	●	●
	11.25° BEND	22.0		630	●	●	●	●
	TEE OR CLOSED END	112.2		*	1600	1070	800	750

THRUST BLOCK LENGTH

PIPE DN.	FITTING	MAX. THRUST IN KN	THRUST BLOCK HEIGHT	STIFF CLAY 50 KPa.	VERY STIFF CLAY SANDY LOAM 100KPa.	SAND & GRAVEL HARDCLAY 150KPa.	SAND & GRAVEL CEMENTED WITH CLAY 200KPa.	ROCK 240kPa
375	90° BEND	241.9	800	*	*	2220	1510	1260
	60° BEND	171.0		*	2140	1430	1070	890
	45° BEND	130.9		*	1640	1090	820	680
	22.5° BEND	66.7		1670	840	●	●	●
	11.25° BEND	33.5		840	●	●	●	●
	TEE OR CLOSED END	171.0		*	2140	1430	1070	890
450	90° BEND	342.6	900	*	*	2540	1900	1590
	60° BEND	242.3		*	2690	1800	1350	1120
	45° BEND	185.4		*	2060	1375	1030	860
	22.5° BEND	94.5		2100	1050	700	●	●
	11.25° BEND	47.5		1060	●	●	●	●
	TEE OR CLOSED END	242.3		*	2690	1800	1350	1120
500	90° BEND	418	1000	*	*	2790	2090	1740
	60° BEND	295.6		*	*	1970	1480	1230
	45° BEND	226.2		*	2260	1510	1130	940
	22.5° BEND	115.3		2310	1150	770	●	●
	11.25° BEND	58.0		1160	●	●	●	●
	TEE OR CLOSED END	295.5		*	*	1970	1480	1230
600	90° BEND	593	1100	*	*	*	2700	2250
	60° BEND	419		*	*	2540	1910	1590
	45° BEND	320		*	2920	1950	1460	1220
	22.5° BEND	164		2980	1490	990	750	620
	11.25° BEND	82.2		1500	750	●	●	●
	TEE OR CLOSED END	419		*	*	2540	1910	1590
750	90° BEND	909	1300	*	*	*	*	2920
	60° BEND	643		*	*	*	2480	2060
	45° BEND	492		*	*	2530	1890	1580
	22.5° BEND	251		*	1930	1290	970	810
	11.25° BEND	126.1		1940	970	650	●	●
	TEE OR CLOSED END	643		*	*	*	2480	2060
900 (Ø960 MSCL)	90° BEND	1.228	1500	*	*	*	*	3420
	60° BEND	868		*	*	*	2900	2420
	45° BEND	664		*	*	2960	2220	1850
	22.5° BEND	339		*	2260	1510	1130	940
	11.25° BEND	170		2270	1140	760	●	●
	TEE OR CLOSED END	868		*	*	*	3300	2650

THRUST BLOCK DIMENSIONS - 1200kPa

● INDICATES BLOCK LENGTH OF 600


* = SPECIAL DESIGN

PLANS AND DOCUMENTS referred to in the DEVELOPMENT APPROVAL


Application No: MIN/2024/337

Dated: 16 July 2024


Development shall comply with the conditions of approval as detailed in the Decision Notice and Council's Planning Scheme, Local Laws and Planning Policies

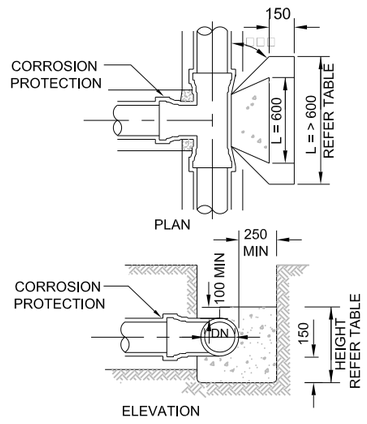


THRUST BLOCK FOR TEES
(FOR HORIZONTAL THRUST)

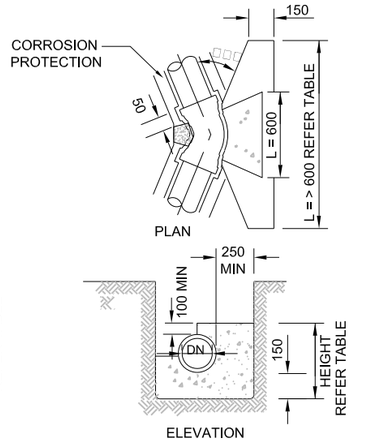

THRUST BLOCK FOR BENDS
(FOR HORIZONTAL THRUST)

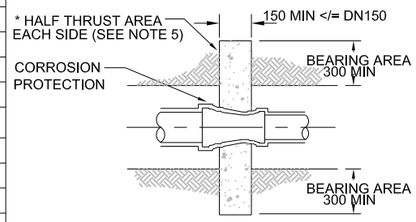

TAPER THRUST BLOCK
(FOR HORIZONTAL THRUST)

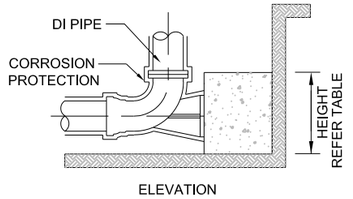

FLUSHING/WASHOUT BEND THRUST BLOCK
(FOR HORIZONTAL THRUST) (MINIMUM REQUIRED THRUST AREA AS PER TEE OR CLOSED END)

NOTES

1. ALL DIMENSIONS IN MILLIMETERS UNLESS OTHERWISE SPECIFIED.
2. CAST THE THRUST AREA OF ALL THRUST BLOCKS AGAINST A CLEAN FACE OF UNDISTURBED NATURAL SOIL. SOIL CLASSIFICATIONS USED ON THIS DRAWING ARE EXPLAINED IN SEQ-WAT-12110-1. DO NOT USE STANDARD THRUST BLOCKS AS SPECIFIED IN THIS DRAWING IN SOILS WITH < 5OkPa BEARING CAPACITY EG;
   –VERY SOFT, SOFT OR FIRM CLAY.
   –LOOSE CLEAN SAND.
   –UNCOMPACTED FILL OR REFUSE.
   A GEOTECHNICAL ASSESSMENT AND INDIVIDUAL DESIGN IS REQUIRED FOR THESE SOILS.
3. THRUST BLOCKS NOT TO INTERFERE WITH OTHER SERVICES OR BE LOCATED OUTSIDE THE WATER MAIN ALLOCATION WITHOUT WATER AGENCY APPROVAL.
4. ALL CONCRETE GRADE N20. TABLE OF DIMENSIONS BASED ON REQUIRED TEST PRESSURE OF 1200kPa AND ACTUAL DICL PIPE DIAMETERS.
5. THE MINIMUM THRUST AREA FOR TAPER THRUST BLOCKS TO BE EQUAL TO THE DIFFERENCE BETWEEN THE THRUST AREAS FOR TEES OR CLOSED ENDS OF EQUIVALENT DIAMETER TO THOSE EACH SIDE OF TAPER. THE DETAIL SHOWN IS FOR < OR = DN150 MAINS. FOR LARGER MAINS, THE TAPER THRUST BLOCK SHALL BE REINFORCED AND OF A SIZE AS SHOWN IN SEQ-WAT-1206-1.
6. FOR DOWNWARD VERTICAL THRUST, THE ALLOWABLE BEARING PRESSURE FOR VARIOUS SOILS MAY BE TAKEN AS TWICE THAT FOR HORIZONTAL THRUST SHOWN.
7. WHEN POURING CONCRETE AGAINST FITTINGS PLACE A MEMBRANE OF POLYETHYLENE, PVC OR FELT BETWEEN THE FITTING AND CONCRETE TO PREVENT DAMAGE TO THE FITTING. PIPE JOINTS TO BE CLEAR OF CONCRETE.
   CONCRETE THRUST BLOCK ANCHORS FOR VALVES TO BE AS DETAILED ON SEQ-WAT-1206-1.

PROJECT NAME

COURTNEY DR UPPER COOMERA

STAGE 02

RP DESCRIPTION

LOT 188, 189, 190, 191 & 192 ON RP173728
COURTNEY DRIVE
LOCALITY OF UPPER COOMERA
LOCAL AUTHORITY - GOLD COAST CITY COUNCIL

CLIENT

HB Land

REV	DATE	DESCRIPTION	INT
A	13-10-23	COUNCIL ISSUE	EP

COPYRIGHT IS VESTED IN MORTONS-URBAN SOLUTIONS AND WRITTEN CONSENT IS REQUIRED PRIOR TO REPRODUCTION. DO NOT SCALE FROM THIS DRAWING.

ASSOCIATED CONSULTANTS

BIOME WATER AND ENVIRONMENTAL CONSULTING
Robin Russell & ASSOCIATES PTY. LTD.
BENNETT+BENNETT

DRAWING TITLE

WATER RETICULATION DETAILS

MORTONS urbansolutions
Urban & Regional Planning
Civil Engineering
Project Coordination
MUS Pty Ltd T/As:
Mortons-Urban Solutions
ABN: 39 116 375 065
mortons@urbansolutions.net.au
www.urbansolutions.net.au
Tel 07 5571 1099
Postal Address
PO Box 2484
Southport QLD 4215
Gold Coast Office
Suite 9, 19 Short St
Southport QLD 4215

DESIGNED	RB	DRAWN	EP
APPROVED	RPEQ 4706	DATE	13-10-23

DRAWING NUMBER 41901-02-710

REV A

F:\Autocad Client\419 - HB Land\01 - Courtney Drive\Precinct-Stage 02\Engineering Drawings\Current\41901-02-710.dwg, DETAILS, 21/06/2024 1:35:41 PM, 1:2