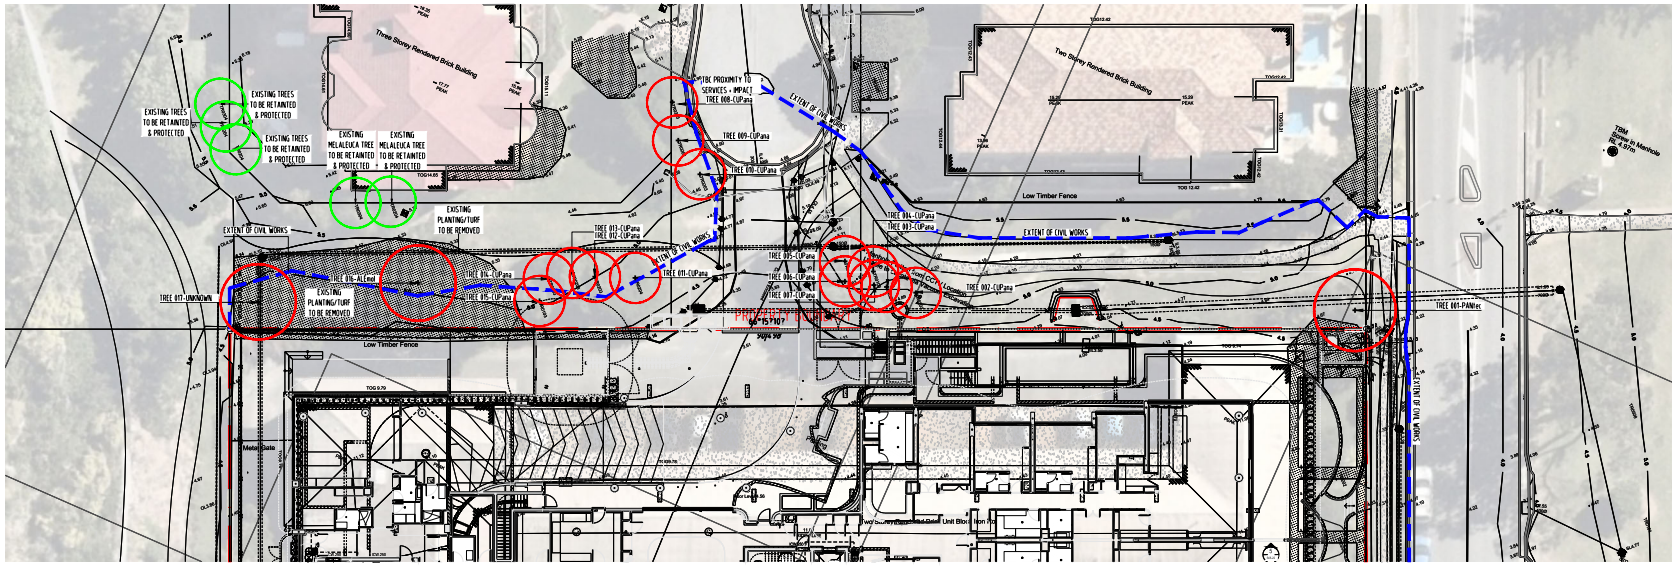


LEGEND

- EXISTING TREE TO BE REMOVED
- EXISTING TREE TO BE RETAINED

IDENTIFIED PALM/TREE SPECIES ONSITE TO BE REMOVED

CUPANIOPSIS anacardioides
PANDANUS tectorious
MELALEUCA spp
ALEURITES moluccans

- TREE 001-PANtec
- TREE 002-CUPana
- TREE 003-CUPana
- TREE 004-CUPana
- TREE 005-CUPana
- TREE 006-CUPana
- TREE 007-CUPana
- TREE 008-CUPana
- TREE 009-CUPana
- TREE 010-CUPana
- TREE 011-CUPana
- TREE 012-CUPana
- TREE 013-CUPana
- TREE 014-CUPana
- TREE 015-CUPana
- TREE 016-CUPana
- TREE 017-ALEmol
- TREE 018-UNKNOWN

CITY OF GOLD COAST
OPW TREE WORKS SITE PLAN
SUBJECT TO AMENDMENTS MARKED IN RED TO CORRESPOND WITH LETTER

Application No.: OPW/2026/317

Dated: 26 March 2026

A: 15 Christine Avenue Miami, Gold Coast 4220
P: 07 5654 5198
W: ldgla.com.au
DIMENSIONS ARE SUBJECT TO SITE MEASUREMENT & VERIFICATION
DO NOT SCALE OF THIS DRAWING

NOT FOR CONSTRUCTION

Issue	Date	Details	Approved
B	20.03.26	FOR APPROVAL	TS
A	18.03.26	FOR APPROVAL	TS

Client:

Scale 1:200 @ A1 - Dimensions in metres

Project: 122 MARINE PARADE MIAMI 4220

Designed by: AH | Drawn by: AH | Checked: TS

Title: TREE REMOVAL PLAN (PUBLIC)

Job No.: LA2411301 | Drawing No.: 912 | Issue: B